


DELTA	RADIUS	ARC	CHORD	BEARING
1 77°06'40"	52.52	70.63	65.40	N 46°17'35"E
2 89°41'56"	52.00	44.02	125.70	N 60°00'00"E
3 30°59'55"	53.00	94.14	64.14	N 61°39'55"E
4 10°04'25"	55.00	10.51	13.22	N 4°41'35"E
5 75°55'30"	58.00	74.83	60.75	N 7°11'25"E
6 122°33'13"	52.00	115.40	45.32	N 46°17'35"E
7 18°11'11"	72.00	13.33	25.10	N 5°18'54"E
8 1°05'55"	72.00	70.29	70.15	N 10°15'11"E
9 2°53'41"	252.00	105.84	102.38	N 25°27'30"E
10 105°46'29"	23.00	42.75	35.48	N 45°55'41"E
11 32°42'44"	108.00	61.75	60.80	N 64°47'42"E
12 5°15'04"	15.00	12.76	12.26	S 22°18'37"E
13 23°30'08"	31.00	169.36	32.56	N 25°27'30"E
14 1°05'22"	32.00	11.55	24.46	S 14°15'22"E
15 1°02'49"	32.00	11.55	24.46	N 46°17'35"E
16 5°53'25"	32.00	11.55	24.46	N 19°30'00"E
17 50°57'18"	32.00	25.41	27.53	N 46°17'35"E
18 26°15'04"	15.00	12.76	12.26	N 78°39'40"E
19 32°37'28"	15.13	12.43	74.22	N 66°44'46"E
20 51°45'50"	70.00	70.41	68.10	N 57°10'28"E
21 25°27'23"	15.00	31.53	31.71	N 47°20'06"E
22 28°15'38"	78.00	38.54	36.15	N 45°24'30"E
23 1°45'12"	132.00	39.19	39.32	N 57°00'00"E
24 44°28'11"	8.00	3.56	9.07	N 10°48'21"E
25 30°17'08"	180.00	1.33	112.10	N 23°18'24"E
26 54°52'09"	120.18	11.50	110.40	N 77°52'16"E
27 50°17'06"	180.00	16.00	16.07	N 12°44'51"E
28 26°54'29"	220.00	103.32	102.37	N 3°55'56"E
29 12°55'29"	350.00	79.00	78.84	N 10°15'11"E
30 15°11'11"	180.00	57.13	50.50	N 51°18'36"E
31 12°33'15"	70.00	143.75	122.77	N 46°52'36"E
32 32°55'55"	70.00	113.62	101.55	N 61°15'25"E
33 1°42'52"	70.00	41.19	40.60	N 56°00'00"E
34 30°11'30"	30.00	125.04	12.63	N 50°00'00"E
35 70°42'21"	70.00	1.33	112.10	N 23°18'24"E
36 1°52'19"	1935.08	400.96	400.21	N 2°11'21"E
37 2°55'03"	5.00	2.55	3.00	N 4°52'04"E
38 62°39'50"	5.00	2.55	3.00	N 63°00'00"E
39 89°12'41"	5.00	2.55	3.00	N 63°00'00"E
40 14°14'37"	64.00	10.15	27.73	N 2°11'21"E
41 70°31'45"	23.00	28.51	28.14	N 1°11'21"E
42 90°11'11"	25.00	49.60	48.74	N 4°52'04"E
43 90°00'00"	50.00	14.14	70.71	N 2°11'21"E
44 30°00'00"	62.00	11.11	9.09	N 3°11'21"E
45 70°31'45"	23.00	28.51	28.14	N 1°11'21"E
46 30°58'48"	82.00	46.97	12.54	N 3°11'21"E
47 122°53'13"	54.00	14.04	5.11	N 3°11'21"E
48 18°11'11"	12.00	1.24	62.12	N 3°11'21"E
49 12°05'29"	3.00	3.01	8.00	N 3°11'21"E
50 5°10'40"	1.00	1.00	3.00	N 3°11'21"E
51 7°43'33"	3.00	3.00	8.00	N 3°11'21"E

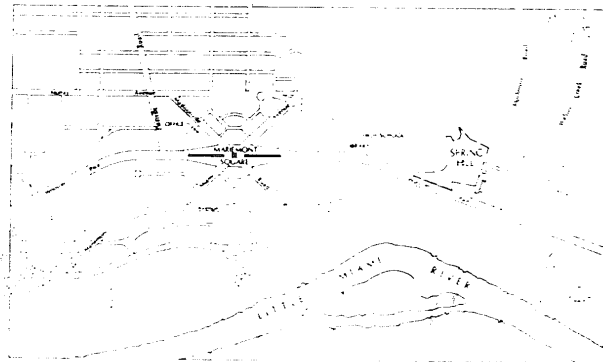


VICINITY MAP

THE UNDERSIGNED DO HEREBY CERTIFY
THAT TO THE BEST OF OUR KNOWLEDGE
THIS DRAWING DOES ACCURATELY SHOW
THE BUILDINGS AS CONSTRUCTED

REGISTERED ARCHITECT



REGISTERED SURVEYOR - 55411

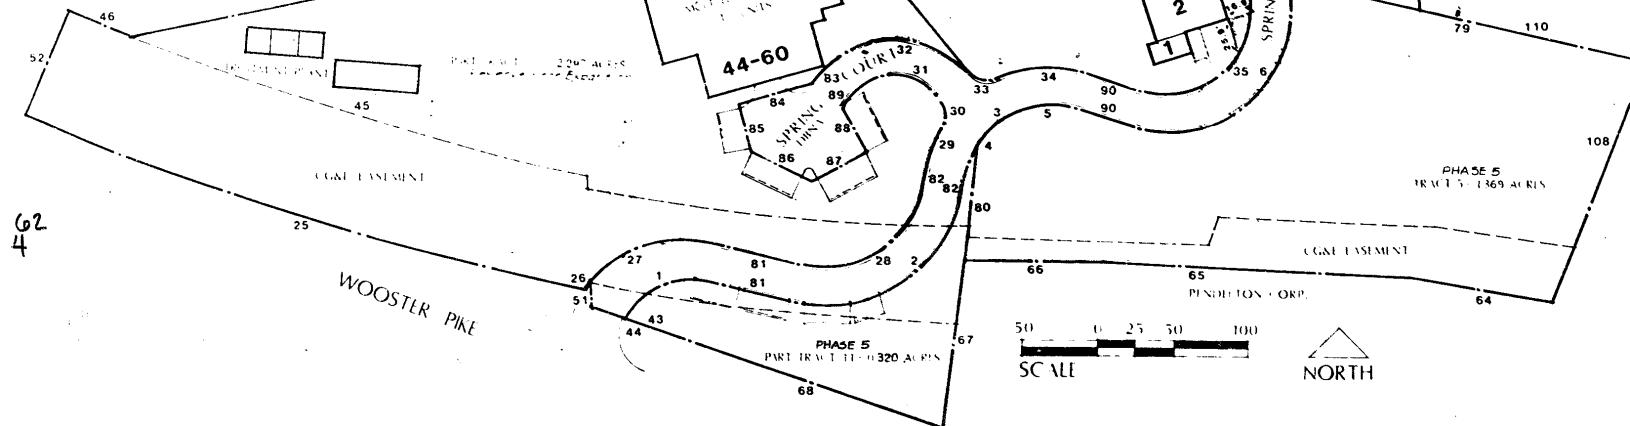

- LEGEND
- LIMITED COMMON AREA
 - COMMON AREA
 - 2** CONDOMINIUM NUMBER
 - 2** METES AND BOUNDS

PHASE 5
EXHIBIT C-30

TO THE DECLARATION OF CONDOMINIUM
FOR
SPRING HILL OF MARIEMONT CONDOMINIUM

SEC. 3, 1, 4, FR. 2, COLUMBIA TWP.
VILLAGE OF MARIEMONT
HAMILTON COUNTY, OHIO