RECORD OF SURVEY

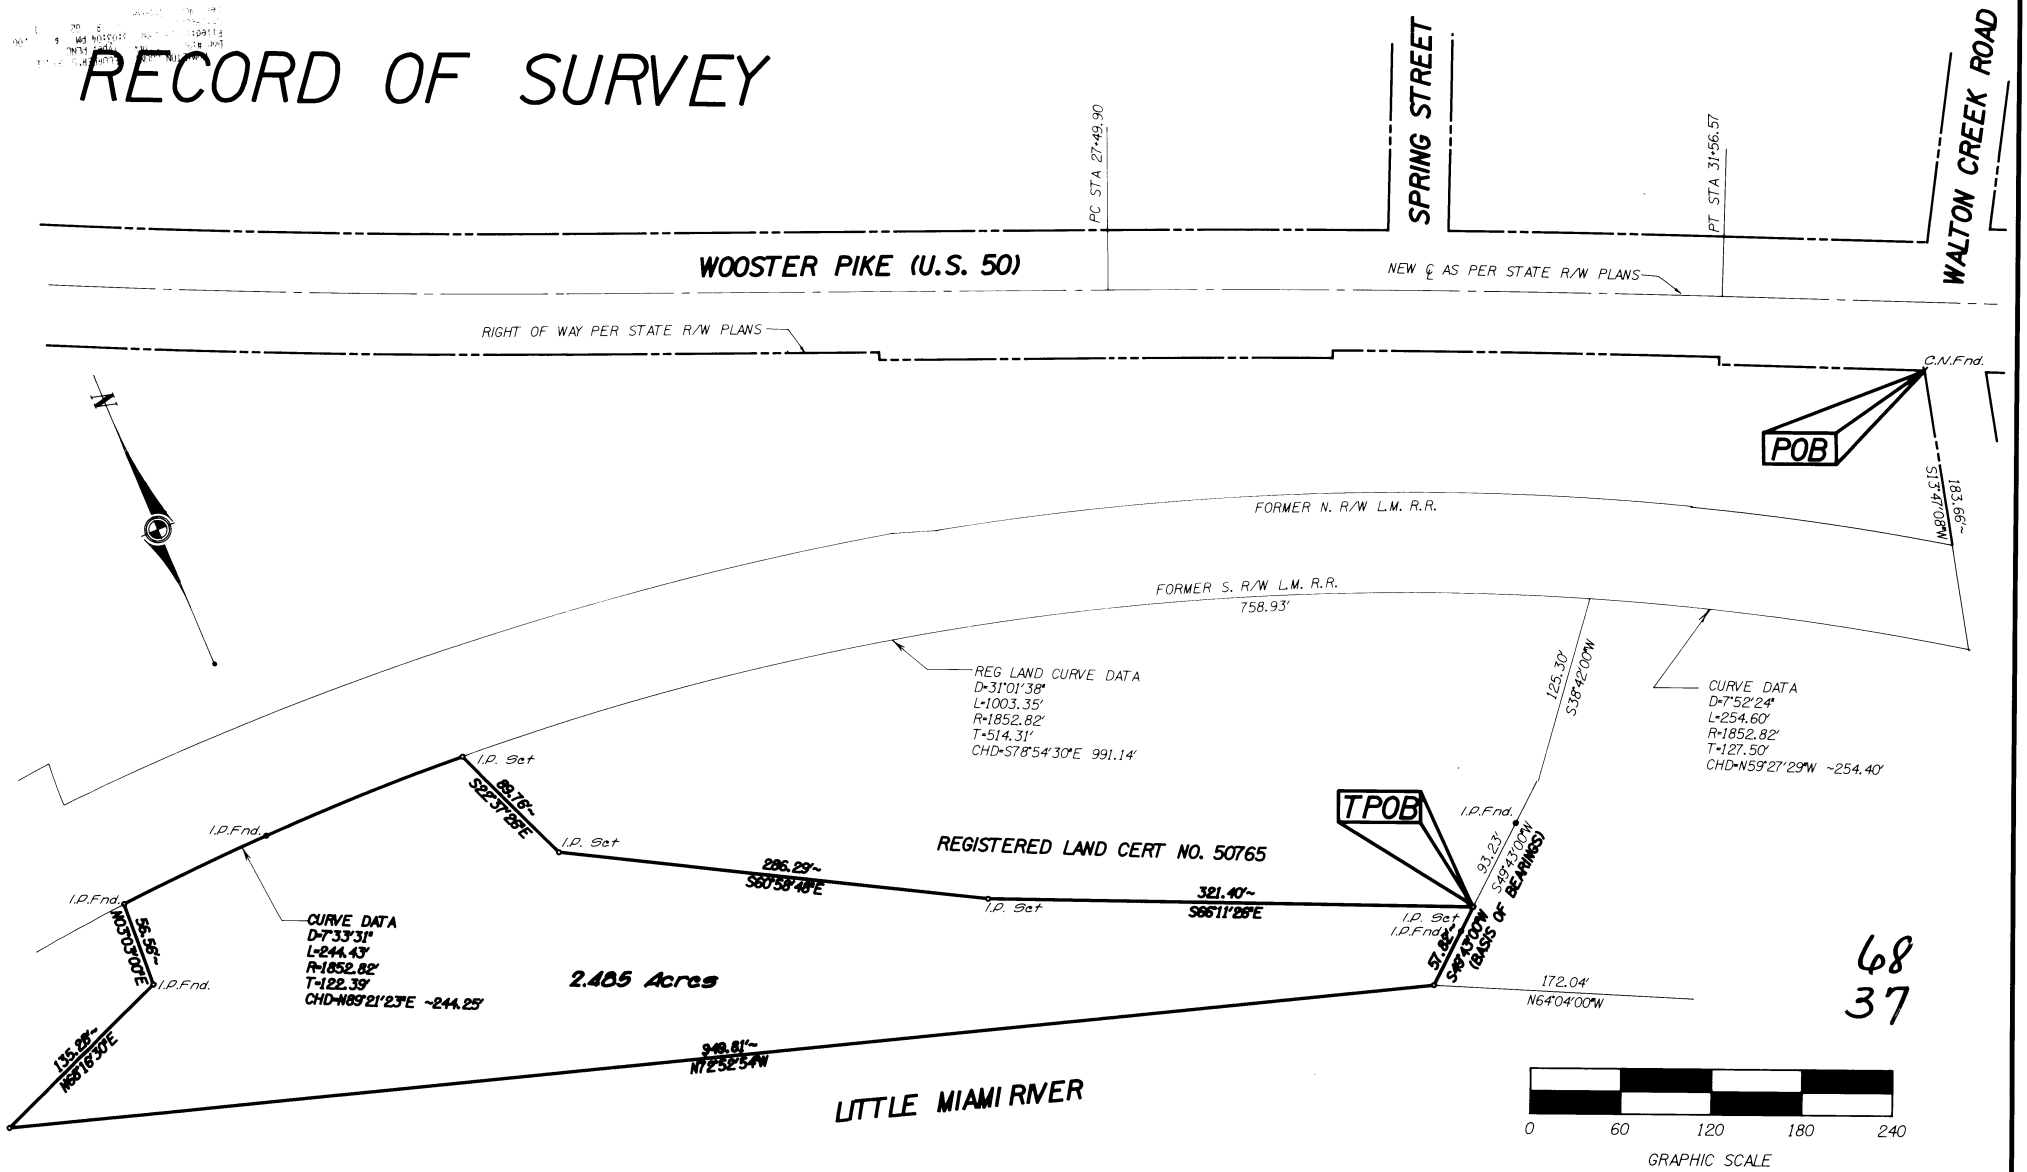

68
37

CLOSURE TABLE

BEARING	DIST.	NORTHING	EASTING
S 49°43'00" W	57.82'	-37.38	-44.11
N 72°52'54" W	949.81'	279.57	-907.73
N 68°16'30" E	135.28'	50.07	125.67
N 03°03'00" E	56.56'	56.48	3.01
N 89°21'23" E	244.25'	2.74	244.23
S 22°37'26" E	89.76'	-82.85	34.53
S 60°58'48" E	286.29'	-138.88	250.35
S 66°11'26" E	321.40'	-129.75	294.05
		0.00	0.00

STATE OF OHIO
JAMES P. BENEDICT
6583
REGISTERED SURVEYOR

SURVEYOR'S CERTIFICATION

I HEREBY CERTIFY THAT THE INFORMATION SHOWN ON THIS SURVEY IS CORRECT AND IS THE RESULT OF A FIELD SURVEY BY LOCKWOOD, JONES & BEALS, INC.

JAMES P. BENEDICT, OHIO P.S. 6583

PLAT of SURVEY

SECTION 3, TOWNSHIP 4, FRACTIONAL RANGE 2
COLUMBIA TOWNSHIP HAMILTON COUNTY, OHIO

SCALE: 1"=60'	DATE: JULY 27, 1992
DES.	
DRN. NRS	
CKD. JPB	

LJB engineers architects
LOCKWOOD, JONES AND BEALS INC.
1 CHANNEL POINT COURT SUITE 200
SHARONVILLE, OHIO 45241 TEL: 513-772-7700 FAX: 513-772-7791

PROJECT NO. 7230 C O
SHEET NO.