


INDIAN HILL VILLAGE  
INDIAN HILL TWP.  
HAM. CO. OHIO  
CODE 2  
MADISONVILLE W.C.

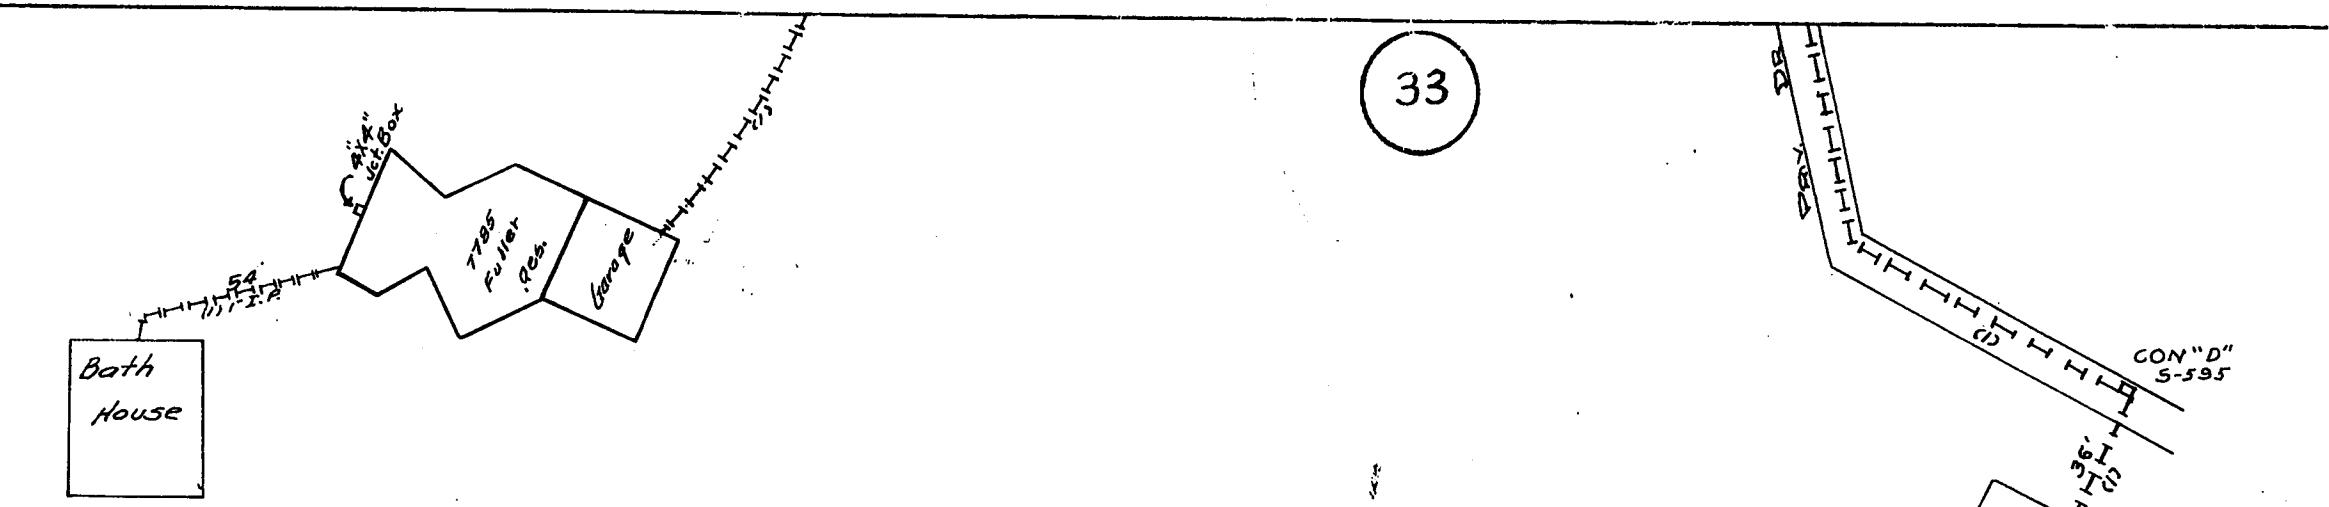

MARIEMONT VILL.  
MARIEMONT TWP.  
HAM. CO. OHIO  
CODE 20  
MADISONVILLE W.C.

AVE.

POCAHONTAS

AVE.

MARIEMONT  
PUBLIC  
LIBRARY.

Buried

8'


10'

8'

10'

8'

LITTLE MIAMI FIRE DIST.  
COLUMBIA TWP. - HAM. CO. OHIO  
CODE 18

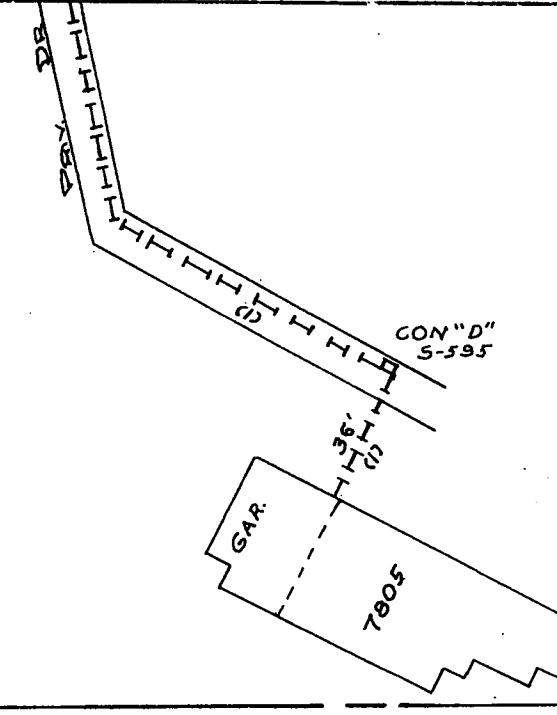unable to locate in  
Google maps

INDIAN HILL FIRE DIST.  
MARIEMONT S.D.  
INDIAN HILL TWP.  
HAM. CO. OHIO  
CODE 123  
MADISONVILLE W.C.  
REVISED

DATE	CODE
12/77	T.D. CHANGE
10-85	T.D. CHANGE
2-86	M 91G

MARIEMONT HIGH SCHOOL  
#3812 POCOHONTAS AVE

