

Request: A211201438

Gas Map

- Gas
- Pipe Change

Large Gas Service

Dimensioning Line

Gas Valve

Syphon

Drip

Coupling

Flow Control Device

High Volume Tee

Reducer

Sleeve

Telemeter

Vent

Flange

Gas Regulating Station Site

Expansion Joint

Exposed Pipe

Casing

Gas Detail Area
- Gas Main
- Pressure
- Feeder

High Pressure

Intermediate Pressure


Medium Pressure

Standard Pressure

Transmission

Unknown Pressure

Foreign Pipe
- Current Request
- Input Geometry
- Land
- Edge of Pavement

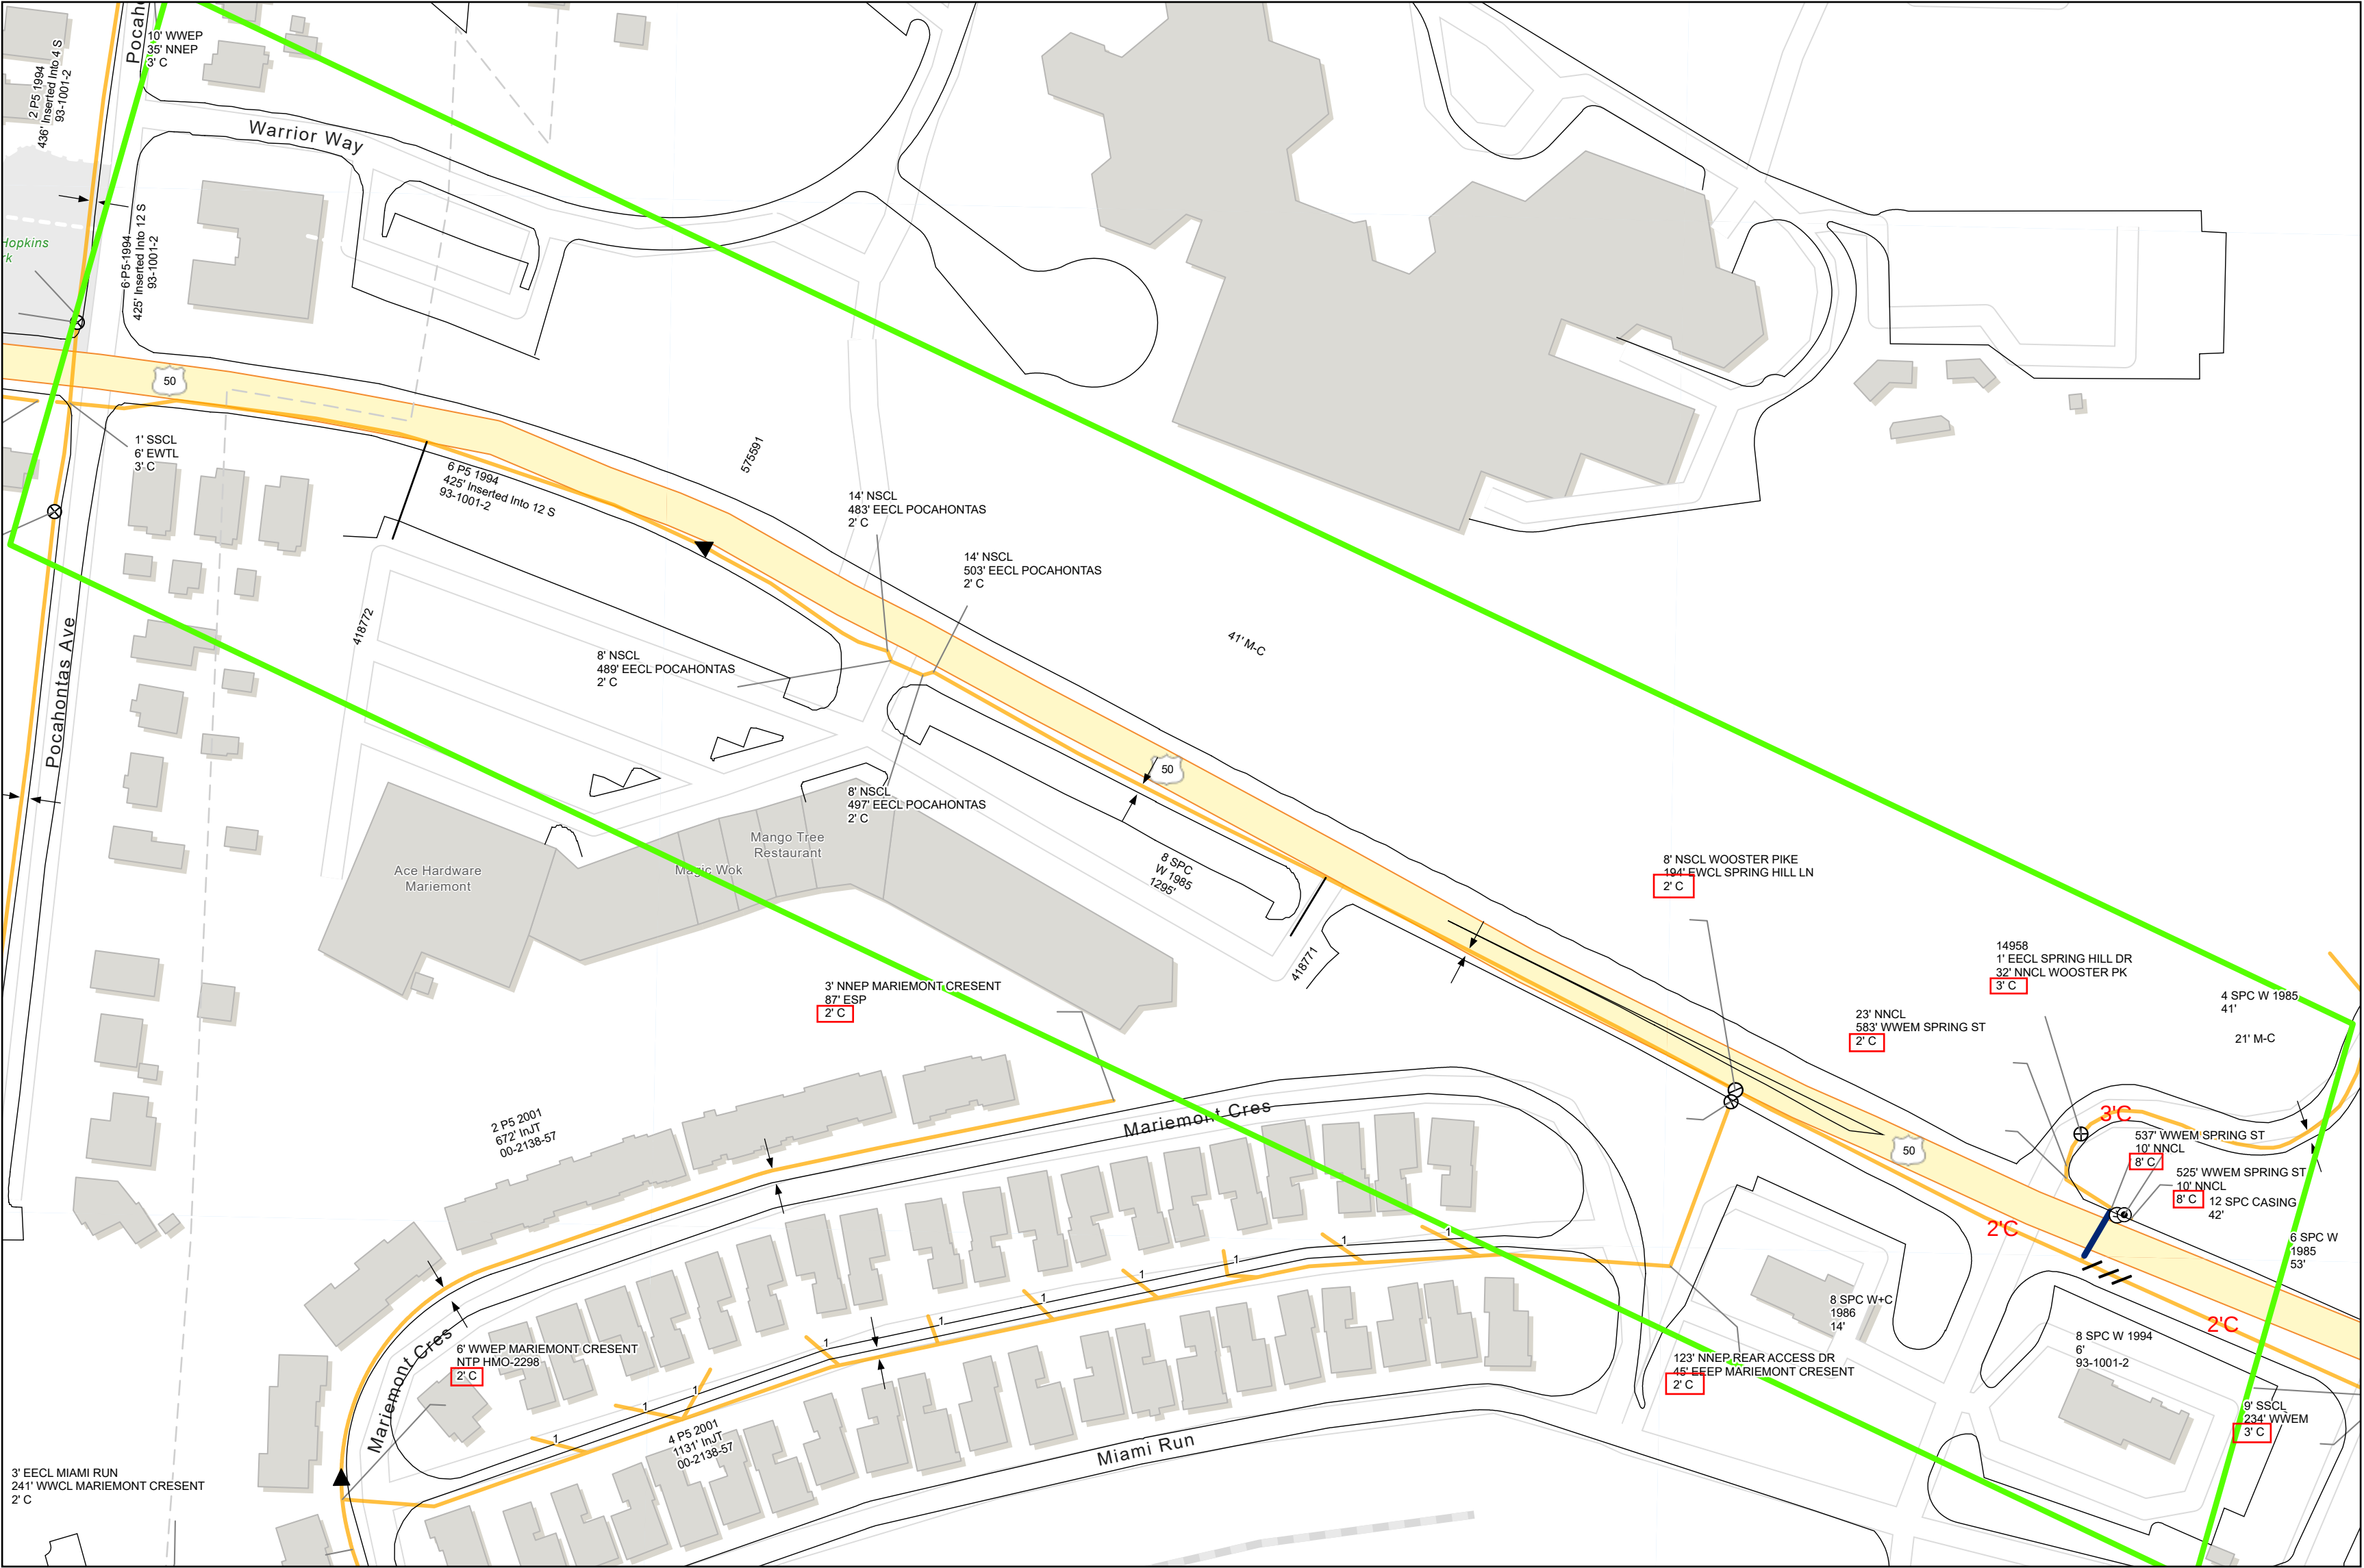

DISCLAIMER - This document was prepared for internal Duke Energy purposes only and was not prepared by a land surveyor. All facility, cable, and equipment locations are approximate; and this information may not be accurate of complete. It should not be used for any survey, engineering, or legal purposes.

