


TRAFFIC SIGNAL STRAIN POLE AND PEDESTRIAN PEDESTAL CHART									
POLE NO.	FOUNDATION ELEVATION (FT)	POLE TYPE	DESIGN NUMBER	POLE HEIGHT (FT)	ATTACHMENT HEIGHT (FT)	INDEX ANGLE (DEG)	ANGLES (DEG) FROM INDEX LINE		
							POWER SERVICE	PEDESTRIAN SIGNAL HEAD	PEDESTRIAN PUSH BUTTON
								CABLE ENTRANCE (TOP)	POLE MOUNTED SIGN
SP-1	575.17	TC-81.10	12	27'	26	126			
SP-2	570.17	TC-81.10	12	32'	31	182			
SP-3	567.22	TC-81.10	12	32'	225	277			
SP-4	566.28	TC-81.10	12	33'	32.5	180			
PS-3	567.00	TC-83.20		8'					
PS-4	566.03	TC-83.20		8'					

△ DUE TO UTILITY CONFLICTS, SP-4 WAS RELOCATED 6.5' EAST OF THE ORIGINAL POLE APPROVED LOCATION. THE SAG ON THE SPANS FROM SP-4 NEED TO BE REDUCED TO OBTAIN THE PROPER CLEARANCE FOR THE SIGNALS ON THOSE SPANS FROM SP-4.

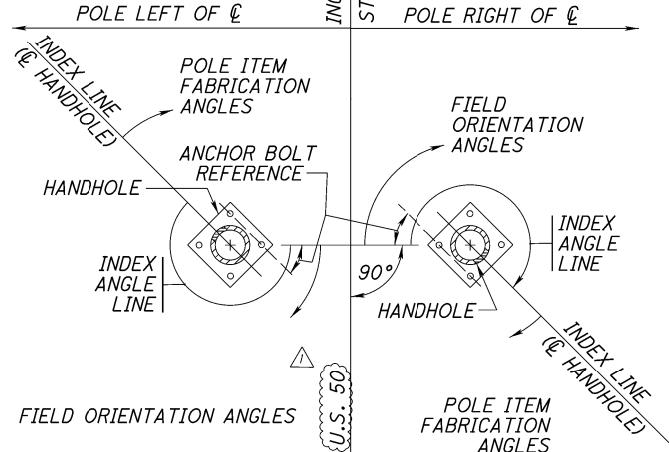

POLE ORIENTATION DETAIL NOTES:

- ALL ANGLES MEASURED CLOCKWISE.
- INDEX LINE GOES THROUGH THE CENTER OF THE HANDHOLE.
- HANDHOLE SHALL BE SQUARE TO ANCHOR BASE (AS SHOWN).

LEGEND








- VEHICULAR SIGNAL HEAD TO BE REMOVED
- PROP. VEHICULAR SIGNAL HEAD, SH1
- EX. SIGNAL POLE
- PROP. SIGNAL POLE, SP-X
- PROP. PEDESTRIAN SIGNAL HEAD, P1
PROP. PEDESTRIAN HEAD, PS-X, AND PROP. PUSHBUTTON, PB-X
- EX. PULL BOX
- PROP. PULL BOX, PBX
- PROP. CONDUIT
- STOP LINE RADAR DETECTION
- ADVANCED RADAR DETECTION
- PROP. CONTROL CABINET, WORKPAD (332), AND UPS

PAVEMENT MARKING LEGEND

- (SL) ITEM 644 - STOP LINE, 24"
- (CW) ITEM 644, CROSSWALK LINE, 24", 10' WIDE @ 5.5' SPACING
- (€) ITEM 644 - CENTER LINE
- (L) ITEM 644 - LANE LINE, 6"
- (A) ITEM 644 - LANE ARROW
- (CH) ITEM 644 - CHANNELIZING LINE, 12", WITH RPM (WHITE/RED)
- (R) REMOVAL OF PAVEMENT MARKING, INCLUDING RPM (YELLOW/YELLOW), WHEN CENTERLINE IS REMOVED.
- (I) ITEM 644 - ISLAND MARKING

△ REMOVAL OF PAVEMENT MARKING, INCLUDING RPM (YELLOW/YELLOW), WHEN CENTERLINE IS REMOVED.

△ ITEM 644 - ISLAND MARKING

 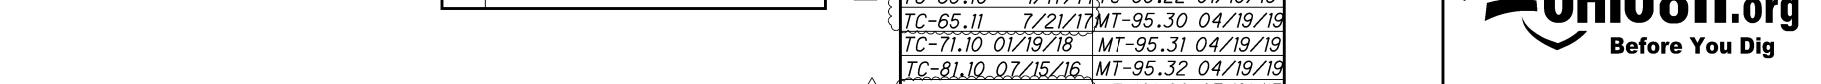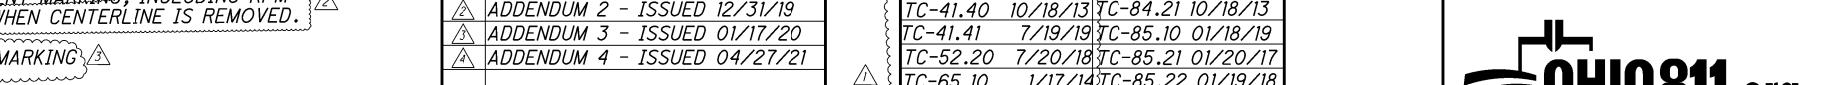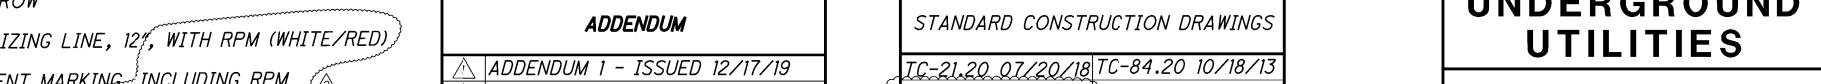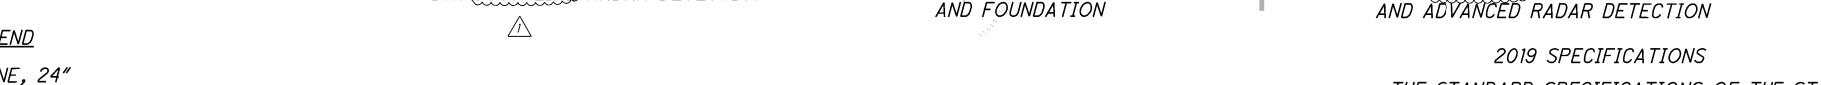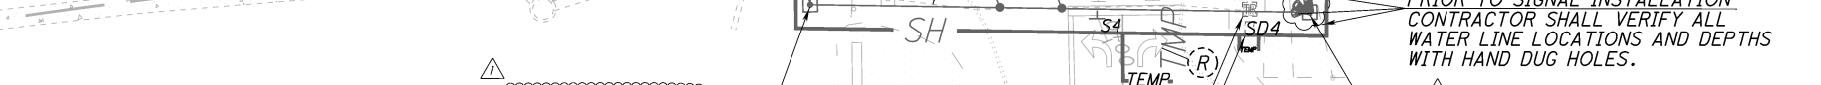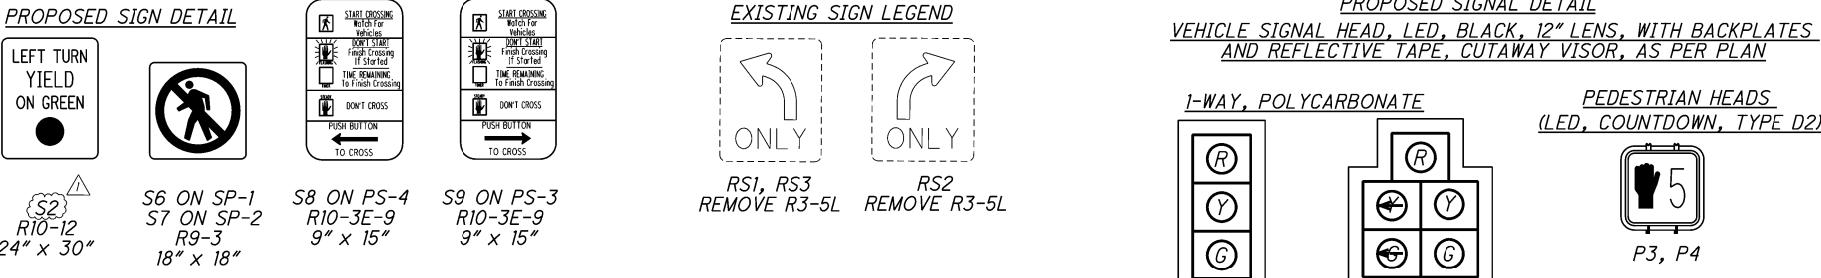

ADDENDUM	
△ ADDENDUM 1 - ISSUED 12/17/19	TC-84.20 10/18/13
△ ADDENDUM 2 - ISSUED 12/31/19	TC-84.21 10/18/13
△ ADDENDUM 3 - ISSUED 01/17/20	TC-85.10 01/18/19
△ ADDENDUM 4 - ISSUED 04/27/21	TC-85.21 01/20/17

STANDARD CONSTRUCTION DRAWINGS	


ITEM 632 PEDESTRIAN SIGNAL HEAD (LED), (COUNTDOWN), TYPE D2, AS PER PLAN

IN ADDITION TO THE REQUIREMENTS OF C&MS 632 AND 732 THE FOLLOWING SHALL APPLY:

1. SIGNAL HEADS AND VISORS SHALL BE CONSTRUCTED OF BLACK POLYCARBONATE PLASTIC AND MEET ITE SPECIFICATIONS.

2. PROPER EXTERIOR COLORS SHALL BE OBTAINED BY USE OF COLORED PLASTIC MATERIAL RATHER THAN PAINTING.

3. PIPE, SPACERS AND FITTINGS CONSTRUCTED OF POLYCARBONATE PLASTIC MAY BE USED IN LIEU OF GALVANIZED STEEL OR ALUMINUM.

4. THE PEDESTRIAN SIGNAL HEAD SHALL BE OF THE LED COUNTDOWN TYPE.

5. NEW ATTACHMENT HARDWARE AND FITTINGS SHALL BE USED

6. THE LIGHT EMITTING DIODE (LED) MODULES SHALL MEET THE REQUIREMENTS OF C&MS 732.04-. THE CONTRACTOR SHALL PROVIDE ODOT, IN WRITING, WITH THE LED MANUFACTURER NAME, SERIAL NUMBER, PART NUMBER, DESCRIPTION OF LAMP, AND DATE OF MANUFACTURE FOR ALL LED UNITS THAT ARE TO BE USED IN THE SIGNAL HEAD PRIOR TO INSTALLATION, FOR ACCEPTANCE AND WARRANTY PURPOSES.

PAYMENT FOR ITEM 632 PEDESTRIAN SIGNAL HEAD (LED), (COUNTDOWN), TYPE D2, AS PER PLAN SHALL BE MADE FOR THE NUMBER OF COMPLETE SIGNAL HEAD FURNISHED AND INSTALLED, INCLUDING ALL LABOR, EQUIPMENT, MATERIALS AND NEW ATTACHMENT HARDWARE.

ITEM 632 - POWER SERVICE, AS PER PLAN

POWER SERVICE SHALL BE AS PER SPECIFICATION 632 AND STANDARD CONSTRUCTION DRAWING TC-83.10 WITH THE FOLLOWING EXCEPTIONS:

1. THE METER BASE MOUNTING HEIGHT SHALL BE NO MORE THAN FIVE (5) FEET HIGH TO THE CENTER OF THE METER BASE FROM THE GROUND.

2. THE CONTRACTOR SHALL SUPPLY THE NECESSARY METER BASES.

3. ALL POWER SERVICES SHALL BE METERED. THE METER SHALL HAVE A LEVER OPERATED BYPASS.

4. THE POWER SERVICE BLIND HALF COUPLING SHALL BE TWENTY-SEVEN (27) INCHES ABOVE THE BOTTOM OF THE STRAIN POLE BASE PLATE AND SHALL BE WELDED TO THE STRAIN POLE.

5. CONDUIT FROM THE BOTTOM OF THE DISCONNECT SWITCH ENCLOSURE INTO THE BOTTOM OF THE CONTROLLER CABINET WILL NOT BE PERMITTED. POWER SERVICE WIRES FROM THE DISCONNECT SWITCH ENCLOSURE TO THE CONTROLLER CABINET SHALL BE ROUTED THROUGH THE STRAIN POLE.

6. IF INTERSECTION LIGHTING IS SPECIFIED THEN SEPARATE DISCONNECT SWITCHES SHALL BE INSTALLED AND LABELED "LIGHTING" AND "TRAFFIC SIGNAL" WITH A WEATHER PROOF STICKER. MARKER ON THE OUTSIDE OF THE ENCLOSURE IS NOT ACCEPTABLE.

DISCONNECT SWITCH ENCLOSURES FURNISHED SHALL INCLUDE A PADLOCK EQUAL TO MASTER NO. 49KA OR WILSON BOHANNON 660, WITH LOCK BODY OF BRONZE OR BRASS AND KEYING SHALL BE TO THE STATE MASTER.

THE CONTRACTOR SHALL CONTACT THE METER SECTION OF THE POWER COMPANY FOR INFORMATION REGARDING THE METER BASE INSTALLATION PRIOR TO ORDERING POLES. THE CONTRACTOR WILL BE RESPONSIBLE FOR REQUESTING AND SCHEDULING ANY INSPECTIONS THE POWER COMPANY MAY

ITEM 632 - POWER SERVICE, AS PER PLAN, CONTINUED

REQUIRE FOR THE POWER SERVICE HOOK UP. THE CONTRACTOR SHALL CONTACT ODOT DISTRICT 8 TRAFFIC OPERATIONS TO OBTAIN THE POWER SERVICE ADDRESS TO BE USED FOR ON ALL INSPECTIONS. ONCE THE SIGNAL HAS PASSED INSPECTION, THE CONTRACTOR WILL NOTIFY THE PROJECT ENGINEER WHO WILL IN TURN NOTIFY ODOT DISTRICT 8 TRAFFIC OPERATIONS. ODOT DISTRICT 8 TRAFFIC OPERATIONS WILL THEN MAKE APPLICATION FOR POWER FROM THE UTILITY.

UNDER NO CIRCUMSTANCES SHALL THE CONTRACTOR SPLIC POWER CABLE INTO THE POWER COMPANY'S CIRCUITS. THE VOLTAGE SUPPLIED SHALL BE NOMINALLY 120 VOLTS. THE CONTRACTOR IS RESPONSIBLE FOR OBTAINING ANY NECESSARY PERMITS AND THE PAYING OF ALL FEES. THE EXISTING METER, IF APPLICABLE, IS THE PROPERTY OF THE POWER COMPANY AND SHALL NOT BE REMOVED BY THE CONTRACTOR. PRIOR TO THE EXISTING TRAFFIC SIGNAL REMOVAL, ODOT DISTRICT 8 TRAFFIC OPERATIONS WILL REQUEST THE REMOVAL OF THE METER AND CLOSURE OF THE ACCOUNT.

THE CONTRACTOR SHALL FURNISH AND INSTALL AN ALUMINUM STICKER WITH 4-INCH LETTERING TO THE CABINET. ADDRESS MUST BE VISIBLE FROM THE STREET.

THE DEPARTMENT WILL MEASURE ITEM 632, POWER SERVICE, AS PER PLAN, BY THE NUMBER OF COMPLETE UNITS AND WILL INCLUDE: WEATHERHEAD, CONDUIT, FITTINGS, CLAMPS, AND OTHER NECESSARY HARDWARE, INSTALLATION OF METER BASE, GROUND WIRE CONNECTIONS, DISCONNECT SWITCH WITH ENCLOSURE, AND COORDINATION WORK WITH UTILITIES.

ANY ADDITIONAL CABLE OR WOOD POLES NECESSARY TO ESTABLISH A POWER SERVICE WITH THE UTILITY COMPANY SHALL BE COVERED UNDER THE PERTINENT PAY ITEMS.

ITEM 632 SIGNAL SUPPORT FOUNDATION

PRIOR TO ORDERING THE SIGNAL SUPPORTS, THE CONTRACTOR SHALL CONTACT OUPS TO HAVE ALL THE UTILITIES LOCATED IN THE FIELD THEN MEET WITH THE PROJECT ENGINEER TO LOCATE THE PROPOSED SUPPORT LOCATION TO INSURE THERE ARE NO CONFLICTS WITH UTILITIES. IF THERE ARE ISSUES, PROJECT ENGINEER SHALL PROVIDE GUIDANCE AS TO THE RELOCATION OF THE SUPPORT POLES.

PAYMENT WILL BE AT THE CONTRACT UNIT PRICE AND WILL BE FULL COMPENSATION FOR ALL LABOR, MATERIALS, TOOLS, EQUIPMENT AND OTHER INCIDENTALS NECESSARY FOR EACH SUPPORT FURNISHED, IN PLACE, COMPLETE AND ACCEPTED.

ITEM 633 UNINTERPRETABLE POWER SUPPLY (UPS), 1000 WATT, AS PER PLAN

IN ADDITION TO THE REQUIREMENTS OF C&MS 633 AND 733, POLE ATTACHMENT HARDWARE WILL BE INCLUDED FOR POLE MOUNTED CABINETS, AND A CABINET RISER (8 INCH MINIMUM) AND ANCHOR BOLTS WILL BE PROVIDED FOR BASE-MOUNTED CABINETS. BEFORE PERFORMING THE WORK, THE CONTRACTOR, THE DISTRICT TRAFFIC ENGINEER AND THE PROJECT ENGINEER WILL PERFORM A SITE INSPECTION TO ESTABLISH THE LOCATION OF THE UPS CABINET AND FOUNDATION.

THE UPS CABINET SHALL INCLUDE A GENERATOR POWER PANEL WITH A HEAVY DUTY POWER RELAY VERSUS THE LINE VOLTAGE GENERATOR SWITCH. THE GENERATOR INLET SHALL BE A RECESSED PANEL WITH A DOOR THAT IS FLUSH WITH THE EXTERNAL SIDE OF THE UPS CABINET. IT SHALL INCLUDE A RECESSED PLUG, AUTOMATIC TRANSFER SWITCH AND A DOOR THAT SECURELY CLOSES OVER THE POWER CORD.

THE UPS OUTPUT NOTIFICATIONS FOR ON BATTERY, BATTERY 2-HOUR TIMER, AND LOW BATTERY SHALL BE WIRED INTO THE CABINET BACK PANEL TO PROVIDE SPECIAL STATUS ALARMS FOR EACH OUTPUT INTO THE SIGNAL CONTROLLER.

ITEM 633 UNINTERPRETABLE POWER SUPPLY (UPS), 1000 WATT, AS PER PLAN, CONTINUED

THIS ITEM SHALL INCLUDE A RED LED STATUS INDICATOR LAMP TO ALLOW MAINTENANCE PERSONNEL AND LAW ENFORCEMENT TO QUICKLY ASSESS WHETHER A TRAFFIC SIGNAL CABINET IS BEING POWERED BY A UPS. THE LED HOUSING SHALL BE NEMA 4X, IP65 OR IP66, RATED FOR OUTDOOR USE AND BE TAMPER/SHATTER RESISTANT. IT SHALL BE A DOME ENCLOSURE CONTAINING A RED LENS WITH LED THAT IS VISIBLE FROM 100 FOOT MINIMUM. THE ENCLOSURE AND LED MODULE SHOULD BE PLACED AND CENTERED ON THE TOP SURFACE OF THE UPS CABINET AND SEALED FROM WATER INTRUSION. IT SHOULD BE WIRED USING MINIMUM 20GA STRANDED, INSULATED HOOKUP WIRE TO THE STATUS RELAY OUTPUTS OF THE UPS. THE WIRES SHALL BE TERMINATED BY LUGS AT THE DISPLAY END AND PERMANENTLY LABELED "BACKUP POWER STATUS DISPLAY," WITH WIRE POLARITY INDICATED. THE RED LED SHALL ONLY ILLUMINATE TO INDICATE THE CABINET IS OPERATING UNDER UPS BACKUP POWER (THE "BACKUP" OPERATING CONDITION). THIS ITEM INCLUDES PROGRAMMING THE UPS STATUS RELAY OUTPUTS TO PRODUCE THE LAMP STATUS DISPLAYS. THESE STATUS DISPLAYS WILL BE SOLID 100% DUTY CYCLE (NOT FLASHING) DISPLAYS. THE OPERATING VOLTAGE OF THE LED LAMP SHALL BE 120V AC UNLESS OTHERWISE INDICATED.

ITEM 633 CONTROLLER ITEM MISC.: CONTROLLER UNIT, TYPE COBALT, WITH ASC-3 SOFTWARE, WITH CABINET, TYPE 332

IN ADDITION TO THE REQUIREMENTS OF C&MS 633 AND 733, THE FOLLOWING REQUIREMENTS SHALL APPLY:

THE CONTROLLER SHALL BE AN ECONOLITE COBALT RACKMOUNT AND SHALL HAVE AN ATC COMPLIANT ENGINE BOARD. THE CONTROLLER SHALL BE DESIGNED FOR USE IN CALTRANS CABINETS USING THE BACKSIDE CI CONNECTOR AS THE PRIMARY CONTROLLER-TO-CABINET INTERFACE. THE CONTROLLER SHALL BE SUPPLIED WITH ASC-3 SOFTWARE. FOR WARRANTY PURPOSES, A VENDOR-SPECIFIC DECAL, AS PER ODOT CMS 733.02 SHALL BE APPLIED TO EACH CONTROLLER UNIT AT THE TIME OF DELIVERY TO THE PROJECT.

THE CABINET SHALL BE FURNISHED WITH AN EDI 2018ECLIF CONFLICT MONITOR AS ALLOWED ON THE TAP/APPRIROVED PRODUCTS LIST. THE CONFLICT MONITOR TEST SHALL BE PERFORMED AT A MAXIMUM OF SIX (6) MONTHS PRIOR TO THE INSTALLATION OF THE CONTROLLER IN THE FIELD. THE CURRENT CONFLICT MONITOR TEST SHALL BE STORED IN THE CABINET UPON INSTALLATION IN THE FIELD. AN AUXILIARY OUTPUT FILE SHALL ALSO BE PROVIDED IN THE CABINET.

THE CONTRACTOR SHALL NOT REASSIGN THE CABINET DETECTOR INPUTS TO REDUCE THE NUMBER OF 2-CHANNEL DETECTOR UNITS SUPPLIED BUT SHALL USE THE STANDARD CALTRANS INPUT FILE DESIGNATIONS.

A CABINET RISER SHALL ALSO BE SUPPLIED AS PART OF THIS PAY ITEM.

THE CONTROLLER SHALL BE INSTALLED WITH THE TIMING PLAN PROGRAMMED MAKING THE CONTROLLER FULLY FUNCTIONAL AND READY FOR INSTALLATION.


PAYMENT SHALL BE MADE AT THE UNIT PRICE BID FOR EACH UNIT, COMPLETE IN PLACE, AND SHALL INCLUDE ALL LABOR, EQUIPMENT, MATERIAL, CABINET AND MOUNTING HARDWARE, AND ALL OTHER INCIDENTALS NECESSARY FOR A FULLY OPERATIONAL CONTROLLER CABINET, ALL CONNECTIONS TESTED AND ACCEPTED.

ITEM 633 CABINET FOUNDATION, AS PER PLAN

THIS ITEM SHALL CONSIST OF CONSTRUCTING A MODIFIED CONTROLLER CABINET FOUNDATION IN ACCORDANCE WITH O.D.O.T. STANDARD CONSTRUCTION DRAWING TC-83.20 AND O.D.O.T. CONSTRUCTION MATERIAL SPECIFICATIONS 633.10, 499, AND 511, EXCEPT AS SHOWN IN THE DETAIL BELOW.

- * THE SIZE OF THE UPS FOUNDATION MAY VARY BASED ON THE CABINET SIZE PROVIDED.
- * THE UPS ELEVATION SHOULD MATCH CABINET FOUNDATION ELEVATION.
- * THE UPS CABINET SHALL BE MOUNTED FLUSH UP AGAINST THE SIGNAL CABINET AND SEALED.
- * CONDUIT AND WIRING FROM THE SIGNAL CABINET TO THE UPS CABINET SHALL BE INSTALLED THROUGH THE CABINET RISER.


PAYMENT FOR ITEM 633, CABINET FOUNDATION, SHALL BE MADE AT THE CONTRACT UNIT PRICE PER EACH COMPLETE AND IN PLACE, AND SHALL INCLUDE ALL LABOR, MATERIALS, AND EQUIPMENT NECESSARY TO COMPLETE THE WORK.

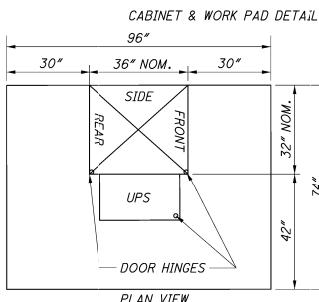

ITEM 633 CONTROLLER WORK PAD, AS PER PLAN

THIS ITEM SHALL CONSIST OF CONSTRUCTING A CONTROLLER WORK PAD IN ACCORDANCE WITH O.D.O.T. STANDARD CONSTRUCTION DRAWING TC-83.20 EXCEPT THE SIZE AND SHAPE OF THE PAD SHALL BE AS SHOWN IN THE DETAIL BELOW.

PAYMENT FOR ITEM 633, CONTROLLER WORK PAD, SHALL BE MADE AT THE CONTRACT UNIT PRICE PER EACH COMPLETE AND IN PLACE, AND SHALL INCLUDE ALL LABOR, MATERIALS, AND EQUIPMENT NECESSARY TO COMPLETE THE WORK.

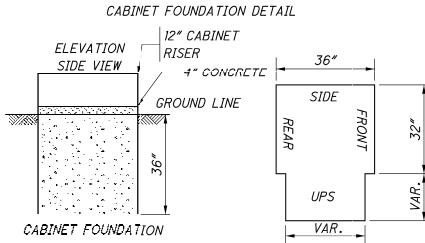

GROUNDING AND BONDING

THE REQUIREMENTS OF THE CONSTRUCTION AND MATERIAL SPECIFICATIONS (CMS) AND THE TC SERIES OF STANDARD CONSTRUCTION DRAWINGS ARE MODIFIED AS FOLLOWS:

1. ALL METALLIC PARTS CONTAINING ELECTRICAL CONDUCTORS SHALL BE PERMANENTLY JOINED TO FORM AN EFFECTIVE GROUND FAULT CURRENT PATH BACK TO THE GROUNDED CONDUCTOR IN THE POWER SERVICE DISCONNECT SWITCH.
- A. PROVIDE AN EQUIPMENT GROUNDING CONDUCTOR IN METALLIC CONDUITS (725.04) IN ADDITION TO THE CONDUCTORS SPECIFIED AND BOND THE CONDUIT TO THIS GROUNDING CONDUCTOR.
- B. WHEN AN EQUIPMENT GROUNDING CONDUCTOR IS REQUIRED IN PLASTIC CONDUIT (725.05), THE INSTALLATION SHALL INCLUDE A SEPARATE EQUIPMENT GROUNDING CONDUCTOR IN ADDITION TO THE CONDUCTORS SPECIFIED.
- C. METALLIC CONDUIT CARRYING THE LOOP WIRES FROM IN THE PAVEMENT TO THE PULL BOX SPLICE LOCATION WILL ONLY BE BONDED AT THE PULL BOX END, AND WILL NOT CONTAIN AN EQUIPMENT GROUNDING CONDUCTOR.
- D. IF MULTIPLE CONDUIT RUNS BEGIN AND END AT THE SAME POINTS, ONLY ONE EQUIPMENT GROUNDING CONDUCTOR IS REQUIRED.
- E. IF AN EQUIPMENT GROUNDING CONDUCTOR IS NEEDED IN CONDUIT BETWEEN SIGNALIZED INTERSECTIONS FOR UNDERGROUND INTERCONNECT CABLE, THE GROUNDING SYSTEM FOR EACH SIGNALIZED INTERSECTION WILL BE SEPARATED ABOUT MIDWAY BETWEEN THE INTERSECTIONS.
- F. THE MESSENGER WIRE AT SIGNALIZED INTERSECTIONS WILL BE USED AS THE CONDUCTIVE PATH FROM CORNER TO CORNER IF CONDUIT IS NOT PROVIDED UNDER THE ROADWAY. WHEN CONDUIT CONNECTS THE CORNERS OF AN INTERSECTION, AN EQUIPMENT GROUNDING CONDUCTOR SHALL BE USED IN THE CONDUIT.
2. CONDUITS.
- A. THE 725.04 CONDUIT SHALL HAVE GROUNDING BUSHINGS INSTALLED AT ALL TERMINATION POINTS. THE BUSHING MATERIAL SHALL BE COMPATIBLE WITH GALVANIZED STEEL CONDUIT AND THE GROUNDING LUG MATERIAL SHALL BE COMPATIBLE FOR USE WITH COPPER WIRE. THREADED OR COMPRESSION TYPE BUSHINGS MAY BE USED.
- B. THE 725.05 CONDUIT SHALL HAVE THE INSIDE AND OUTSIDE DIAMETERS OF THE CONDUIT UNBURNED AT ALL TERMINATION POINTS.
- C. BOTH ENDS OF METALLIC CONDUIT SHALL BE BONDED TO THE EQUIPMENT GROUNDING CONDUCTOR.
- D. METALLIC CONDUIT MAY BE BONDED TO METALLIC BOXES THROUGH THE USE OF CONDUIT FITTINGS UL APPROVED FOR THIS TYPE OF CONNECTION, WITH THE BOX BONDED TO THE EQUIPMENT GROUNDING CONDUCTOR.
3. WIRE FOR GROUNDING AND BONDING.
- A. USE INSULATED, COPPER WIRE FOR THE EQUIPMENT GROUNDING CONDUCTOR. BONDING JUMPERS IN BOXES AND ENCLOSURES MAY BE BARE OR INSULATED COPPER WIRE. WIRE SIZE SHALL BE AS FOLLOWS:
 - I. USE 4 AWG BETWEEN THE POWER SERVICE AND SUPPORTS, POLES, PEDESTALS, CONTROLLER OR FLASHER CABINETS.
 - II. USE A MINIMUM 8 AWG BETWEEN LOOP DETECTOR PULL BOXES AND THE FIRST CONDUIT THAT REQUIRES A LARGER SIZE AS SPECIFIED IN 3.A.I ABOVE.
 - III. USE A MINIMUM 8 AWG BETWEEN THE "PREPARE TO STOP WHEN FLASHING" INSTALLATION (INCLUDING SUPPORT) AND THE FIRST CONDUIT THAT REQUIRES A LARGER SIZE AS SPECIFIED IN 3.A.I ABOVE.

GROUNDING AND BONDING, CONTINUED

- IV. THE INSULATION SHALL BE GREEN OR GREEN WITH YELLOW STRIPE(S). FOR 4 AWG OR LARGER, INSULATION MAY ALSO BE BLACK WITH GREEN TAPE/LABELS INSTALLED AT ALL ACCESS POINTS.
- B. IN A HIGHWAY LIGHTING SYSTEM, THE EQUIPMENT GROUNDING CONDUCTOR SHALL BE THE SAME WIRE SIZE AS THE DUCT CABLE OR DISTRIBUTION CABLE CIRCUIT CONDUCTORS, WITH THE MINIMUM CONDUCTOR SIZE OF 4 AWG. BONDING JUMPERS WILL BE MINIMUM SIZE 4 AWG.
4. GROUND ROD.
- A. A $\frac{1}{4}$ INCH SCHEDULE 40 PVC CONDUIT WILL BE USED IN FOUNDATIONS AND CONCRETE WALLS FOR THE GROUNDING CONDUCTOR (GROUND WIRE) RACEWAY TO THE GROUND ROD. SHOULD METALLIC CONDUIT BE USED, BOTH ENDS OF THE CONDUIT SHALL BE BONDED TO THE GROUNDING CONDUCTOR.
- B. THE TYPICAL GROUNDING CONDUCTOR (GROUND WIRE) SHALL BE 4 AWG INSULATED, COPPER.
5. THE GREEN CONDUCTOR IN SIGNAL CABLES (CONDUCTOR #4) SHALL NOT BE USED TO SUPPLY POWER TO A SIGNAL INDICATION. IT WILL BE CONNECTED TO THE SIGNAL BODY AS AN EQUIPMENT GROUND IN ALUMINUM HEADS AND IT WILL BE UNUSED IN PLASTIC HEADS. UNUSED CONDUCTORS SHALL BE GROUNDED IN THE CABINET. TYPICAL USE OF CONDUCTORS IS AS FOLLOWS:

COND.	NO. COLOR	VEHICLE SIGNAL	PEDESTRIAN SIGNAL
1	BLACK	GREEN BALL	*#1 WALK
2	WHITE	AC NEUTRAL	AC NEUTRAL
3	RED	RED BALL	*#1 DW/FDW
4	GREEN	EQUIPMENT GROUND	EQUIPMENT GROUND
5	ORANGE	YELLOW BALL	*#2 DW/FDW
6	BLUE	GREEN ARROW	*#2 WALK
7	WHITE/BLACK STRIPE	YELLOW ARROW	NOT USED

6. POWER SERVICE AND DISCONNECT SWITCH.

- A. AT THE POWER SERVICE LOCATION, THE GROUNDING CONDUCTOR (GROUND WIRE) FROM THE DISCONNECT SWITCH NEUTRAL (AC-) BAR TO THE GROUND ROD SHALL BE A CONTINUOUS, UN-SPliced CONDUCTOR. IF SPLICED, IT SHALL BE AN EXOTHERMIC WELD BUTT SPLICE.
- B. THE SERVICE NEUTRAL (AC-) SHALL ONLY BE CONNECTED TO GROUND AT THE PRIMARY POWER SERVICE DISCONNECT SWITCH.
- C. NEMA CONTROLLER CABINETS: IF A POWER SERVICE DISCONNECT SWITCH IS LOCATED BEFORE THE CONTROLLER CABINET, THE NEUTRAL (AC-) AND THE GROUNDING BARS IN THE CONTROLLER CABINET SHALL NOT BE CONNECTED TOGETHER AS SHOWN IN NEMA TS-2, FIGURE 5-4.

GROUNDING AND BONDING, CONTINUED

- II. IF SECONDARY DISCONNECT SWITCHES ARE CONNECTED AFTER THE PRIMARY DISCONNECT SWITCH, THE NEUTRAL (AC-) SHALL ONLY BE GROUNDED AT THE PRIMARY SWITCH. EQUIPMENT GROUNDING CONDUCTORS SHALL BE BROUGHT TO THE PRIMARY SWITCH, BUT SHALL BE GROUNDED AT BOTH SECONDARY AND PRIMARY SWITCHES.
7. PAYMENT - ALL MATERIALS AND WORK REQUIRED TO COMPLETE THE EFFECTIVE GROUND FAULT CURRENT PATH SYSTEM ARE INCIDENTAL TO THE CONDUCTORS INSTALLED BY CONTRACT.

ITEM 809 ADVANCE RADAR DETECTION

THIS ITEM OF WORK SHALL CONSIST OF FURNISHING AND INSTALLING A WAVETRONIX SMARTSENSOR ADVANCE DETECTION UNIT (MOD# SS-200F). THE DETECTION UNIT SHALL INCLUDE THE FOLLOWING:

1. POWER SHALL BE PROVIDED FROM THE TRAFFIC CABINET.
2. ALL REQUIRED INPUTS CARDS SHALL BE INCLUDED IN THE TRAFFIC CABINET AND SHALL BE COMPATIBLE WITH CALTRANS, NEMA TS1 AND NEMA TS2 DETECTOR RACKS. THE CARDS SHALL PROVIDE TRUE PRESENCE DETECTOR CALLS OR CONTACT CLOSURE TO THE TRAFFIC CONTROLLER.
3. THE UNIT SHALL BE MOUNTED DIRECTLY TO A POLE OR MAST ARM, AS RECOMMENDED BY THE MANUFACTURER. CABLE(S) SHALL BE PROVIDED AS REQUIRED AND RECOMMENDED BY THE MANUFACTURER.
4. SURGE PROTECTION DEVICES, AS RECOMMENDED BY THE MANUFACTURER SHALL BE INCLUDED BOTH AT THE POLE WHERE THE UNIT IS LOCATED TO PROTECT THE UNIT AND IN THE TRAFFIC CABINET TO PROTECT THE CABINET ELECTRONICS.
5. THE MANUFACTURER'S REPRESENTATIVE SHALL BE ON SITE DURING INSTALLATION AND TESTING AND SHALL PROVIDE ON-SITE TRAINING ON THE SETUP, OPERATION AND MAINTENANCE OF THE UNIT.
6. A SERIAL TO ETHERNET COMMUNICATIONS MODULE AND ETHERNET CABLE (MINIMUM 7 FEET).
7. THE POWER SUPPLY AND COMMUNICATION MODULES SHALL BE SECURED TO A SINGLE PANEL THAT CAN BE MOUNTED INTERIOR TO THE TRAFFIC CABINET. THE PANEL SHALL INCLUDE MODULAR-PLUG STYLE CONNECTIONS FOR UP TO FOUR (4) SENSOR CABLES. ADDITIONAL SENSORS MAY BE HARD-WIRED TO THE COMMUNICATION MODULES, AS NECESSARY.

ITEM 809 STOP LINE RADAR DETECTION

THIS ITEM OF WORK SHALL CONSIST OF FURNISHING AND INSTALLING A WAVETRONIX SMARTSENSOR MATRIX DETECTION UNIT. THE DETECTION UNIT SHALL INCLUDE THE FOLLOWING:

1. POWER SHALL BE PROVIDED FROM THE TRAFFIC CABINET.
2. ALL REQUIRED INPUTS CARDS SHALL BE INCLUDED IN THE TRAFFIC CABINET AND SHALL BE COMPATIBLE WITH CALTRANS, NEMA TS1 AND NEMA TS2 DETECTOR RACKS. THE CARDS SHALL PROVIDE TRUE PRESENCE DETECTOR CALLS OR CONTACT CLOSURE TO THE TRAFFIC CONTROLLER.
3. THE UNIT SHALL BE MOUNTED DIRECTLY TO A POLE OR MAST ARM, AS RECOMMENDED BY THE MANUFACTURER. CABLE(S) SHALL BE PROVIDED AS REQUIRED AND RECOMMENDED BY THE MANUFACTURER.
4. SURGE PROTECTION DEVICES, AS RECOMMENDED BY THE MANUFACTURER SHALL BE INCLUDED BOTH AT THE POLE WHERE THE UNIT IS LOCATED TO PROTECT THE UNIT AND IN THE TRAFFIC CABINET TO PROTECT THE CABINET ELECTRONICS.
5. THE MANUFACTURER'S REPRESENTATIVE SHALL BE ON SITE DURING INSTALLATION AND TESTING AND SHALL PROVIDE ON-SITE TRAINING ON THE SETUP, OPERATION AND MAINTENANCE OF THE UNIT.
6. A SERIAL TO ETHERNET COMMUNICATIONS MODULE AND ETHERNET CABLE (MINIMUM 7 FEET).
7. THE POWER SUPPLY AND COMMUNICATION MODULES SHALL BE SECURED TO A SINGLE PANEL THAT CAN BE MOUNTED INTERIOR TO THE TRAFFIC CABINET. THE PANEL SHALL INCLUDE MODULAR-PLUG STYLE CONNECTIONS FOR UP TO FOUR (4) SENSOR CABLES. ADDITIONAL SENSORS MAY BE HARD-WIRED TO THE COMMUNICATION MODULES, AS NECESSARY.





PAYMENT FOR ITEM 809 STOP LINE RADAR DETECTION SHALL BE MADE AT THE CONTRACT UNIT PRICE FOR EACH

UNIT, COMPLETE AND IN PLACE INCLUDING ALL REQUIRED CABINET HARDWARE, MOUNTING BRACKETS, CABLES, CONDUIT AND CONNECTIONS TESTED AND ACCEPTED.

PAYMENT FOR ITEM 809 ADVANCE RADAR DETECTION SHALL BE MADE AT THE CONTRACT UNIT PRICE FOR EACH UNIT, COMPLETE AND IN PLACE INCLUDING ALL REQUIRED CABINET HARDWARE, MOUNTING BRACKETS, CABLES, CONDUIT, CONNECTIONS TESTED AND ACCEPTED, AND ANY OTHER NECESSARY HARDWARE TO ESTABLISH A FULLY FUNCTIONAL DETECTION SYSTEM.

ADDENDUM



ADDENDUM 1 - ISSUED 12/17/19
 ADDENDUM 2 - ISSUED 12/31/19

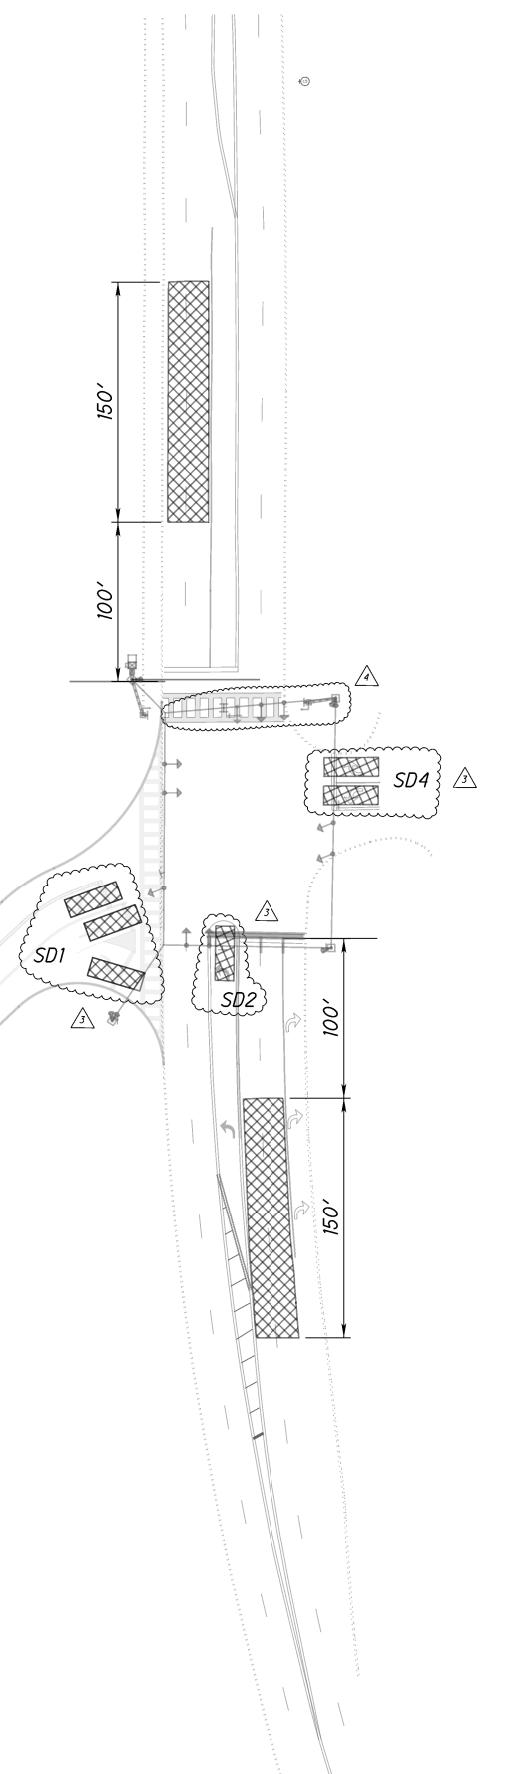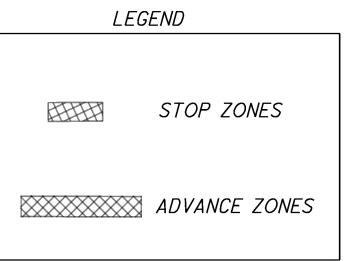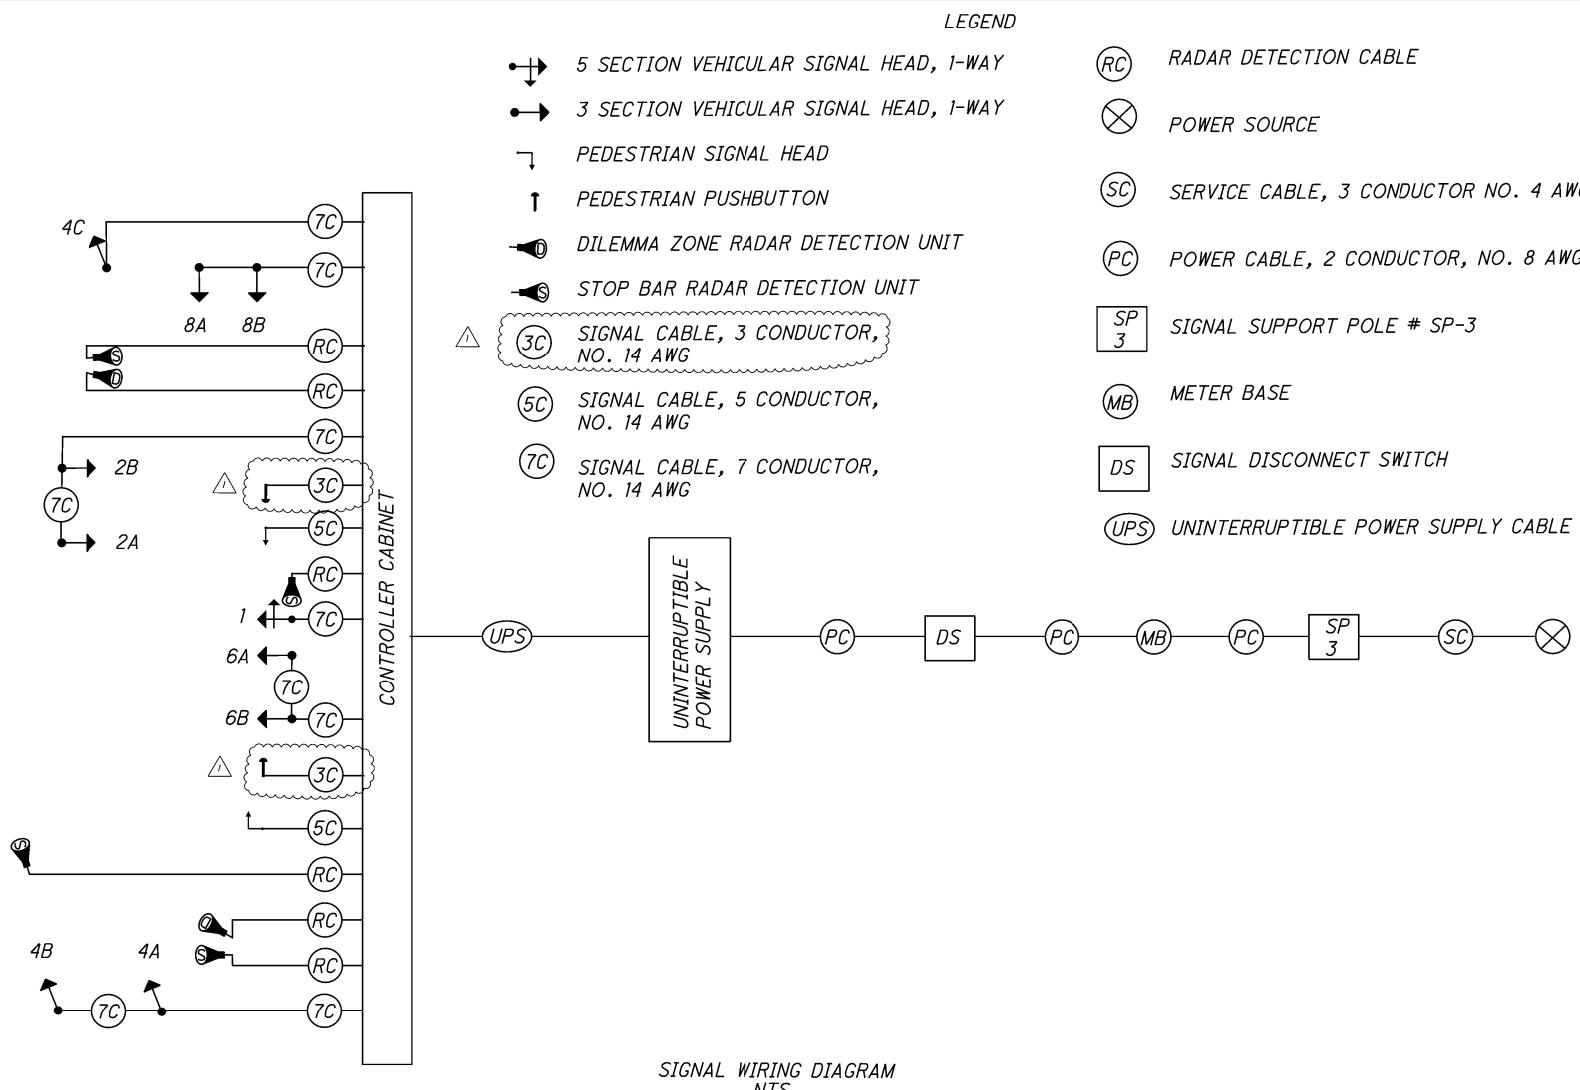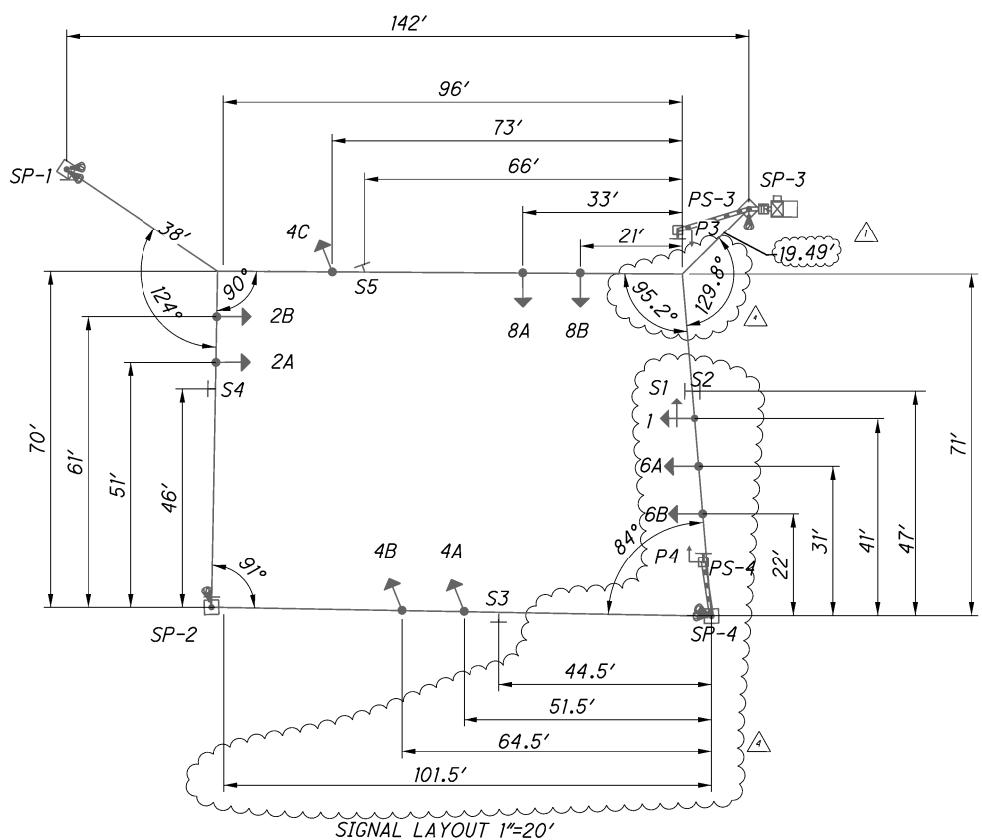

ADDENDUM

RADAR LOOP ZONES 1"=40'

ITEM #	ITEM EXT.	DESCRIPTION	UNIT	QUANTITY
ITEM 621	00100	RPM	EACH	6
ITEM 622	54000	RAISED PAVEMENT MARKER REMOVED	EACH	2
ITEM 625	25400	CONDUIT, 2"	FT	44
ITEM 625	25500	CONDUIT, 3"	FT	18
ITEM 625	29000	TRENCH	FT	33
ITEM 625	36000	PLASTIC CAUTION TAPE	FT	33
ITEM 625	30706	PULL BOX, 725.08, 24"	EACH	1
ITEM 625	32000	GROUND ROD	EACH	7
ITEM 630	60100	SIGN, FLAT SHEET	SQ. FT.	40
ITEM 630	79000	SIGN HANGER ASSEMBLY, SPAN WIRE	EACH	5
ITEM 630	79001	SIGN HANGER ASSEMBLY, MAST ARM	EACH	2
ITEM 632	05007	VEHICULAR SIGNAL HEAD, (LED), BLACK, 5-SECTION, 12" LENS, 1-WAY, POLYCARBONATE, WITH BACKPLATE, AS PER PLAN	EACH	9
ITEM 632	05087	VEHICULAR SIGNAL HEAD, (LED), BLACK, 5-SECTION, 12" LENS, 1-WAY, POLYCARBONATE, WITH BACKPLATE, AS PER PLAN	EACH	1
ITEM 632	20730	PEDESTRIAN SIGNAL HEAD (LED), (COUNTDOWN, TYPE D2	EACH	2
ITEM 632	25000	COVERING OF VEHICULAR SIGNAL HEAD	EACH	10
ITEM 633	25010	COVERING OF PEDESTRIAN SIGNAL HEAD	EACH	2
ITEM 632	26000	PEDESTRIAN RUSH BUTTON	FATHM	2
ITEM 632	30100	MESSENGER WIRE, 7 STRAND, 5/16" DIAMETER WITH ACCESSORIES	FT	387
ITEM 632	30600	TETHER WIRE, WITH ACCESSORIES	FT	387
ITEM 632	40700	SIGNAL CABLE, 7 CONDUCTOR, NO. 14 AWG	FT	847
ITEM 632	40500	SIGNAL CABLE, 5 CONDUCTOR, NO. 14 AWG	FT	262
ITEM 632	64010	SIGNAL SUPPORT FOUNDATION	EACH	4
ITEM 632	64020	PEDESTAL FOUNDATION	EACH	2
ITEM 632	68300	POWER CABLE, 2 CONDUCTOR, NO. 6 AWG	FT	61
ITEM 632	69800	SERVICE CABLE, 3 CONDUCTOR, NO. 6 AWG	FT	50
ITEM 632	70001	POWER SERVICE, AS PER PLAN	EACH	1
ITEM 632	83200	SIGNAL SUPPORT, TYPE TC-81.21, DESIGN 12	EACH	4
ITEM 632	89900	PEDESTAL, 8", TRANSFORMER BASE	EACH	2
ITEM 632	90100	REMOVAL OF TRAFFIC SIGNAL INSTALLATION	EACH	1
ITEM 633	99000	CONTROLLER ITEM MISC.: CONTROLLER UNIT, TYPE COBALT, WITH ASC-3 SOFTWARE, WITH CABINET, TYPE 332	EACH	1
ITEM 633	67191	CABINET-FOUNDATION	EACH	1
ITEM 633	67201	CONTROLLER WORK PAD, AS PER PLAN	EACH	1
ITEM 633	75001	UNINTERRUPTIBLE POWER SUPPLY (UPS), 1000 WATT, AS PER PLAN	EACH	1
ITEM 616	11000	MAINTAINING TRAFFIC	LUMP	1
ITEM 614	1110	LAW ENFORCEMENT OFFICER WITH PATROL CAR FOR ASSISTANCE	HOURS	4
ITEM 623	10000	CONSTRUCTION LA'OUT STAKES AND SURVEYING	LUMP	1
ITEM 624	10000	MOBILIZATION	LUMP	1
ITEM 644	00240	LANE LINE, 6"	MILE	0.01
ITEM 644	00300	CENTERLINE	MILE	0.03
ITEM 644	00404	CHANNELIZING LINE, 12"	FEET	181
ITEM 644	00500	STOP LINE	FEET	139
ITEM 644	00600	CROSSWALK LINE	FEET	780
ITEM 644	01300	LANE ARROW	EACH	5
ITEM 644	00900	ISLAND MARKING	SQ. FT.	60
ITEM 644	30000	REMOVAL OF PAVEMENT MARKING	FEET	200
ITEM 644	30020	REMOVAL OF PAVEMENT MARKING	EACH	1
ITEM 809	69000	ADVANCE RADAR DETECTION	EACH	2
ITEM 809	69100	STOP LINE RADAR DETECTION	EACH	4

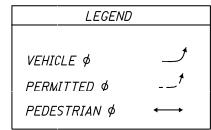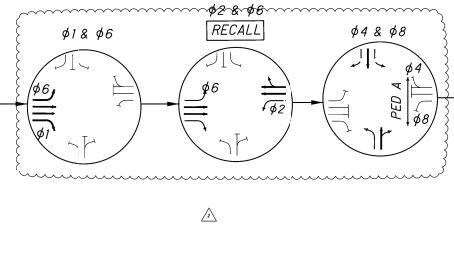

COORDINATION TIMING PLANS				
Days of Week	Plan Name	Hours	Plan No. C/S/O	Cycle Length (sec)
M-F	1	00:00 TO 11:59	-	120
SAT-SUN	2	00:00 TO 11:59	-	100



PHASE	SPLITS (G+Y+AR IN SECONDS)								OFFSET 1 (SEC)	CFFSET 2 (SEC)
	1	2	3	4	5	6	7	8		
DIRECTION	EB	WB	-	SB	-	EE	-	NB		
PLAN NO./C/S/O	INTERSECTION 1									
1	12	95	-	25	-	95	-	25	51	-
2	12	75	-	25	-	75	-	25	4	-

