EXISTING

REPLACE/BORE IN NEW CONDUCTOR w/ CONDUIT

REPLACE/PULL EXISTING CONDUCTOR THRU CONDUIT

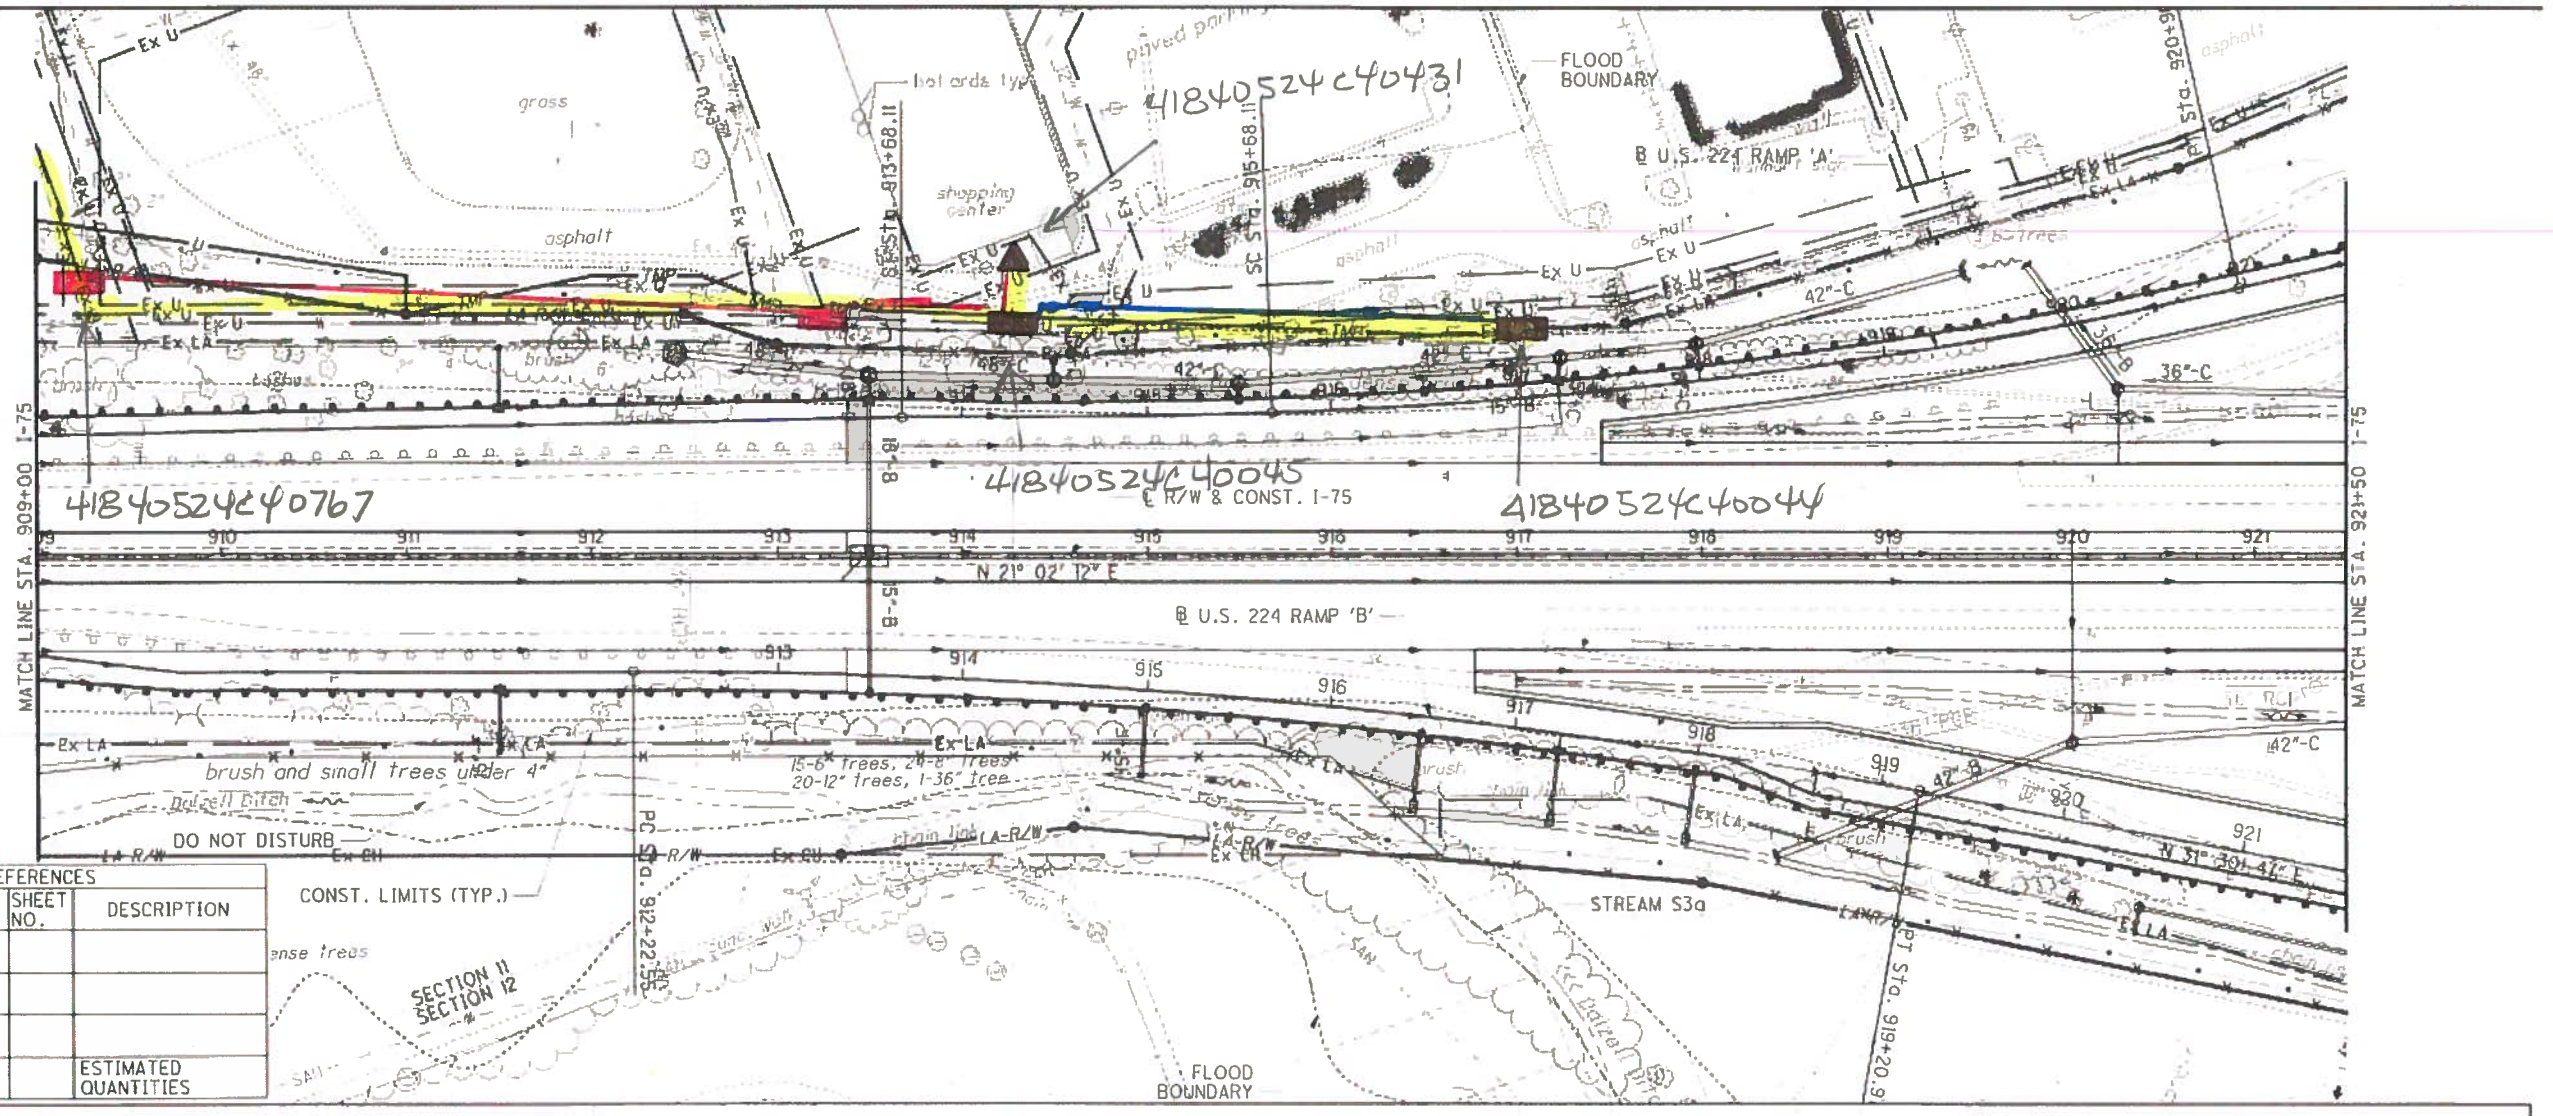

CROSS REFERENCES			
SHEET NO.	DESCRIPTION	SHEET NO.	DESCRIPTION
	CROSS SECTIONS		
			ESTIMATED QUANTITIES

FOR PROFILE SEE SHEET XX

498/2034