


REV	NOTES
0	PROPOSED REROUTE IS IN ORANGE WITH STRUCTURE IN RED.



ENGR: VJS
DRAWN: VJS



PROPOSED RELOCATION FOR  
 FINDLAY - WOODCOCK 69KV LINE  
 STRUCTURES 52-43

LINE: FINDLAY - WOODCOCK 69KV LINE
SHEET: 1 OF 1
REV 0