


LIMA MKC

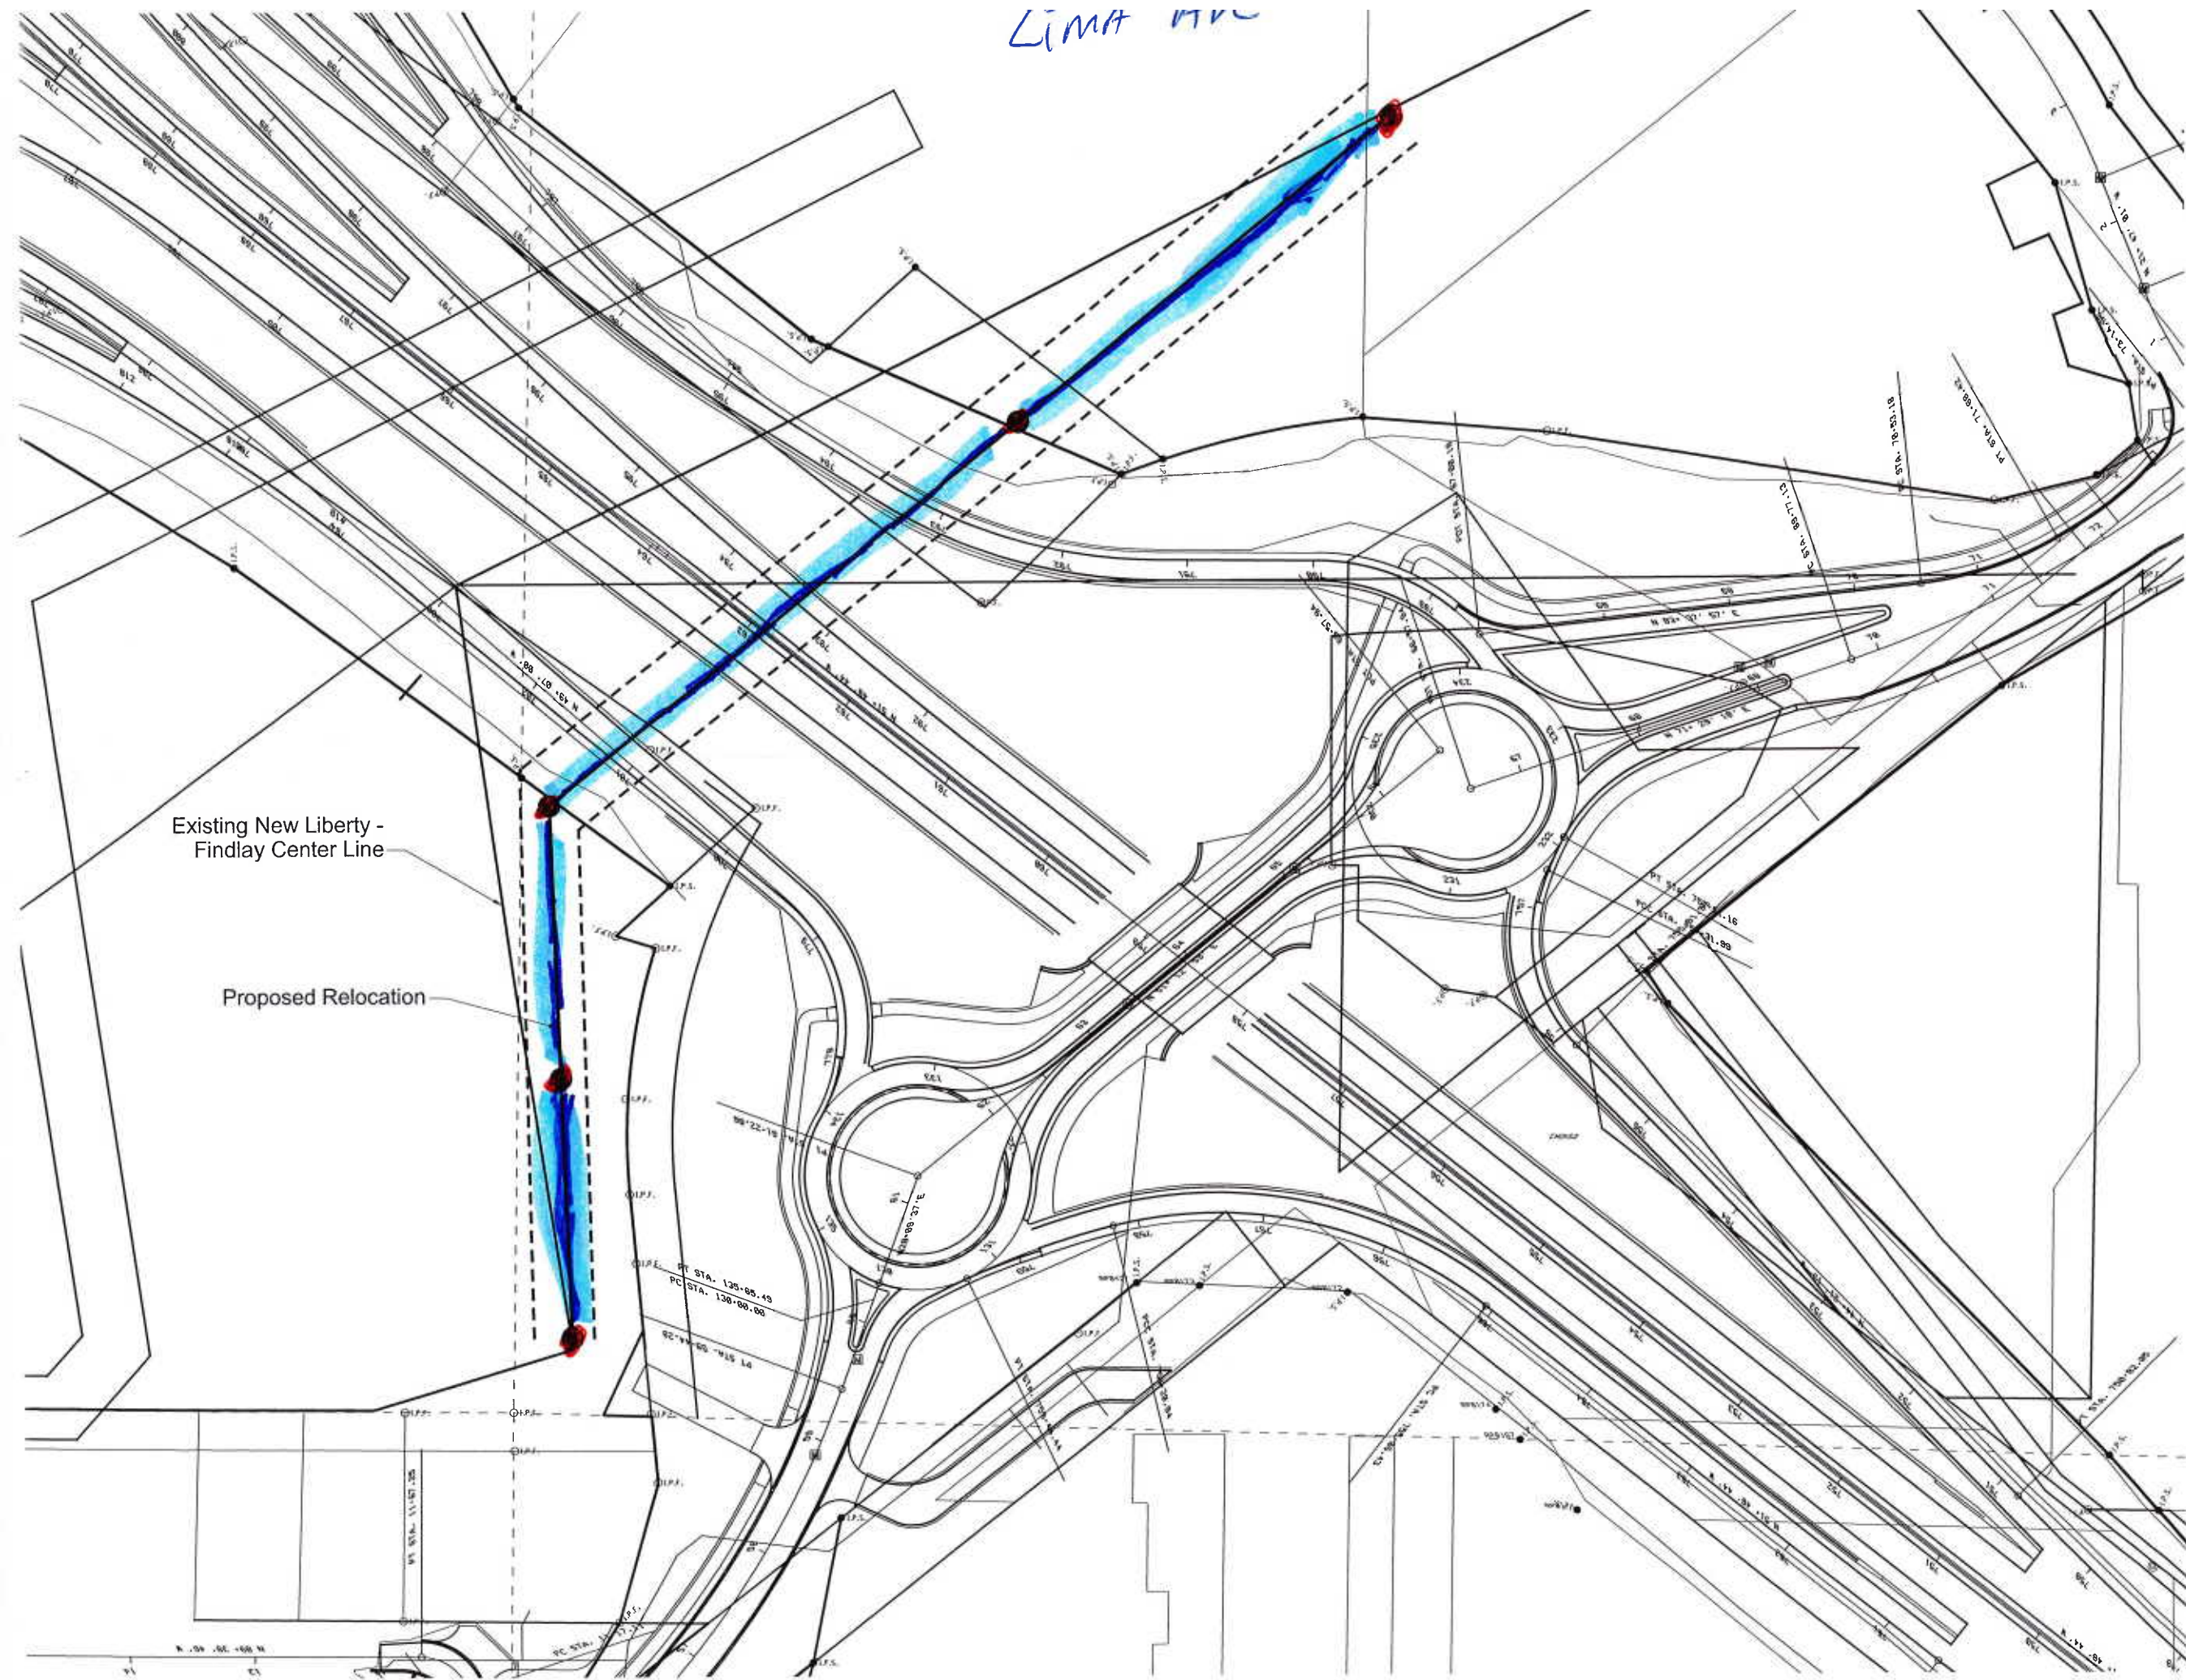

Existing New Liberty -
Findlay Center Line

Proposed Relocation


PT STA. 135+85.49
PC STA. 130+00.00



75 DE : 1
75 RA : 3
95 DE : 2
90 RA : 4
90 DE : 11

Length = 2760'
(.53 mi)

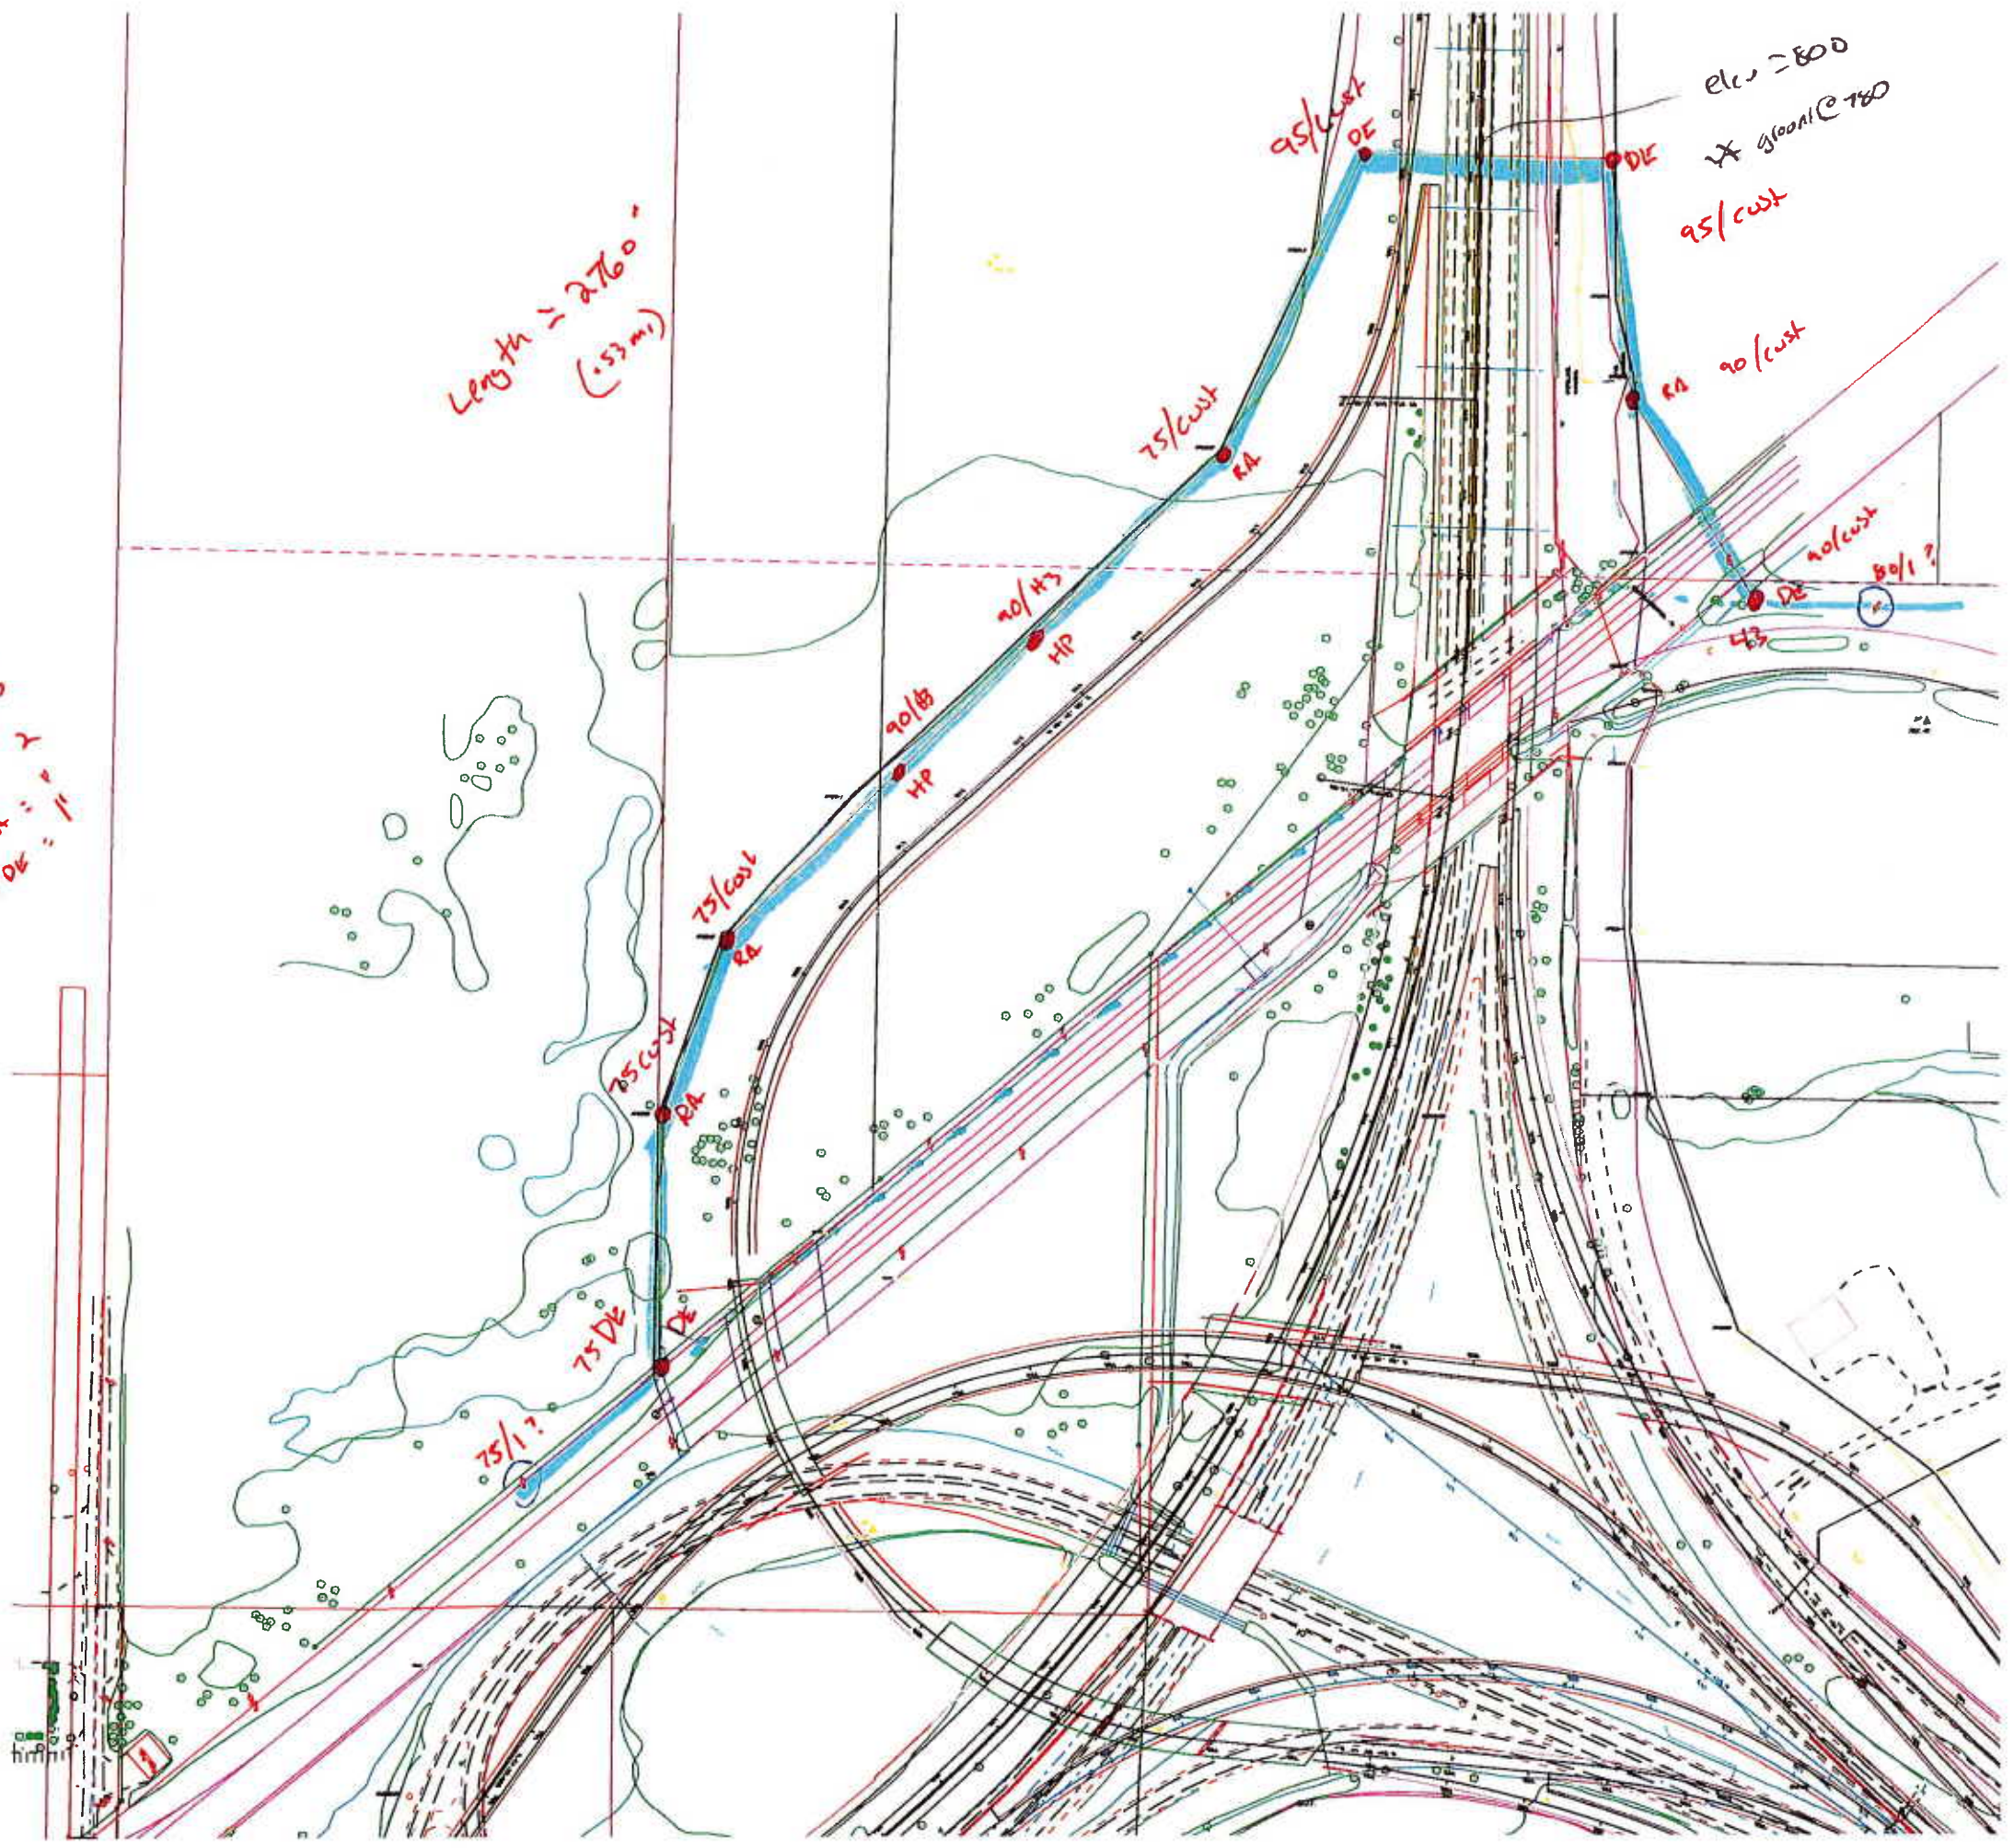

option 2

