

Existing STR 29
May also need replaced.

STR 30

STR 32


STR 33

Proposed
Relocation
Option 2

Existing New
Liberty - Findlay
34kV Line

Existing STR 31, to
be removed

REV	NOTES
0	1. PROPOSED REROUTE IS IN ORANGE WITH STRUCTURE IN RED SOLID CIRCLES. 2. EXISTING ROUTE IS IN BLUE WITH STRUCTURES IN WHITE CIRCLES. 3. STR 29 MAY ALSO NEED TO BE REPLACED (HAS NOT YET BEEN DETERMINED).

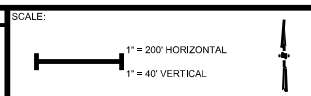

ENGR:	VJS
DRAWN:	VJS



*THIS DRAWING IS THE PROPERTY OF AMERICAN ELECTRIC POWER AND IS LOANED UPON CONDITION THAT IT IS NOT TO BE COPIED OR REPRODUCED, IN WHOLE OR IN PART, OR USED FOR PUBLISHING INFORMATION TO ANY PERSON WITHOUT THE WRITTEN CONSENT OF AMERICAN ELECTRIC POWER, OR FOR ANY PURPOSE DETRIMENTAL TO THEIR INTEREST, AND IS TO BE RETURNED UPON REQUEST.

PROPOSED RELOCATION FOR
NEW LIBERTY - FINDLAY 34.5KV LINE
STRUCTURES 30-32

LINE:	NEW LIBERTY - FINDLAY 34.5KV
SHEET:	1 OF 1
REV	0