


T:\Projects\HAN\87005\roadway\sheets\87005XS001.dgn 30-SEP-2013 10:07PM redderj

SEEDING  
END WIDTH SO.  
YDS.

END AREA VOLUME  
CUT FILL CUT FILL  
CALCULATED  
ABS  
CHECKED  
NAH

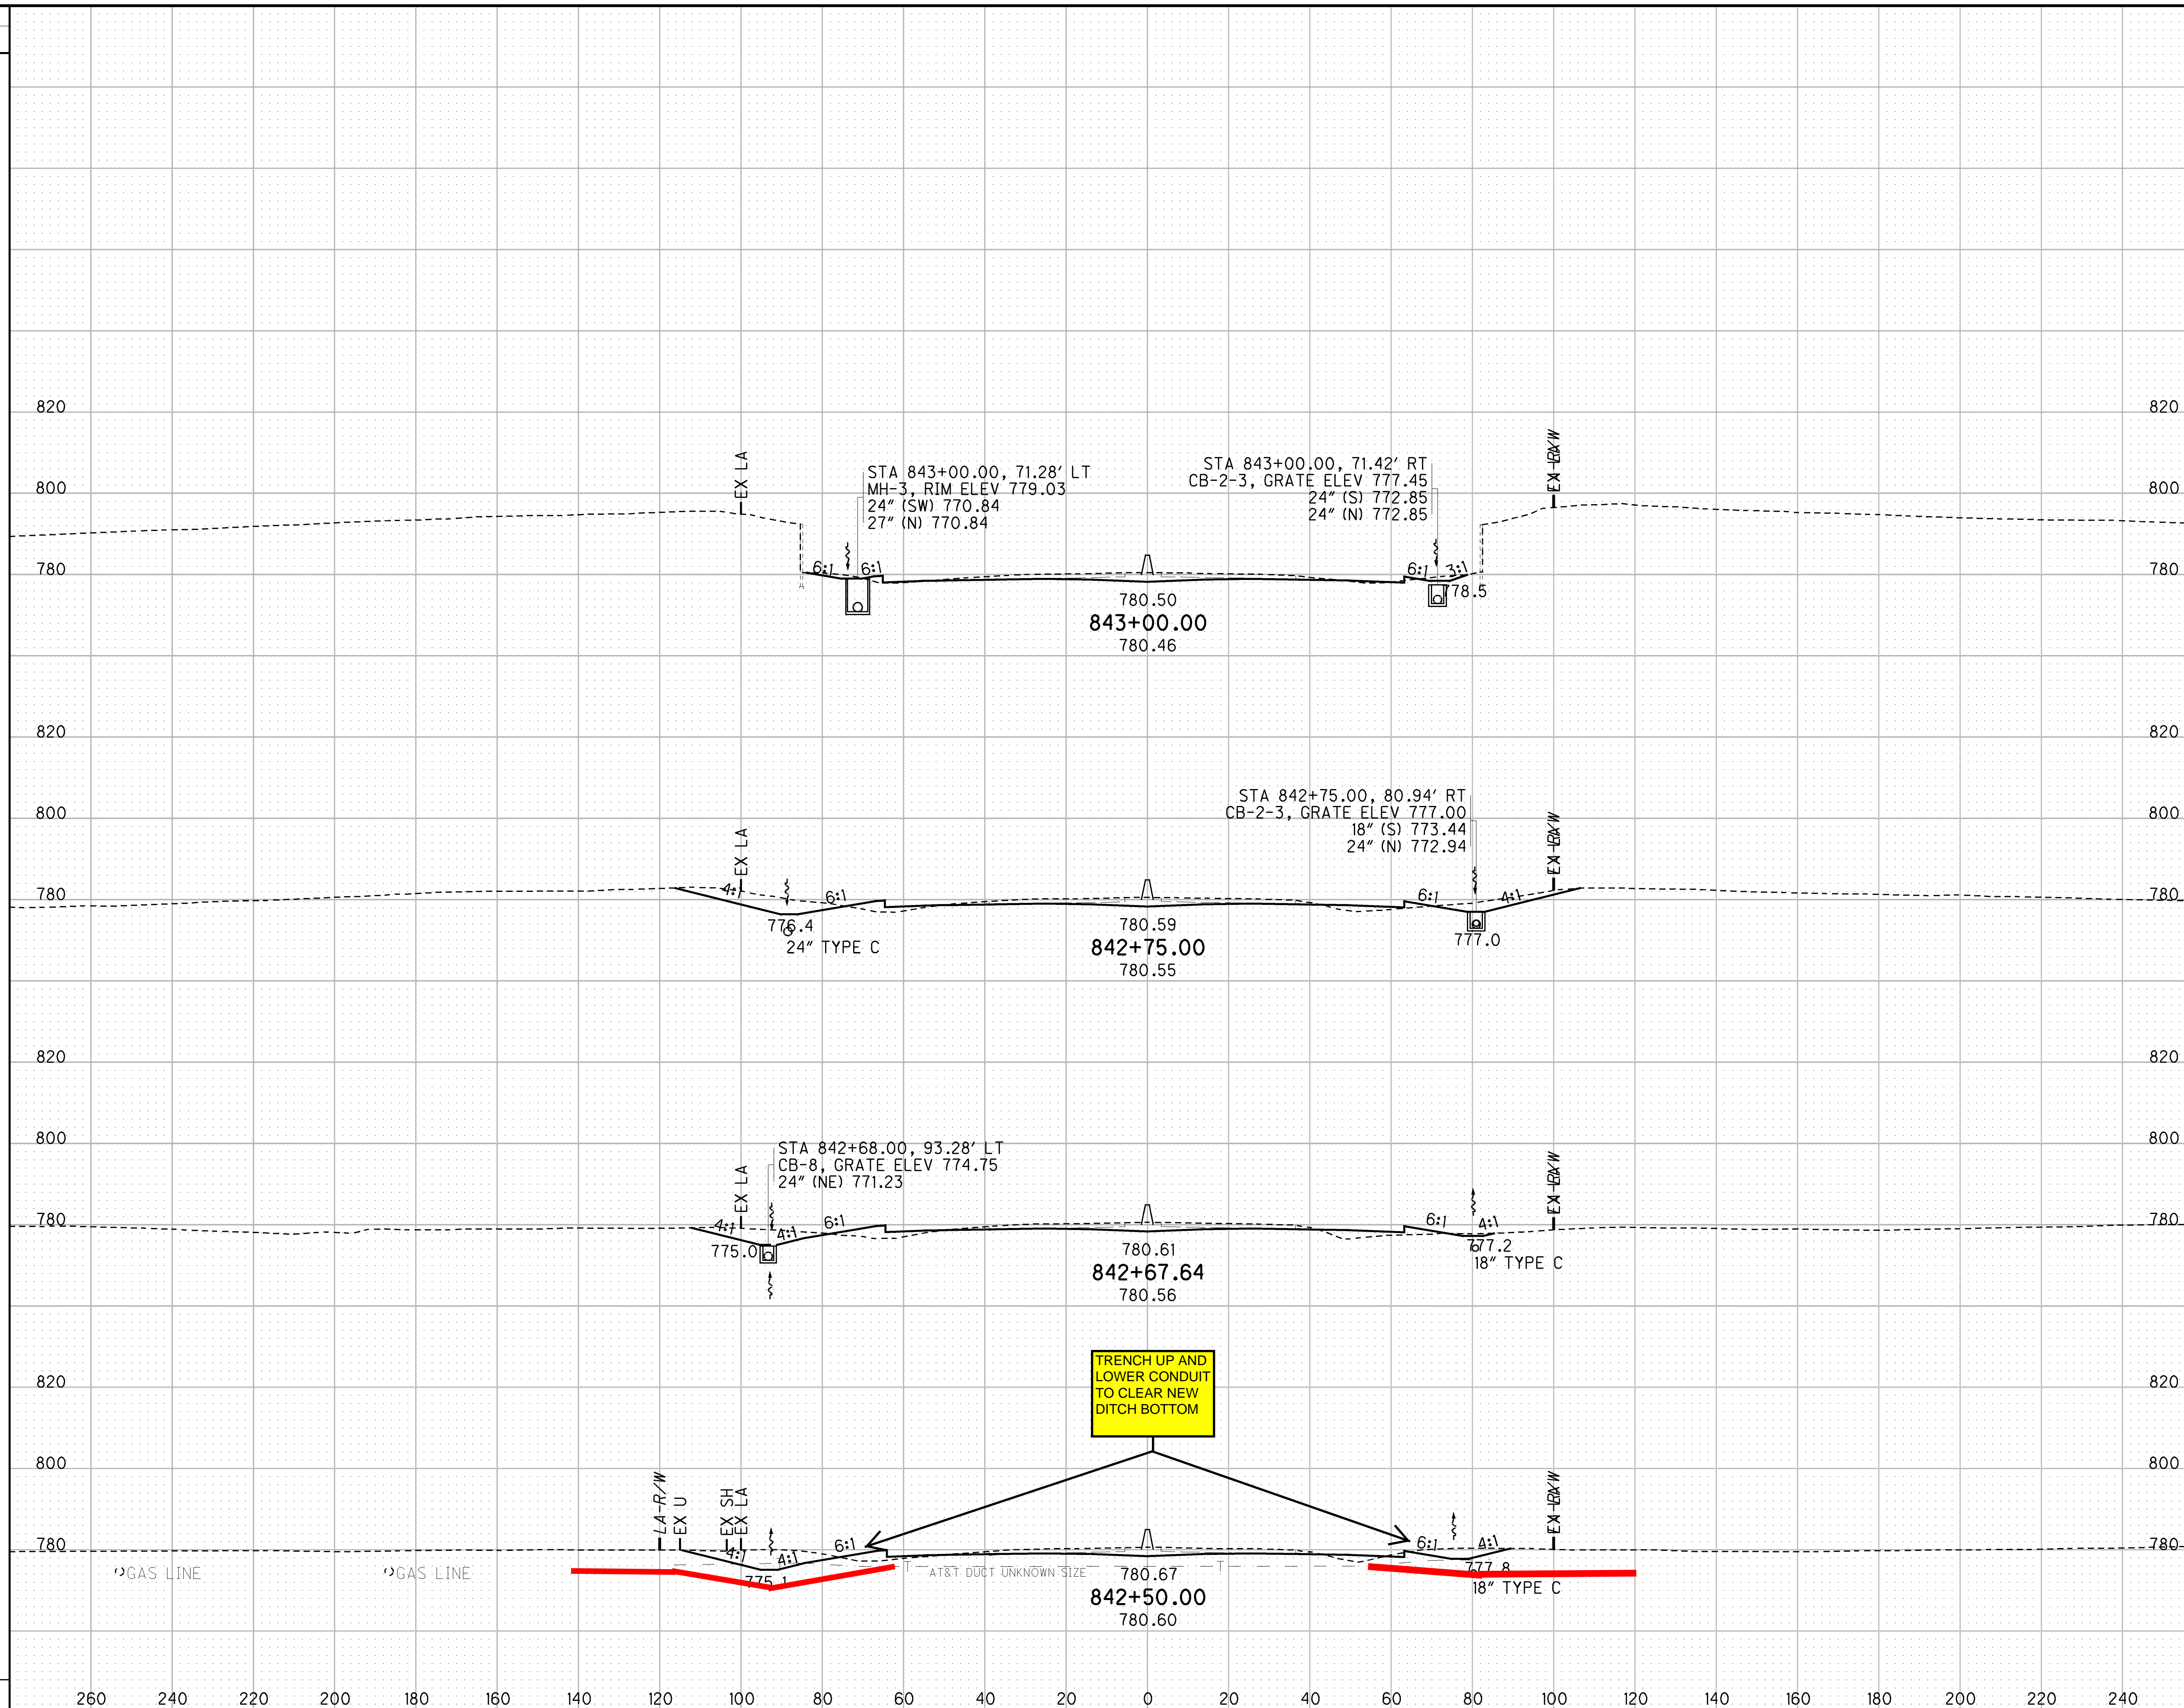

CROSS SECTIONS - I-75  
STA. 842+50.00 TO STA. 843+00.00

HAN-75-14.39

180  
842