
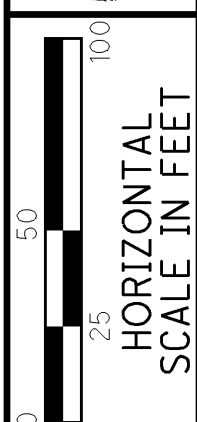
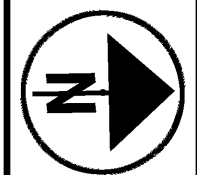
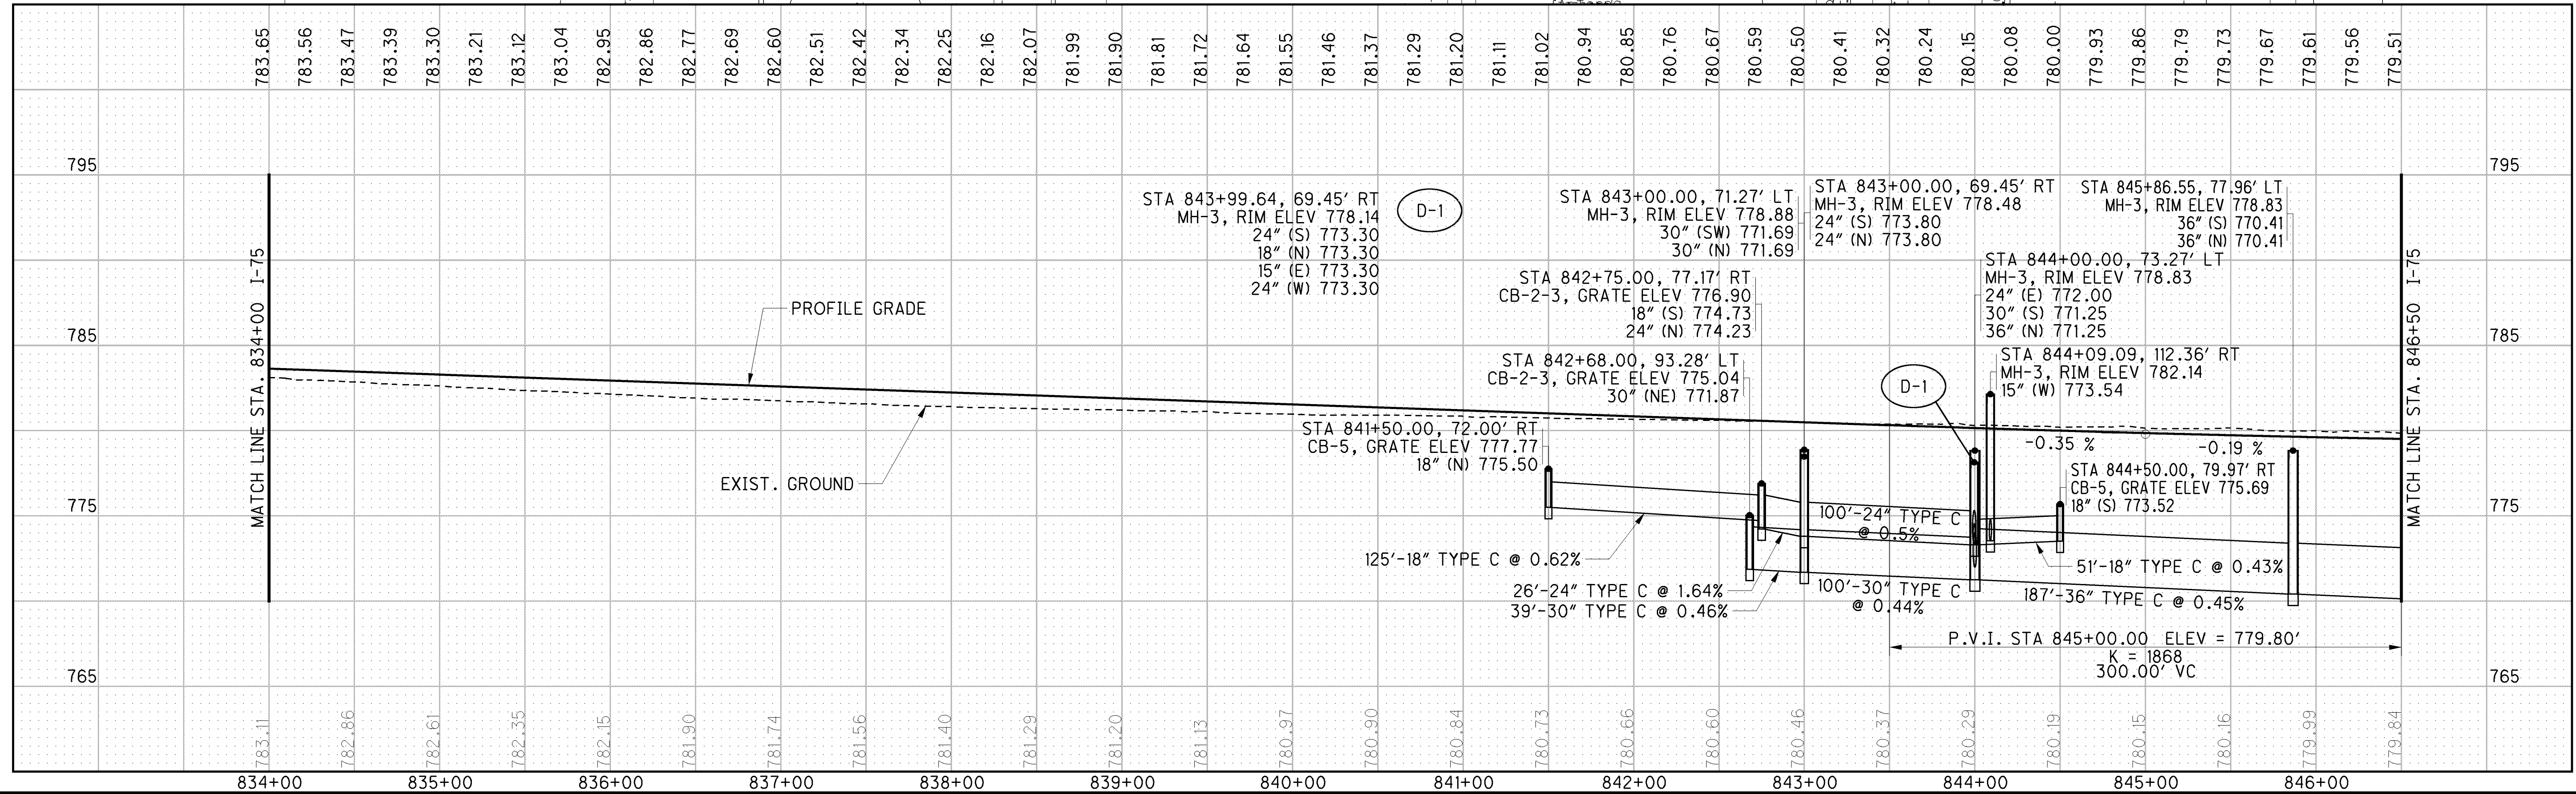


DLW 4/18/14

CROSS REFERENCES			
SHEET NO.	DESCRIPTION	SHEET NO.	DESCRIPTION
	CROSS SECTIONS		
			ESTIMATED QUANTITIES

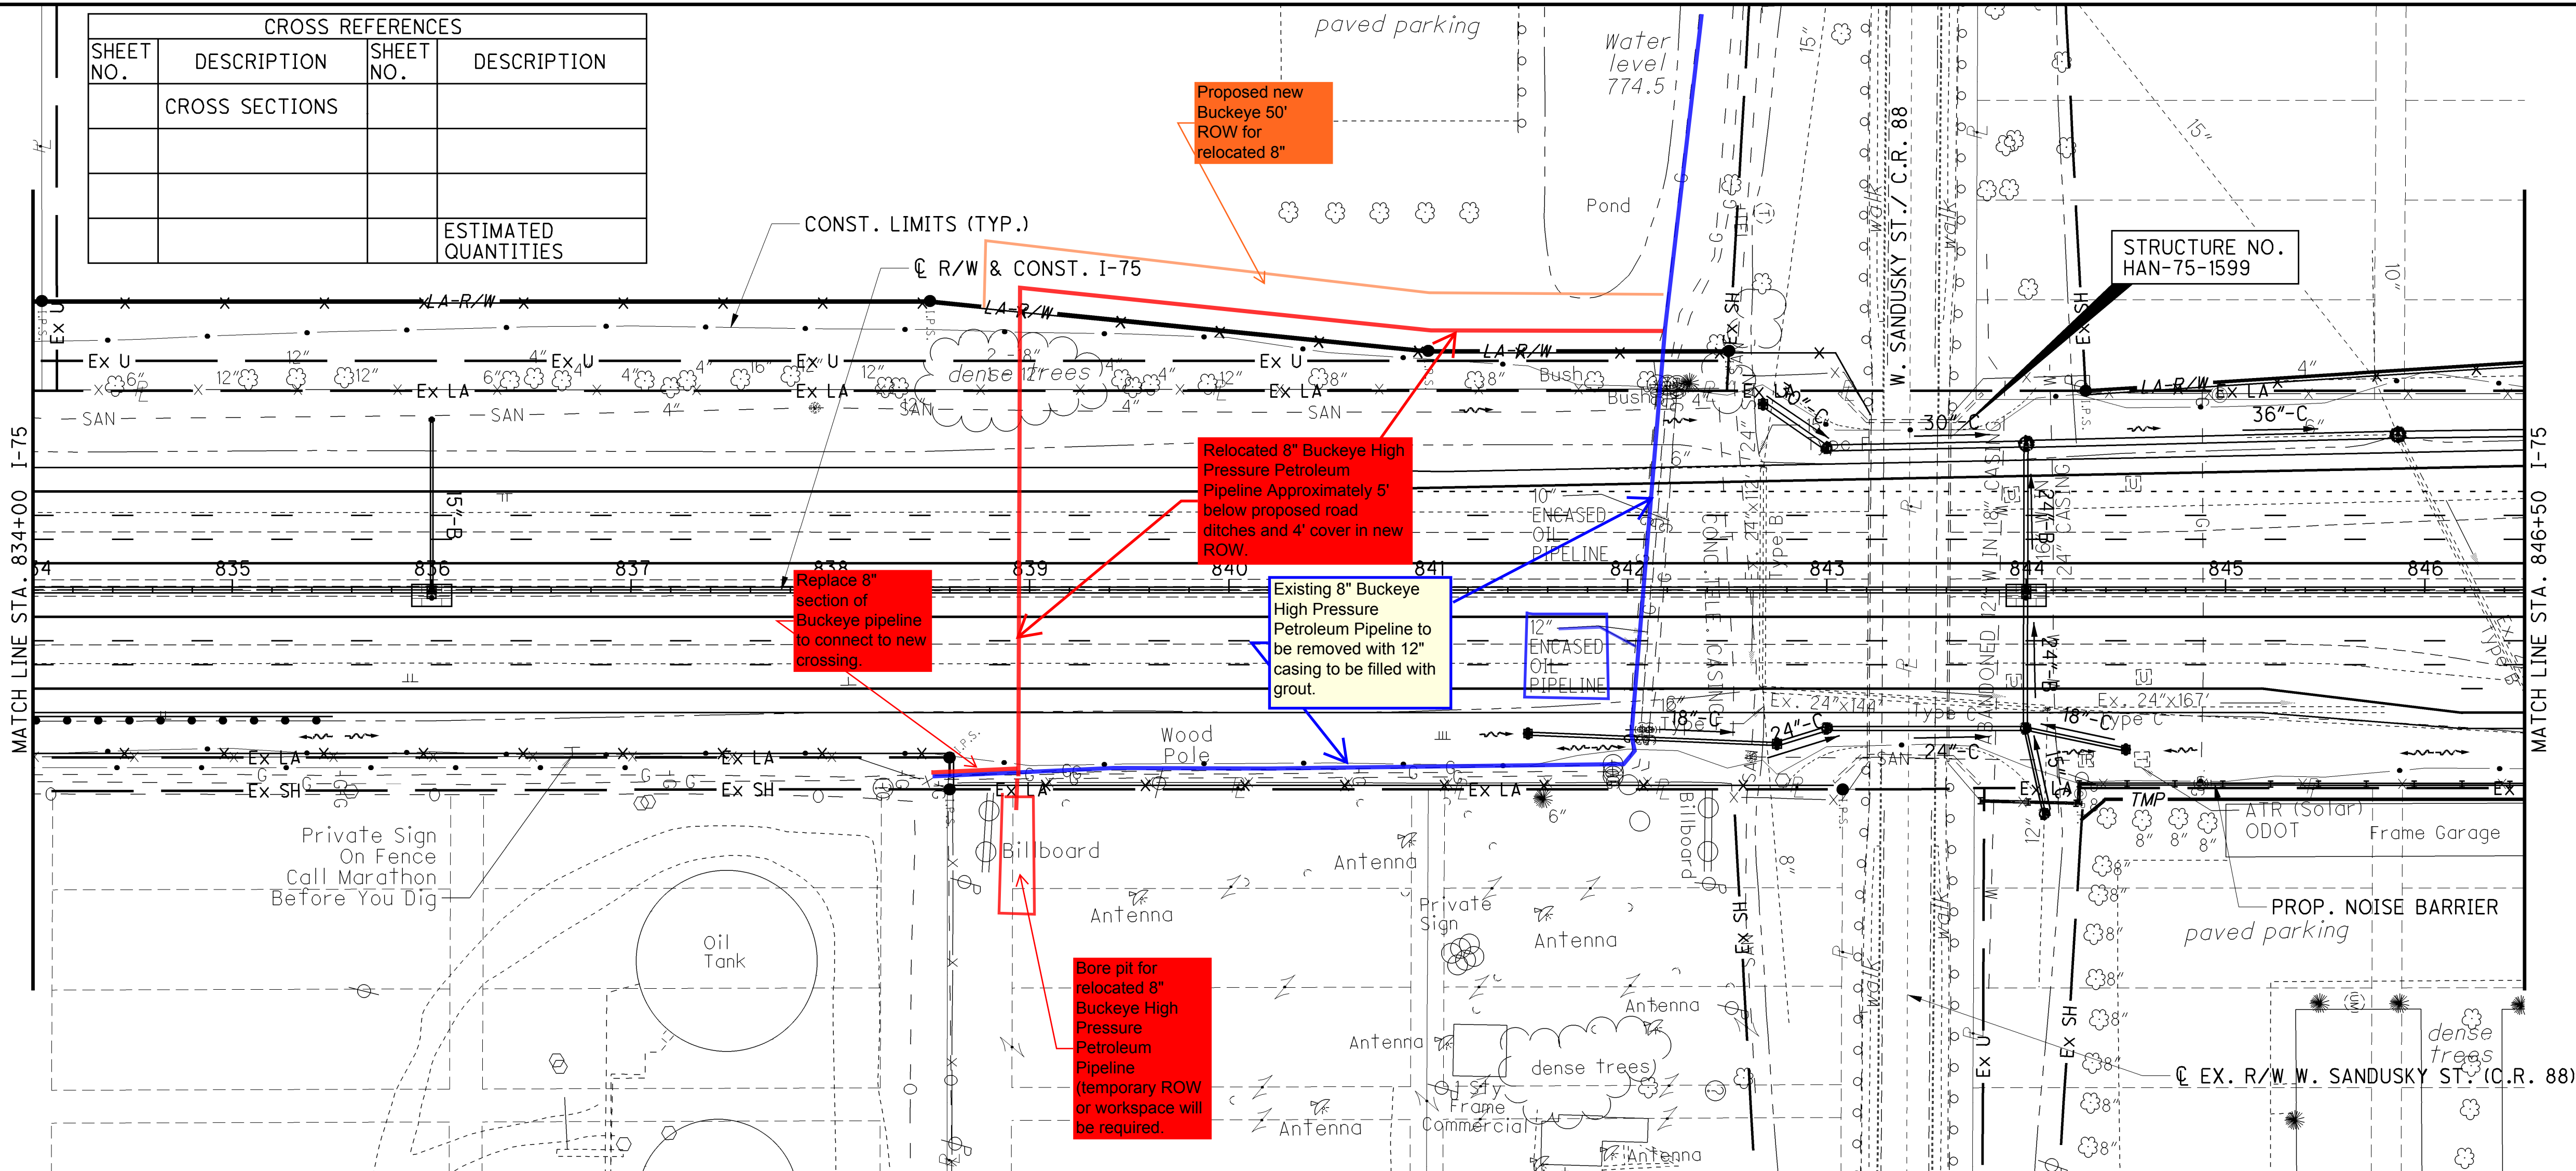


CALCULATED
CHECKED

PLAN AND PROFILE - I-75
STA. 834+00 TO STA. 846+50

HAN-75-14.39

74
635

T:\Projects\HAN\87005\roadway\sheet\87005GP009.dgn 29-MAR-2013 9:12PM reddeni

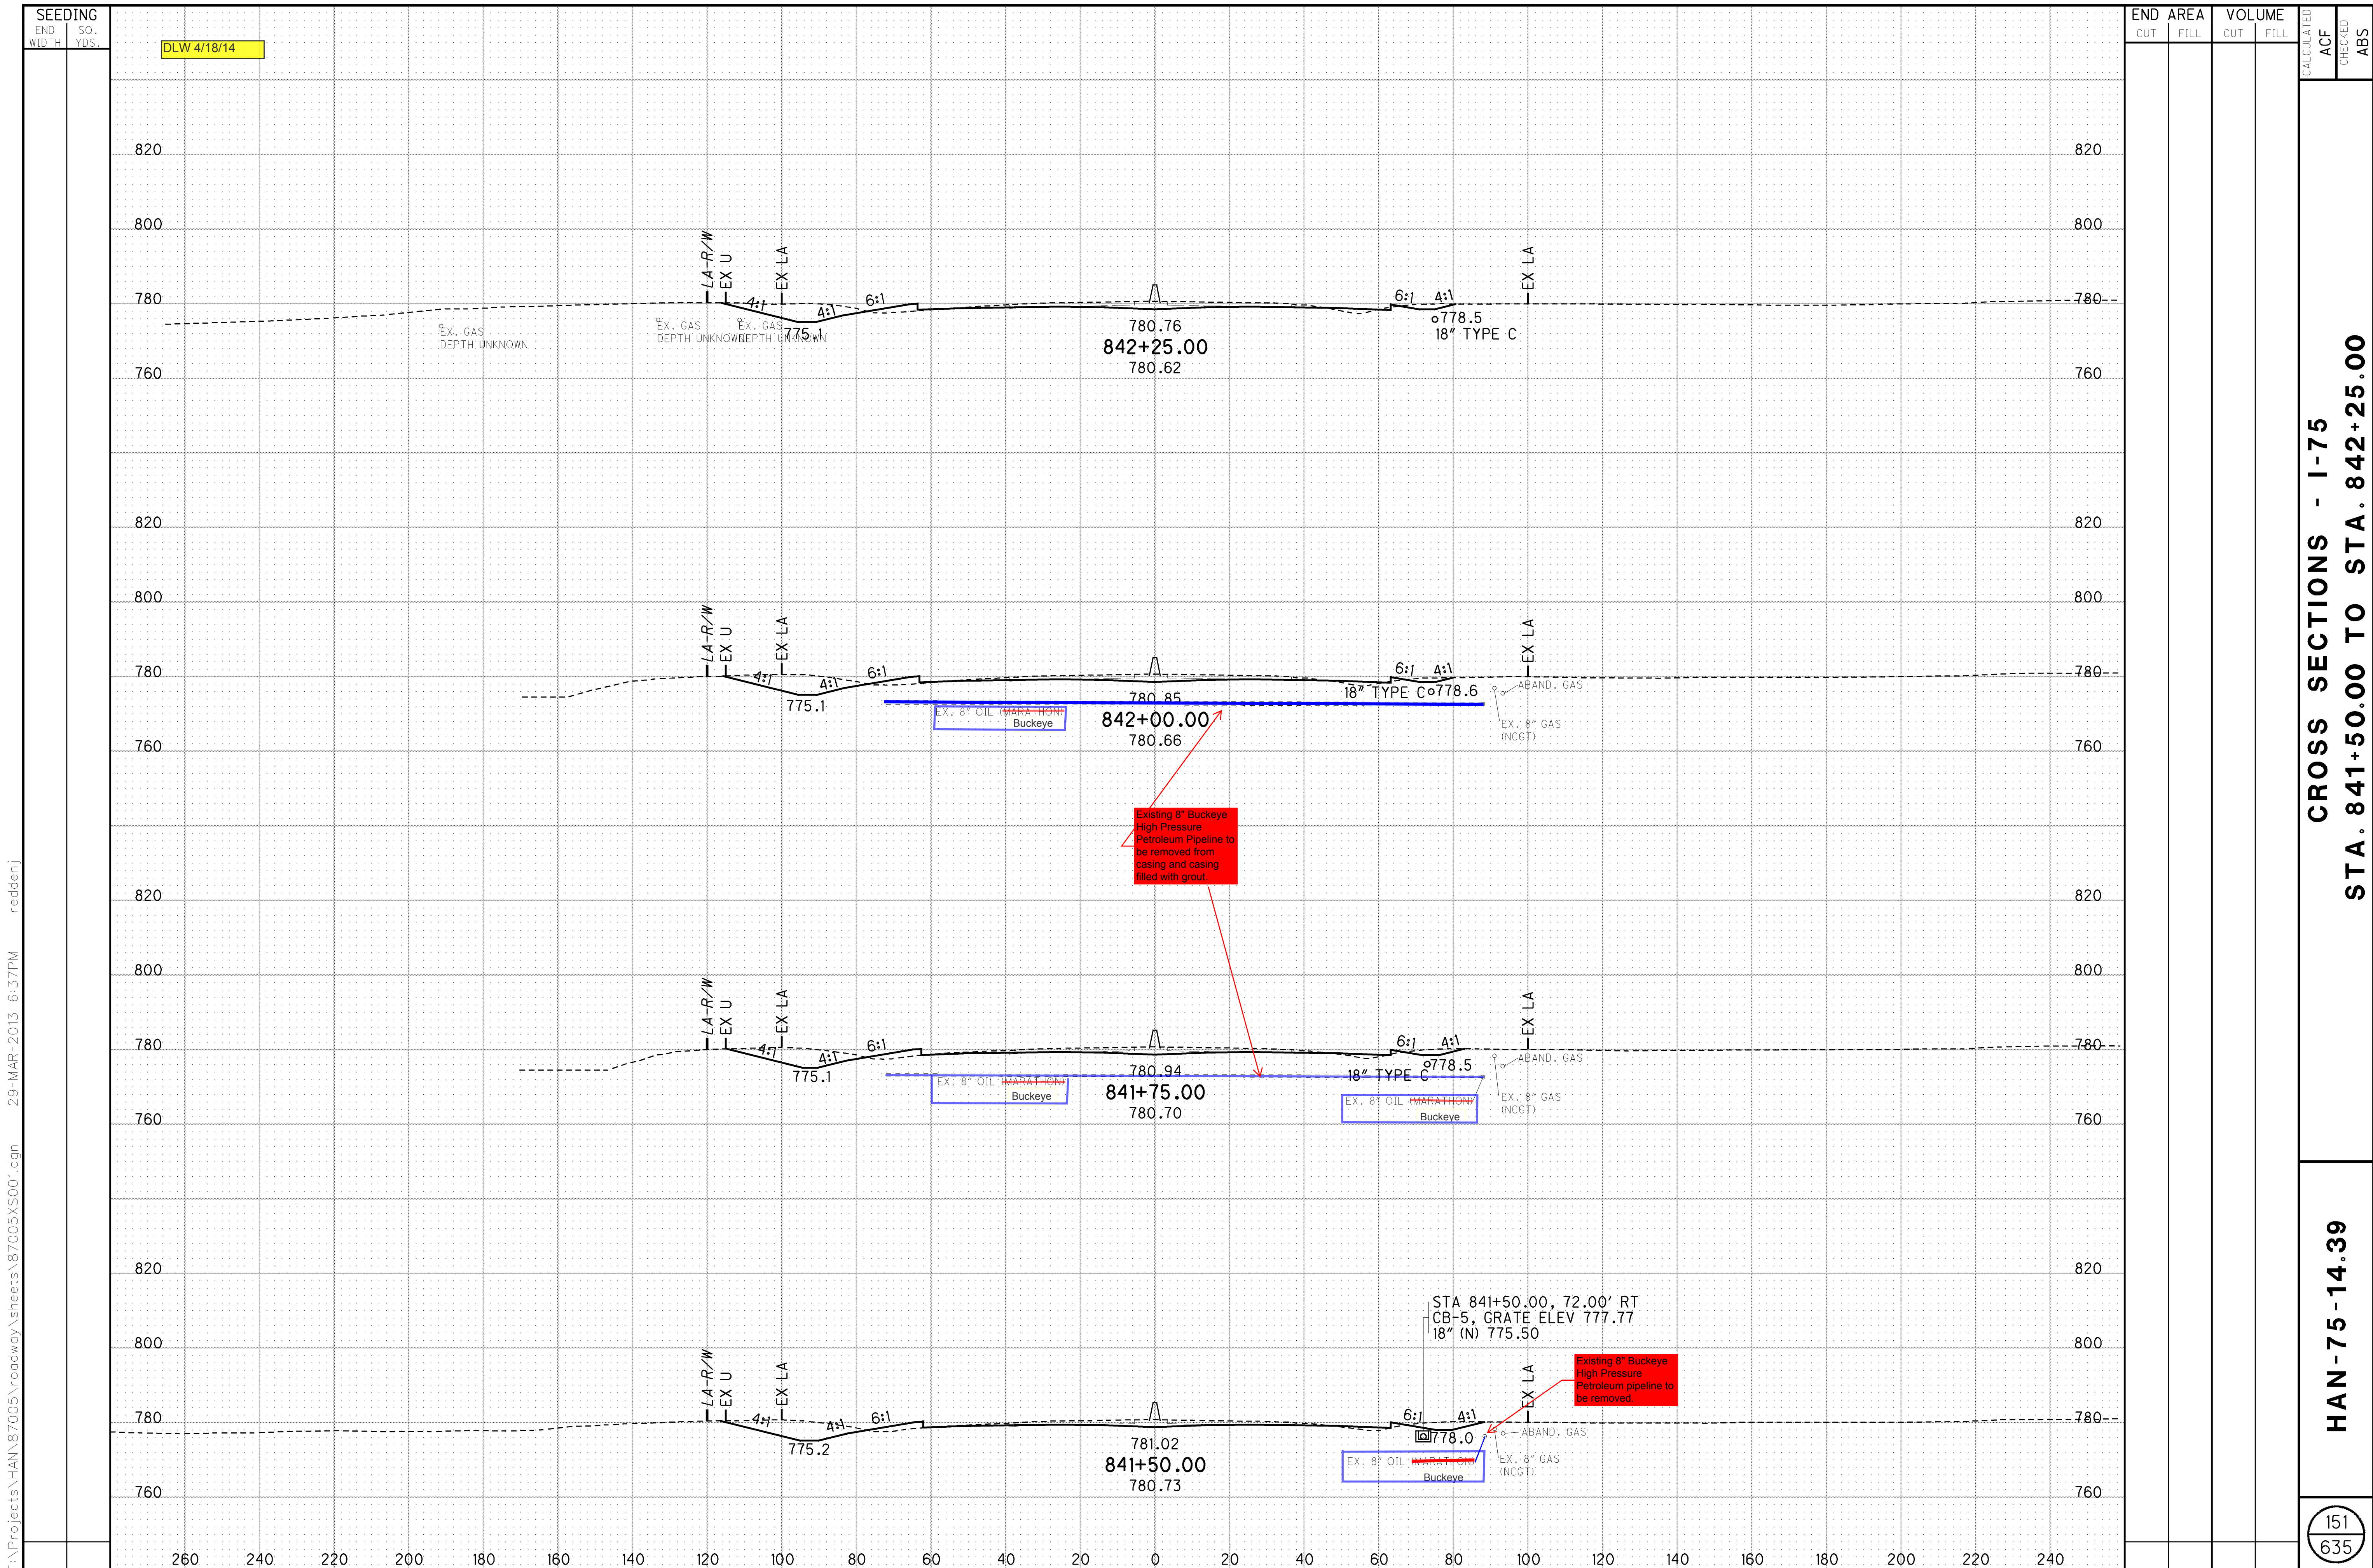

T:\Projects\HAN\87005\roadway\sheet\87005XS001.dgn 29-MAR-2013 6:37PM redderj

DLW 4/18/14

SEEDING	
END WIDTH	SO. YDS.

END AREA		VOLUME		CALCULATED	
CUT	FILL	CUT	FILL	ACF	ABS

CROSS SECTIONS - I-75
STA. 841+50.00 TO STA. 842+25.00

HAN-75-14.39


151
635

SEEDING
END WIDTH SO. YDS.

DLW 4/18/14

END AREA VOLUME
CUT FILL CUT FILL
CALCULATED ACF CHECKED ABS


T:\Projects\HAN\87005\roadway\sheets\87005XS001.dgn 29-MAR-2013 6:37PM redderj

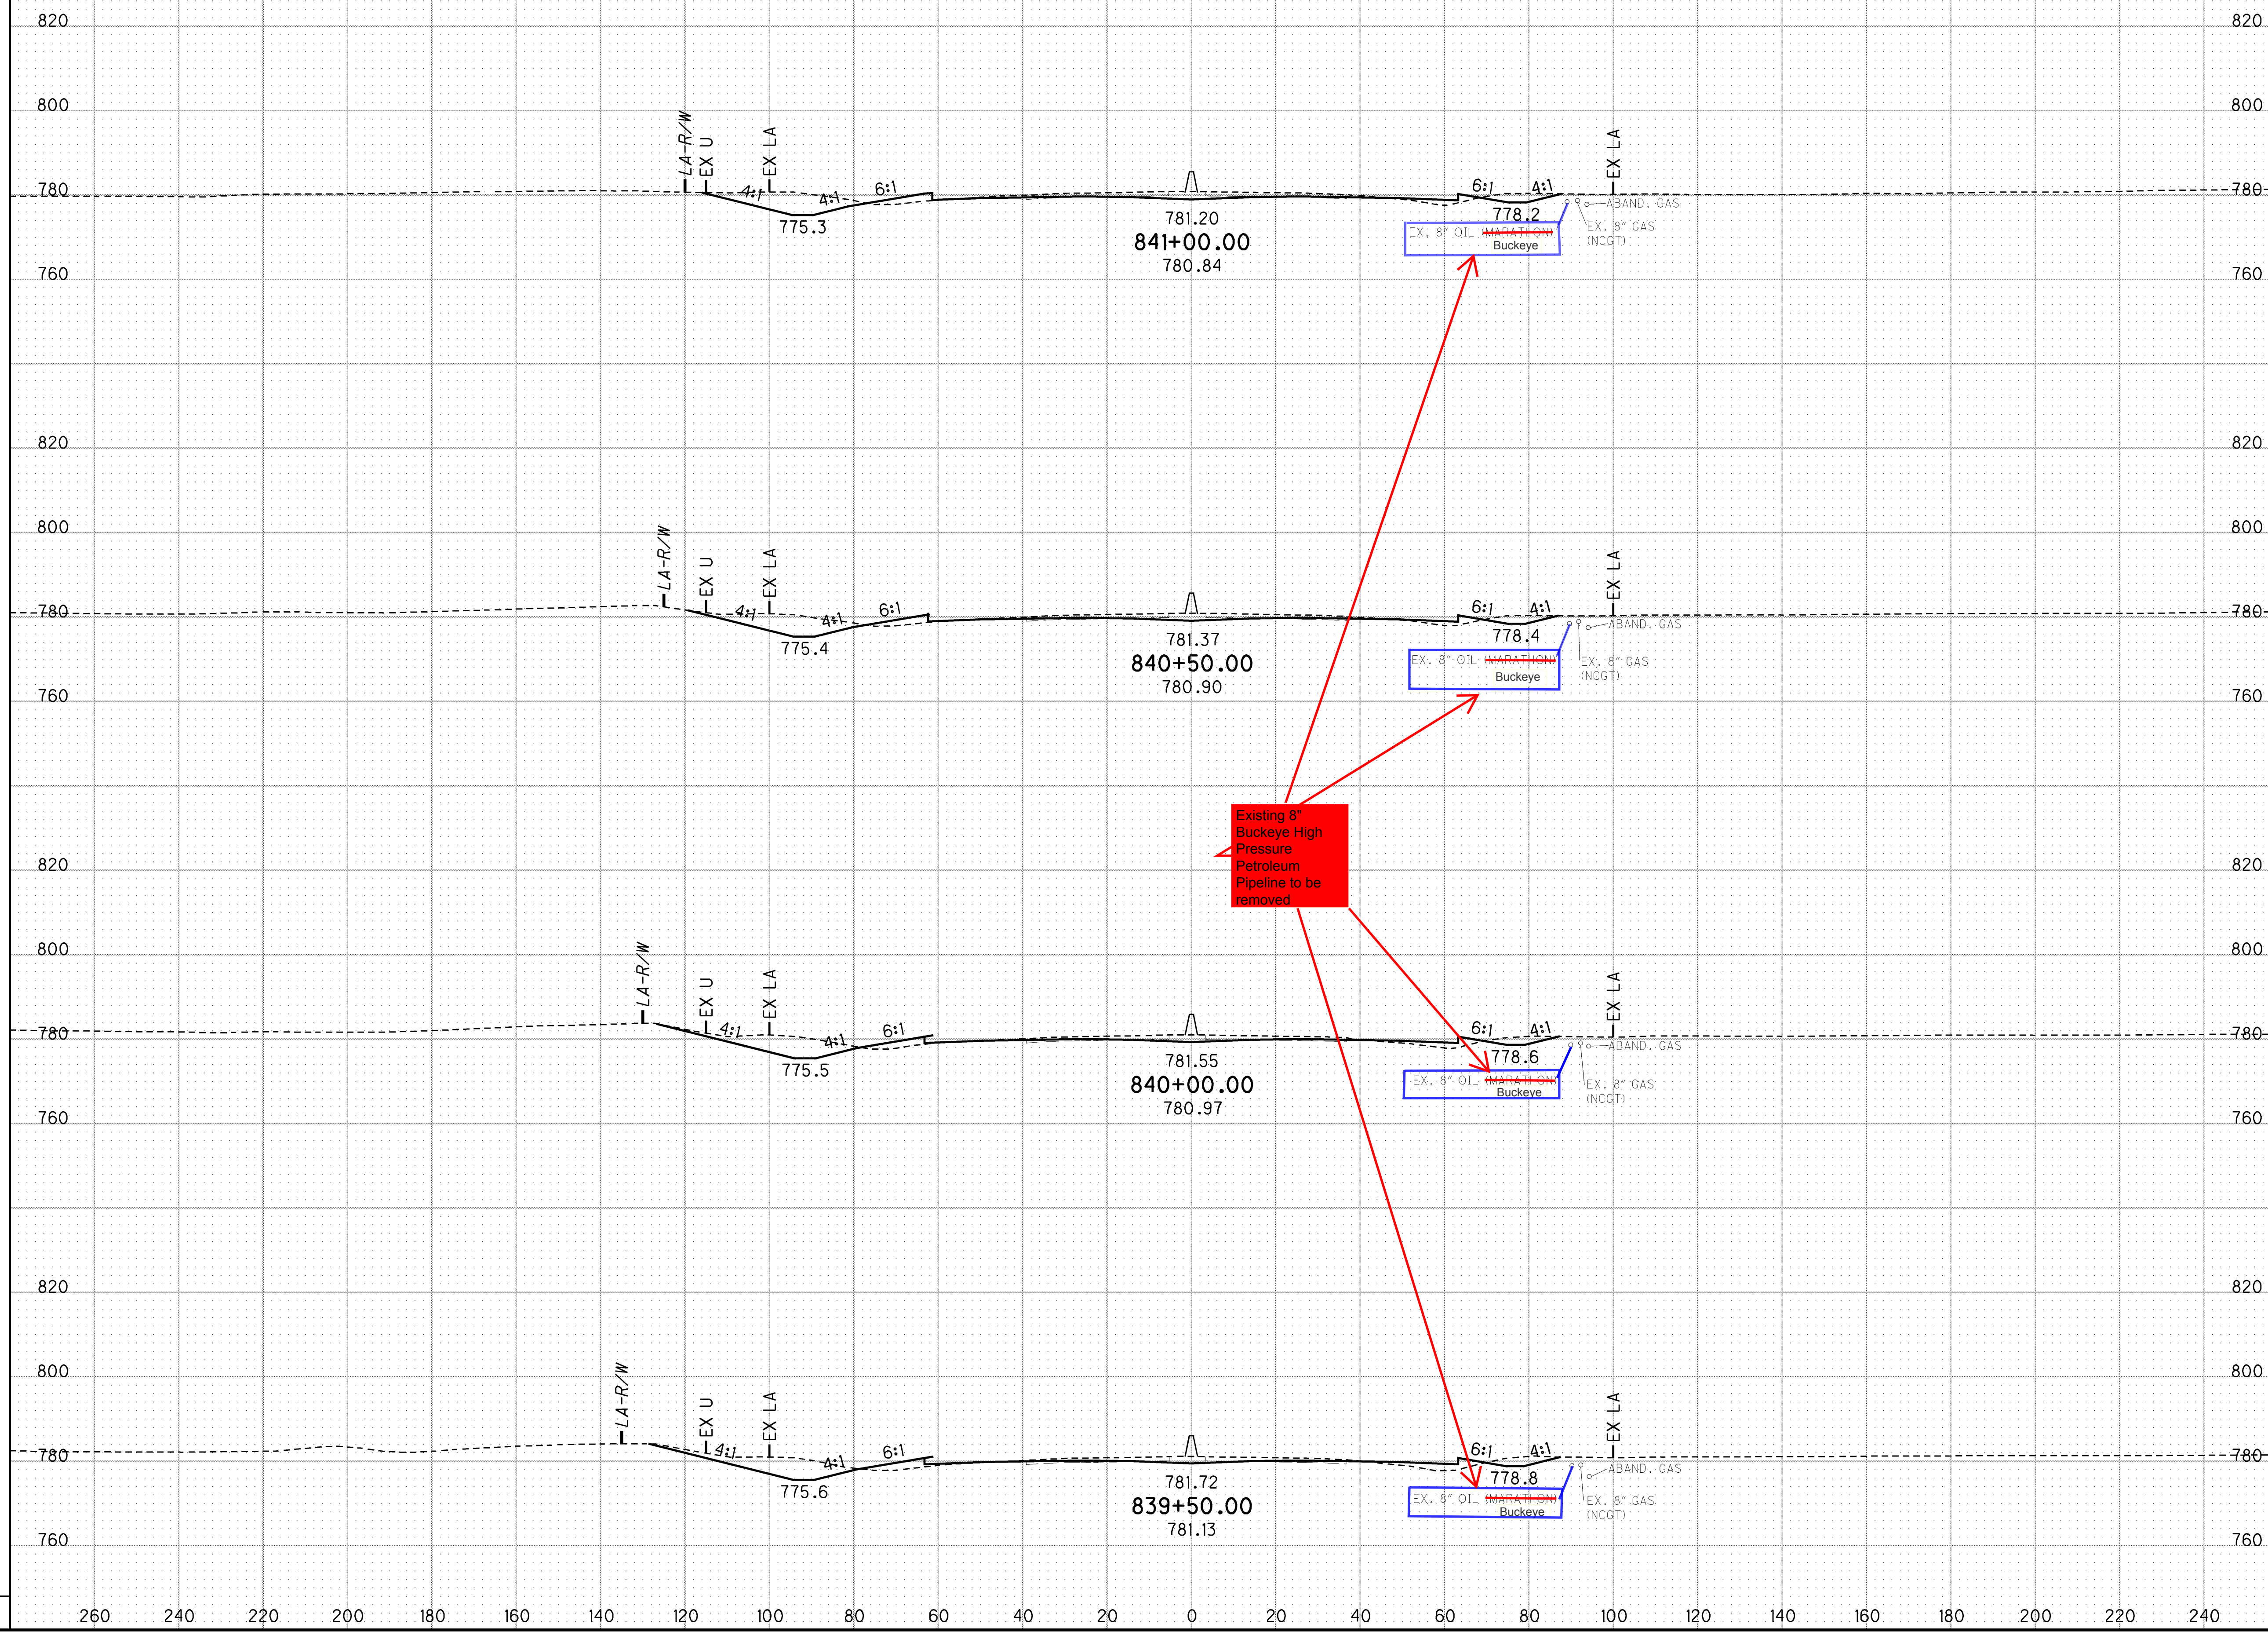

CROSS SECTIONS - I-75
STA. 839+50.00 TO STA. 841+00.00

HAN-75-14.39

150
635

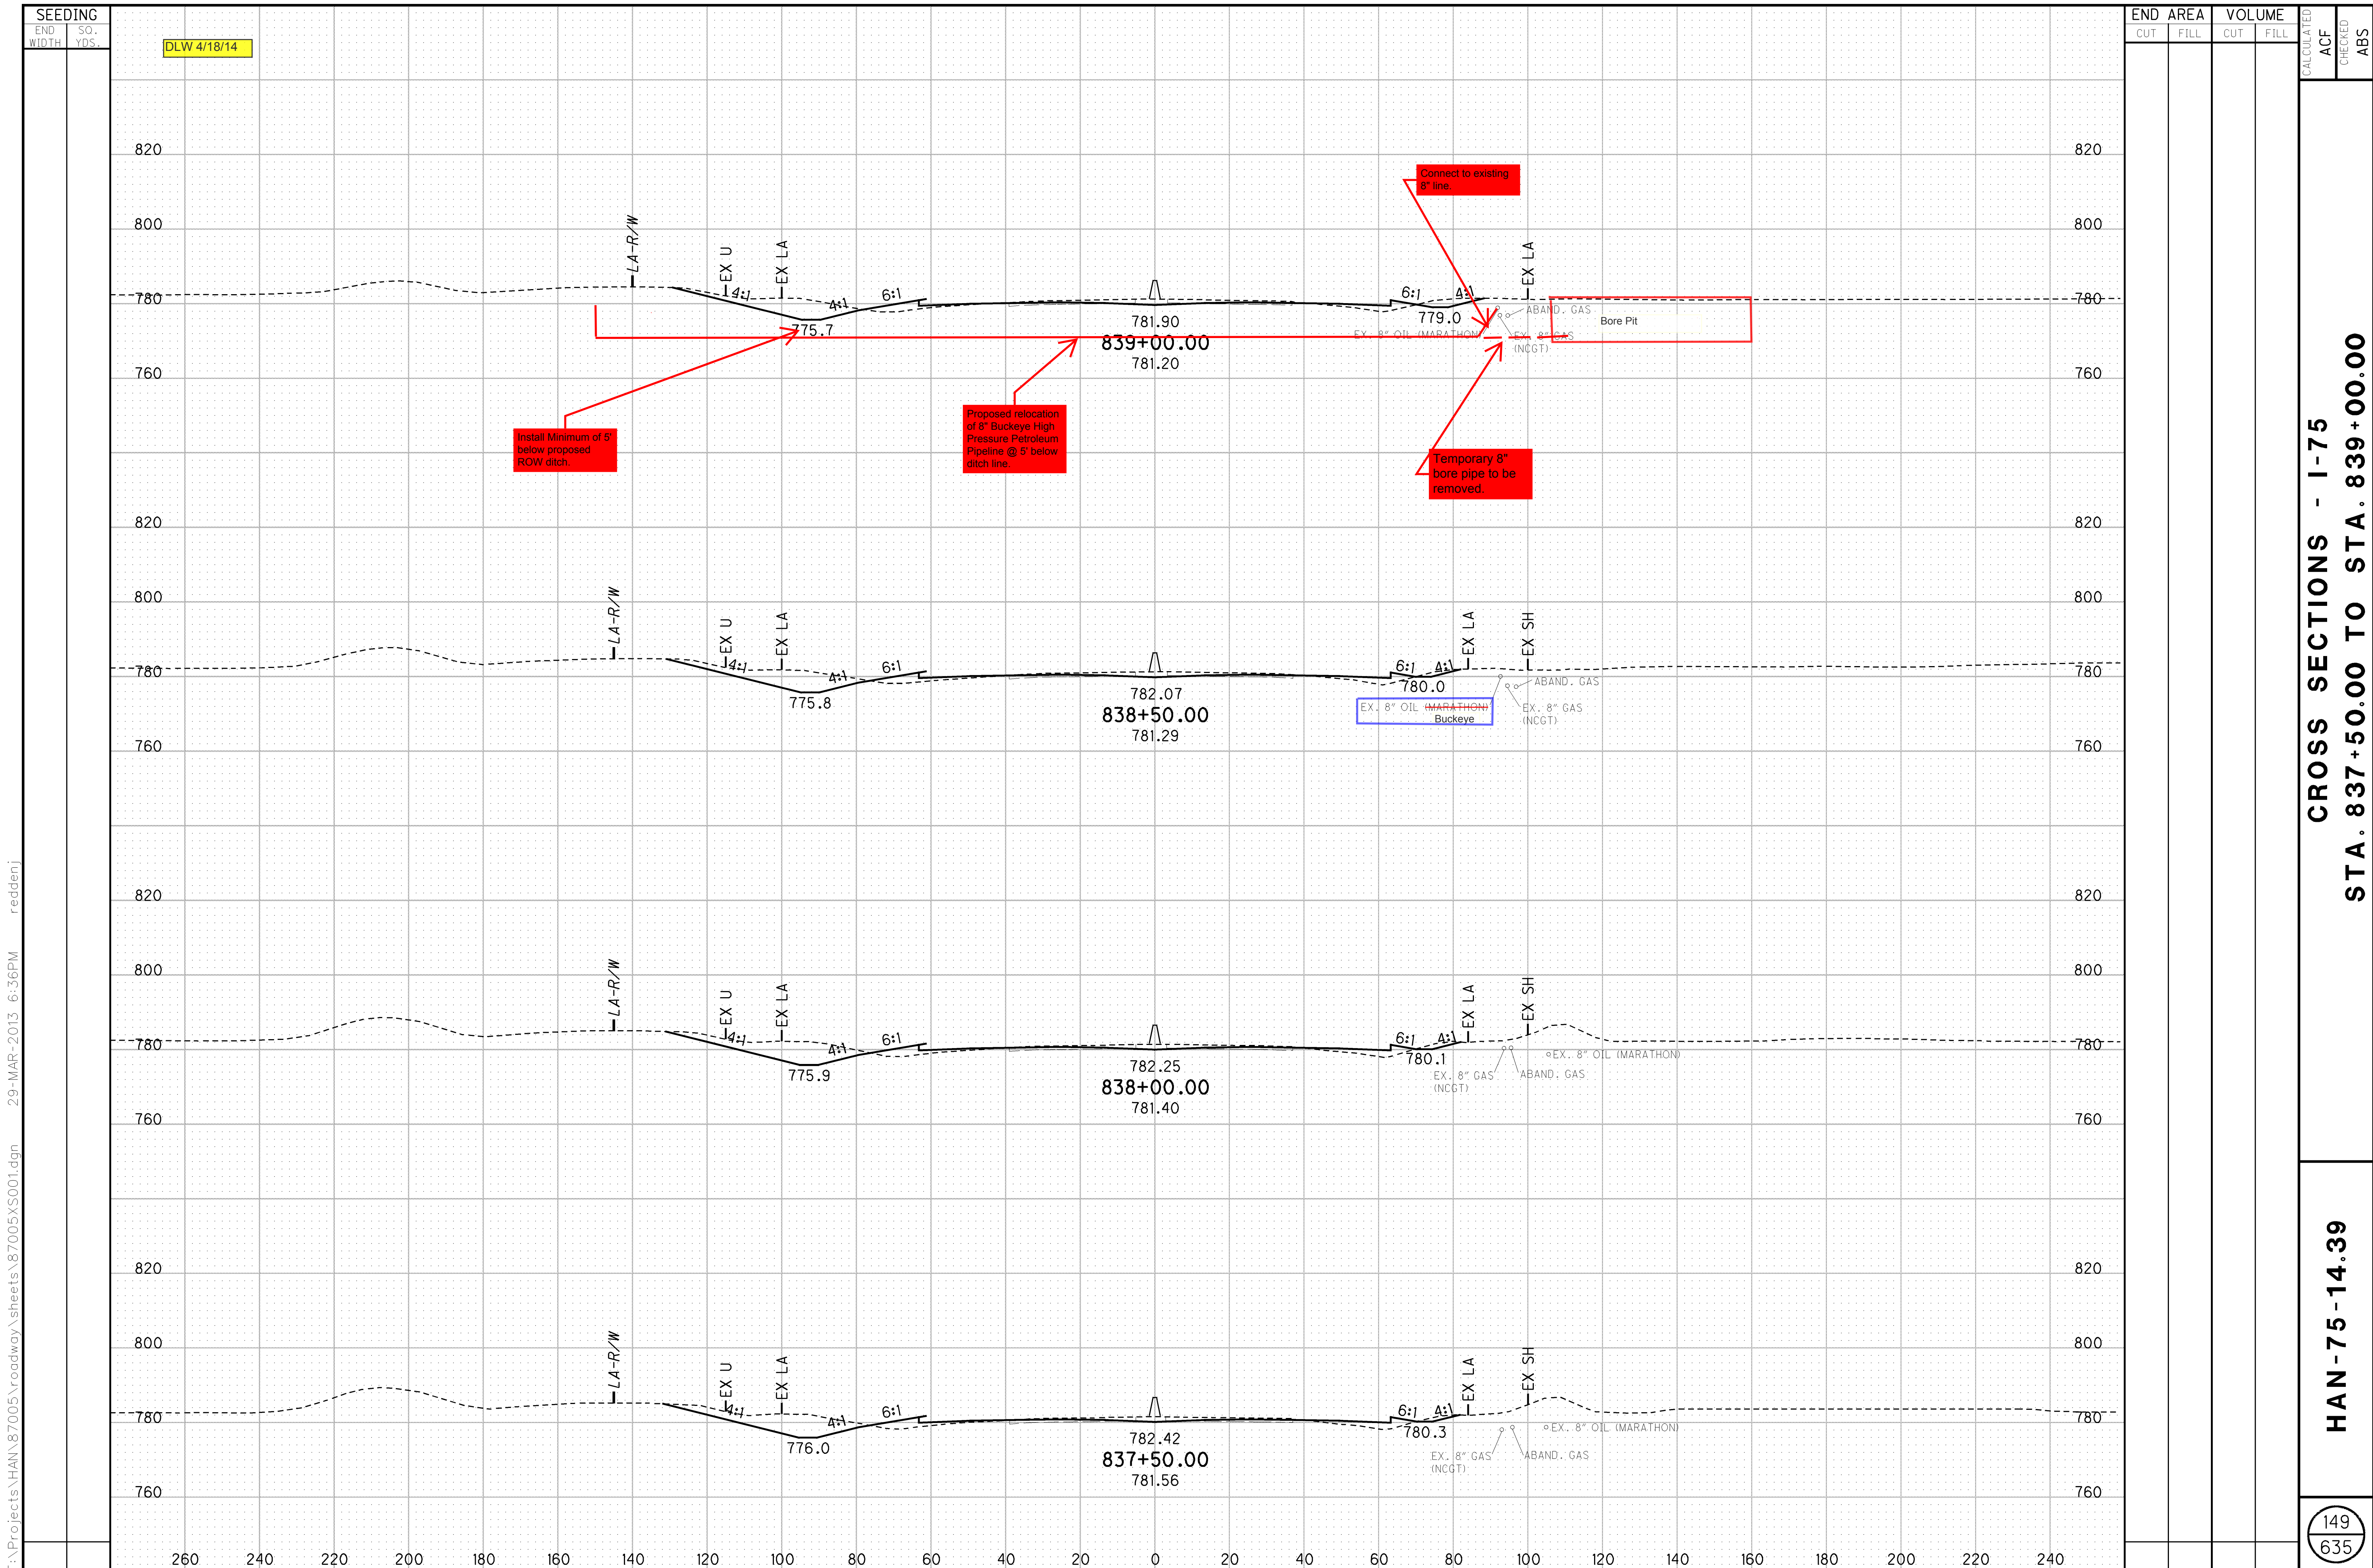

T:\Projects\HAN\87005\roadway\sheet\87005XS001.dgn 29-MAR-2013 6:36PM reddenj