
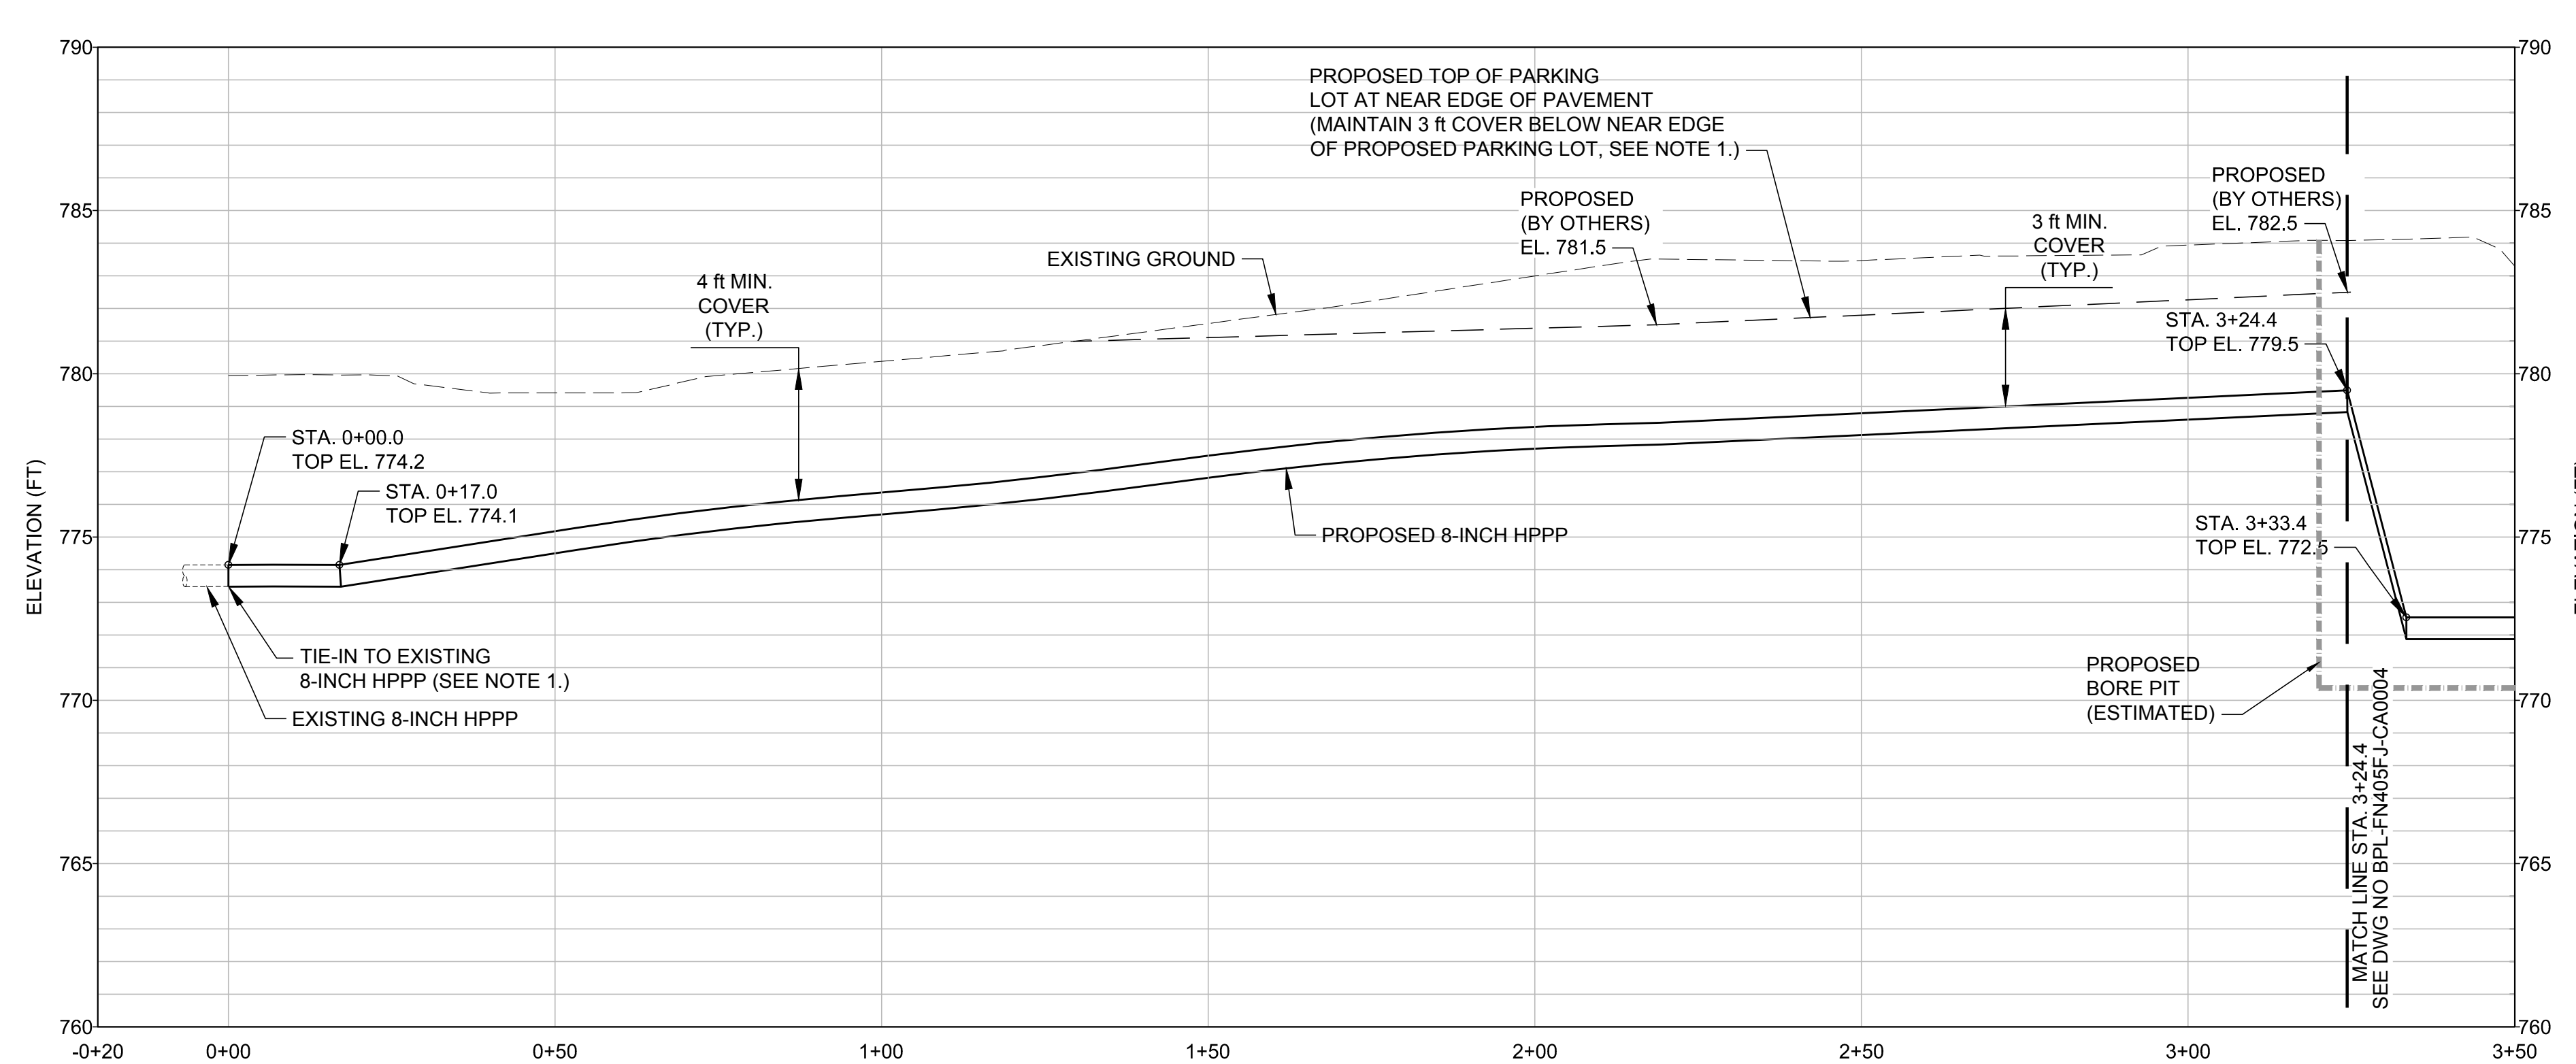


| | | | | | | | | |
|-----------------|--|---|---|---|---|---|---|---|
| JURISDICTION | HANCOCK COUNTY, OHIO | | | | | | | |
| OWNER/ROW # | KOEHLER BROTHERS INC., DASTKO LTD / R/W 22 | | | | | | | |
| TERRAIN SURFACE | GRASS | | | | | | | |
| STATIONING | | | | | | | | |
| PIPE/COATING | ① | ② | ③ | ④ | ⑤ | ⑥ | ⑦ | ⑧ |
| MISC./CASING | | | | | | | | |
| CATHODIC | | | | | | | | |

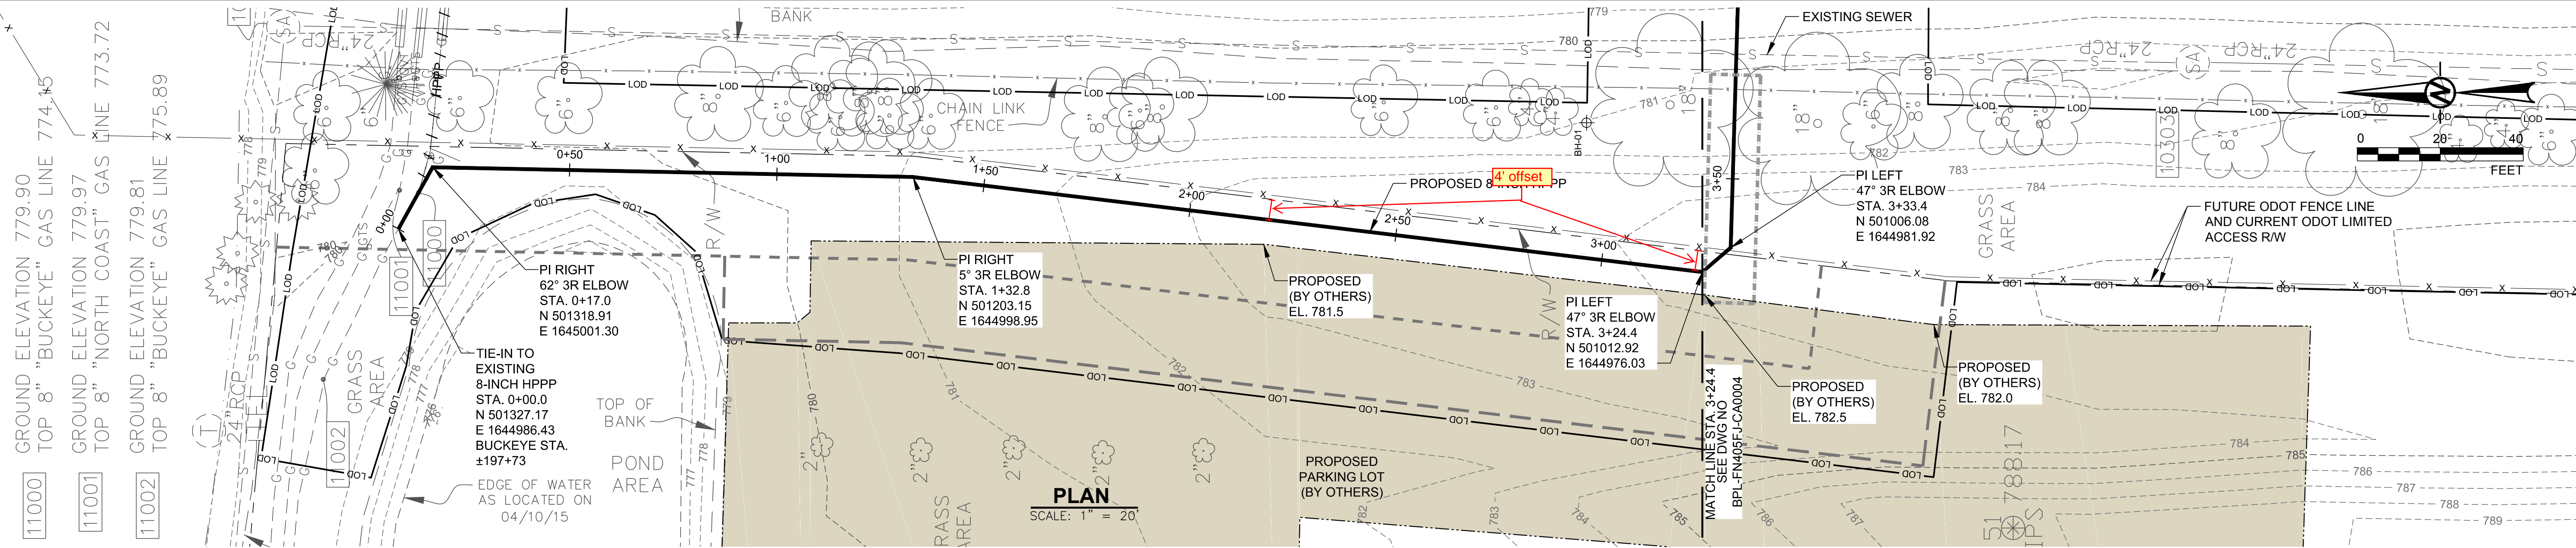

LEGEND

| | |
|--|--|
| | EXISTING BUCKEYE PIPELINE CENTERLINE |
| | EXISTING BUCKEYE PIPELINE TO BE REMOVED |
| | PROPOSED BUCKEYE 25 FT PIPELINE EASEMENT AREA |
| | PROPOSED CONSTRUCTION LICENSE AGREEMENT AREA |
| | PROPOSED PIPELINE 8-INCH HPPP |
| | PROPOSED LIMIT OF DISTURBANCE (LOD) |
| | SOIL SAMPLE BOREHOLE LOCATION AND ID |
| | EXISTING RIGHT OF WAY (R/W) /PROPERTY LINE (APPROXIMATE) |
| | EXISTING GROUND 5-FOOT CONTOUR |
| | EXISTING GROUND 1-FOOT CONTOUR |
| | PROPOSED PARKING LOT EXPANSION (BY OTHERS) |

ISSUED FOR CONSTRUCTION
GAI PROJECT NO. 1412294

| | | | | |
|---|--|--|--|--|
| 5 | | | | |
| 4 | | | | |
| 3 | | | | |
| 2 | | | | |
| 1 | | | | |

| | | | | |
|---|----------|-------------------------|---------|-----------|
| NO | LOC | DESCRIPTION OF REVISION | BY DATE | APPR DATE |
| WORK ORDER NO. | | R0471 | | |
| BUCKEYE PARTNERS, L.P. BUCKEYE PIPE LINE COMPANY, L.P. | | | | |
| CIVIL PLAN & PROFILE (STA. 0+00 TO STA. 3+24.4) HAN 75-14.39 1-75 8-INCH PIPELINE RELOCATION CITY OF FINDLAY, HANCOCK COUNTY, OHIO | | | | |
| SDA/BCL | AS SHOWN | DATE: 09/03/2015 | | |
| DRAWN: | SCALE: | BPL-FN405FJ-CA0004 | | |
| MEF | MEF/RC | DRAWING NUMBER | | |
| APPROVED: | CHECKED: | REV 0 | | |

Golden Associates
5100 W. LEMON STREET
SUITE 208
TAMPA, FLORIDA 33609
PH 1(813)287-1717
FAX 1(813)287-1716
WEB: www.golder.com

PAGE 5
DO NOT SCALE DRAWING

NOTES:
1. PROPOSED EDGE OF PARKING LOT ELEVATIONS / GRADING OBTAINED FROM "FREUDENBERG NOK SITE GRADING AND UTILITY PLAN" DATED 5/17/15 AS PREPARED BY VAN HORN HOOVER AND ASSOCIATES, INC..
2. SEE DRAWING BPL-FN405FJ-CA0005 FOR BILL OF MATERIAL.

PROFILE
SCALE: 1" = 20' HORIZ.
1" = 4' VERT.

Drawing File: BPL-FN405FJ-CA0005.dwg | Layout: Plan & Profile | 11 Modified: 09/03/15 11:42am | Plotted: 09/03/15 3:11pm | Plotted by: STAvanman