
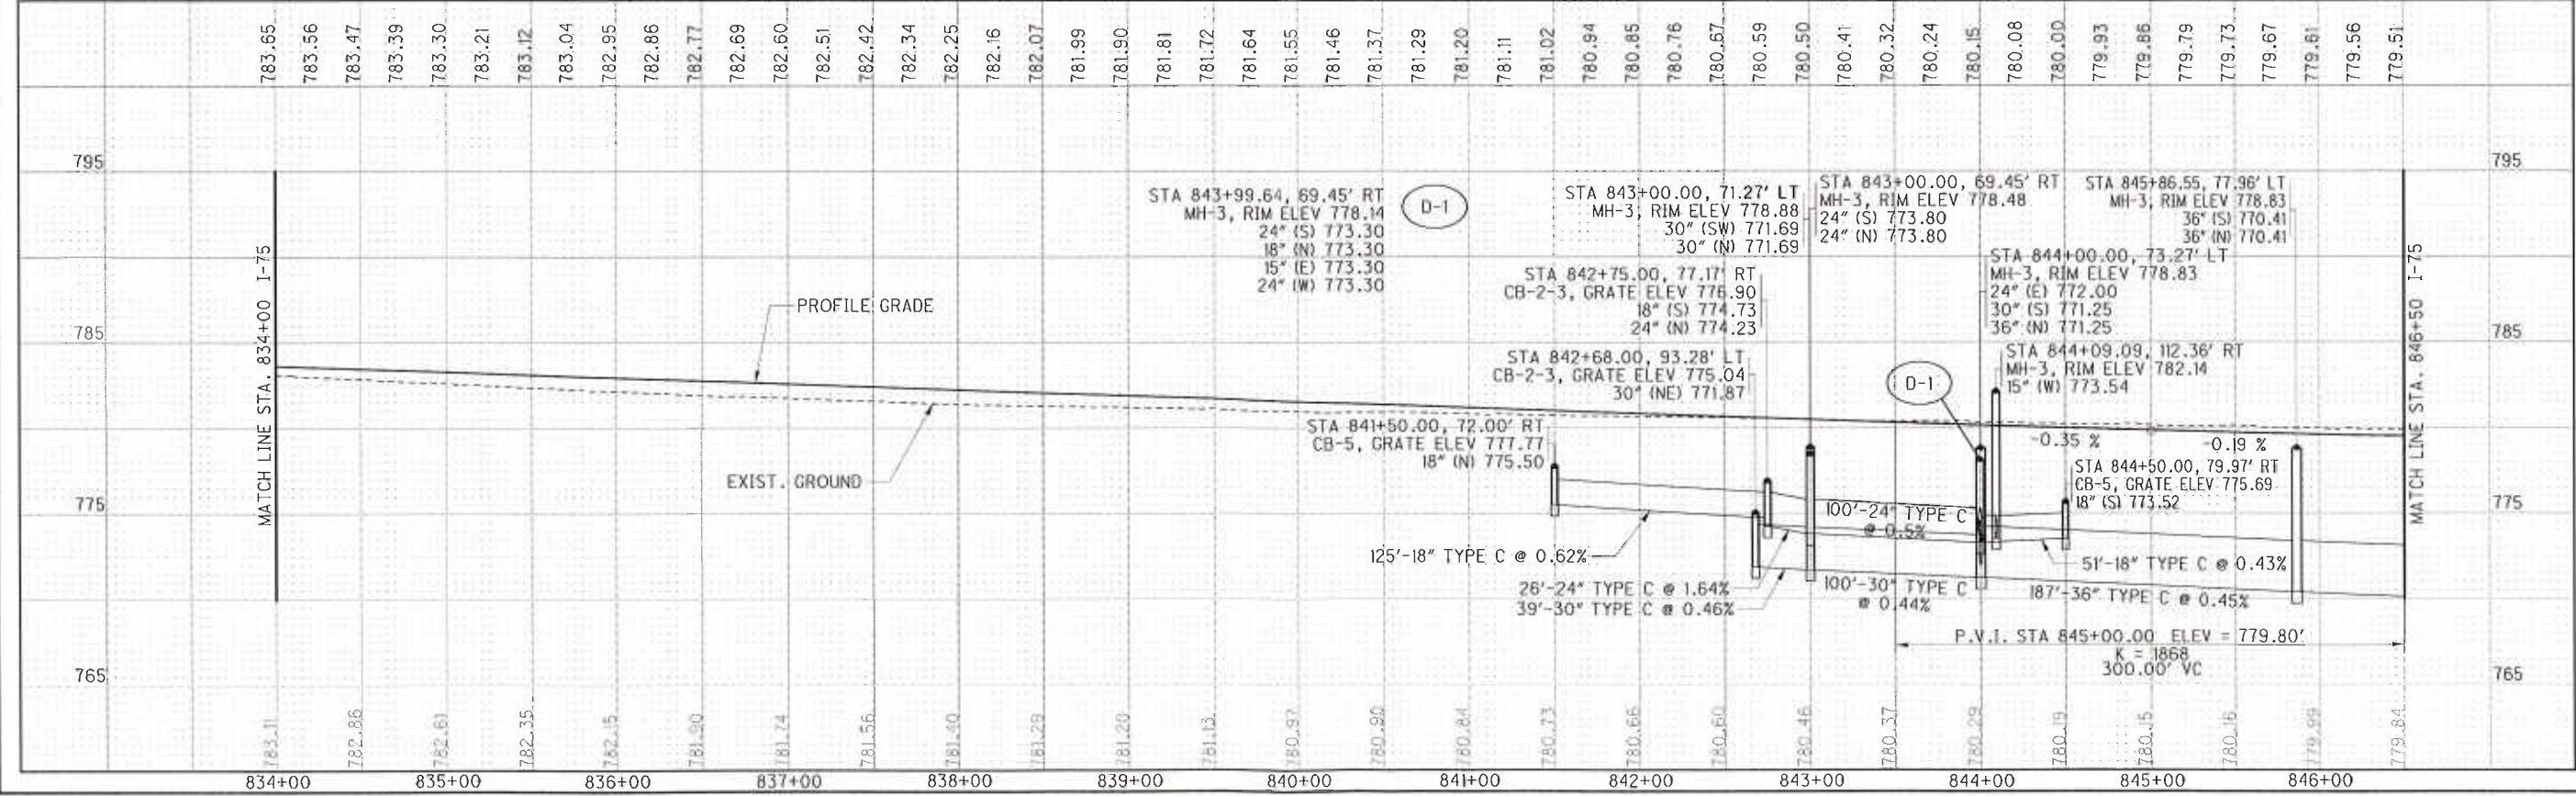


DLW 4/18/14

CROSS REFERENCES			
SHEET NO.	DESCRIPTION	SHEET NO.	DESCRIPTION
	CROSS SECTIONS		
			ESTIMATED QUANTITIES

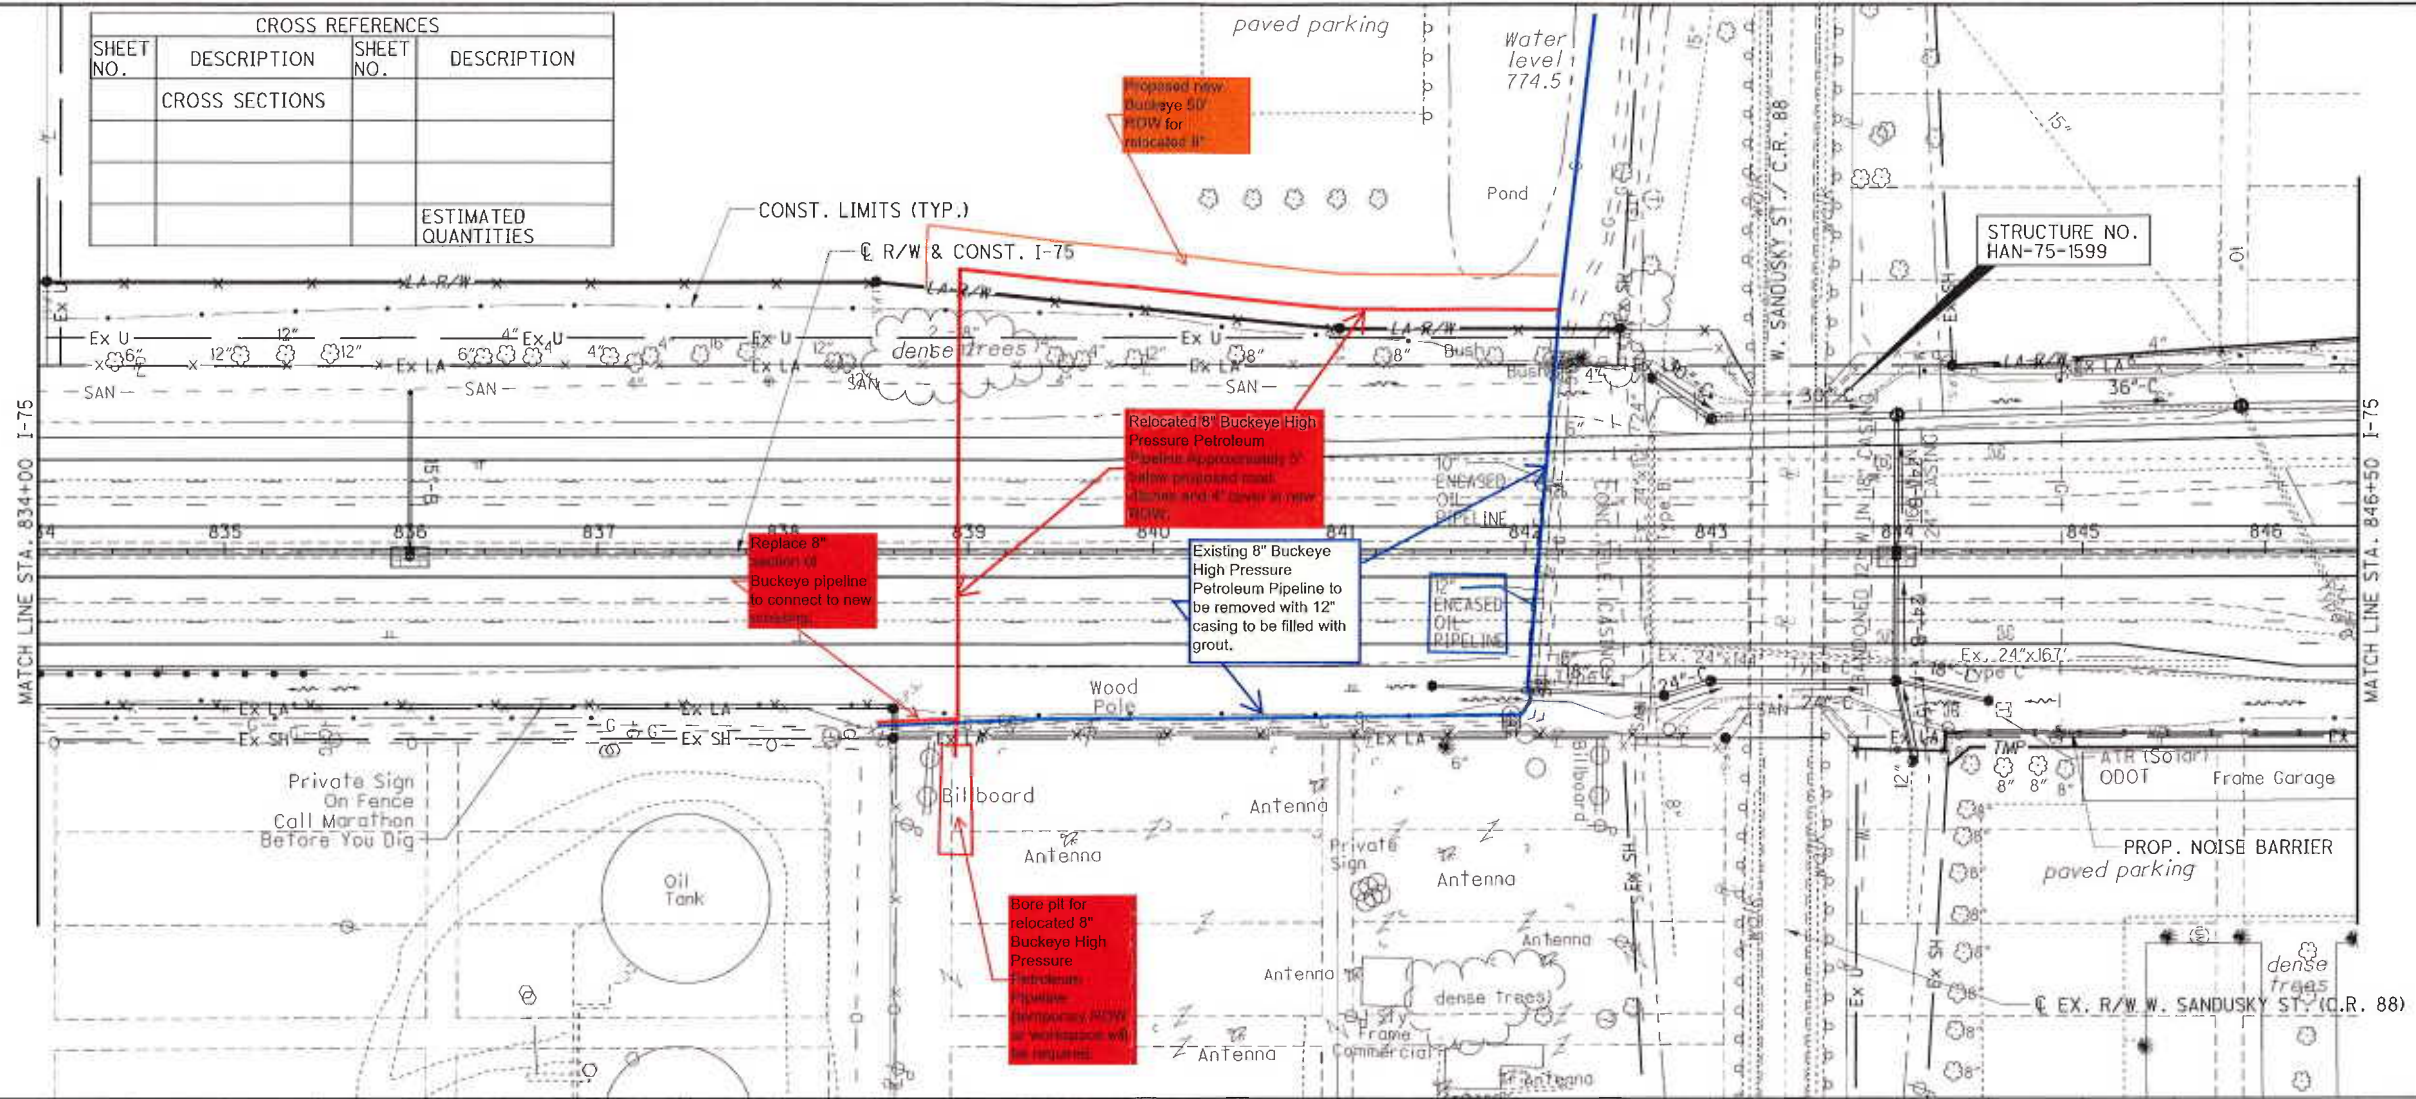

PLAN AND PROFILE - I-75  
 STA. 834+00 TO STA. 846+50


HAN-75-14.39

74  
 635

T:\Projects\HAN\87005\Roadway\sheets\87005GP009.dgn 29-MAR-2013 9:12PM redderj



T:\Projects\HAN\87005\roadway\sheet\87005X5001.dgn 29-MAR-2013 6:37PM reddentj

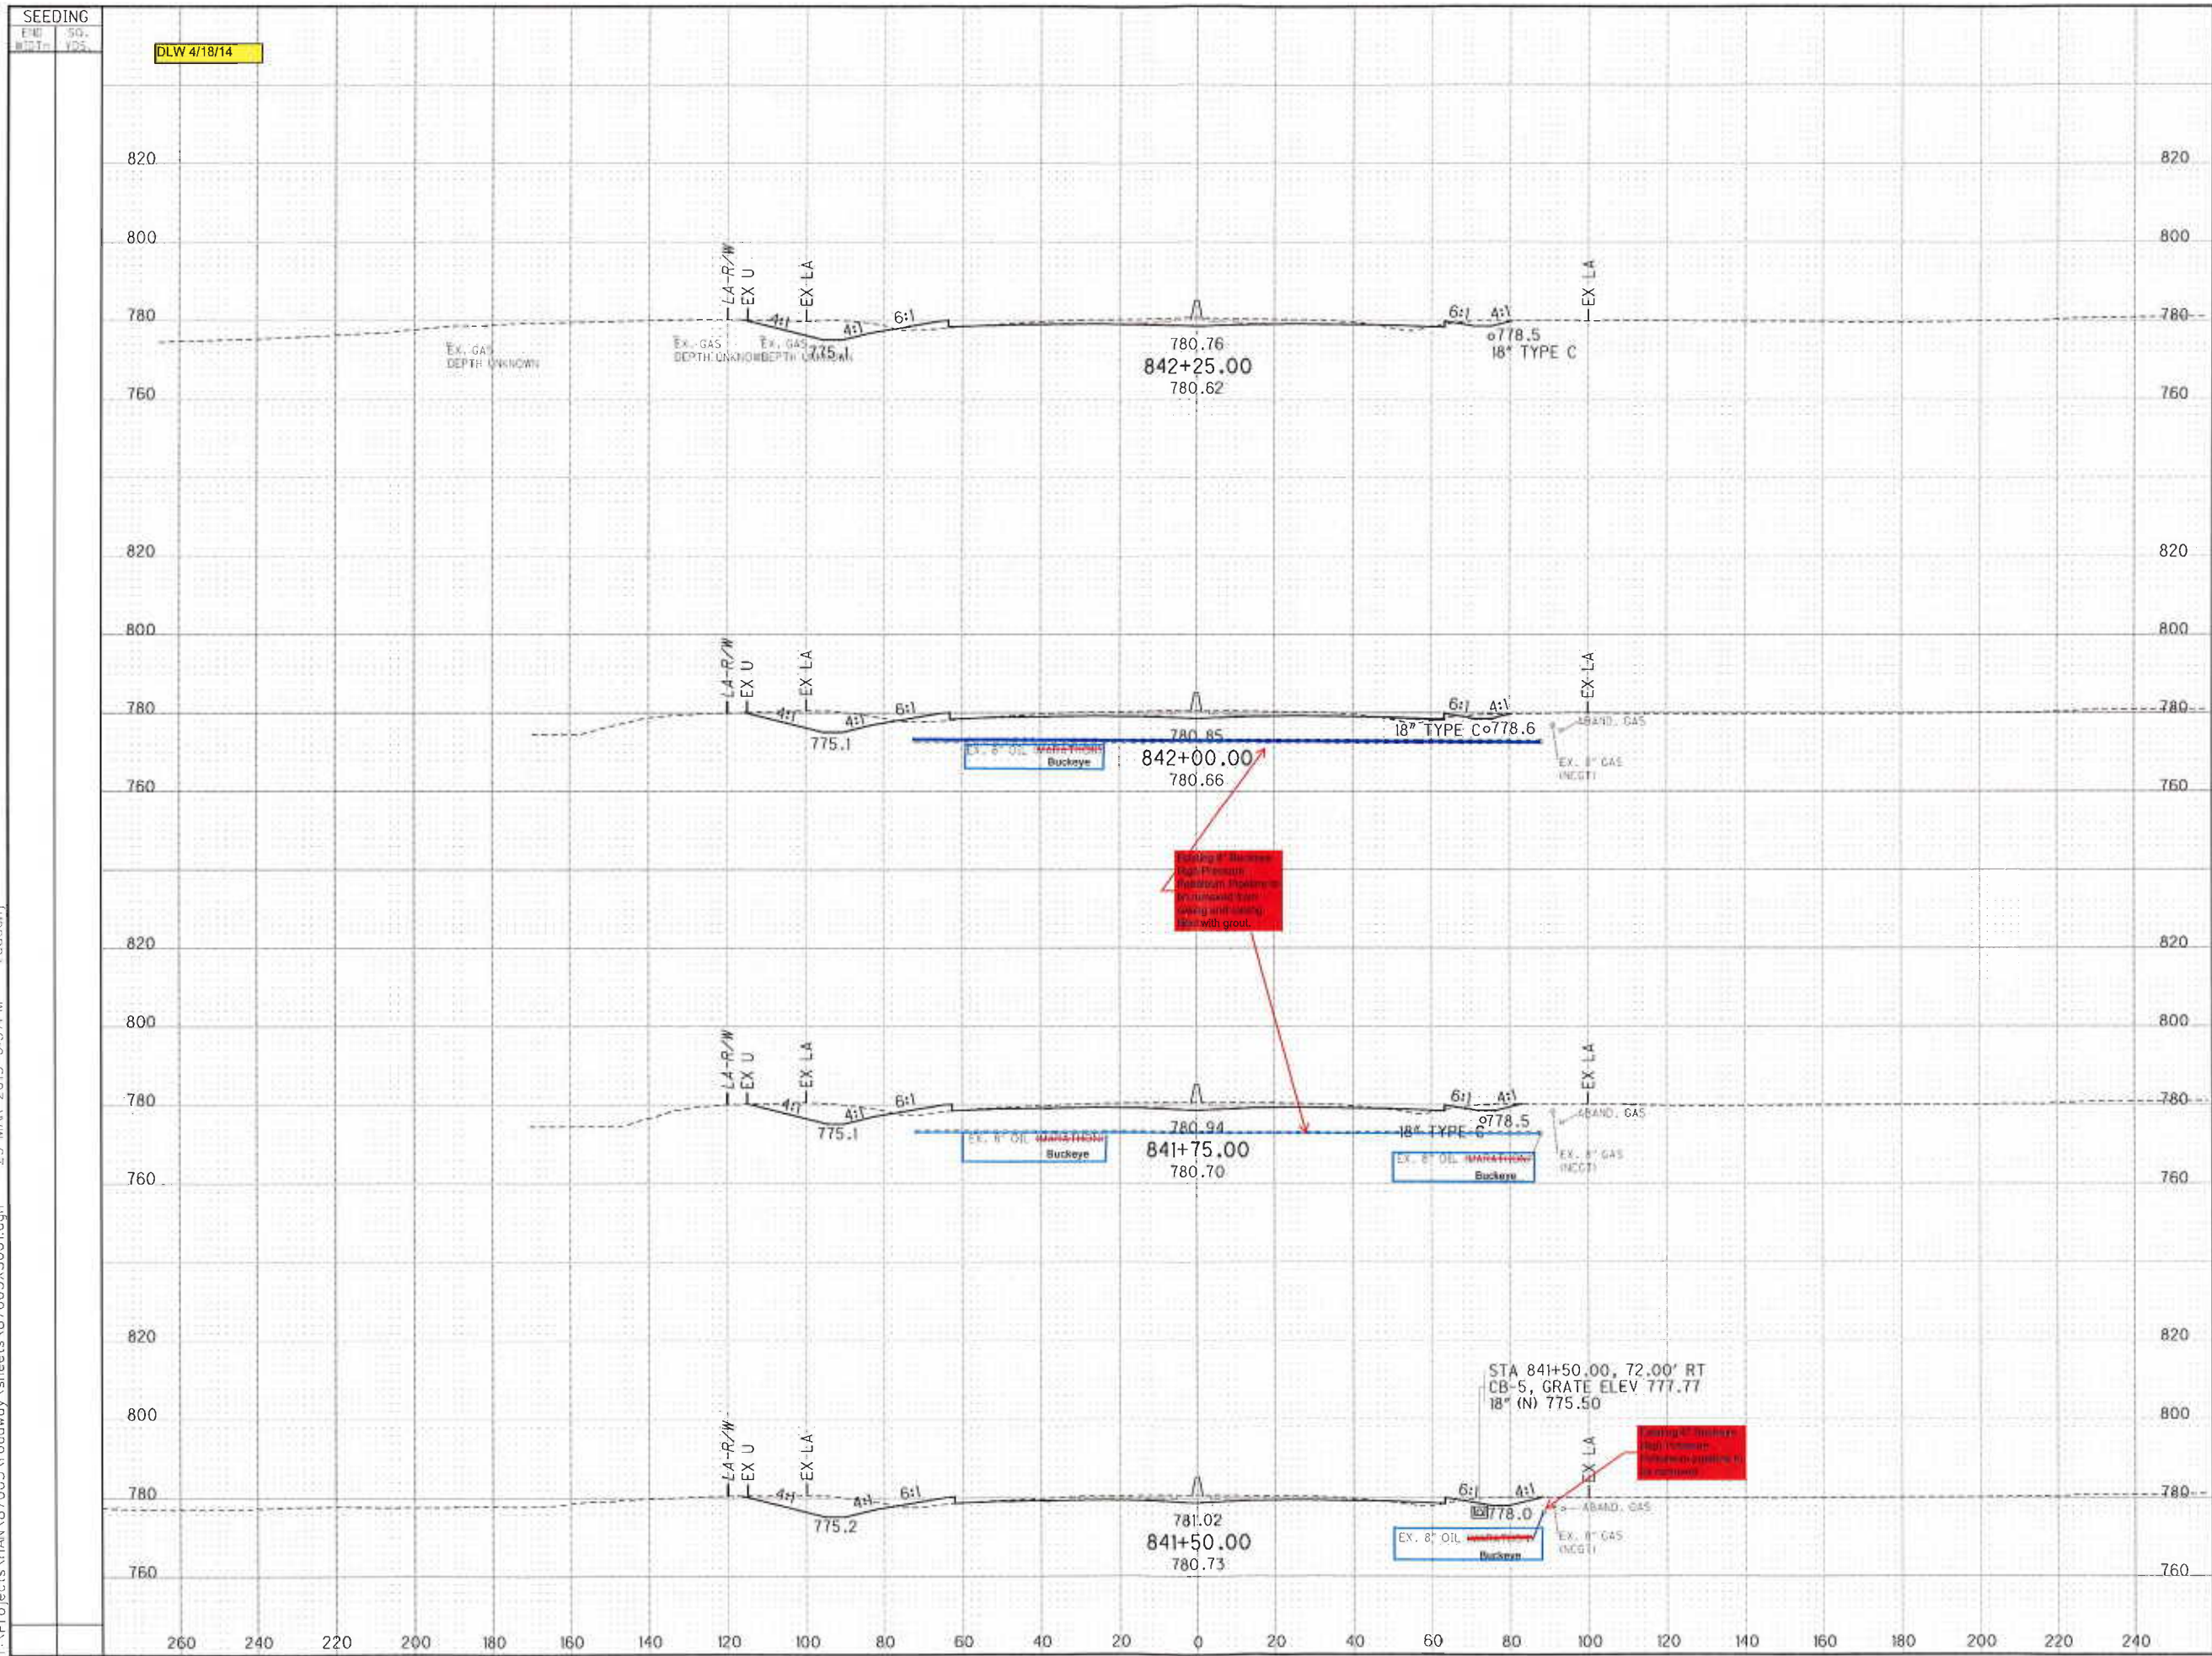

DLW 4/18/14


SEEDING	
END	SO.
DEPTH	YDS.

END AREA		VOLUME		CALCULATED	CHECKED
CUT	FILL	CUT	FILL		

CROSS SECTIONS - I-75  
STA. 841+50.00 TO STA. 842+25.00

HAN-75-14.39



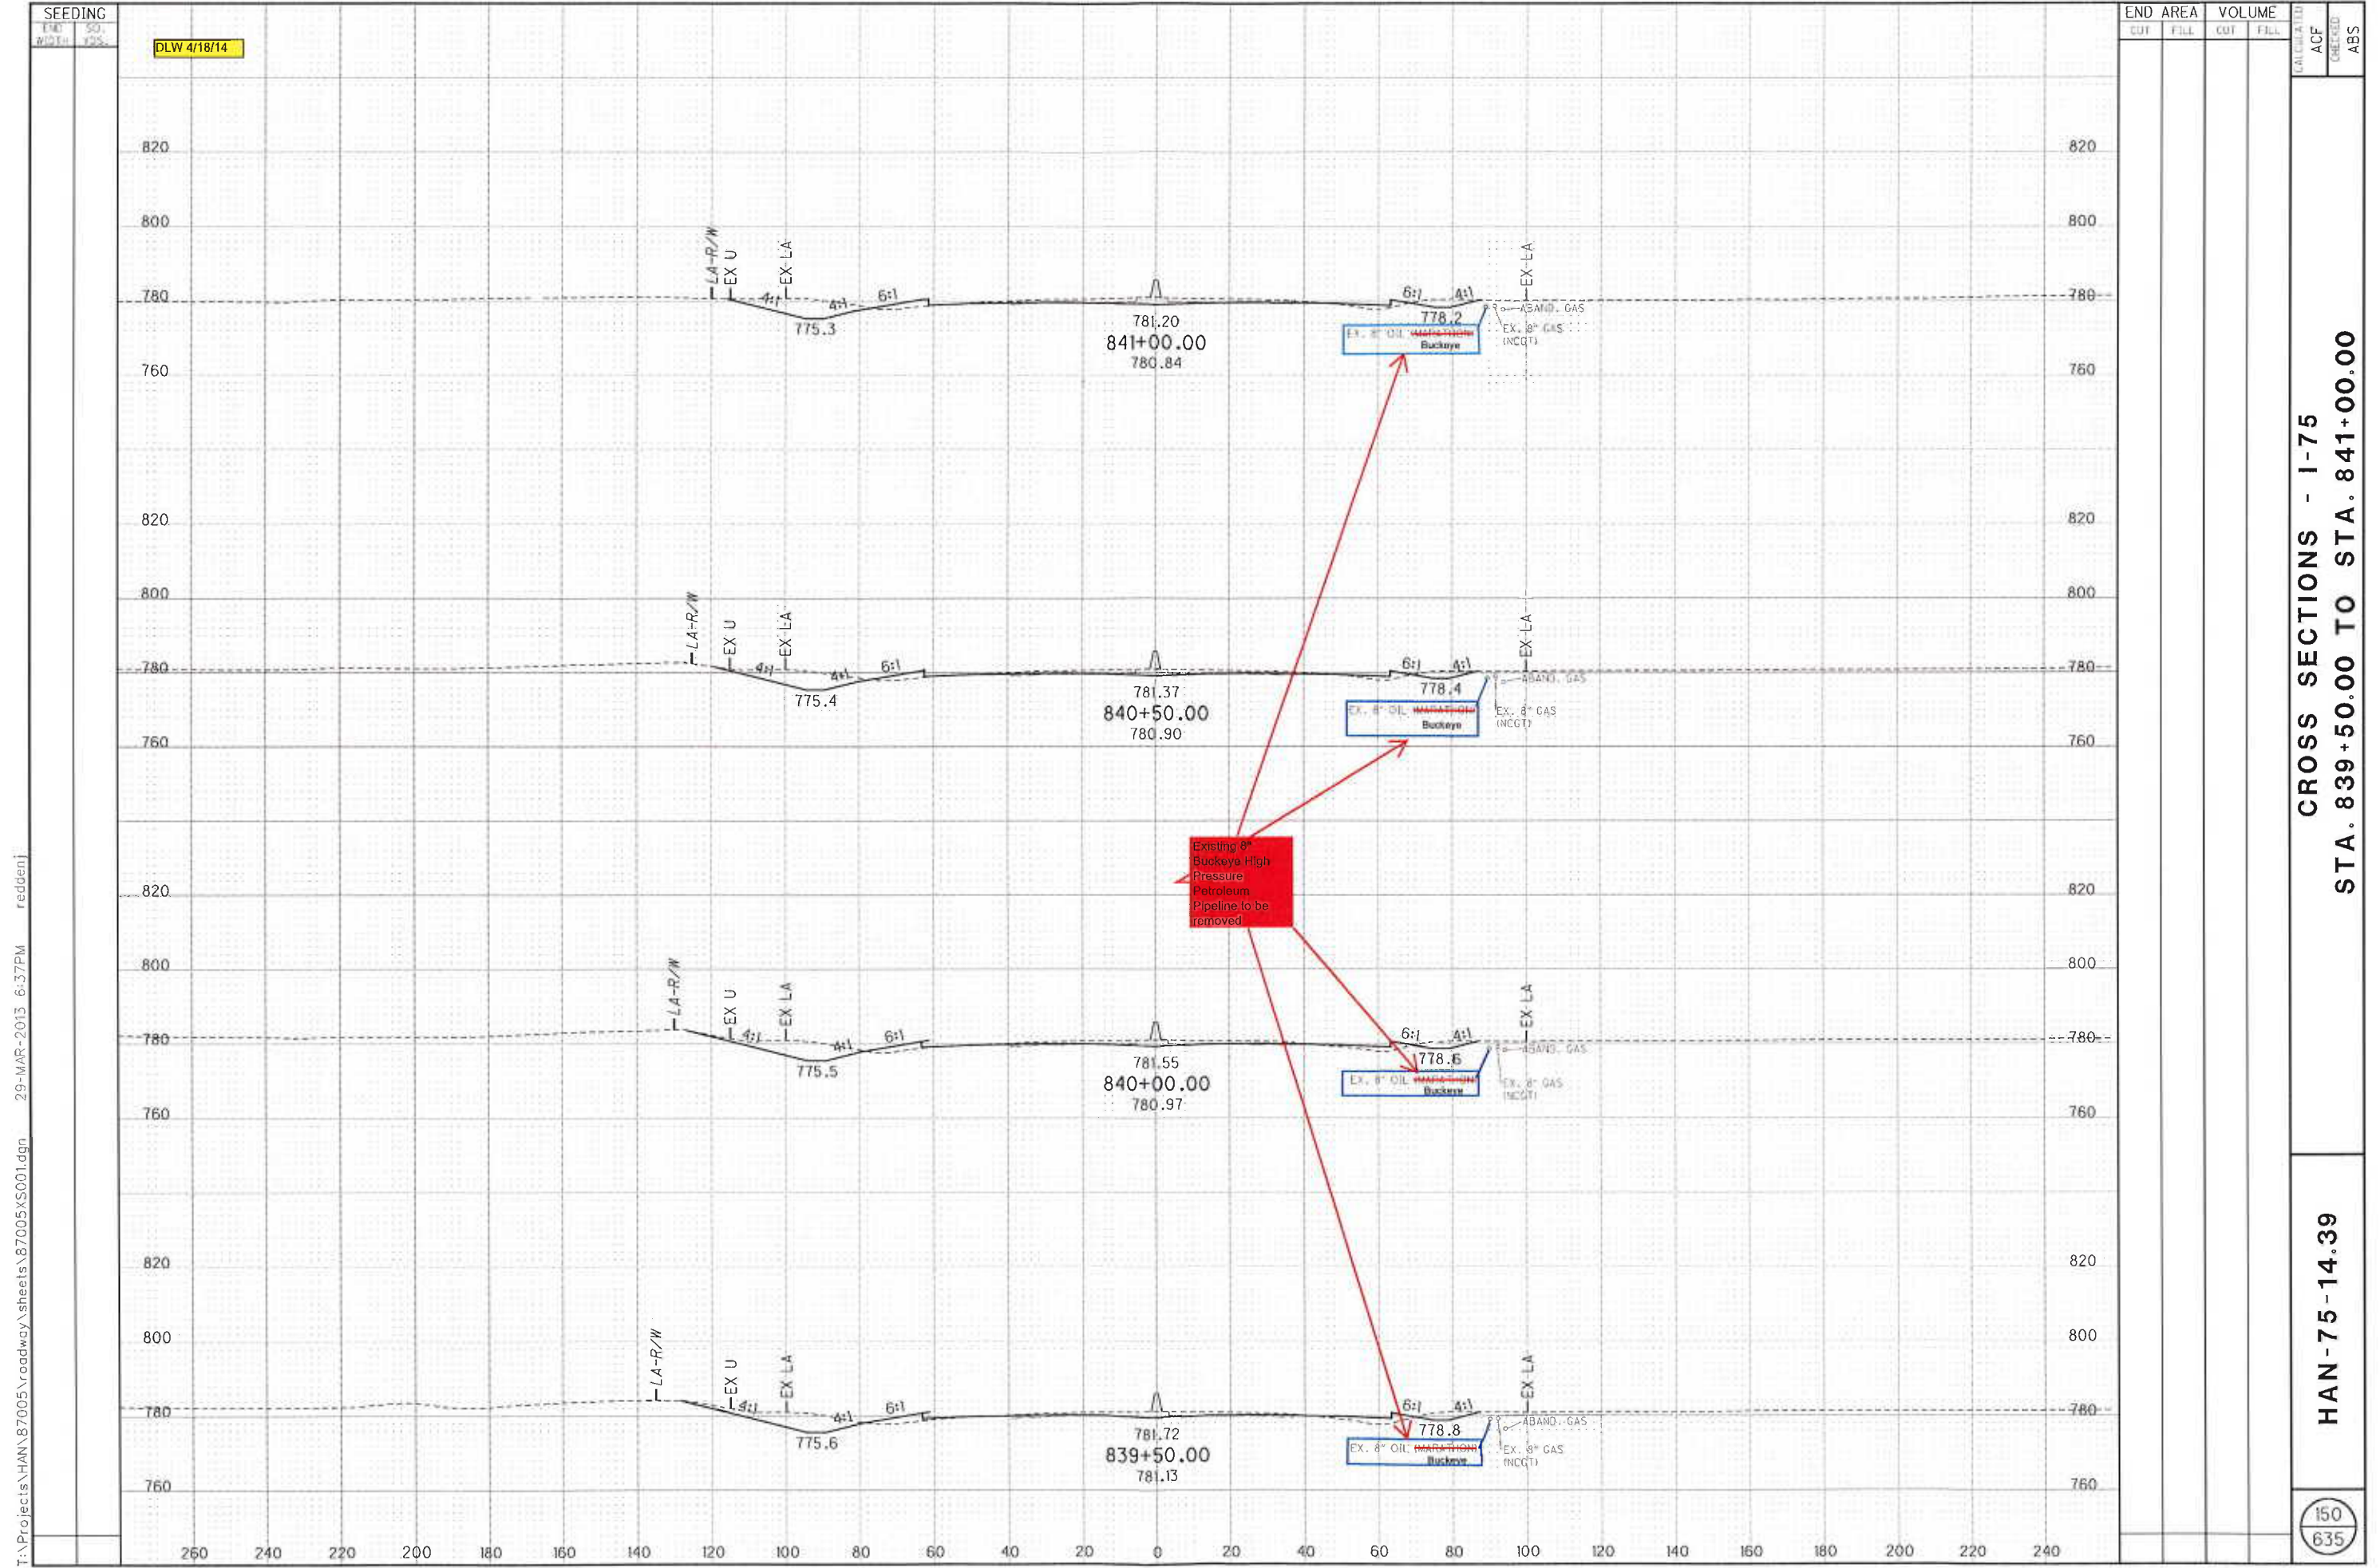

**CROSS SECTIONS - I-75**  
**STA. 839+50.00 TO STA. 841+00.00**


**HAN-75-14.39**

150  
635

T:\Projects\HAN\87005\roadway\sheets\87005XS001.dgn 29-MAR-2013 6:37PM reddentj



T:\Projects\HAN\87005\roadway\sheet\87005XS001.dgn 29-MAR-2013 6:36PM redderj

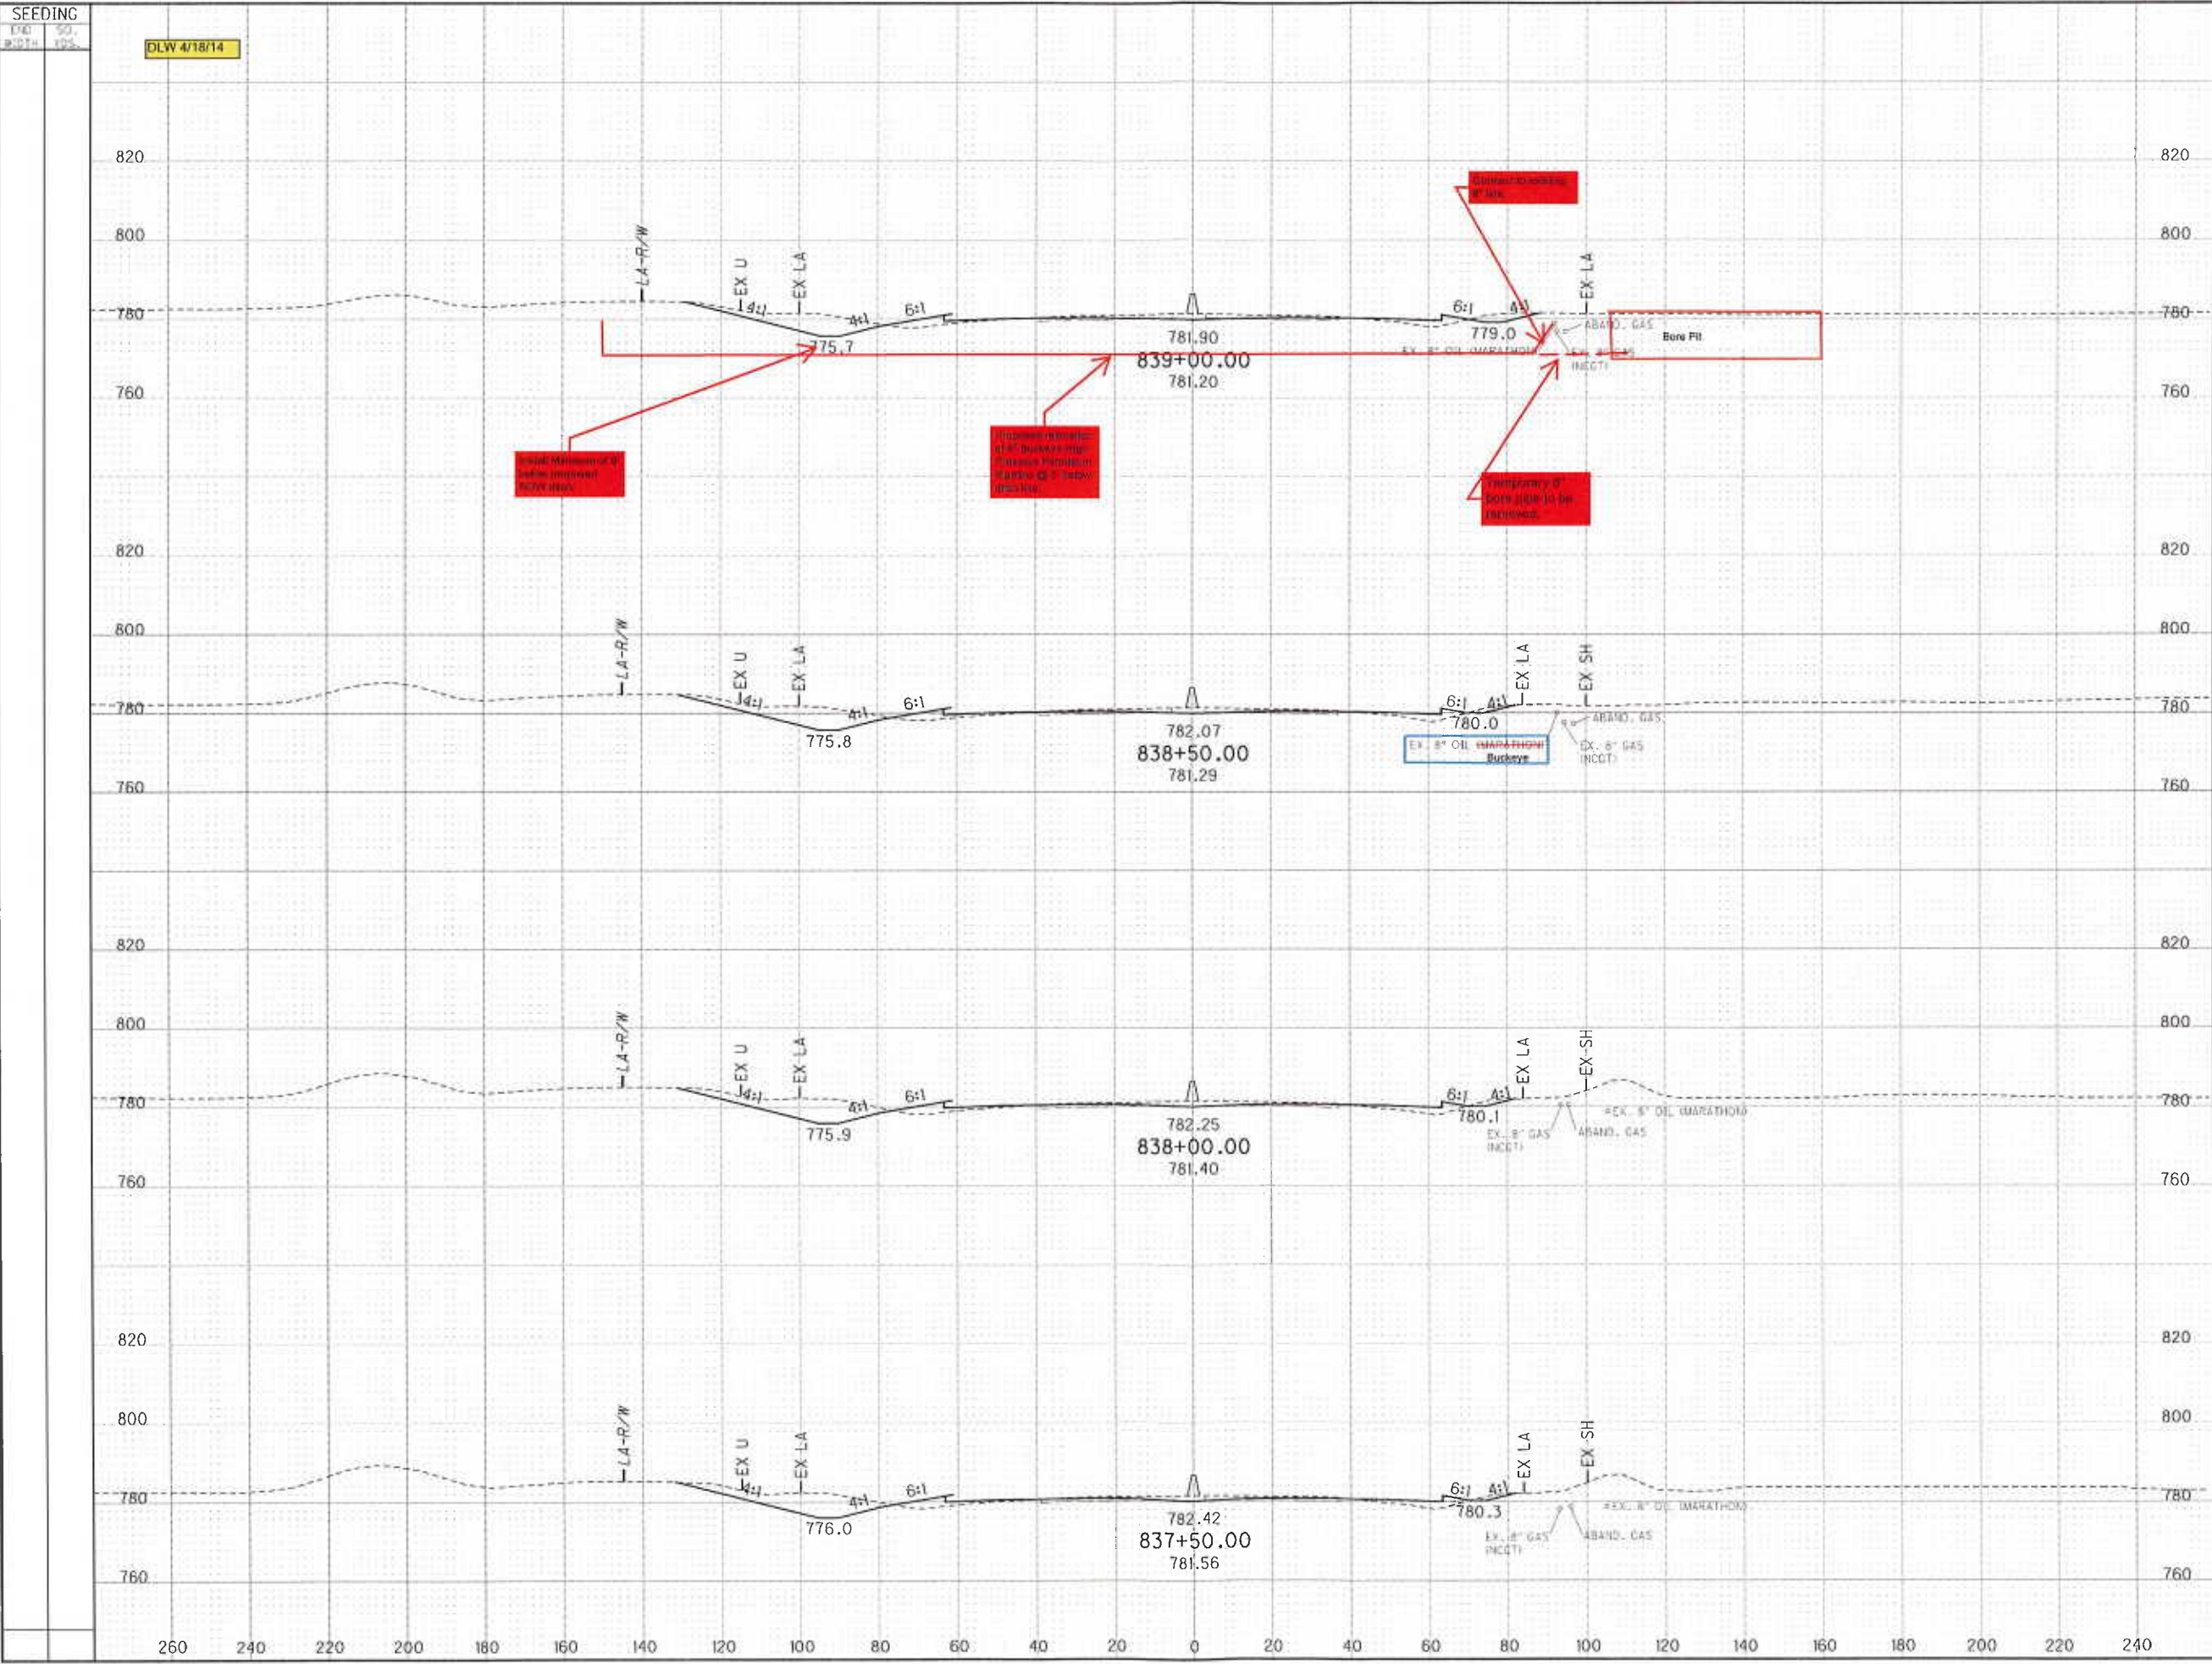

SEEDING	
DATE	BY
DLW 4/18/14	

END AREA	VOLUME	CHECKED	DATE

CROSS SECTIONS - I-75  
STA. 837+50.00 TO STA. 839+00.00

HAN-75-14.39