


T:\Projects\HAN\87005\roadway\sheets\87005XS002.dgn 30-SEP-2013 9:41PM redderj

SEEDING
END SO.
WIDTH 10%

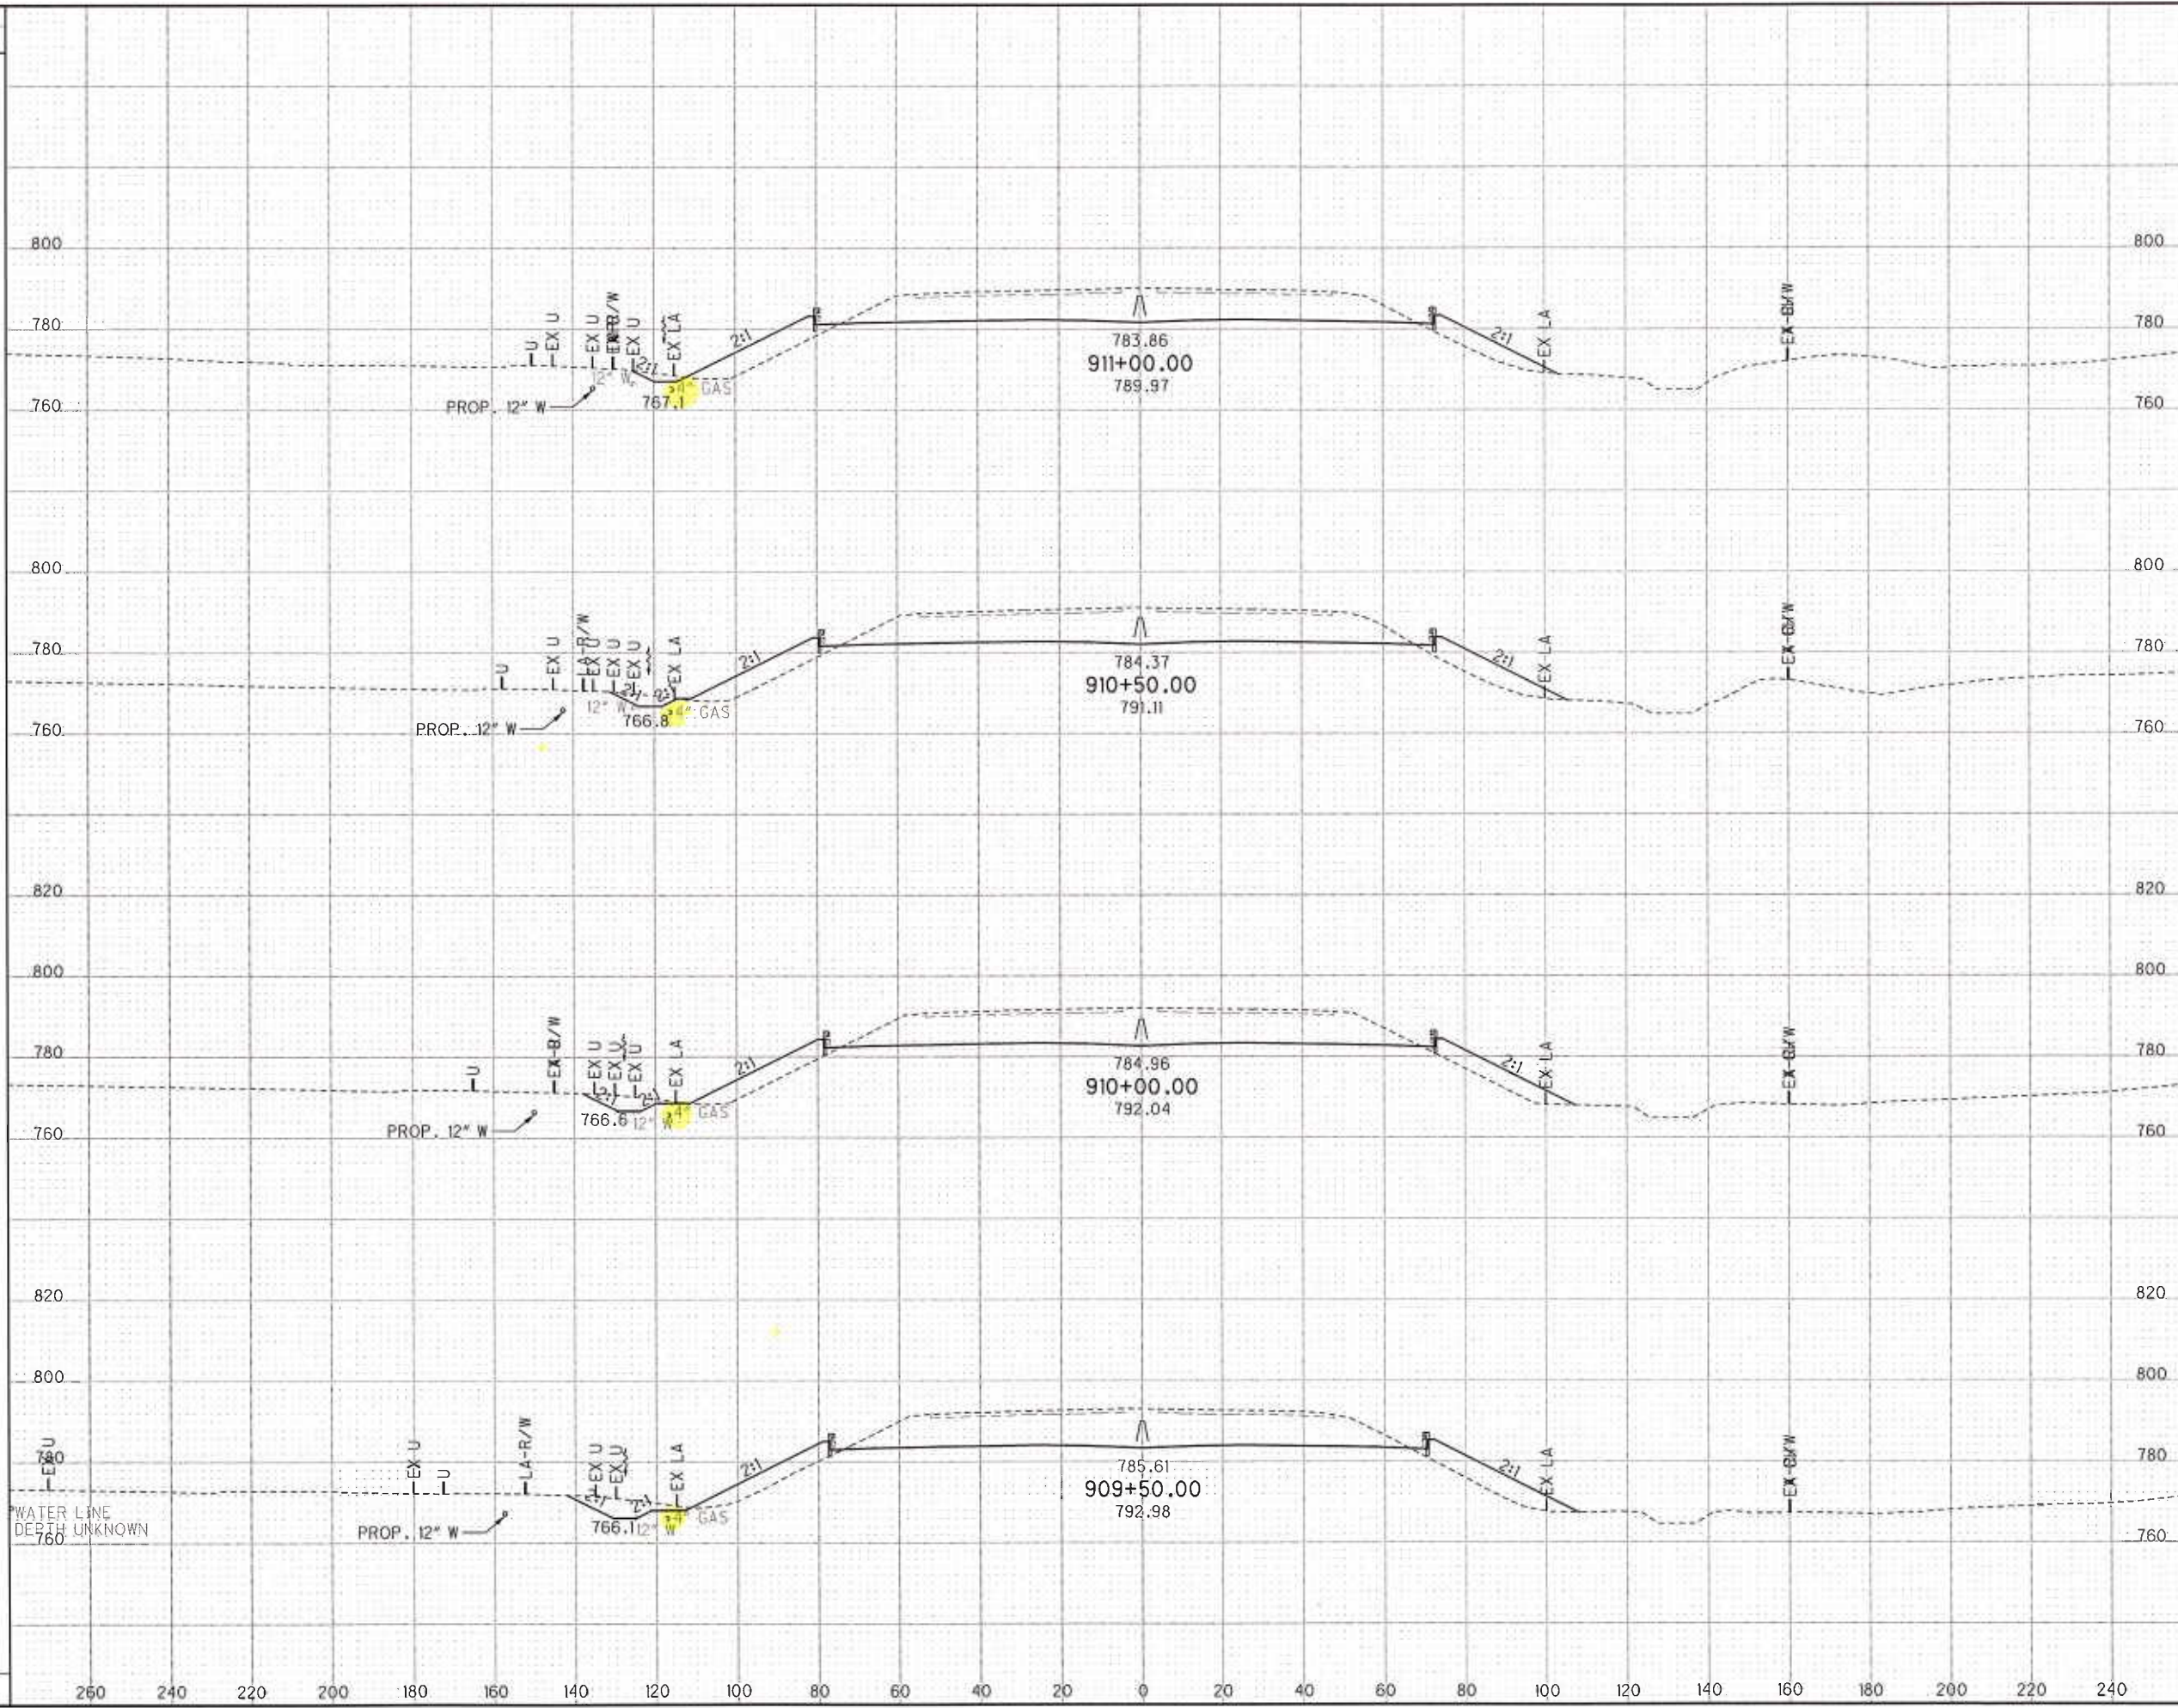


END AREA	VOLUME	CALCULATED		CHECKED	DATE
		CUT	FILL		

CROSS SECTIONS - I-75
STA. 909+50.00 TO STA. 911+00.00

HAN-75-14.39

218
842

T:\Projects\HAN\87005\roadway\sheets\87005XS002.dgn 30-SEP-2013 9:41PM reddnj

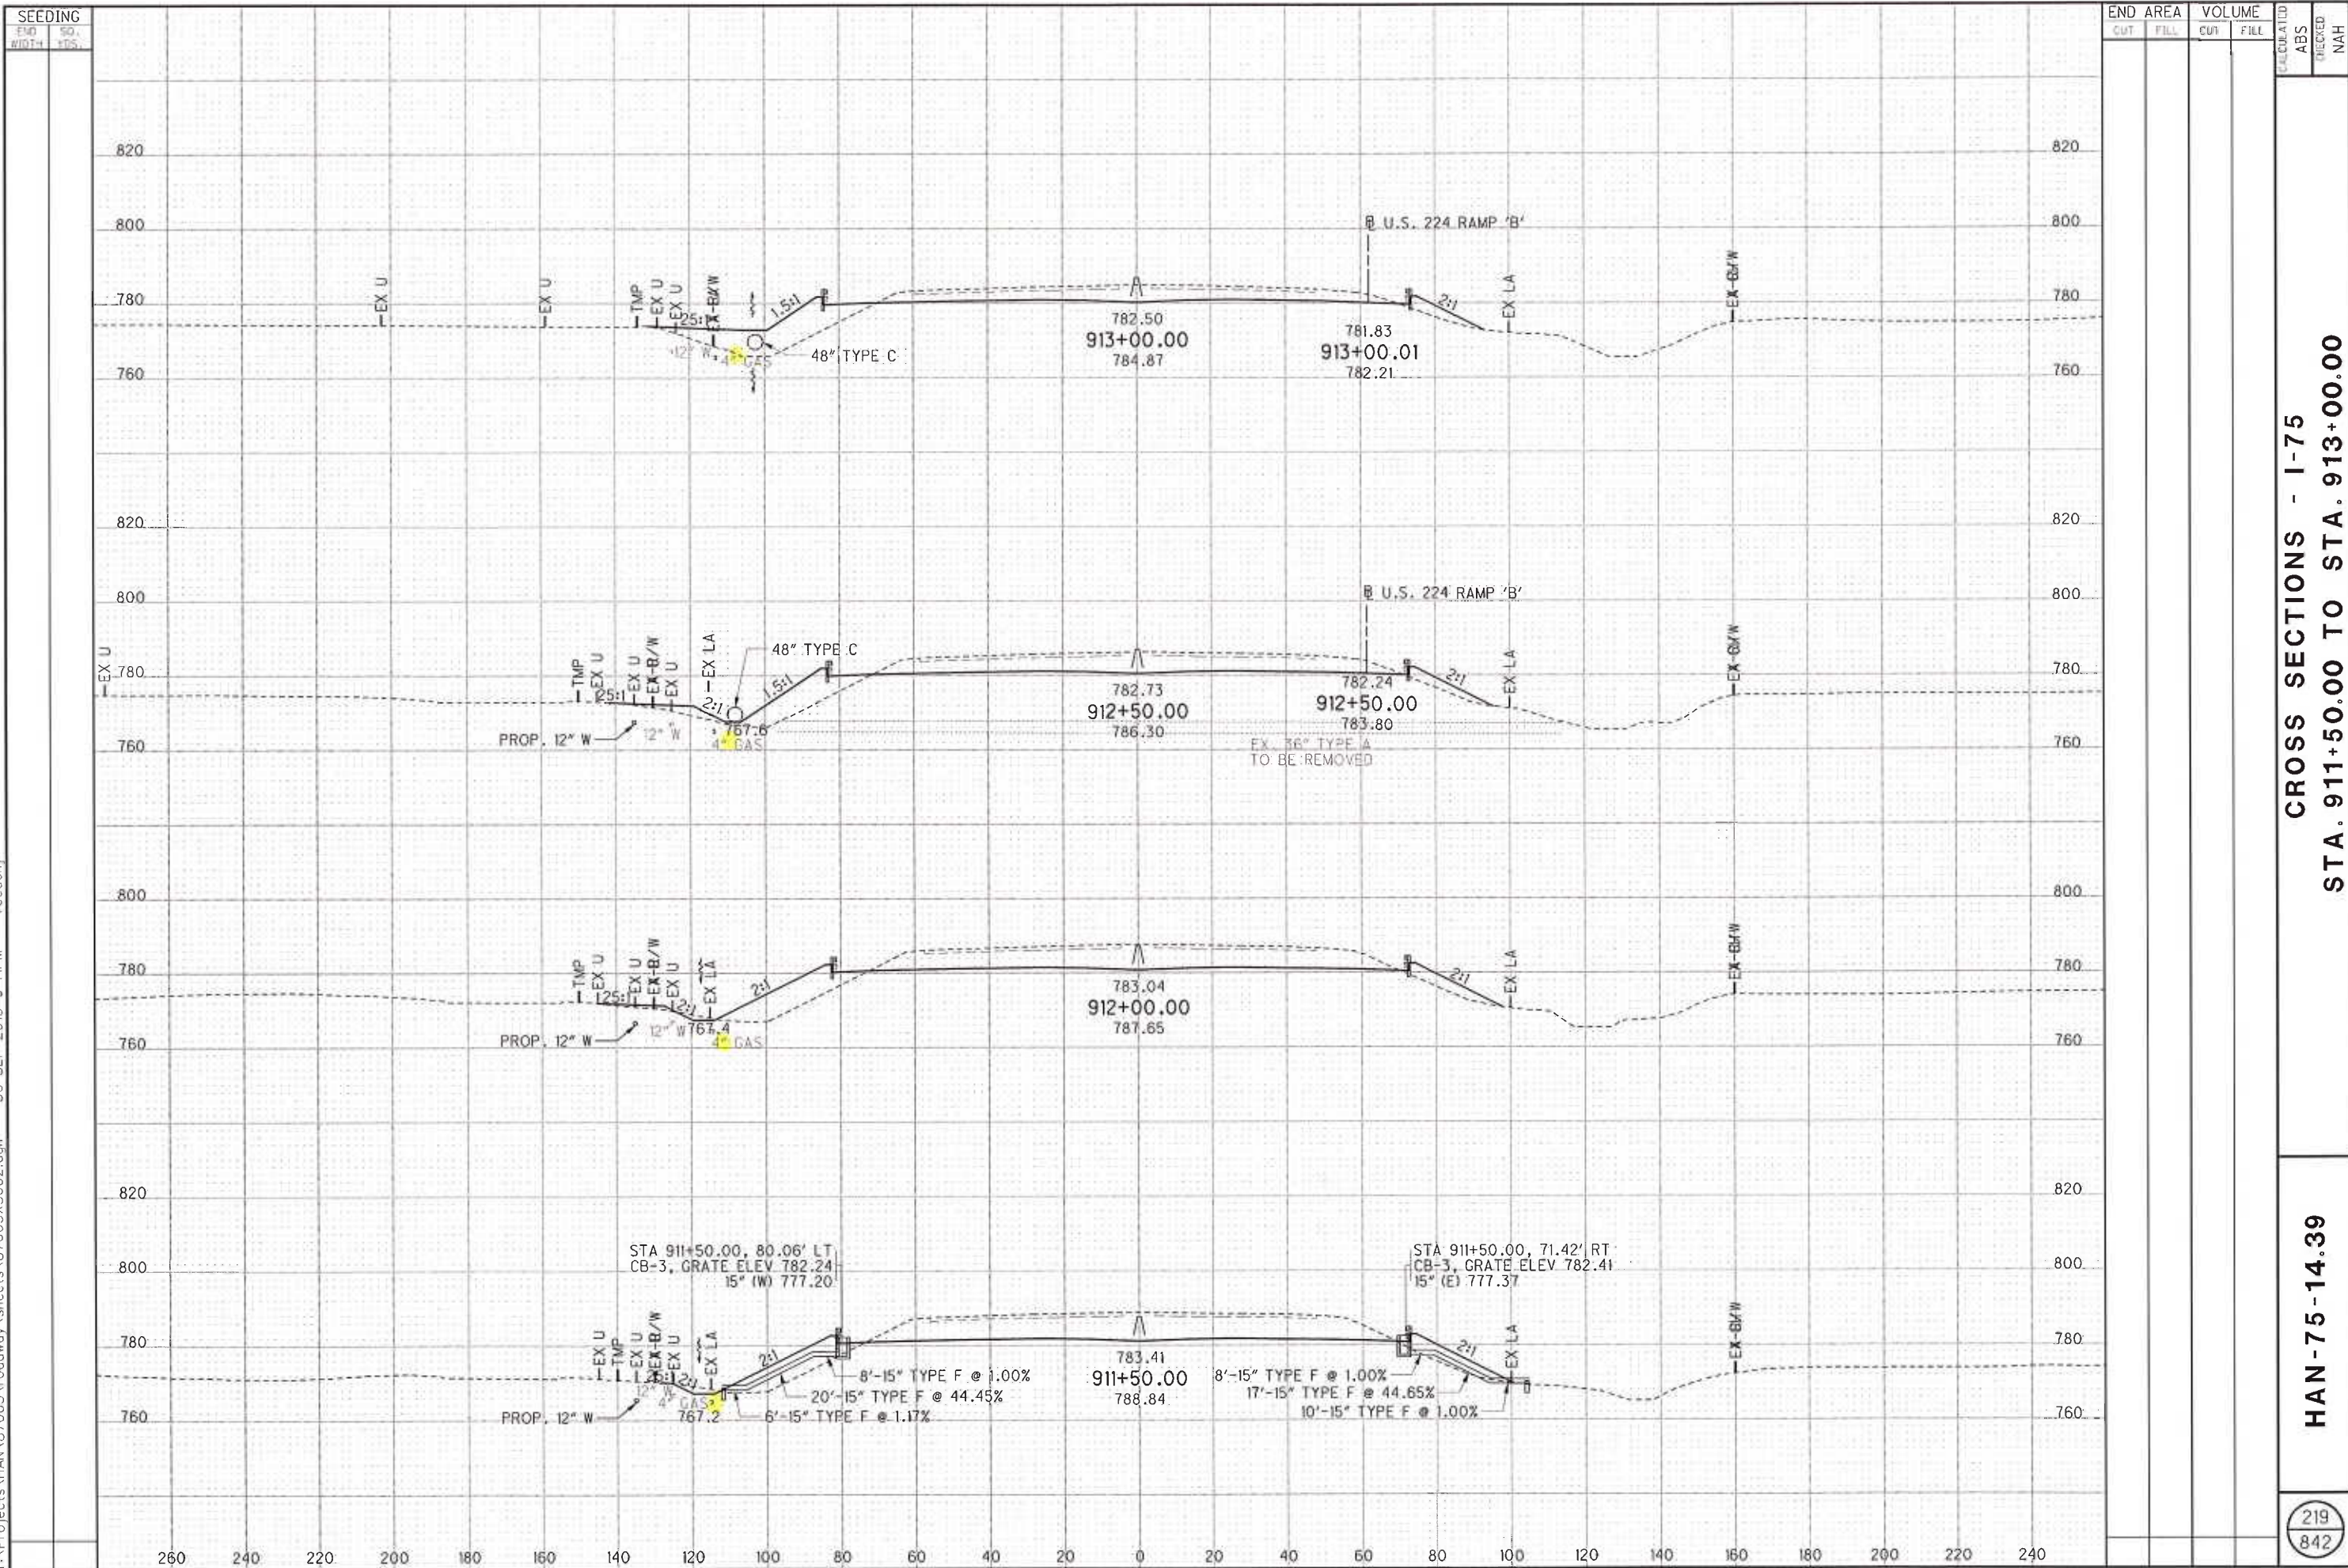

SEEDING	
END SO.	SO. FTS.

END AREA		VOLUME		CALCULATED	ABS	CHECKED	NAH
CUT	FILL	CUT	FILL				

CROSS SECTIONS - I-75
STA. 911+50.00 TO STA. 913+00.00


HAN-75-14.39

219
842

T:\Projects\HAN\87005\roadway\sheet\87005XS002.dgn 30-SEP-2013 9:41PM redderj

SEEDING	
END	SO.
WIDTH	YOG.

END AREA		VOLUME		CALCULATED	CHECKED	DATE
CUT	FILL	CUT	FILL			

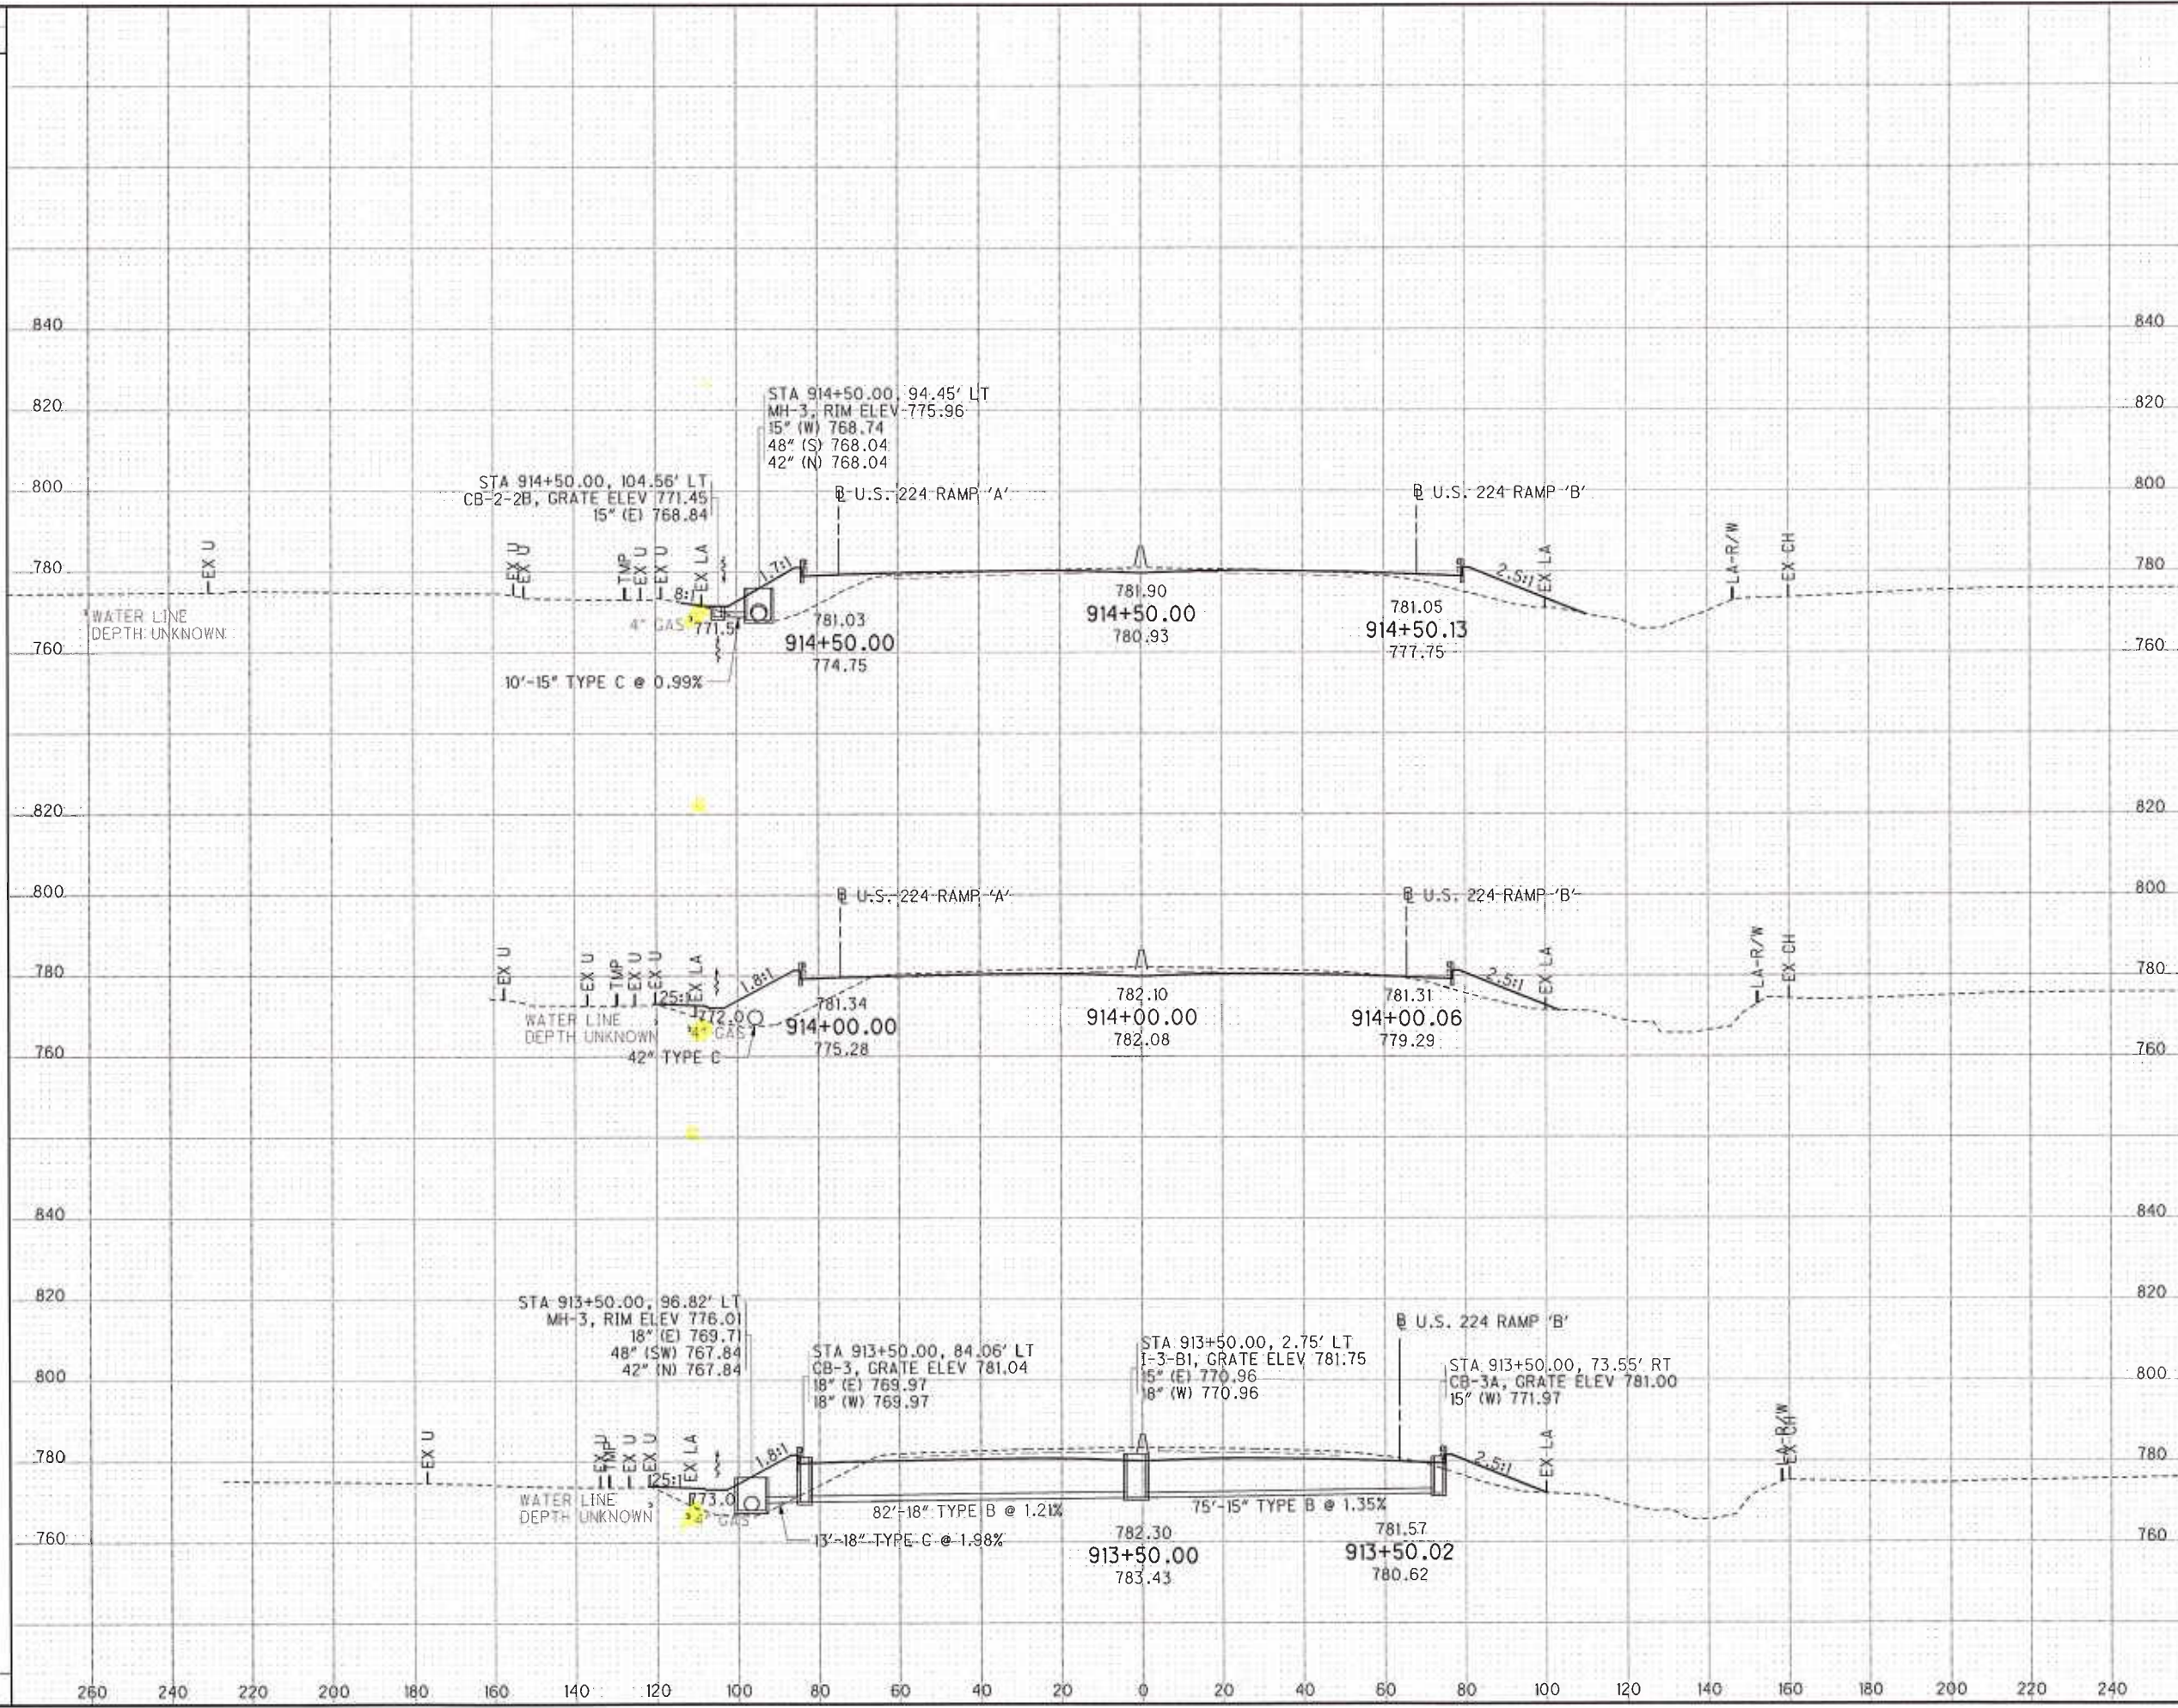

CROSS SECTIONS - I-75
STA. 913+50.00 TO STA. 914+50.00


HAN-75-14.39

220
842

T:\Projects\HAN\87005\roadway\sheet\87005XS002.dgn 30-SEP-2013 9:41PM redder]

SEEDING	
END WIDTH	SO. YDS.

END AREA		VOLUME		CALCULATED	
CUT	FILL	CUT	FILL	ABS	NAH

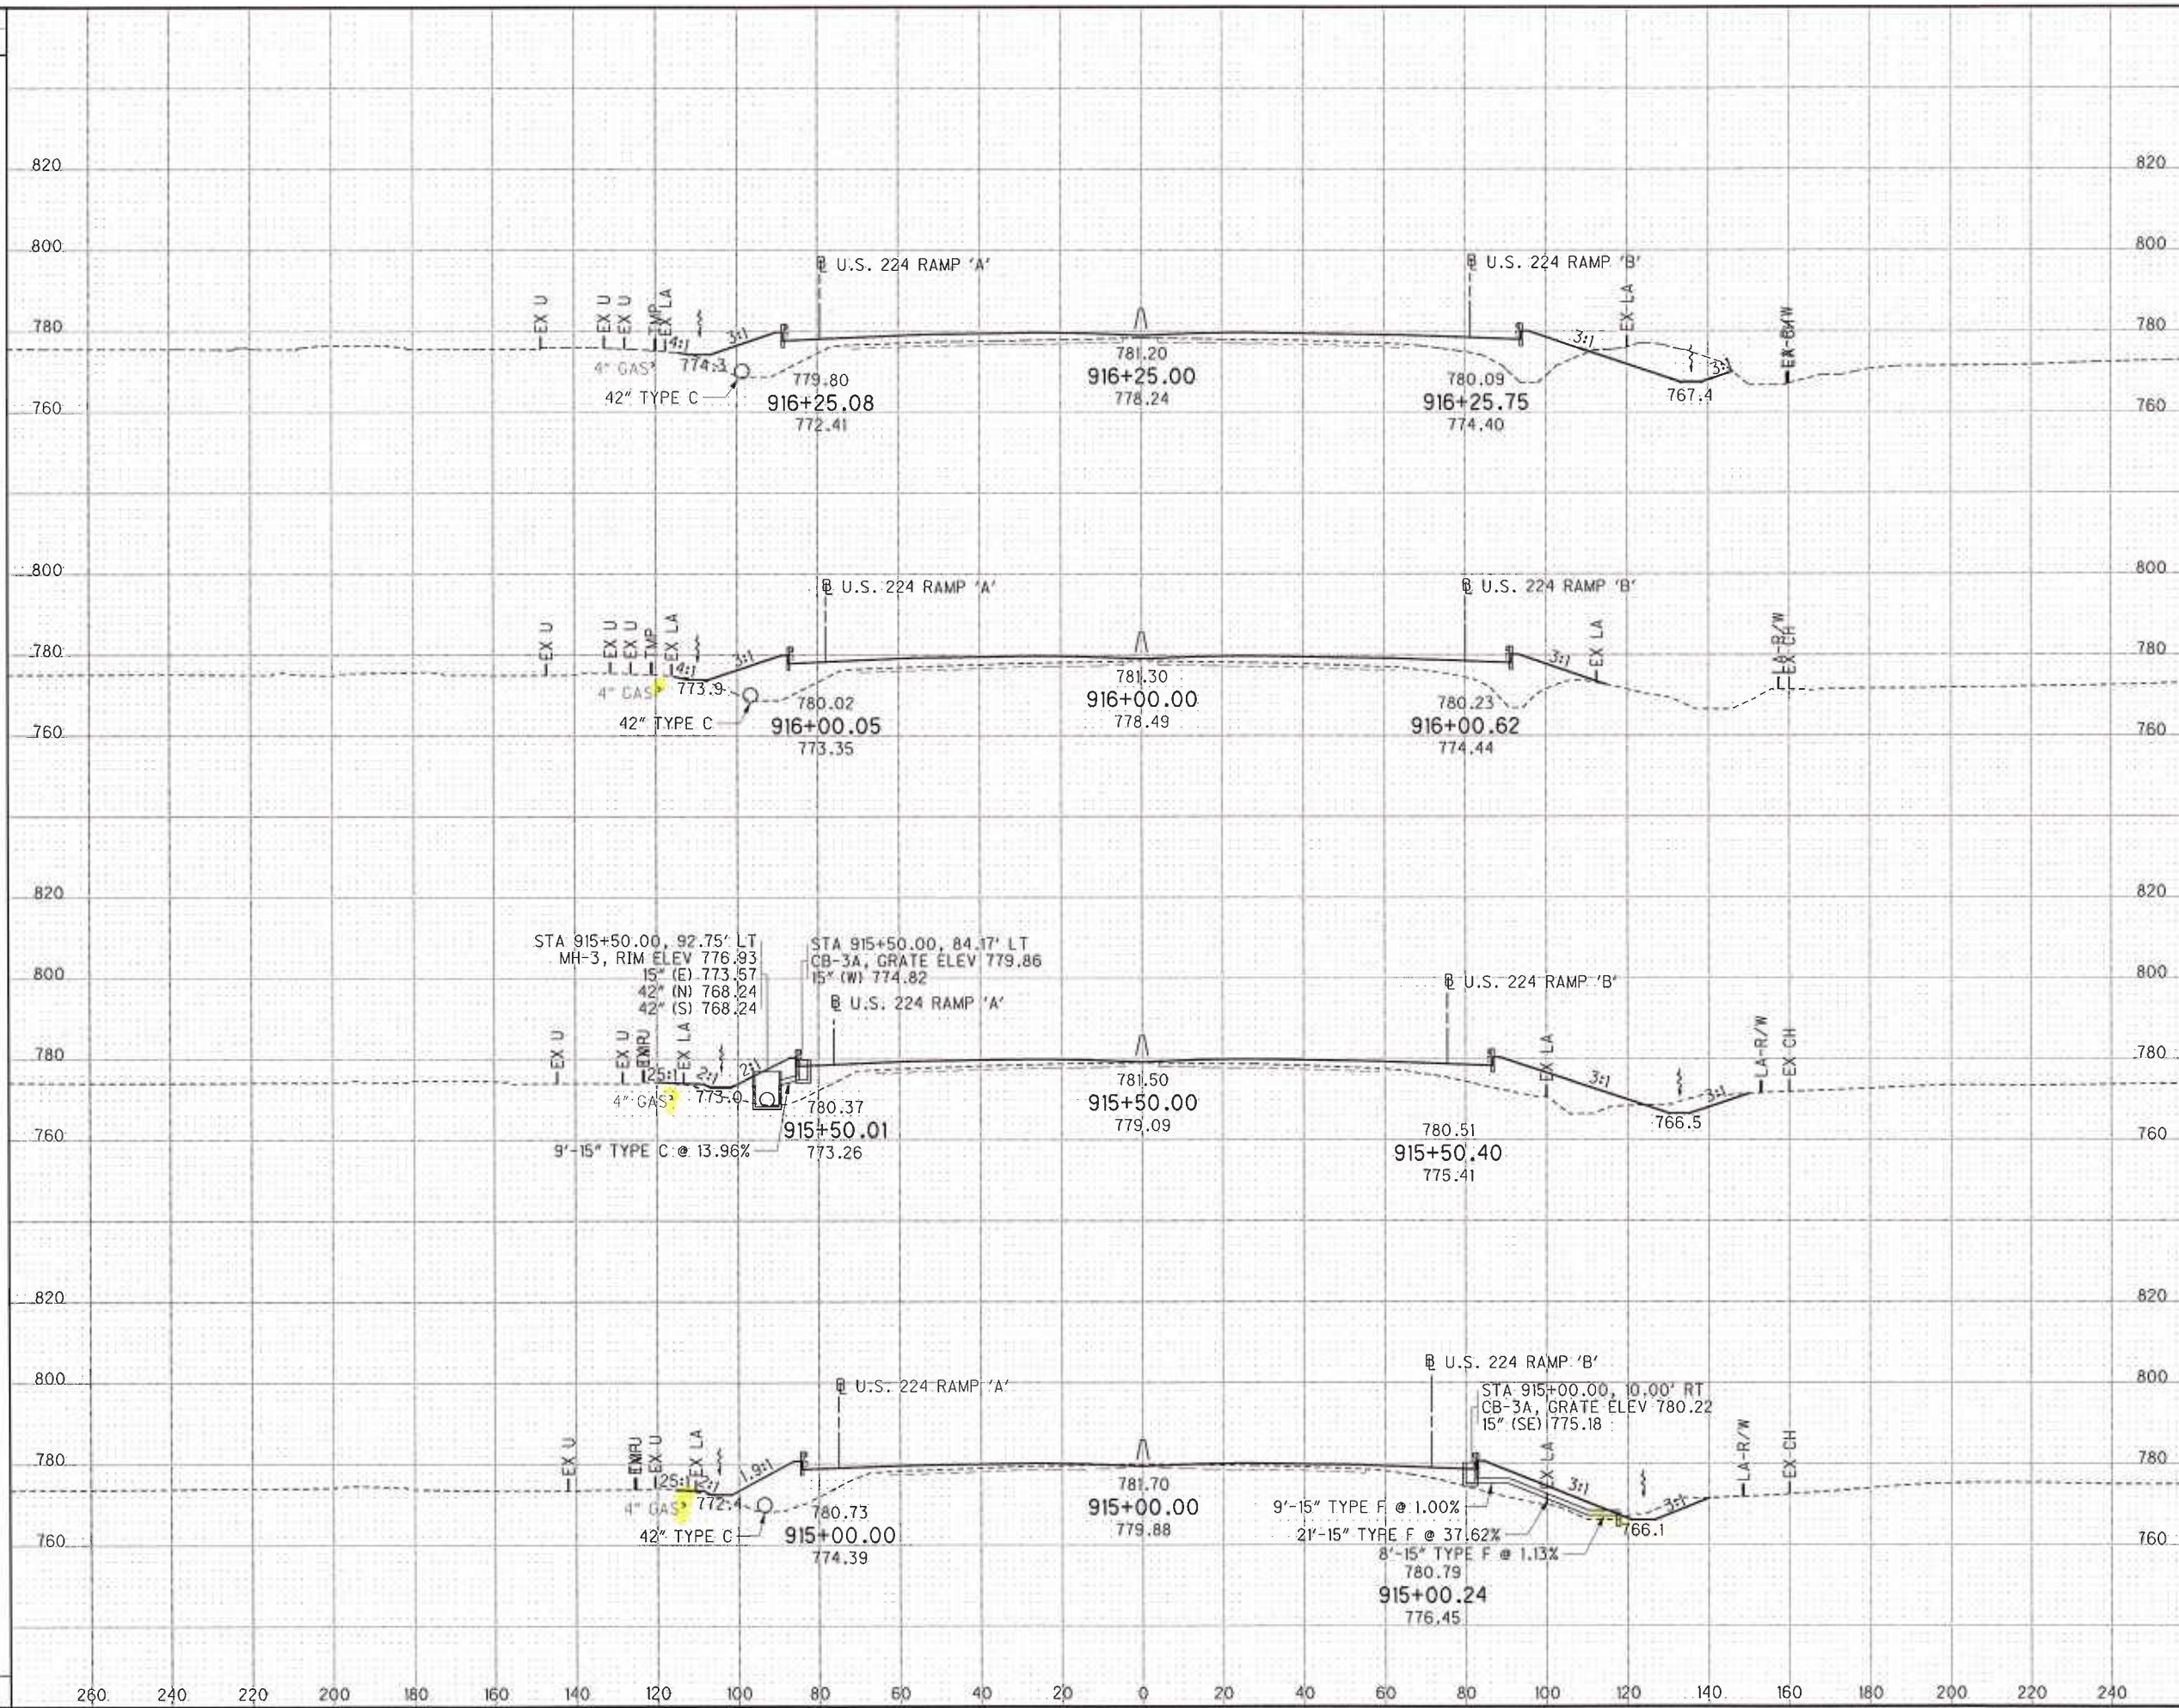

CROSS SECTIONS - I-75
STA. 915+00.00 TO STA. 916+25.00

HAN-75-14.39

221
842