


T:\Projects\HAN\87005\roadway\sheet\87005GP015.dgn 30-SEP-2013 10:01PM redder

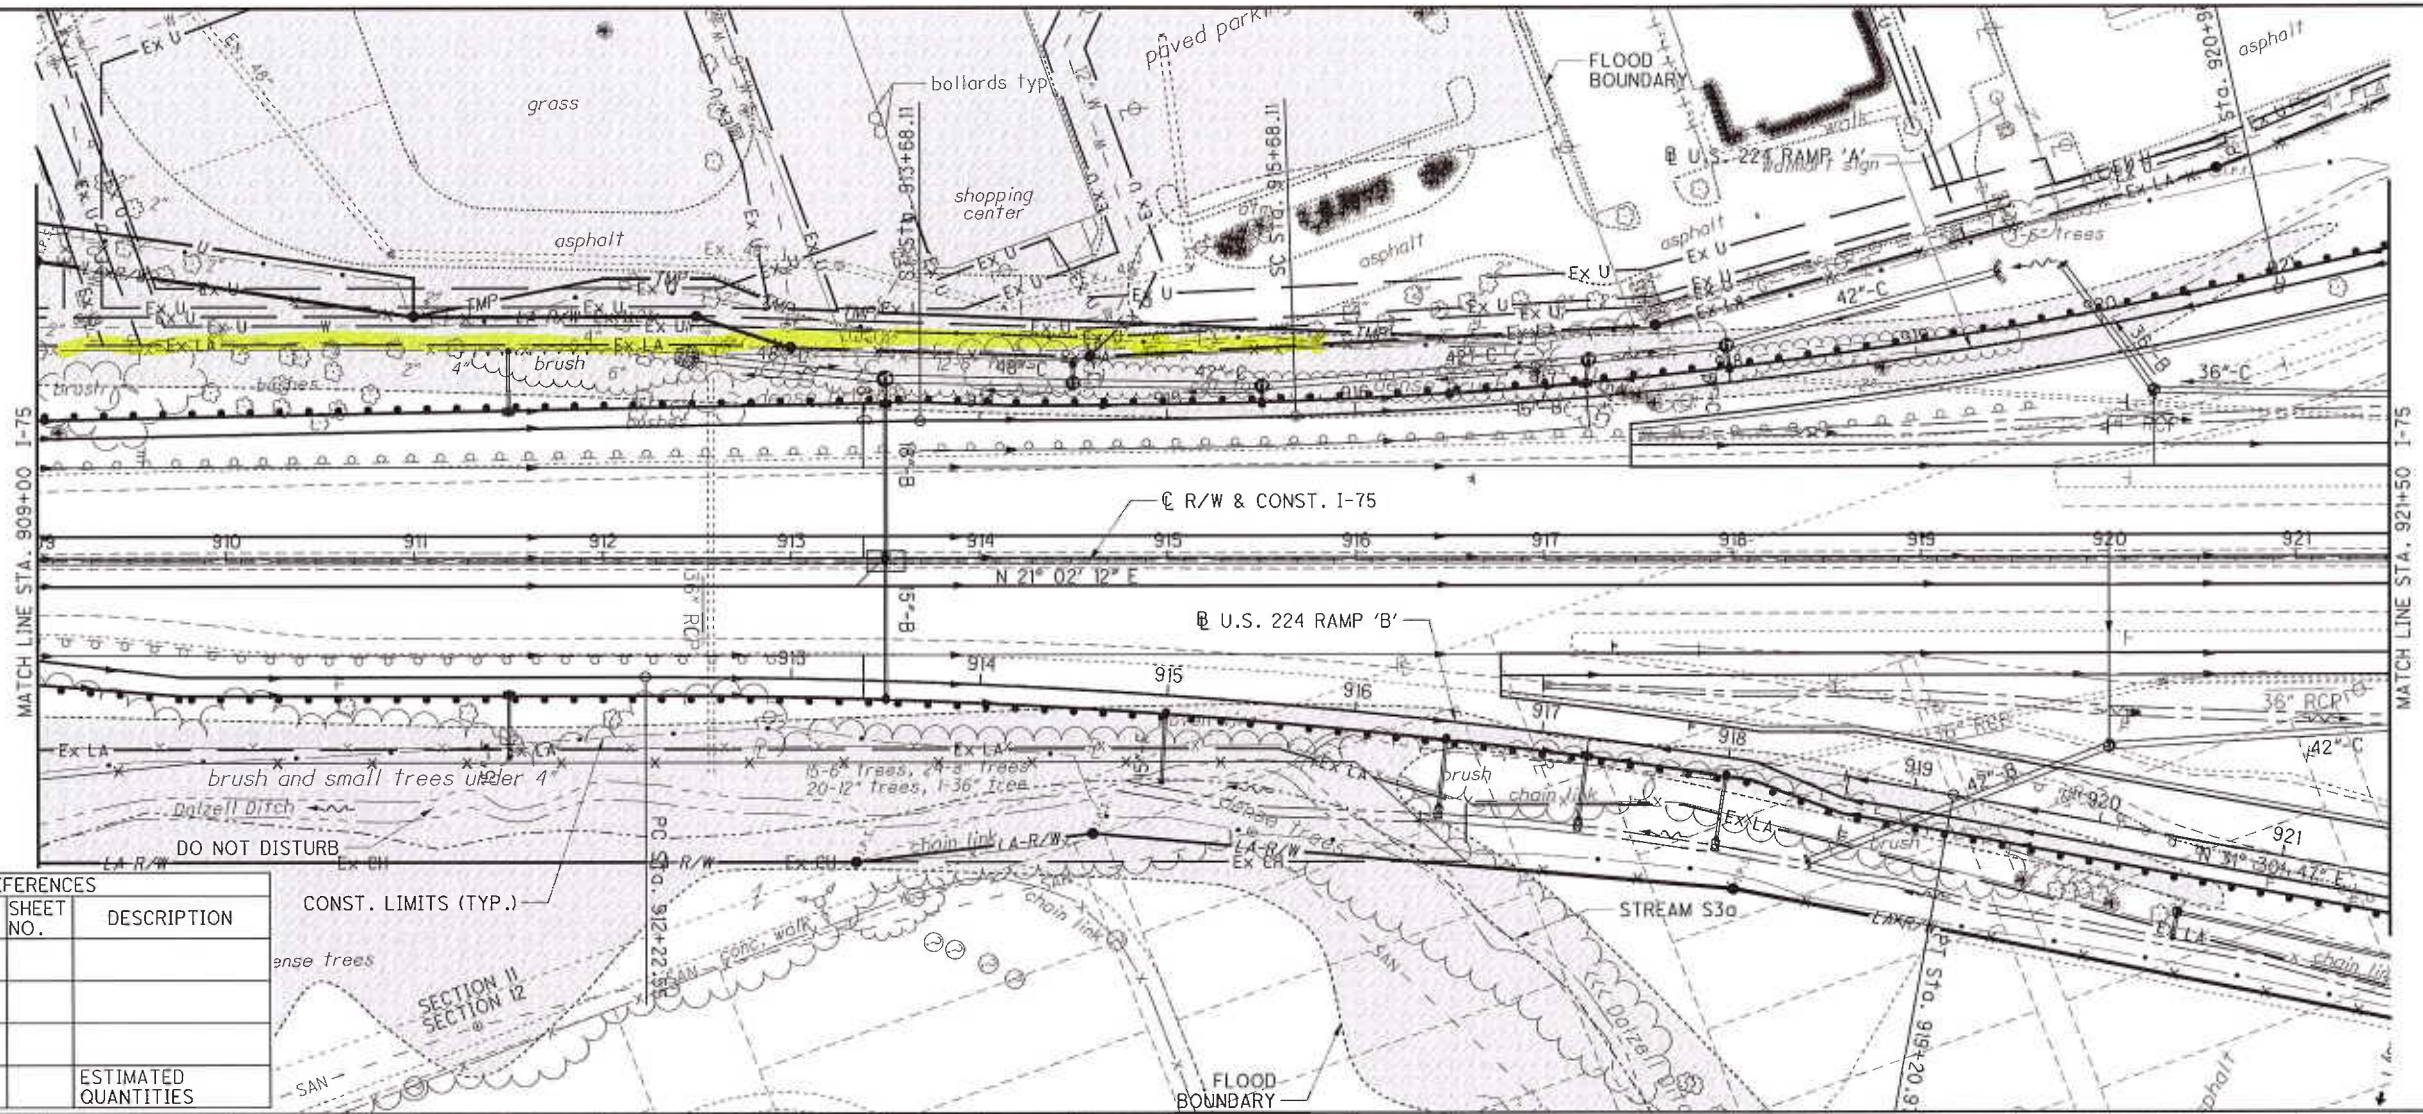


CROSS REFERENCES			
SHEET NO.	DESCRIPTION	SHEET NO.	DESCRIPTION
	CROSS SECTIONS		
			ESTIMATED QUANTITIES

CONST. LIMITS (TYP.)

SECTION 11
SECTION 12

DO NOT DISTURB

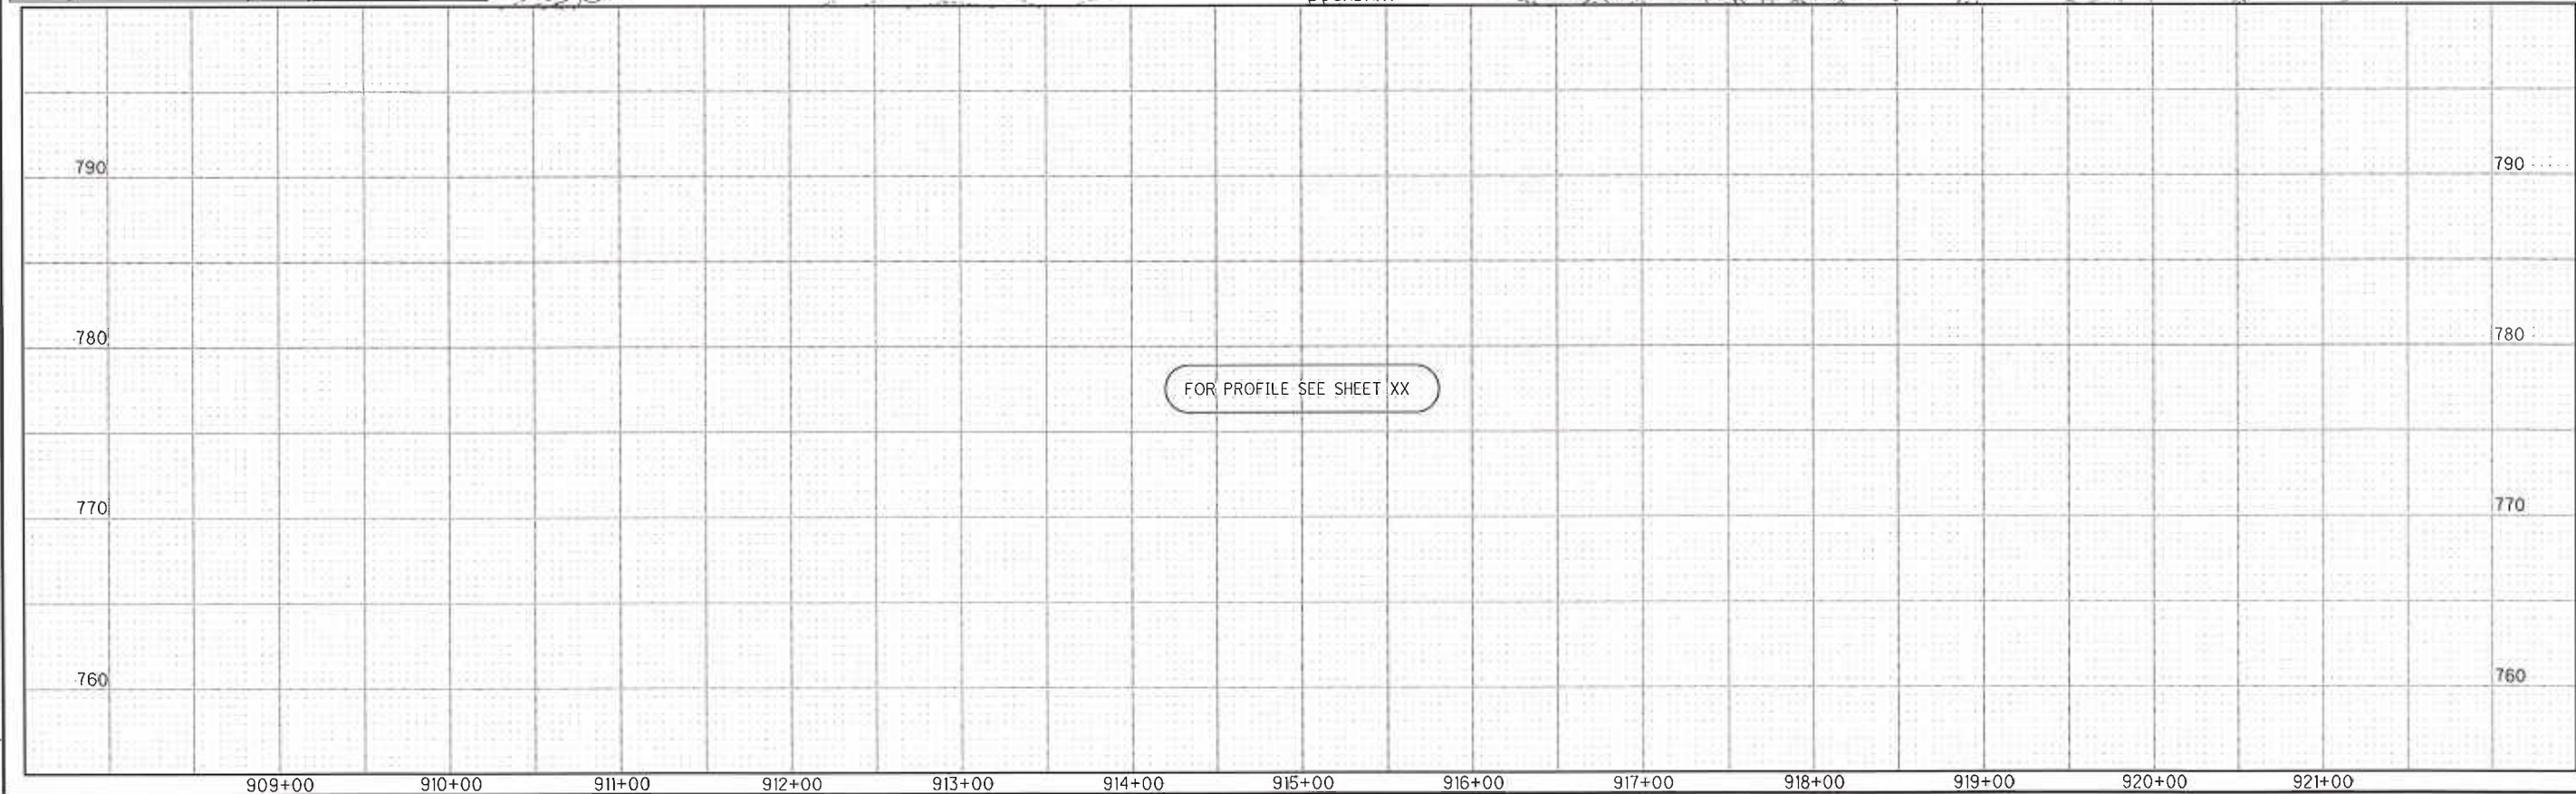

HORIZONTAL SCALE IN FEET

CHECKED

PLAN AND PROFILE - I-75
STA. 909+00 TO STA. 921+50

HAN-75-14.39

120
842