



ESTIMATED QUANTITIES ON THIS SHEET:


ITEM 601 ROCK CHANNEL PROTECTION, TYPE B, WITH FILTER 30 CU. YD.

ITEM 607 FENCE, TYPE 47, AS PER PLAN 1340 FT.

ITEM 607 FENCE, TYPE CLT, AS PER PLAN 740 FT.

ITEM 607 FENCELINE SEEDING AND MULCHING 2080 FT.

FENCING QUANTITIES INCLUDE ALL HARDWARE, POST, ETC., COMPLETE IN PLACE AND ARE CARRIED TO THE FENCING SUB-SUMMARY TABLE ON SHEET ----.

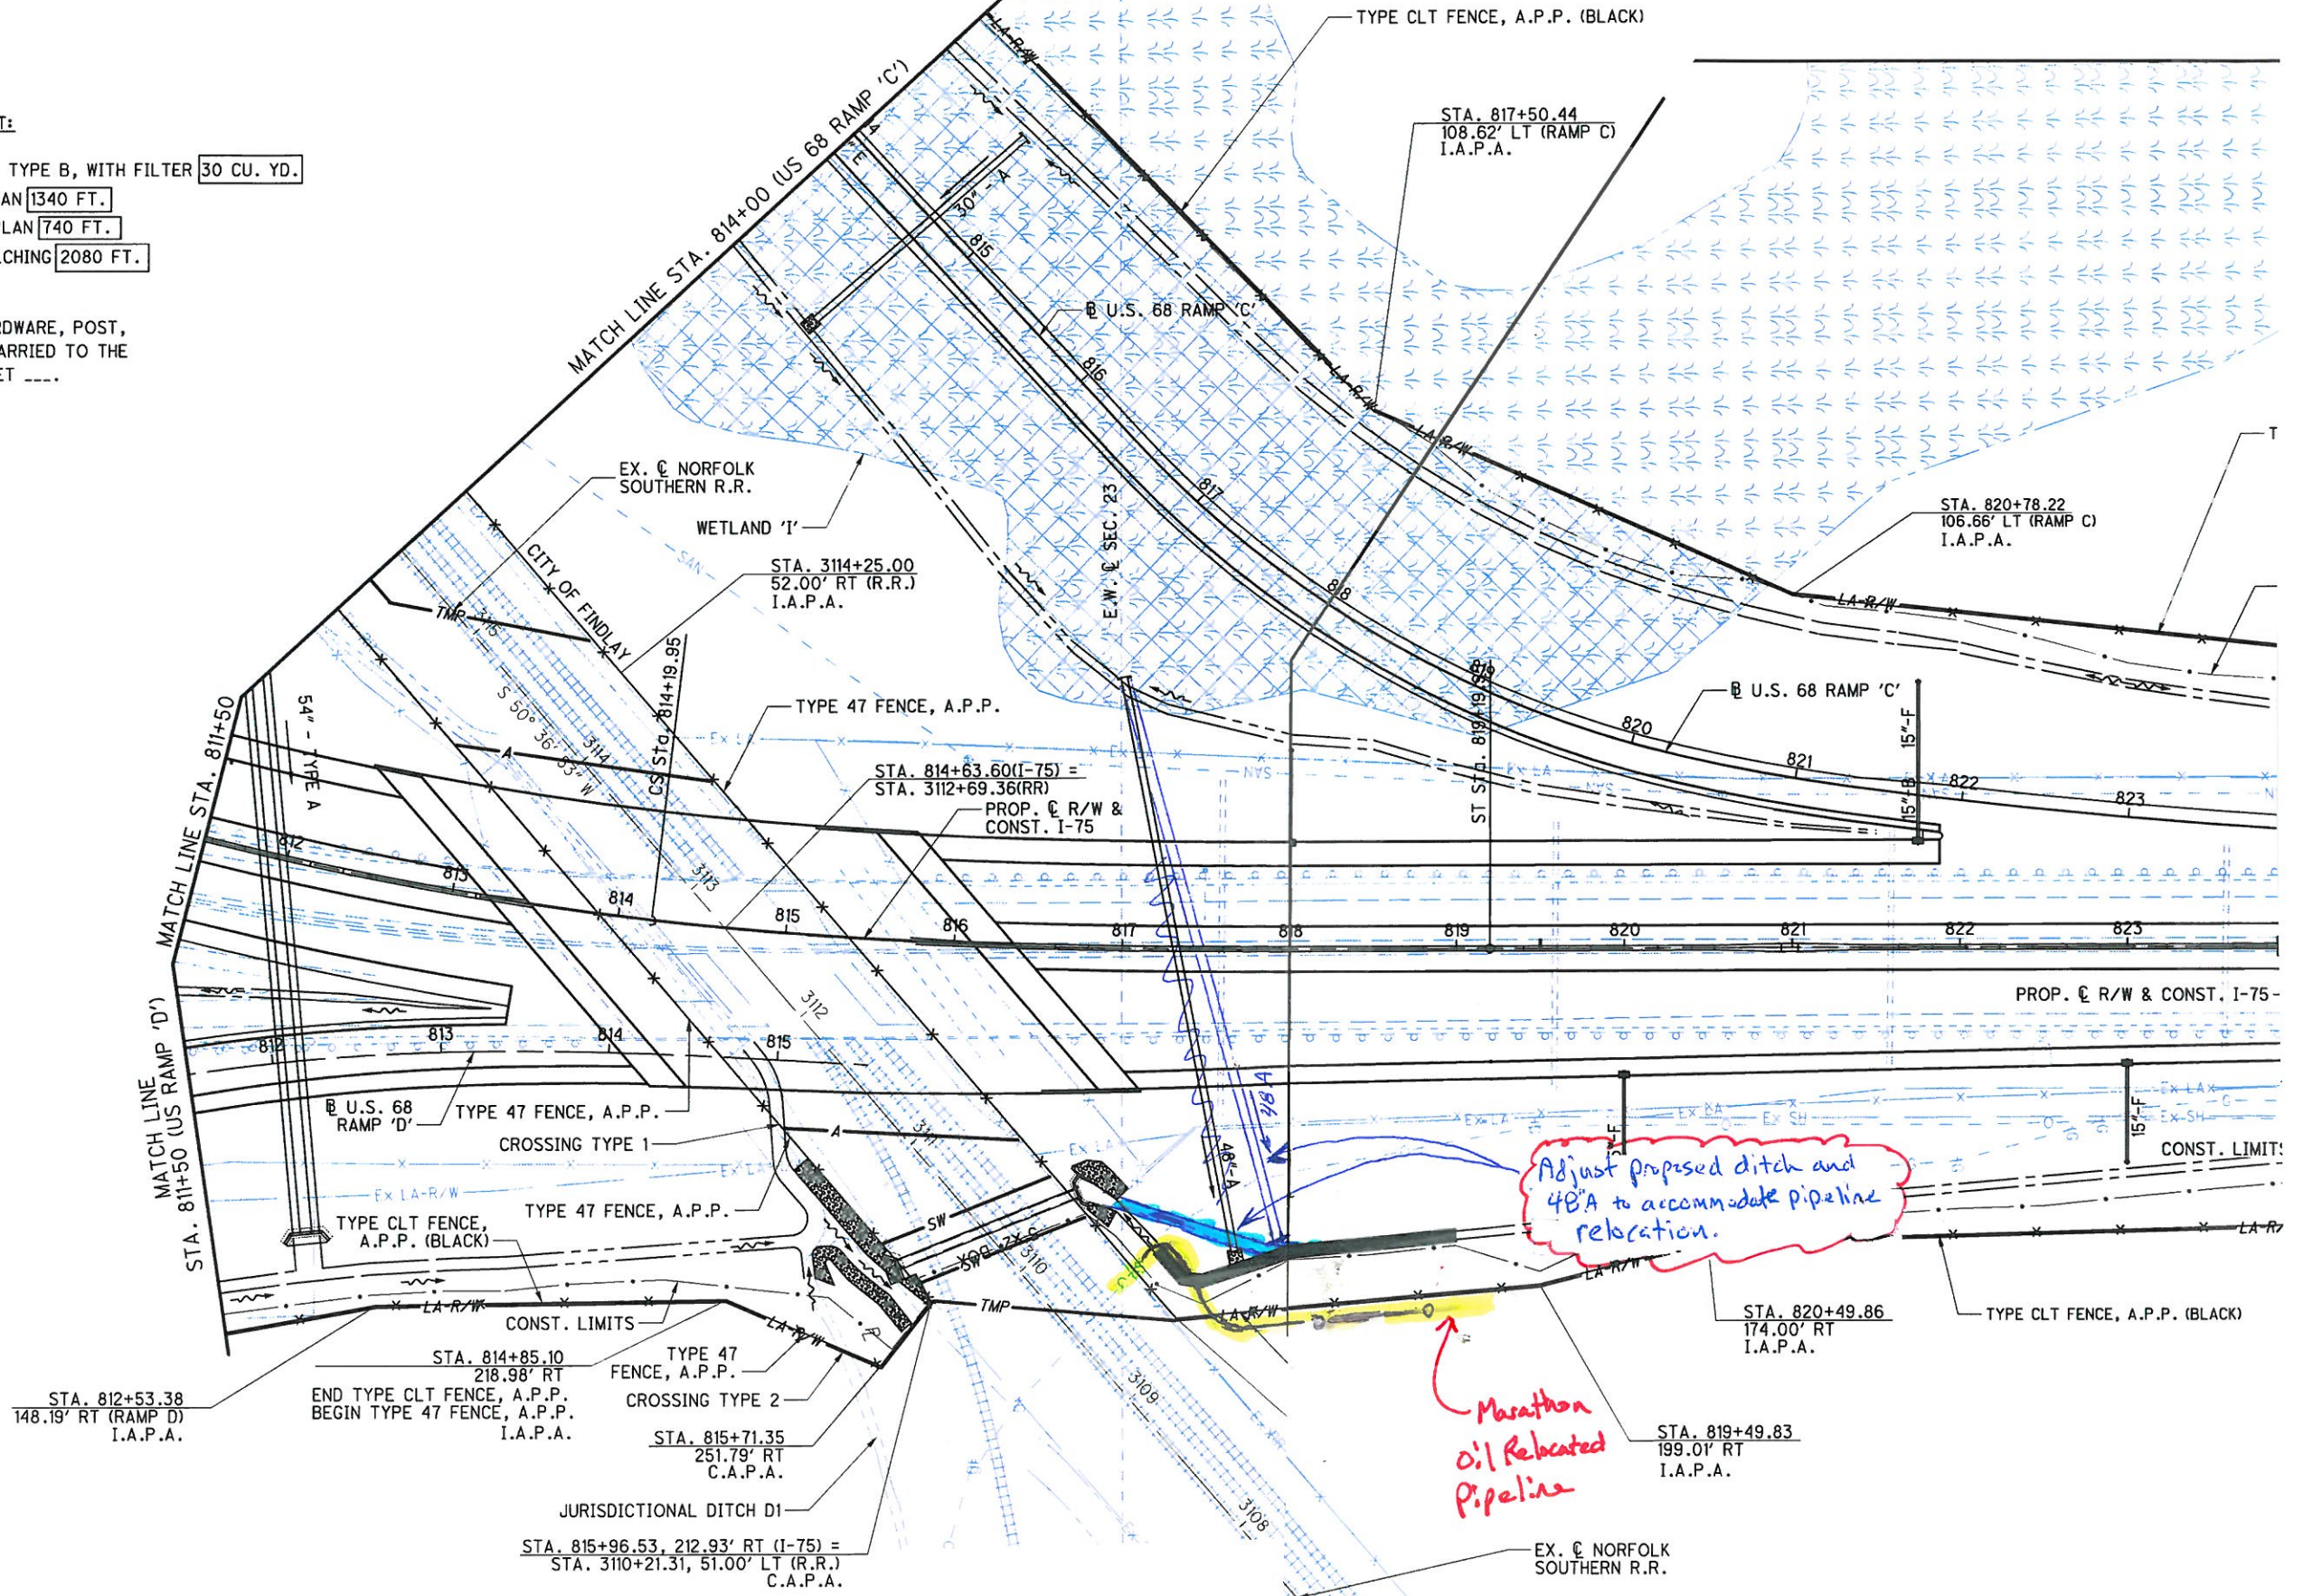

T:\Projects\HAN\87005\roadway\sheets\87005CX006.dgn 09-DEC-2013 10:46 AM mcmillanbl