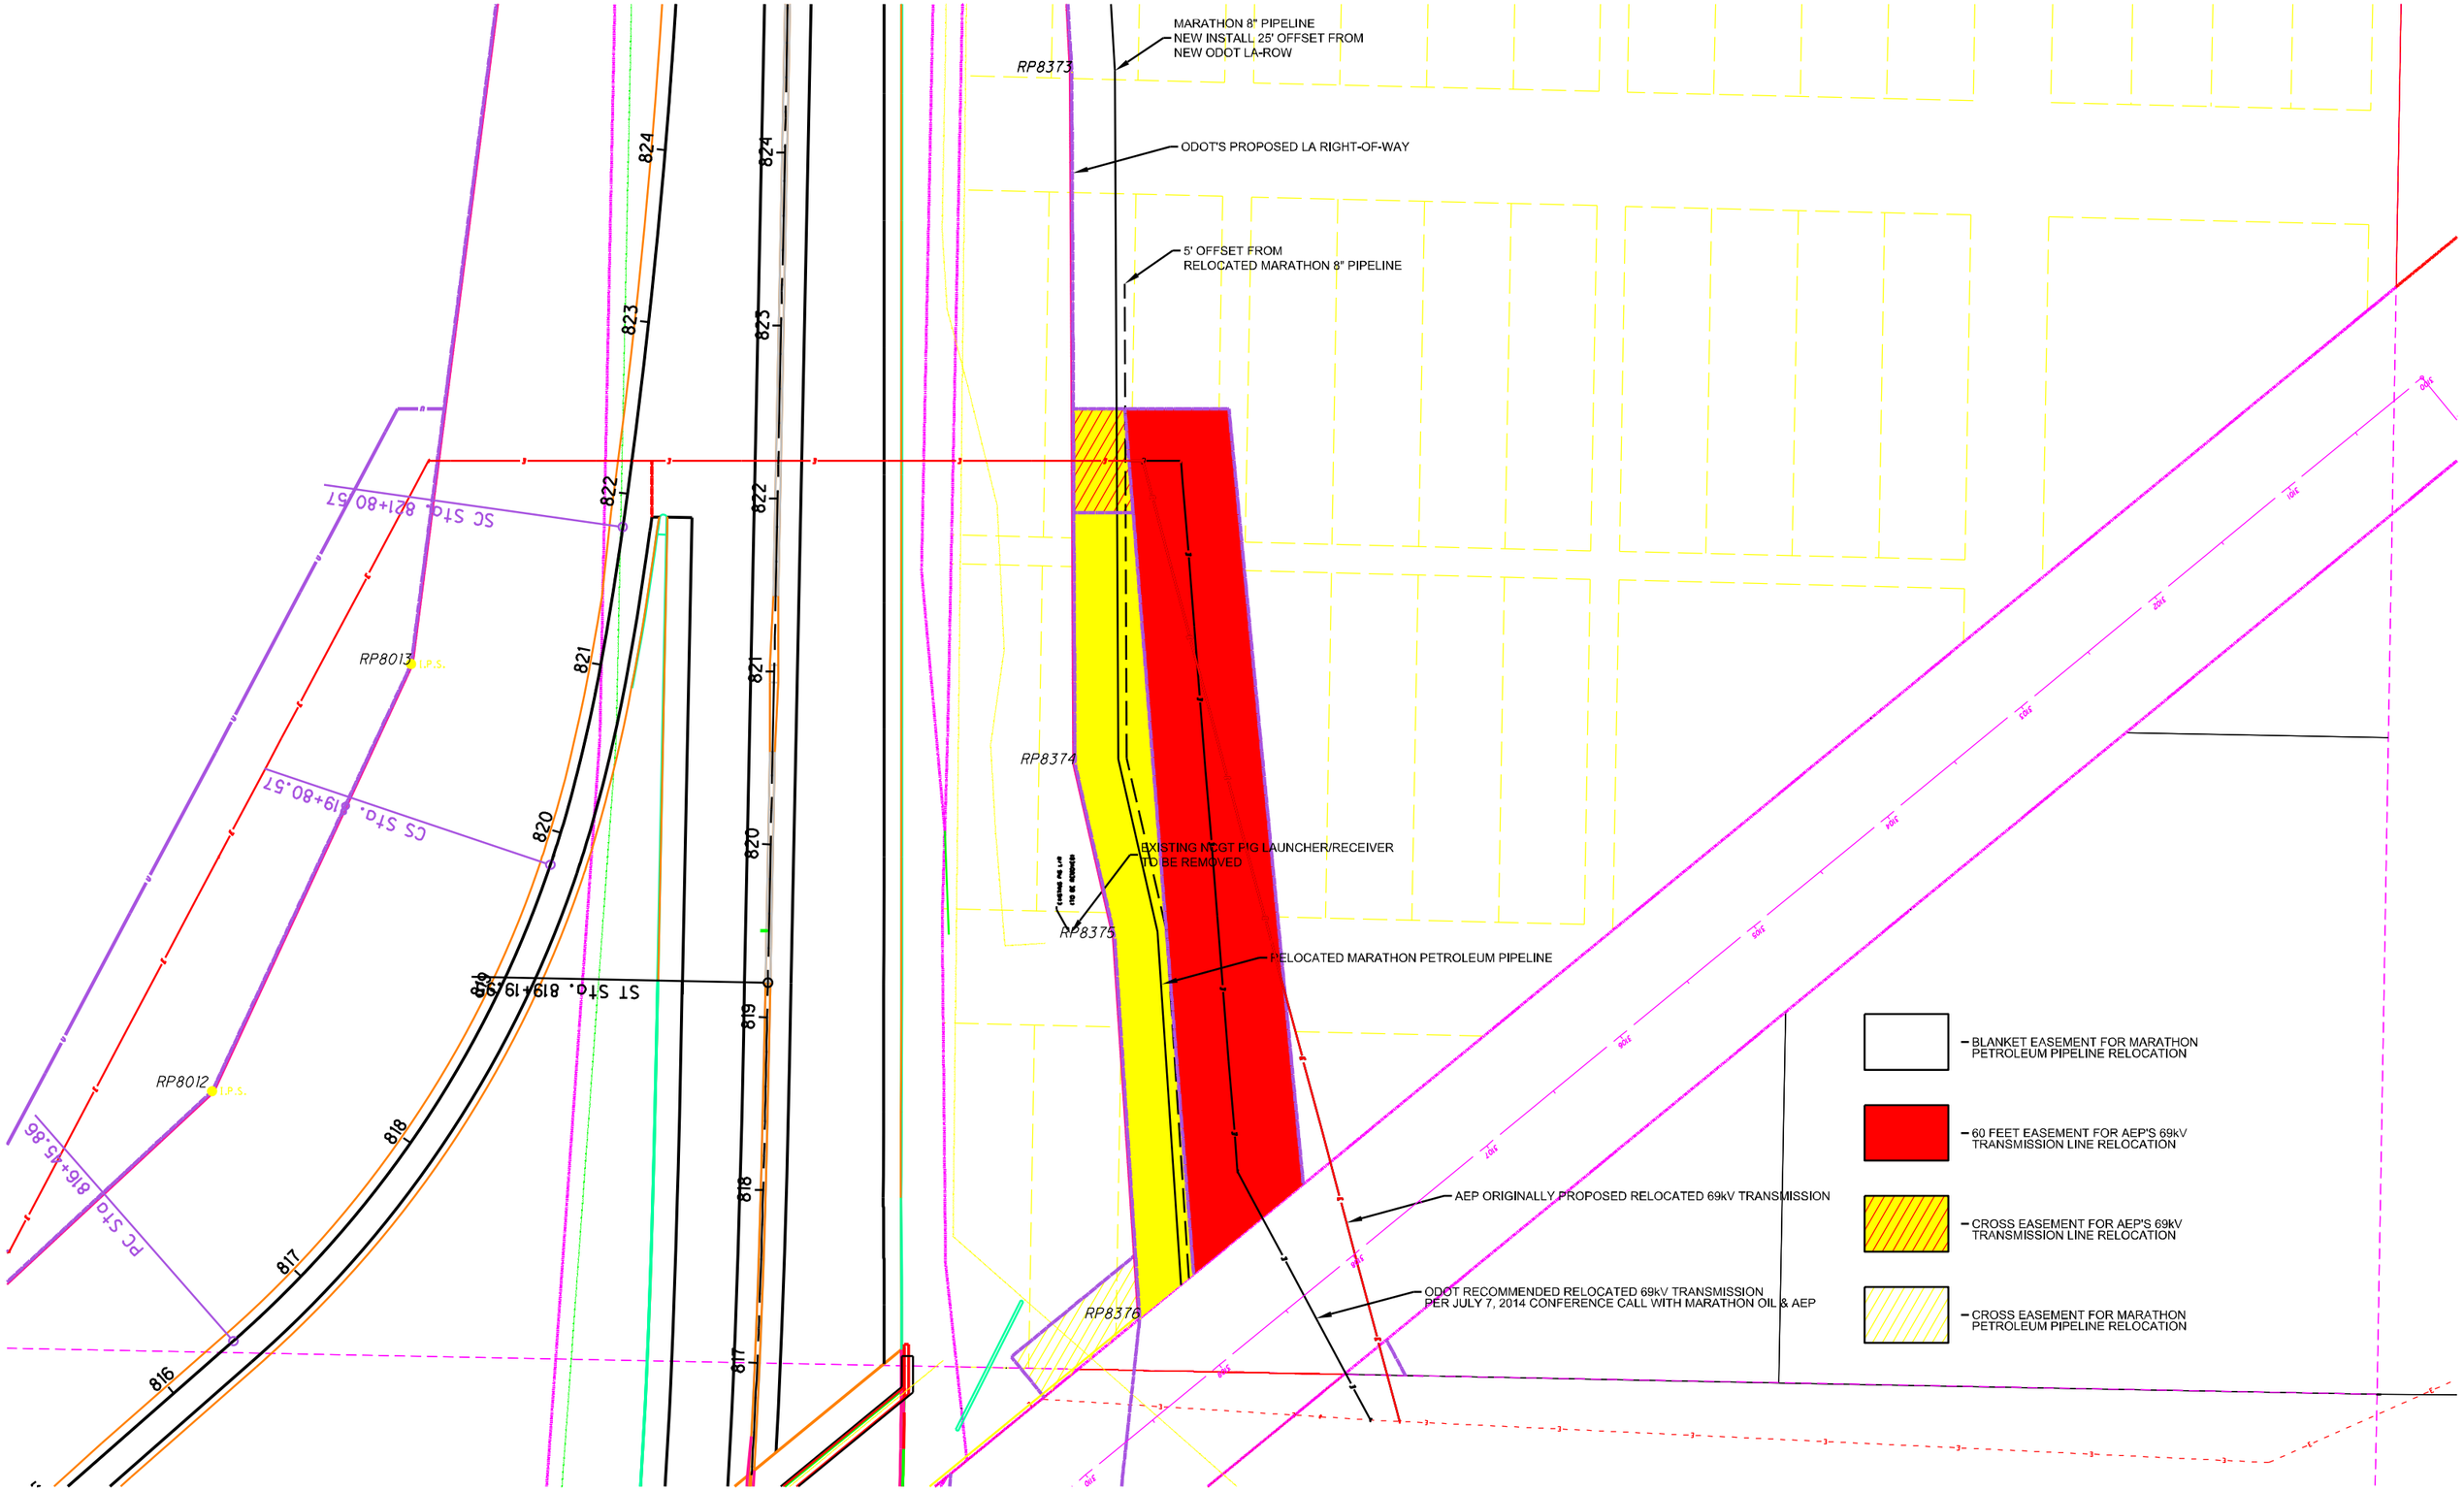
MARATHON 8" PIPELINE
NEW INSTALL 25' OFFSET FROM
NEW ODOT LA-ROW
ODOT'S PROPOSED LA RIGHT-OF-WAY
5' OFFSET FROM
RELOCATED MARATHON 8" PIPELINE
EXISTING NCGT PIG LAUNCHER/RECEIVER
TO BE REMOVED
RELOCATED MARATHON PETROLEUM PIPELINE
AEP ORIGINALLY PROPOSED RELOCATED 69kV TRANSMISSION
ODOT RECOMMENDED RELOCATED 69kV TRANSMISSION
PER JULY 7, 2014 CONFERENCE CALL WITH MARATHON OIL & AEP
RP8373
RP8374
RP8375
RP8376
RP8013
RP8012
SC Sta. 821+80.57
CS Sta. 819+80.57
ST Sta. 819+19.98
PC Sta. 816+45.86
824
823
822
821
820
819
818
817
816
BLANKET EASEMENT FOR MARATHON
PETROLEUM PIPELINE RELOCATION
60 FEET EASEMENT FOR AEP'S 69kV
TRANSMISSION LINE RELOCATION
CROSS EASEMENT FOR AEP'S 69kV
TRANSMISSION LINE RELOCATION
CROSS EASEMENT FOR MARATHON
PETROLEUM PIPELINE RELOCATION