


I:\Project\1100\110005\Roadway\110005\110005\S000.dwg 20-SEP-20 3:04:44 PM rnsd

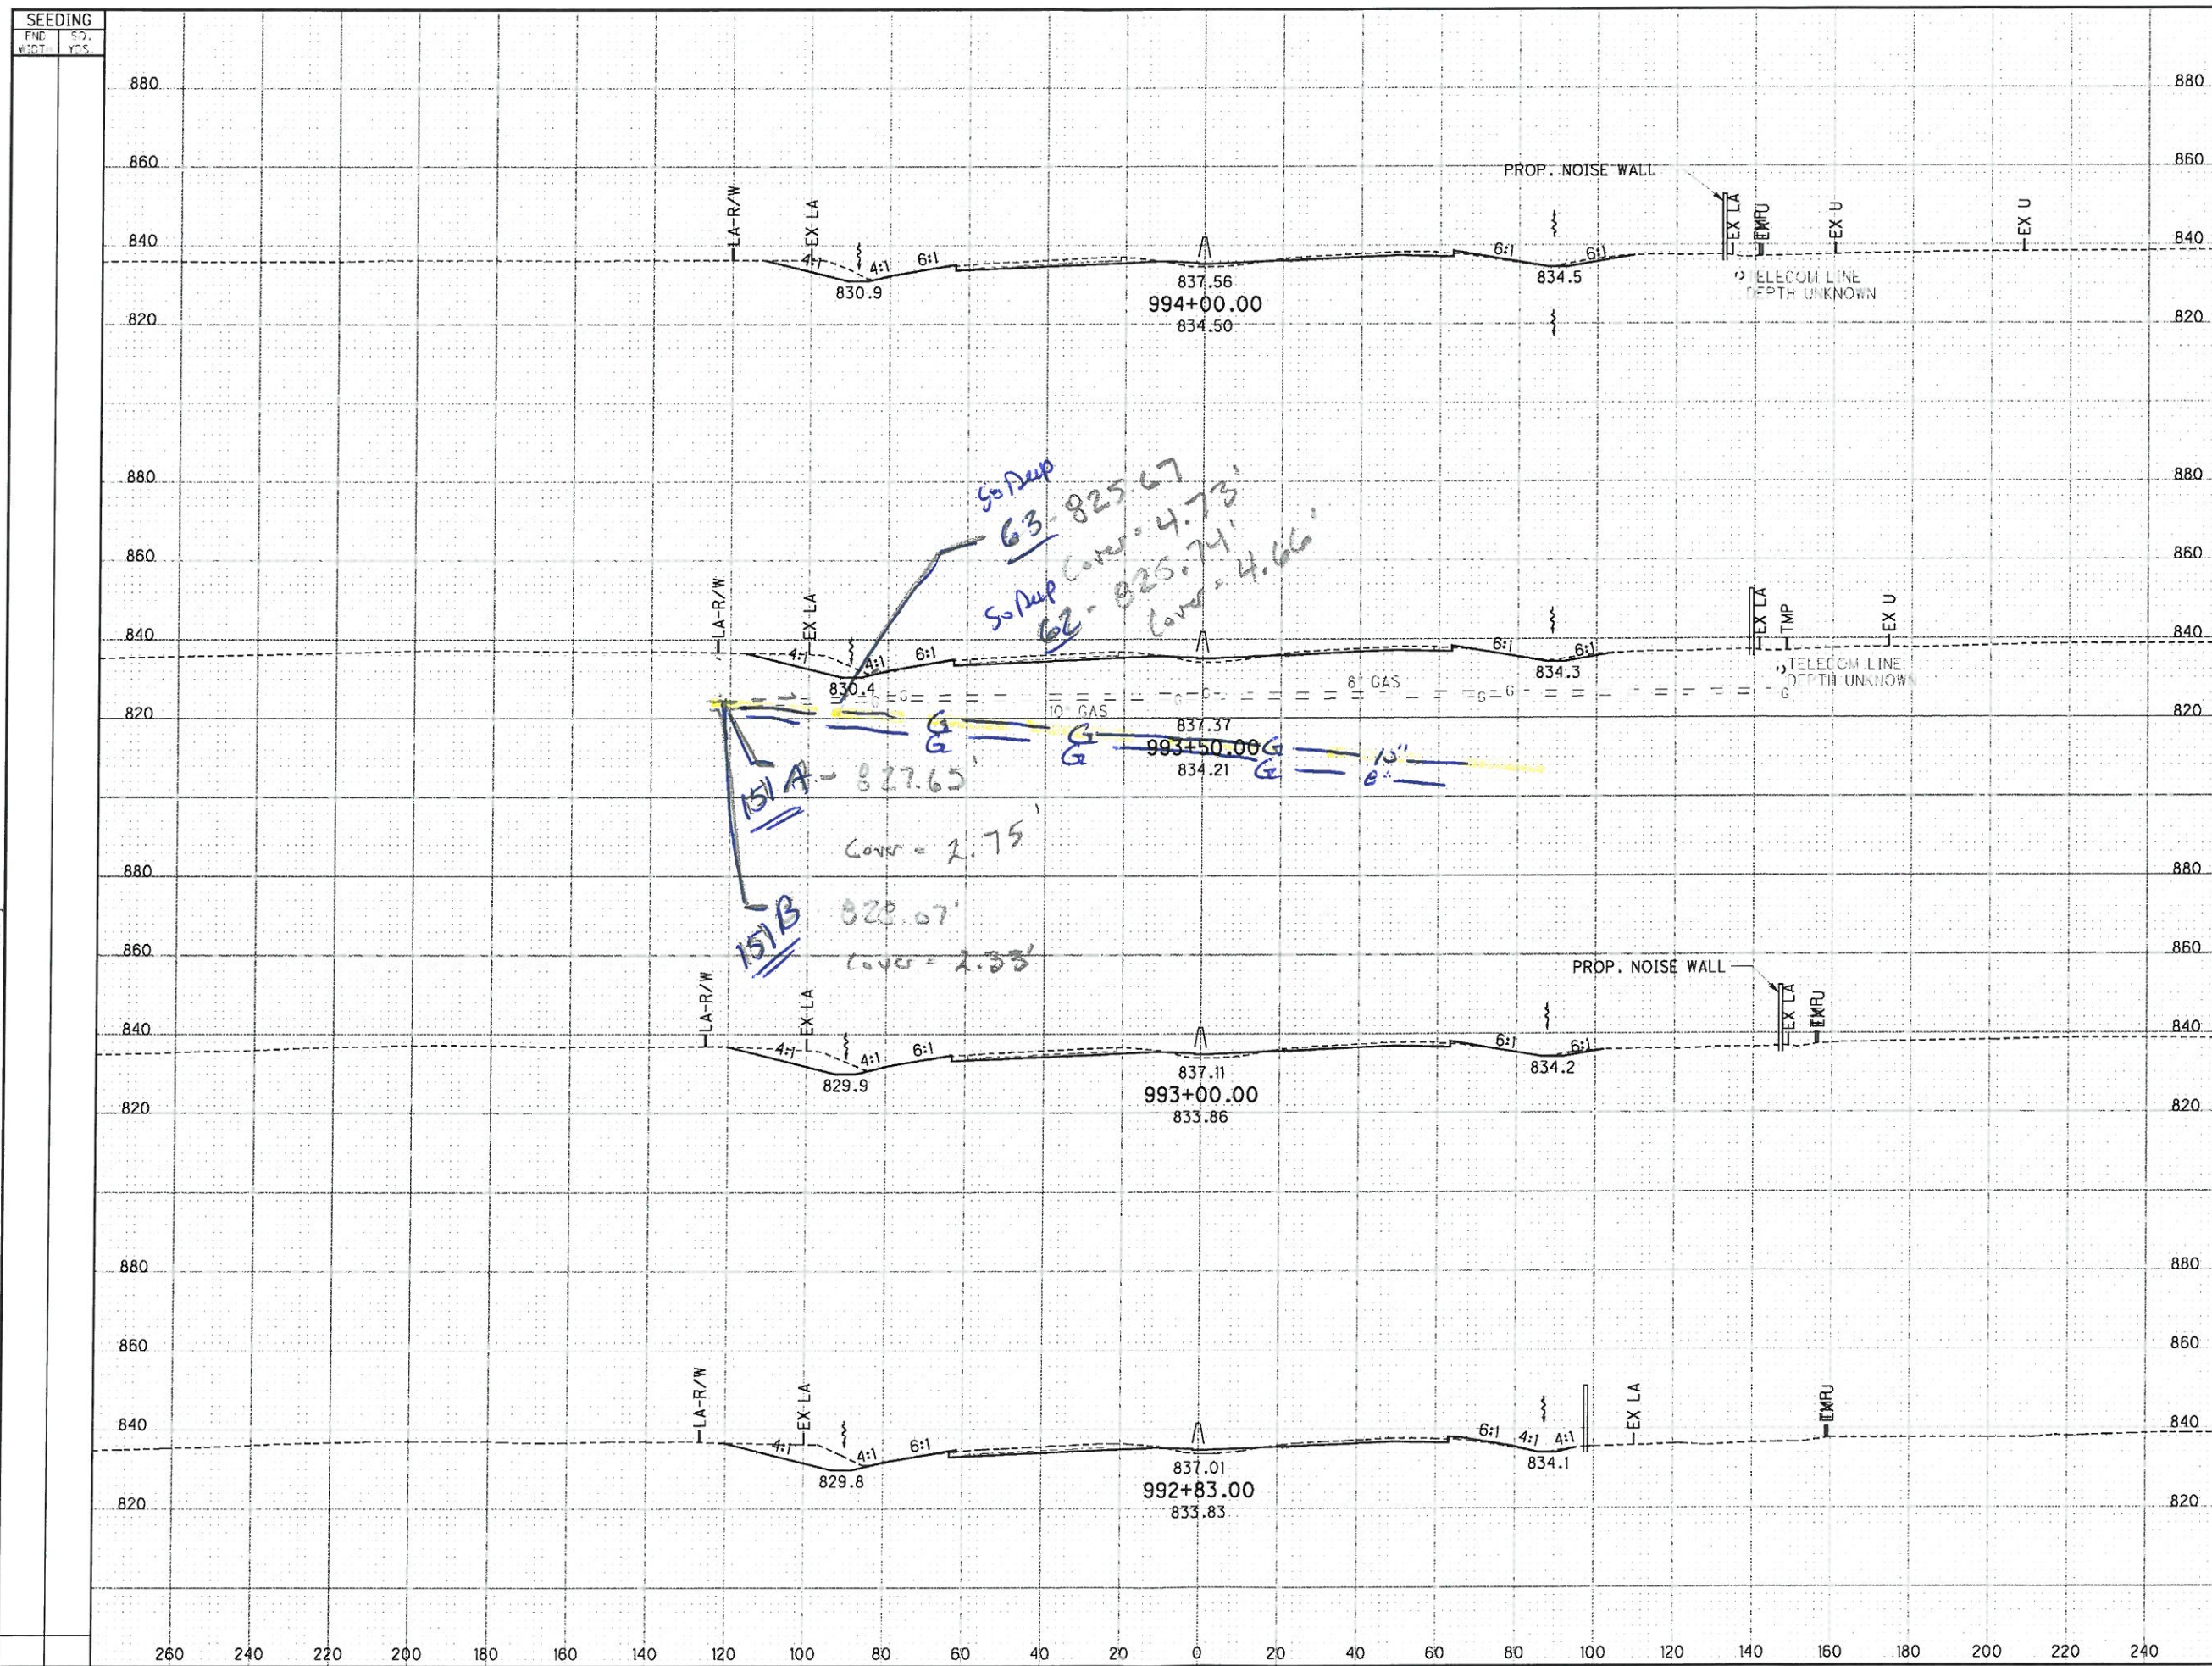

SEEDING		END AREA		VOLUME		CALCULATED	
FIN.	SO.	CUT	FILL	CUT	FILL	ABS.	CHECKED
WGT.	YDS.					NAH	

CROSS SECTIONS - I-75
STA. 992+83.00 TO STA. 994+00.00

HAN-75-14.39

262
842