



21'-6"
 -10'-0"
 -10'-0"
 1'-0"
 0'-0"
 6'-0"
 6'-0"
 6'-0"
 6'-0"
 6'-0"
 74'-00"

(4x19)=76'

H:\2018\80743\ODOT\ProjectData\08665_LAK_20_WEST\Design\MOT\Sheets\MHO01.dgn Sheet 3/11/2022 3:43:50 PM troyer

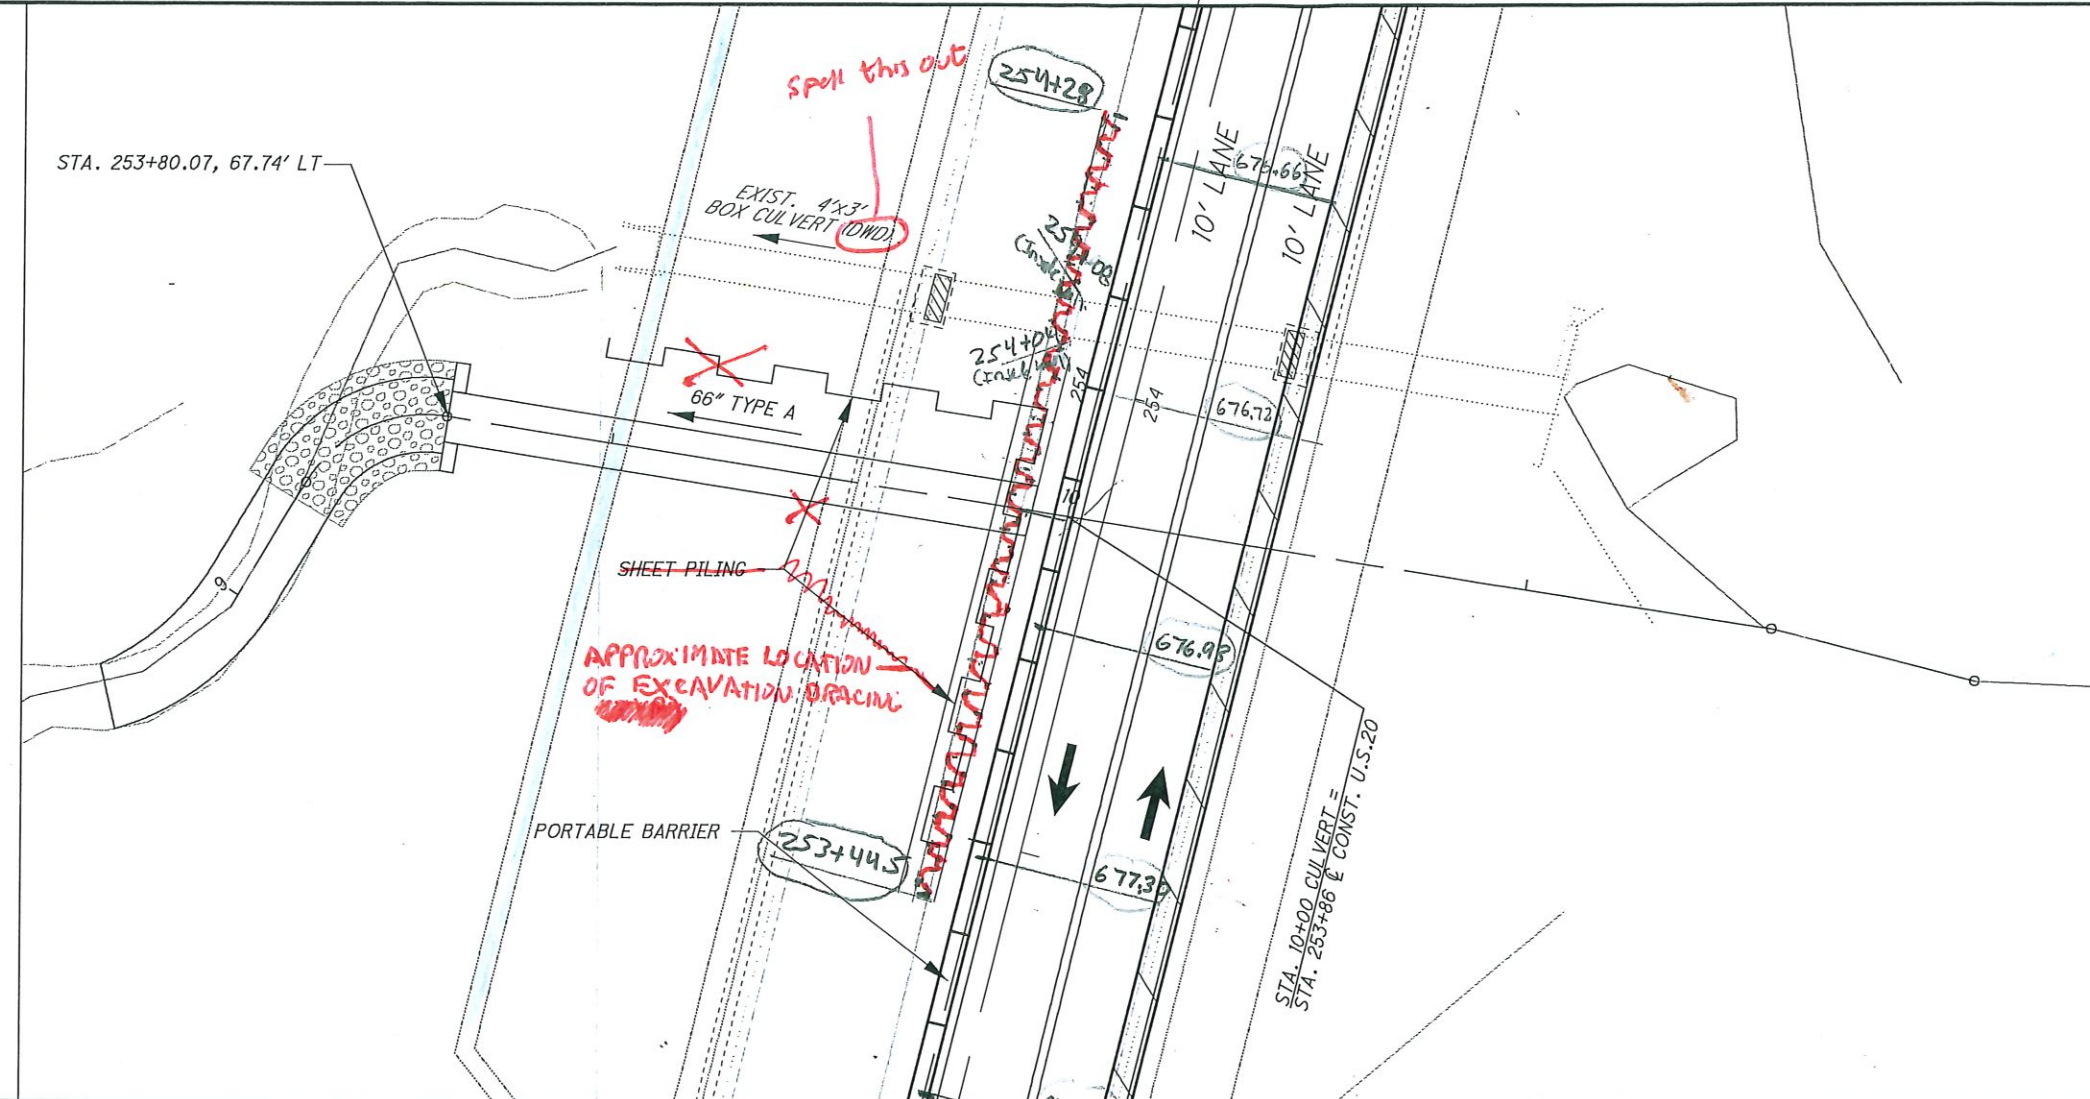

- NOTES**
- AFTER INSTALLATION OF SHEET PILING AND EXCAVATION, CUT HOLE IN SHEET PILING FOR CULVERT. PUSH CULVERT SECTION THROUGH HOLE.

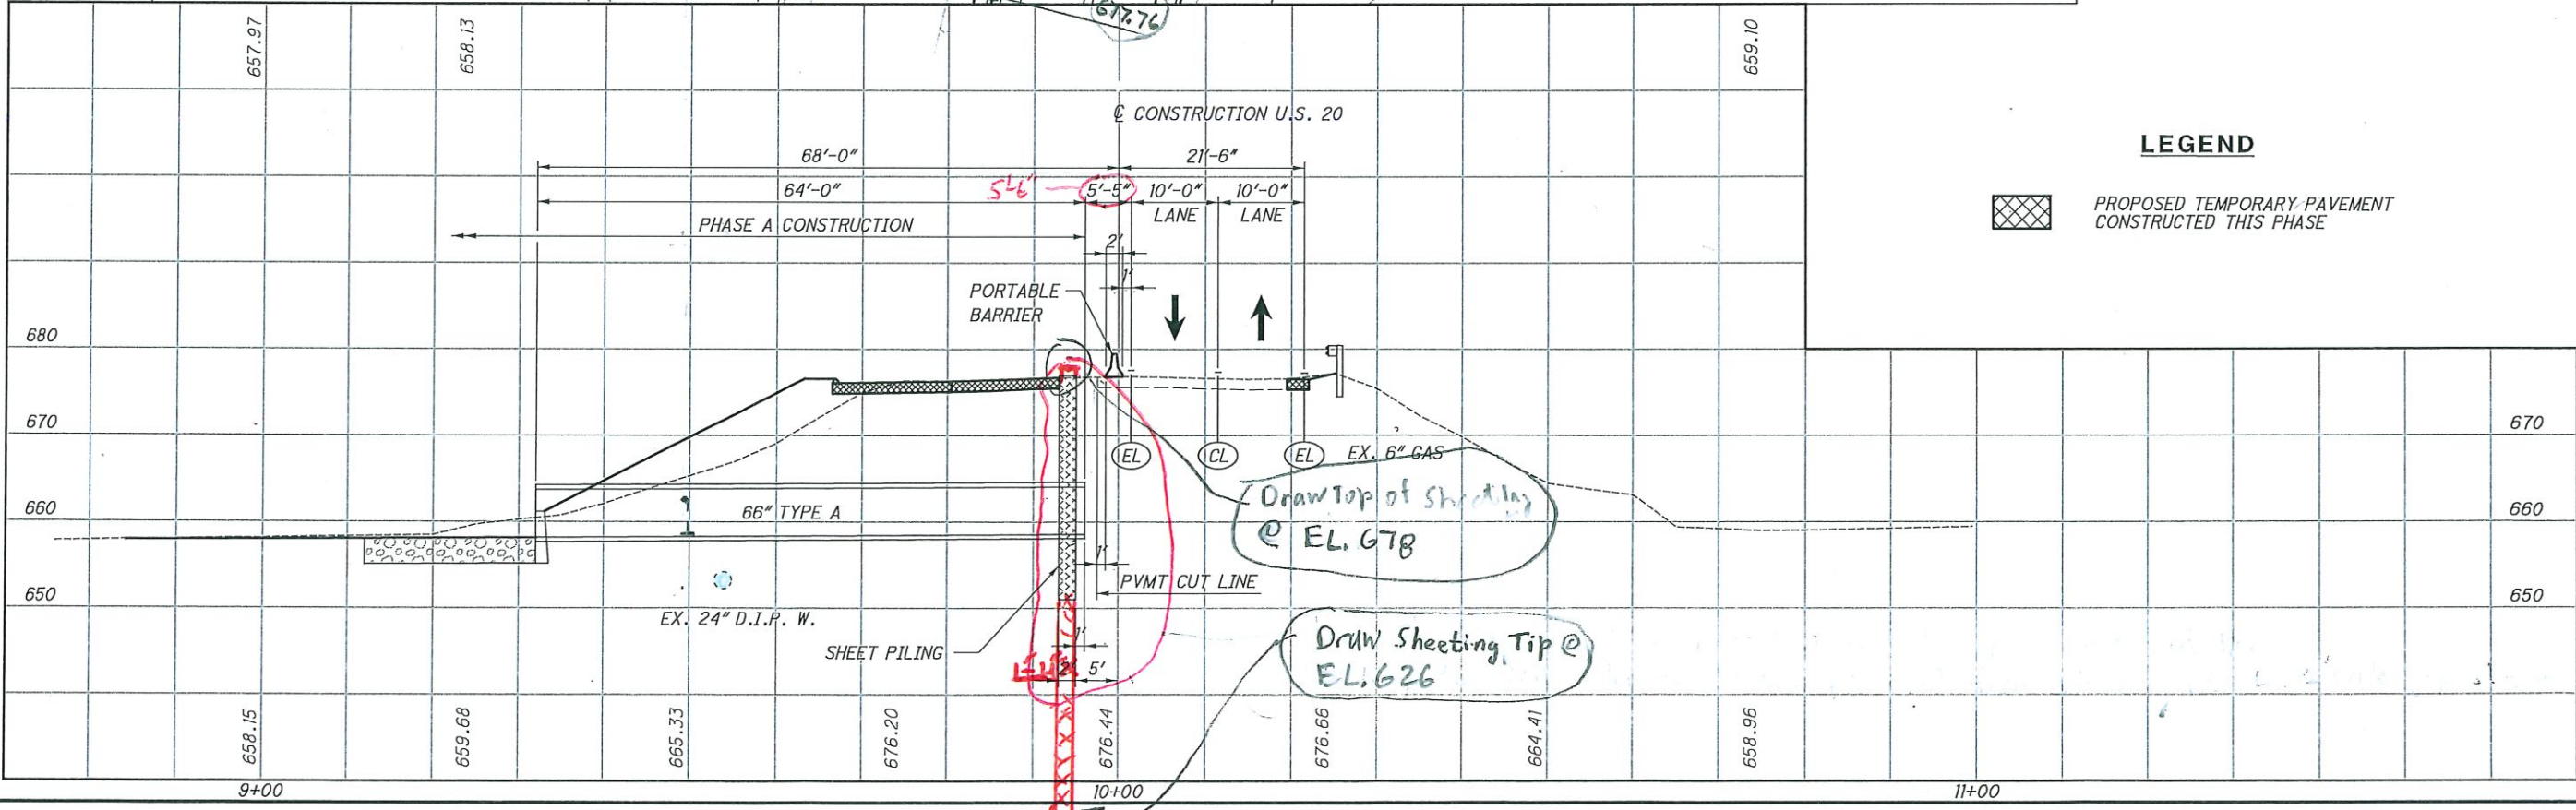

LEGEND

PROPOSED TEMPORARY PAVEMENT CONSTRUCTED THIS PHASE

MAINTENANCE OF TRAFFIC PRE-PHASE 1A
 CULVERT DETAIL STA. 253+86

LAK-US-20-19.59

PZ40
 $w = 19.7' = 1.64'$
 $\frac{677.4}{-658.0} = 19.4'$
 $\frac{676.7}{-658.0} = 18.7'$
 $\frac{19.4}{\times 2} = 38.8'$
 $\frac{18.7}{\times 2} = 37.4'$
 $38.8' + 5' + 5' + 37.4' = 86.2'$
 $\frac{86.2'}{1.64'} = 52.6$ sheets
 53 sheets




Project _____
 Project No. _____ Sheet No. _____ of _____
 Calculated By _____ Date _____
 Checked By _____ Date _____
 Subject _____



Project LAK-20-19.59
 Project No. 180743 Sheet No. 1 of 1
 Calculated By JPR Date 7/11/22
 Checked By _____ Date _____
 Subject Excavation Bracing W/M @ STA 253+86, LT.

(SEE BASIC FOR P/M SHEETS LAY-OUT)

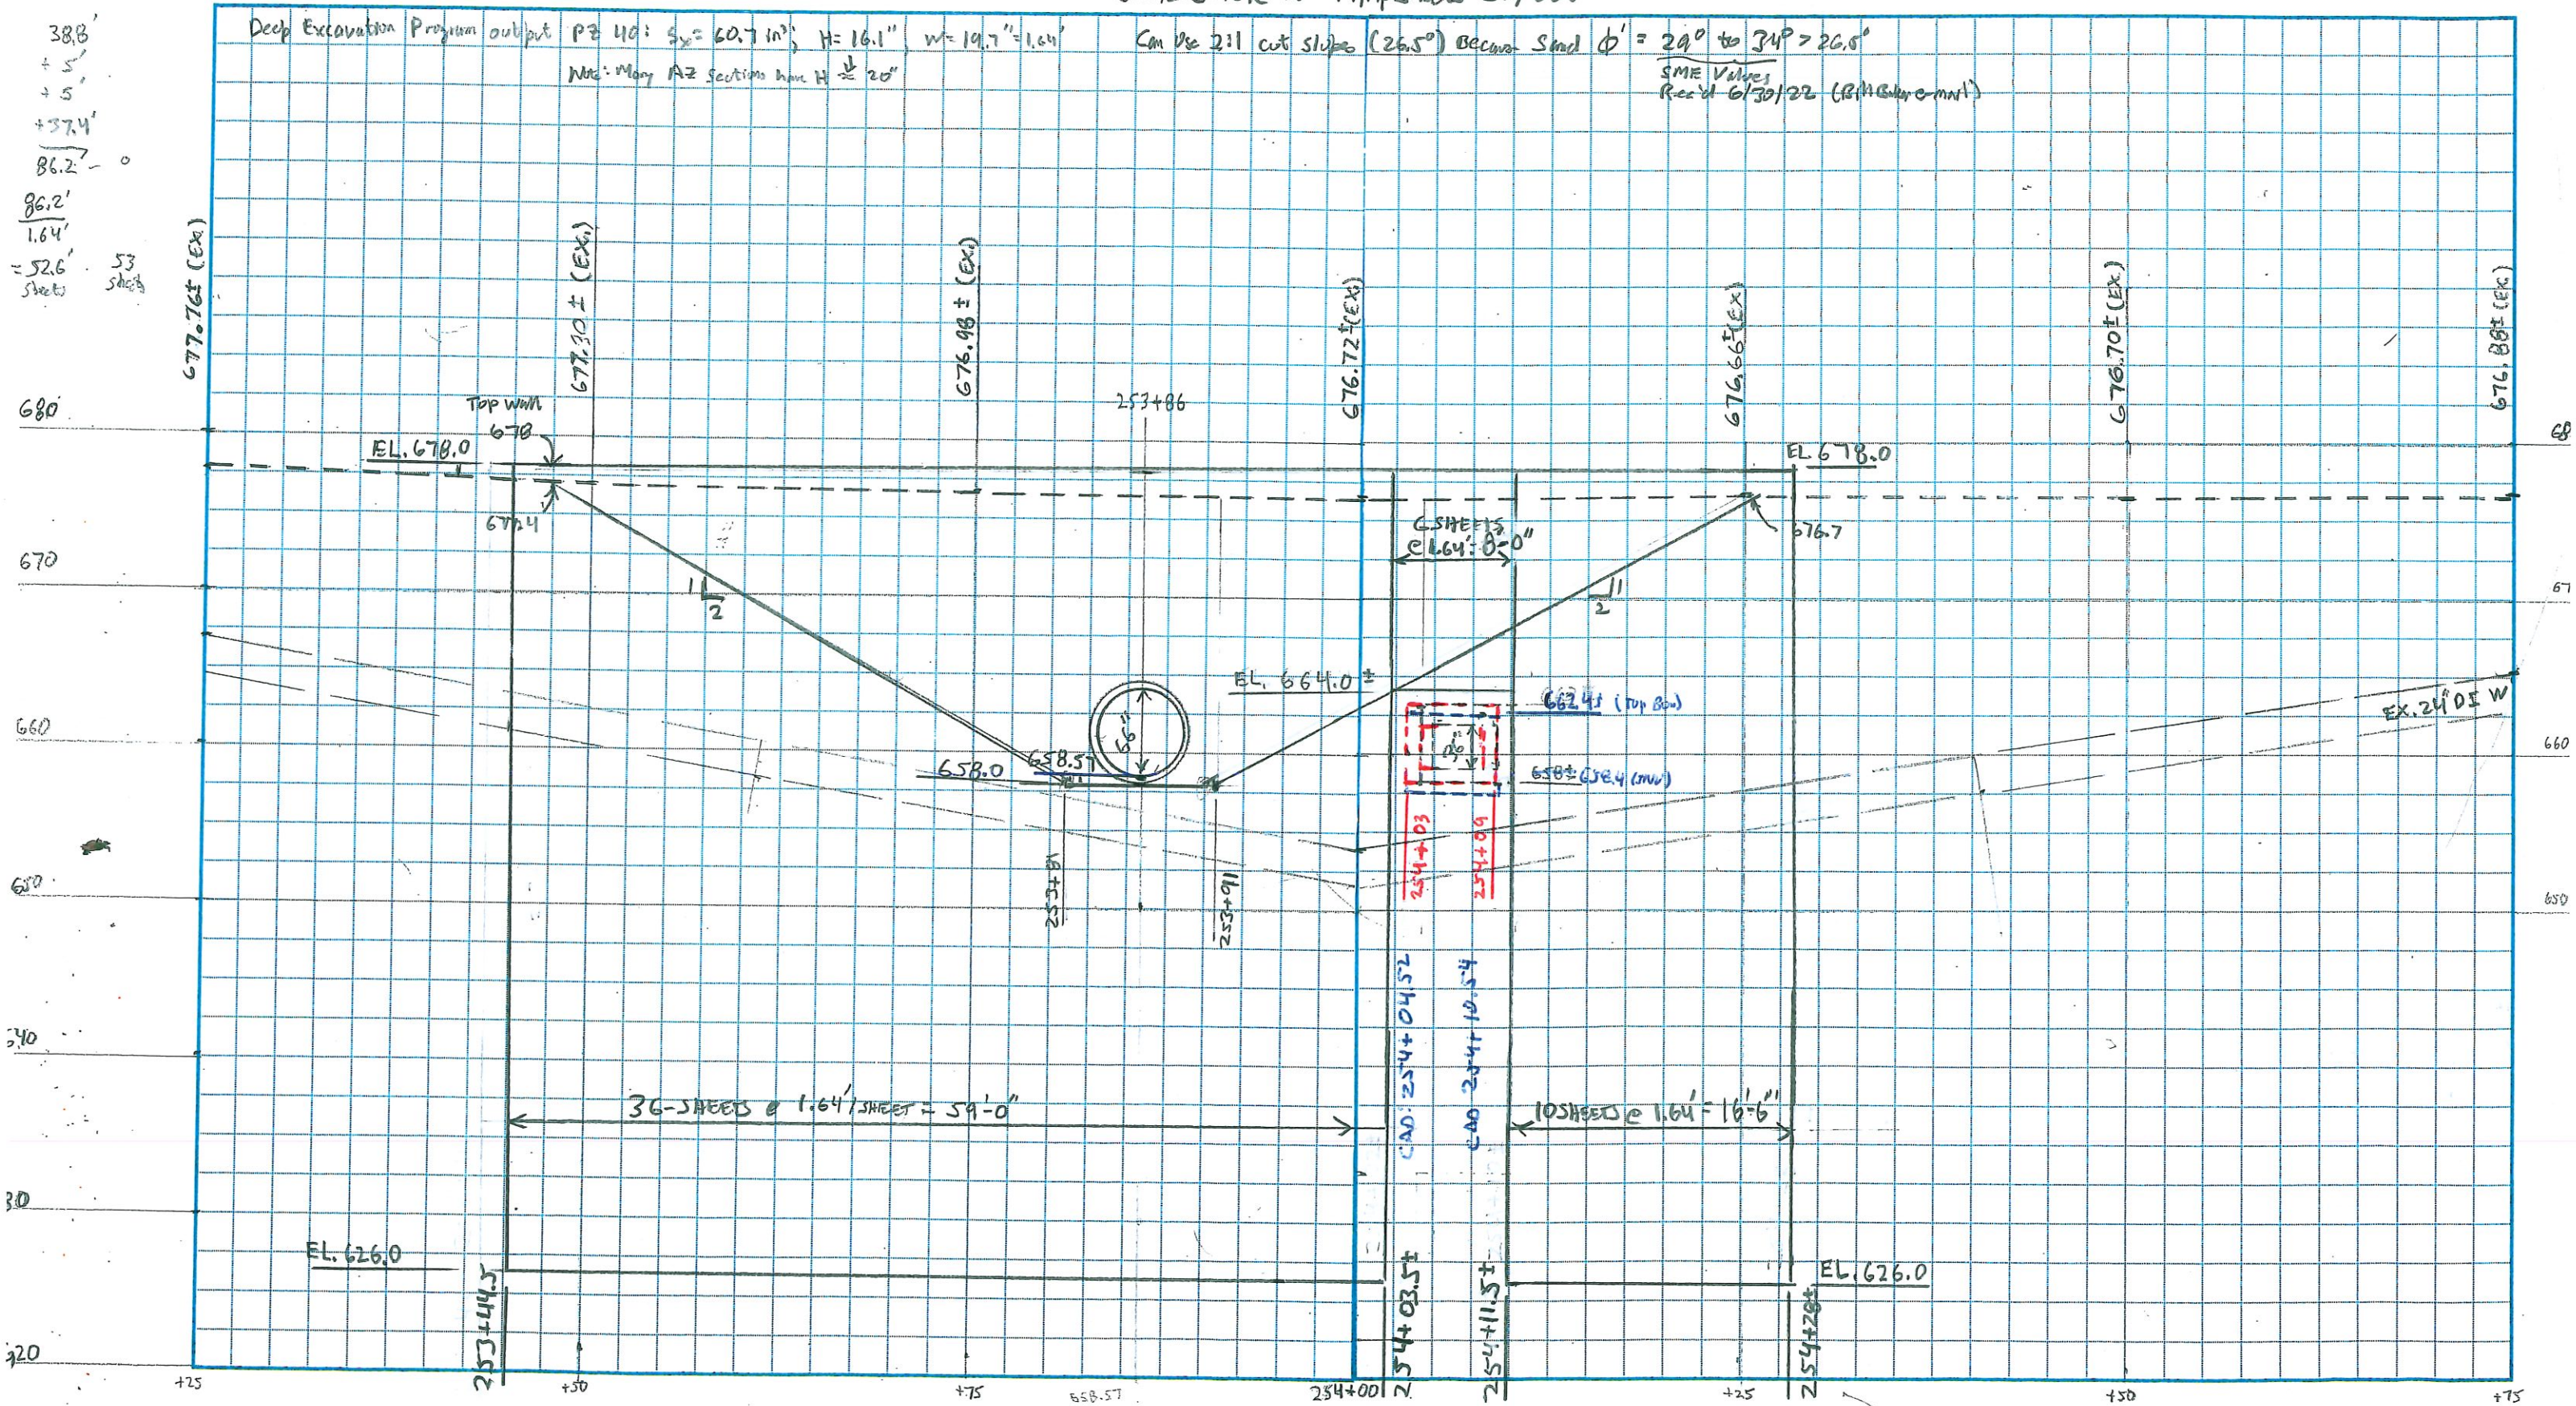

CULVERT @ STA. 253+86

5



www.ctconsultants.com

Project LAK-20-19.59
 Project No. 180743 Sheet No. 1 of 1
 Calculated By JPR Date 6/24/22
 Checked By _____ Date _____

Subject Soil Parameters Needed for Sheet Piling Design @ Culvert, STA. 253+86

PERRY TOWNSHIP TEST BORING B-016-1-19	PROJECT LAK-US-20-19.59 STA. 253+42, 16' LT	UNIT WEIGHTS				STRENGTH PARAMETERS				AT REST coefficient
		Saturated γ_s (pcf)	Total γ_t (pcf)	Effective γ_e (pcf)	Unconfined compressive c_u (pcf)	ϕ' (degree)	K_a	K_p	undrained shear strength S_u (pcf)	
SAND	14'-19'	122	120	66	0	30	0.33	3.0	0	0.5
SAND	19'-22'	125	120	62	0	30	0.33	3.0	0	0.5
SANDY SILT	22'-38'	134	134	72	2500*	32	0.31	3.25	2500	0.47
SANDY SILT (Below water table)	38'-40'	136	136	74	4000*	32	0.31	3.25	4000	0.47
SOILS ARE SATURATED BELOW 12' ELEV. 665										
PERRY TOWNSHIP TEST BORING B-016-2-19	PROJECT LAK-US-20-19.59 STA. 254+45, 16' FT	UNIT WEIGHTS				STRENGTH PARAMETERS				AT REST coefficient
Soil Description	Depth (Feet)	Saturated γ_s (pcf)	Total γ_t (pcf)	Effective γ_e (pcf)	Unconfined compressive c_u (pcf)	ϕ' (degree)	K_a	K_p	undrained shear strength S_u (pcf)	
SAND	1'-15.5'	128	120	65	0	32	0.31	3.25	0	0.47
SAND	15.5'-20.5'	118	118	56	0	29	0.35	2.88	0	0.52
SAND	20.5'-26'	124	124	61	0	34	0.28	3.54	0	0.44
SILT & CLAY	26'-32'	134	134	72	2500	32*	0.31	3.25	2500	0.47
SANDY SILT (Below water table)	32'-40'	136	136	74	3000*	32*	0.31	3.25	3000	0.47


SOILS ARE SATURATED BELOW 12 FT, ELEV 664.

7

Prop 66" Pipe Culvert @ STA. 253+86 → Boring B-016-1-19 is 14' West of Culvert Cut to 657.88±

PROJECT: LAK-20-19.59		DRILLING FIRM / OPERATOR: SME / JH/RM		DRILL RIG: 293-CME55-TRK		STATION / OFFSET: 253+42.16' LT.		EXPLORATION ID									
TYPE: RETAINING WALL		SAMPLING FIRM / LOGGER: SME / JF		HAMMER: AUTOMATIC HAMMER		ALIGNMENT: U.S. 20		B-016-1-19									
PID: 108665 SFN:		DRILLING METHOD: 3.75" HSA		CALIBRATION DATE: 7/30/20		ELEVATION: 677.1 (MSL) EOB: 40.0 ft.		PAGE									
START: 7/13/20 END: 7/13/20		SAMPLING METHOD: SPT		ENERGY RATIO (%): 82.5		LAT / LONG: 41.777329, -81.155701		1 OF 2									
MATERIAL DESCRIPTION AND NOTES		ELEV.		SPT / RQD		REC SAMPLE		GRADATION (%)		ATTERBERG		ODOT CLASS (GI)		ABANDONED			
		677.1		DEPTHS		ID		GR		LL		WC					
4" ASPHALT AND 6" CONCRETE (DRILLER'S DESCRIPTION)		676.3	1	9													
DENSE, BROWN, FINE SAND, TRACE SILT, TRACE CLAY, TRACE GRAVEL, DAMP		674.1	2	14		SS-1									A-3 (V)		
LOOSE TO MEDIUM DENSE, BROWN, COARSE AND FINE SAND, LITTLE GRAVEL, LITTLE SILT, TRACE CLAY			3	11													
LOOSE, BROWN, FINE SAND, TRACE SILT, TRACE CLAY		670.1	4	6		SS-2		18	16	49	12	5	NP	NP	7	A-3a (0)	
LOOSE, BROWN, FINE SAND, TRACE SILT, TRACE CLAY			5	5													
LOOSE, BROWN, FINE SAND, TRACE SILT, TRACE CLAY		666.6	6	2		SS-3A									11	A-3a (V)	
LOOSE, BROWN, FINE SAND, TRACE SILT, TRACE CLAY			7	2		SS-3B										A-3 (V)	
VERY LOOSE, BROWN, COARSE AND FINE SAND, LITTLE SILT, TRACE CLAY, TRACE GRAVEL, MOIST TO WET			8														
LOOSE TO MEDIUM DENSE, BROWN AND GRAY, COARSE AND FINE SAND, LITTLE SILT, TRACE CLAY, TRACE GRAVEL, TRACE ORGANICS, DAMP		660.6	9	2		SS-4									9	A-3 (V)	
LOOSE, GRAY, FINE SAND, SOME SILT, TRACE CLAY, TRACE GRAVEL, WET		658.1	10	2													
VERY STIFF TO HARD, GRAY, SANDY SILT, AND TO SOME CLAY, TRACE GRAVEL, DAMP			11	1		SS-5		0	11	73	12	4	NP	NP	23	A-3a (0)	
VERY STIFF TO HARD, GRAY, SANDY SILT, AND TO SOME CLAY, TRACE GRAVEL, DAMP			12	1													
VERY STIFF TO HARD, GRAY, SANDY SILT, AND TO SOME CLAY, TRACE GRAVEL, DAMP			13														
VERY STIFF TO HARD, GRAY, SANDY SILT, AND TO SOME CLAY, TRACE GRAVEL, DAMP			14	0		SS-6									21	A-3a (V)	
VERY STIFF TO HARD, GRAY, SANDY SILT, AND TO SOME CLAY, TRACE GRAVEL, DAMP			15	0													
VERY STIFF TO HARD, GRAY, SANDY SILT, AND TO SOME CLAY, TRACE GRAVEL, DAMP			16	1		SS-7A									21	A-3a (V)	
VERY STIFF TO HARD, GRAY, SANDY SILT, AND TO SOME CLAY, TRACE GRAVEL, DAMP			17	4		SS-7B										A-3a (V)	
VERY STIFF TO HARD, GRAY, SANDY SILT, AND TO SOME CLAY, TRACE GRAVEL, DAMP			18	7													
VERY STIFF TO HARD, GRAY, SANDY SILT, AND TO SOME CLAY, TRACE GRAVEL, DAMP			19	2		SS-8A									32	A-3a (V)	
VERY STIFF TO HARD, GRAY, SANDY SILT, AND TO SOME CLAY, TRACE GRAVEL, DAMP			20	2		SS-8B										A-3 (V)	
VERY STIFF TO HARD, GRAY, SANDY SILT, AND TO SOME CLAY, TRACE GRAVEL, DAMP			21	4		SS-9A											
VERY STIFF TO HARD, GRAY, SANDY SILT, AND TO SOME CLAY, TRACE GRAVEL, DAMP			22	3		SS-9B	3.00								20	A-3 (V)	
VERY STIFF TO HARD, GRAY, SANDY SILT, AND TO SOME CLAY, TRACE GRAVEL, DAMP			23	3												A-4a (V)	
VERY STIFF TO HARD, GRAY, SANDY SILT, AND TO SOME CLAY, TRACE GRAVEL, DAMP			24	5		SS-10	4.50		2	3	6	46	43	27	19	8	A-4a (8)
VERY STIFF TO HARD, GRAY, SANDY SILT, AND TO SOME CLAY, TRACE GRAVEL, DAMP			25	6													
VERY STIFF TO HARD, GRAY, SANDY SILT, AND TO SOME CLAY, TRACE GRAVEL, DAMP			26	9		SS-11A	4.50									13	A-4a (V)
VERY STIFF TO HARD, GRAY, SANDY SILT, AND TO SOME CLAY, TRACE GRAVEL, DAMP			27	7		SS-11B	4.50										A-4a (V)
VERY STIFF TO HARD, GRAY, SANDY SILT, AND TO SOME CLAY, TRACE GRAVEL, DAMP			28	8													
VERY STIFF TO HARD, GRAY, SANDY SILT, AND TO SOME CLAY, TRACE GRAVEL, DAMP			29	4		SS-12	4.50									14	A-4a (V)
VERY STIFF TO HARD, GRAY, SANDY SILT, AND TO SOME CLAY, TRACE GRAVEL, DAMP			30	7													
VERY STIFF TO HARD, GRAY, SANDY SILT, AND TO SOME CLAY, TRACE GRAVEL, DAMP			31	4		SS-13	4.50									13	A-4a (V)
VERY STIFF TO HARD, GRAY, SANDY SILT, AND TO SOME CLAY, TRACE GRAVEL, DAMP			32	7													
VERY STIFF TO HARD, GRAY, SANDY SILT, AND TO SOME CLAY, TRACE GRAVEL, DAMP			33	10													
VERY STIFF TO HARD, GRAY, SANDY SILT, AND TO SOME CLAY, TRACE GRAVEL, DAMP			34	9		SS-14	4.50		8	14	43	27	24	17	7	14	A-4a (7)
VERY STIFF TO HARD, GRAY, SANDY SILT, AND TO SOME CLAY, TRACE GRAVEL, DAMP			35	10													
VERY STIFF TO HARD, GRAY, SANDY SILT, AND TO SOME CLAY, TRACE GRAVEL, DAMP			36	14		SS-15	4.50									12	A-4a (V)
VERY STIFF TO HARD, GRAY, SANDY SILT, AND TO SOME CLAY, TRACE GRAVEL, DAMP			37	11													
VERY STIFF TO HARD, GRAY, SANDY SILT, AND TO SOME CLAY, TRACE GRAVEL, DAMP			38	12		SS-16	4.50									12	A-4a (V)
VERY STIFF TO HARD, GRAY, SANDY SILT, AND TO SOME CLAY, TRACE GRAVEL, DAMP			39	9													
VERY STIFF TO HARD, GRAY, SANDY SILT, AND TO SOME CLAY, TRACE GRAVEL, DAMP			40	10												12	A-4a (V)

NOTES: NONE
ABANDONMENT METHODS, MATERIALS, QUANTITIES: AUGER CUTTINGS: BENTONITE CHIPS; SAND

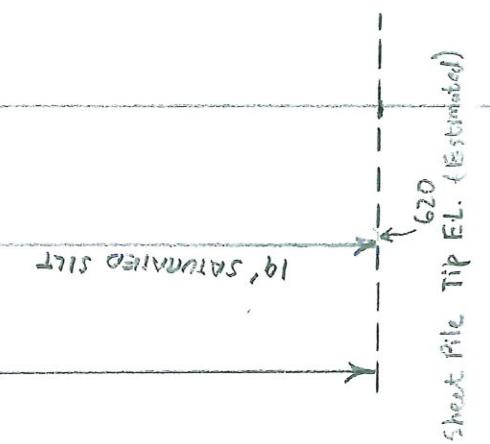


676.4
657.88
18.12

8

Prop 16" Pipe Culvert @ Sta. 253+86 → Boring B-016-2-19 is 59' East of Culvert Cut to 57.88±

PROJECT: LAK-20-19.59 TYPE: RETAINING WALL		DRILLING FIRM / OPERATOR: SME / JH/RM		DRILL RIG: 293-CME55-TRK		STATION / OFFSET: 254+45.16' RT.		EXPLORATION ID: B-016-2-19			
PID: 108665 SFN: 7/13/20		SAMPLING FIRM / LOGGER: 3.75" HSA		HAMMER: AUTOMATIC HAMMER		ALIGNMENT: U.S. 20		PAGE: 1 OF 2			
START: 7/13/20 END: 7/13/20		DRILLING METHOD: SPT		CALIBRATION DATE: 7/30/20		ELEVATION: 676.4 (MSL) EOB: 40.0 ft.					
SAMPLING METHOD:		SPT		ENERGY RATIO (%): 82.5		LAT / LONG: 41.777363, -81.155309					
MATERIAL DESCRIPTION AND NOTES		ELEV.		REC SAMPLE ID		GRADATION (%)		ODOT CLASS (gt)			
4" ASPHALT AND 6" CONCRETE (DRILLER'S DESCRIPTION)		676.4		SS-1		GR CS FS SI CL LL PL PI WC		A-3a (V)			
LOOSE TO MEDIUM DENSE, BROWN, COARSE AND FINE SAND, LITTLE SILT, TRACE CLAY, TRACE GRAVEL, DAMP		675.6		SS-2		7 18 54 16 5		A-3a (V)			
19' (RETAIN SAND)		665.9		SS-3A				A-3a (V)			
				SS-3B				A-3a (V)			
				SS-4				A-3a (V)			
LOOSE TO MEDIUM DENSE, BROWN, COARSE AND FINE SAND, SOME SILT, TRACE CLAY, TRACE GRAVEL, MOIST TO WET		660.9		SS-5				A-3 (V)			
VERY LOOSE, BROWN, COARSE AND FINE SAND, AND SILT, TRACE CLAY, TRACE GRAVEL, WET		658.4		SS-6		0 0 72 23 5		A-3a (V)			
VERY LOOSE, GRAY, FINE SAND, TRACE SILT, TRACE CLAY, TRACE GRAVEL, WET		655.9		SS-7				A-3 (V)			
MEDIUM DENSE TO DENSE, GRAY, COARSE AND FINE SAND, LITTLE SILT, TRACE TO LITTLE GRAVEL, TRACE CLAY, WET		650.4		SS-8				A-3 (V)			
VERY STIFF, GRAY, SILT AND CLAY, TRACE SAND, TRACE GRAVEL, MOIST		645.9		SS-9				A-3 (V)			
HARD, GRAY, SANDY SILT, SOME CLAY, TRACE GRAVEL, DAMP		644.4		SS-10				A-3a (V)			
Estimated (by Rule-of-thumb) 38' ENCROACHMENT		636.4		SS-11				A-4a (V)			
				SS-12				A-4a (V)			
				SS-13				A-4a (V)			
				SS-14				A-4a (V)			
				SS-15				A-4a (V)			
				SS-16				A-4a (V)			
1	9	6	4	100	SS-1	-	-	-	-	5	A-3a (V)
2	2	2	2	100	SS-2	-	-	-	-	9	A-3a (V)
3	2	2	3	100	SS-3A	-	-	-	-	-	A-3a (V)
4	2	3	3	89	SS-4	-	-	-	-	11	A-3a (V)
5	10	6	4	56	SS-5	-	-	-	-	11	A-3 (V)
6	3	3	4	56	SS-6	-	0	72	23	5	A-3a (V)
7	2	1	2	67	SS-7	-	-	-	-	-	A-3 (V)

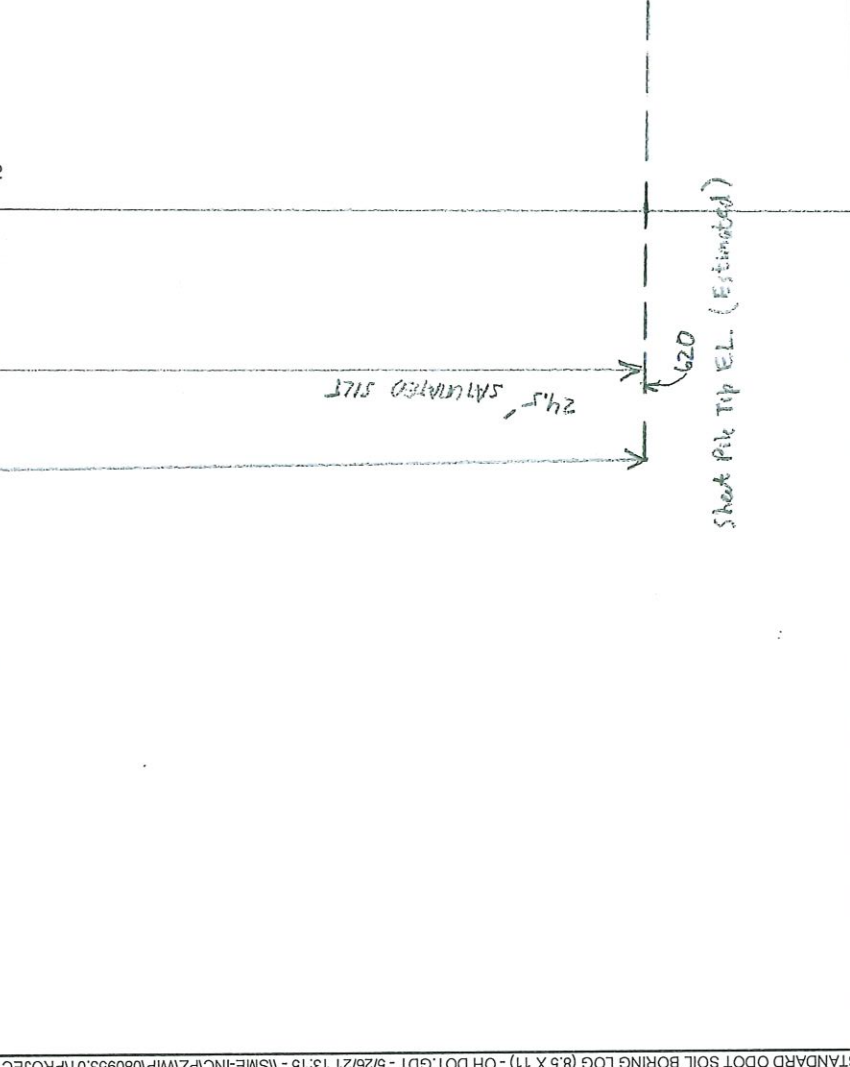

NOTES: NONE
ABANDONMENT METHODS, MATERIALS, QUANTITIES: AUGER CUTTINGS: BENTONITE CHIPS; SAND