


STATE OF OHIO
DEPARTMENT OF TRANSPORTATION

LAK-SR 006-02.60

CITY OF WILLOUGHBY HILLS LAKE COUNTY

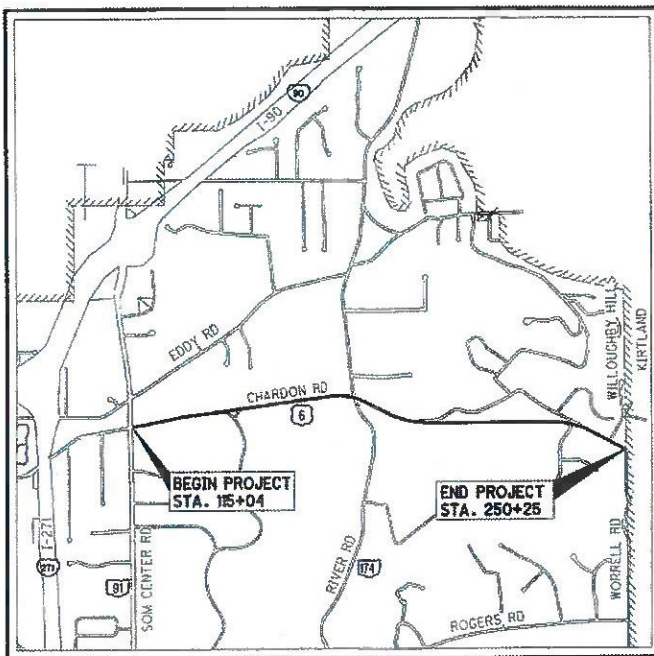

LOCATION MAP

LATITUDE: 41°35'19" LONGITUDE: 81°24'52"



PORTION TO BE IMPROVED	
INTERSTATE HIGHWAY	
FEDERAL ROUTES	
STATE ROUTES	
COUNTY & TOWNSHIP ROADS	
OTHER ROADS	

DESIGN DESIGNATION

CURRENT ADT (2021)	8,582
DESIGN YEAR ADT (2042)	8,582
DESIGN HOURLY VOLUME (2042)	UNKNOWN
DIRECTIONAL DISTRIBUTION	UNKNOWN
TRUCKS (24 HOUR B&C)	UNKNOWN
DESIGN SPEED	UNKNOWN
LEGAL SPEED	35-45 MPH
DESIGN FUNCTIONAL CLASSIFICATION	MINOR ARTERIAL
NHS PROJECT	FEDERAL AID PRIMARY ROUTE

DESIGN EXCEPTIONS

NONE

UNDERGROUND UTILITIES
Contact Two Working Days Before You Dig

OHIO811. 8-1-1. or 1-800-362-2764
(Non-members must be called directly)

PLANS PREPARED BY:
RICHARD L. BOWEN & ASSOC., INC.
2019 CENTER STREET, STE 500
CLEVELAND, OHIO 44113
216-491-9300

INDEX OF SHEETS:

TITLE SHEET	1
SCHEMATIC PLAN	2
TYPICAL SECTIONS	3 - 4
GENERAL NOTES	5 - 6
MAINTENANCE OF TRAFFIC	7 - 7A
GENERAL SUMMARY	10
SUBSUMMARIES	11 - 13
CALCULATIONS	14
PLANS	15 - 19
PAVEMENT MARKING PLANS	20 - 24

ENGINEERS SEAL:

SIGNED: *Pietro A. DiFranco*
DATE: 09/13/2021

STANDARD CONSTRUCTION DRAWINGS						SUPPLEMENTAL SPECIFICATIONS		SPECIAL PROVISIONS	
BP-3.1	1/17/20	TC-71.10	1/19/18	MT-95.50	7/21/17	800	10/15/21		
BP-3.2	1/18/19	TC-82.10	7/19/19	MT-99.20	4/19/19	875	1/18/19		
BP-7.1	7/17/20								

PROJECT DESCRIPTION

RESURFACING OF 2.56 MILES OF CHARDON ROAD (US-06) FROM SOM CENTER ROAD (SR-91) TO THE EASTERN CITY LIMIT OF WILLOUGHBY HILLS.

PROJECT EARTH DISTURBED AREA:	N/A*
ESTIMATED CONTRACTOR EARTH DISTURBED AREA:	N/A*
NOTICE OF INTENT EARTH DISTURBED AREA:	N/A*

* MAINTENANCE PROJECT

2019 SPECIFICATIONS

THE STANDARD SPECIFICATIONS OF THE STATE OF OHIO, DEPARTMENT OF TRANSPORTATION, INCLUDING CHANGES AND SUPPLEMENTAL SPECIFICATIONS LISTED IN THE PROPOSAL SHALL GOVERN THIS IMPROVEMENT.

I HEREBY APPROVE THESE PLANS AND DECLARE THAT THE MAKING OF THIS IMPROVEMENT WILL REQUIRE THE CLOSING TO TRAFFIC OF THE ROADWAY AND THAT DETOURS WILL BE PROVIDED AS INDICATED ON SHEET 8 AND 9

APPROVED: *G. Gardner*
DATE 9/14/21
MAYOR
CITY OF WILLOUGHBY HILLS
G. ANDREW GARDNER

APPROVED: *[Signature]*
DATE 7/20/21
DISTRICT DEPUTY DIRECTOR

APPROVED: _____
DATE _____
DIRECTOR, DEPARTMENT OF TRANSPORTATION

FEDERAL PROJECT NO. **FAN E200(685)**

PID NO. **112503**

CONSTRUCTION PROJECT NO. _____

RAILROAD INVOLVEMENT **NONE**

LAK-US06-02.60

24

\\rba-fs01\5000-7999\7986\7986\51 LAK US006 02.60-2021\Civil\798651SH_01.dwg 13-Sep-21 10:15 AM

PAVEMENT (CONT.)

ITEM 253 - PAVEMENT REPAIR, AS PER PLAN

THIS ITEM IS ANTICIPATED TO BE USED TO REPAIR UNEVEN JOINTS IN THE CONCRETE BASE, AS DIRECTED BY THE ENGINEER.

THIS ITEM OF WORK SHALL CONSIST OF REMOVAL OF THE EXISTING ASPHALT SURFACE LAYERS AND REMOVAL OF 3 INCHES OF THE UNDERLYING CONCRETE BASE, IN AREAS OF SEVERE REFLECTIVE CRACKING/JOINT SEPARATION, AS DETERMINED BY THE ENGINEER.

USE CAUTION WHEN REMOVING CONCRETE BASE TO PREVENT DAMAGE TO EXISTING REINFORCING STEEL. THE 3 INCH CONCRETE BASE REMOVAL DEPTH SHALL BE REDUCED WHERE NECESSARY TO PREVENT DAMAGE TO EXISTING REINFORCING STEEL.

PAVEMENT REPAIR SHALL BE PERFORMED AFTER PAVEMENT PLANING AND BEFORE PLACEMENT OF THE INTERMEDIATE AND/OR SURFACE COURSE. THE CONTRACTOR SHALL BE CAPABLE OF PERFORMING PAVEMENT REPAIRS TO A MINIMUM OF 2 FEET WIDE.

THE DEPTH OF THE PAVEMENT REPAIR SHALL BE ESTIMATED AT 6" ± 1".



REPLACEMENT MATERIAL SHALL BE ITEM 301, ITEM 441 TYPE 2, OR ITEM 442 19MM MATERIAL AND SHALL BE PLACED AND COMPACTED TO FINISH FLUSH WITH THE ADJACENT PAVEMENT SURFACE.

PAYMENT SHALL INCLUDE ALL LABOR, EQUIPMENT, AND MATERIALS NECESSARY TO COMPLETE THE PAVEMENT REPAIRS. PAYMENT WILL BE MADE AT THE UNIT BID PRICE PER SQUARE YARD OF ITEM 253 - PAVEMENT REPAIR, AS PER PLAN. THE FOLLOWING ESTIMATED QUANTITY IS PROVIDED IN THE GENERAL SUMMARY TO BE USED AT LOCATIONS DETERMINED BY THE ENGINEER:

ITEM 253 - PAVEMENT REPAIR, AS PER PLAN

350 CY

ITEM 441 ASPHALT CONCRETE INTERMEDIATE COURSE TYPE 2, (448), PG64-22, AS PER PLAN

THIS ITEM SHALL BE USED FOR CORRECTION OF CROWN, PROFILE AND ANY OTHER IRREGULARITIES.

ALL OPEN TRANSVERSE JOINTS SHALL BE TAPERED TO MEET EXISTING PAVEMENT BEFORE INTRODUCING TRAFFIC. A "BUMP" SIGN (MB-1-36) SHALL BE ERECTED ON EACH SIDE OF TRANSVERSE JOINTS LEFT OPEN OVER NIGHT, INCLUDING A SPEED ADVISORY SIGN. THESE SIGNS SHALL BE REMOVED IMMEDIATELY AFTER JOINT HAS BEEN CLOSED. PAYMENT OF SIGNS SHALL BE INCLUDED IN THE UNIT PRICE BID FOR ITEMS 614 MAINTAINING TRAFFIC. REQUIREMENTS OF 441 APPLY.

ITEM 441 ASPHALT CONCRETE SURFACE COURSE TYPE 1, (446), PG70-22M, AS PER PLAN

THE COARSE VIRGIN AGGREGATE FOR THIS ITEM SHALL CONSIST OF A BLEND OF 60% MINIMUM AIR COOLED BLAST FURNACE SLAG (ACBFS) OR TRAP ROCK FROM ONTARIO WITH LIMESTONE COMPRISING THE REMAINING PERCENTAGE.

ALL OPEN TRANSVERSE JOINTS SHALL BE TAPERED TO MEET EXISTING PAVEMENT BEFORE INTRODUCING TRAFFIC. A "BUMP" SIGN (MB-1-36) SHALL BE ERECTED ON EACH SIDE OF TRANSVERSE JOINTS LEFT OPEN OVER NIGHT, INCLUDING A SPEED ADVISORY SIGN. THESE SIGNS SHALL BE REMOVED IMMEDIATELY AFTER JOINT HAS BEEN CLOSED. PAYMENT OF SIGNS SHALL BE INCLUDED IN THE UNIT PRICE BID FOR ITEMS 614 MAINTAINING TRAFFIC.

CARE SHALL BE TAKEN TO MATCH EXISTING PAVEMENT ELEVATIONS AT EXISTING PAVED BERMS, DRIVES, INTERSECTIONS, ETC.

ASPHALT CONCRETE SURFACE COURSE SEALING REQUIREMENTS

IN ADDITION TO THE GUTTER SEALING REQUIREMENTS SPECIFIED ON SCD BP-3.1 AND IN 401.15, THE CONTRACTOR SHALL SEAL THE FOLLOWING LOCATIONS:

- ALL CASTINGS INCLUDING BUT NOT LIMITED TO MONUMENTS, MANHOLES, WATER VALVES, CATCH BASINS, CURB INLETS.
- BUTT JOINTS AND FEATHER JOINTS INCLUDING BRIDGE APPROACHES.
- BUTT JOINTS BETWEEN PAVED SHOULDER AND DRIVEWAY ASPHALT AND TAPERED EDGE WHEN FEATHER TO AN EXISTING ASPHALT DRIVEWAY.
- PERIMETER OF ALL PAVEMENT REPAIRS OR OTHER ASPHALT INLAYS WHEN PAVEMENT REPAIRS/INLAYS ARE NOT OVERLAID WITH AN ASPHALT CONCRETE SURFACE COURSE.
- ALL COLD LONGITUDINAL JOINTS BETWEEN PAVED SHOULDERS AND GUARDRAIL ASPHALT.

THE MATERIAL USED SHALL BE A CERTIFIED 702.01 PG BINDER. THE WIDTH OF THE SEALER SHALL BE 2-3 INCHES.

ANY ADDITIONAL COSTS ASSOCIATED WITH THE WORK IDENTIFIED IN THIS NOTE SHALL BE INCLUDED IN THE APPROPRIATE ASPHALT CONCRETE SURFACE COURSE ITEM OF WORK.

ITEM 632 - DETECTOR LOOP, AS PER PLAN

DETECTOR LOOPS DISTURBED BY PAVEMENT PLANING, PAVEMENT REPAIR, OR BUTT JOINT OPERATIONS SHALL BE ABANDONED IN PLACE. THE NEW DETECTOR LOOP WIRE WILL BE CUT INTO THE INTERMEDIATE COURSE BEFORE THE PROPOSED SURFACE COURSE HAS BEEN PLACED. NEW LOOP DETECTORS SHALL BE PLACED AT THE SAME LOCATIONS AND BE THE SAME SIZE AND TYPE AS THE EXISTING, OR AS DETERMINED BY THE ENGINEER.

THE CONTRACTOR SHALL NOTIFY CITY OF WILLOUGHBY HILLS ENGINEER 216-377-3838 FIVE WORKING DAYS IN ADVANCE OF ANY PLANING OPERATIONS OR PAVEMENT REPAIR WORK THAT WILL DAMAGE DETECTOR LOOP INSTALLATIONS. THIS NOTIFICATION IS NEEDED TO SCHEDULE TEMPORARY SIGNAL TIMING MODIFICATIONS FOR THE TIME PERIOD WHEN THE DETECTOR LOOPS ARE OUT OF OPERATION. THE CONTRACTOR SHALL THEN RENOTIFY THE CITY WITHIN 2 WORKING DAYS AFTER THE DAMAGED DETECTOR LOOPS ARE REPLACED SO THAT SIGNAL TIMINGS CAN BE RESTORED TO THE ORIGINAL SETTINGS.

THE NEW DETECTOR LOOP WIRES SHALL BE RUN INTO THE EXISTING CONTROL BOX, POLE, OR PULLBOX, WHICHEVER IS APPLICABLE. INCLUDED IN THIS ITEM IS THE POURED EPOXY TYPE CABLE SPLICE KIT (CONFORMING TO 725.15) THAT MUST BE USED IN MAKING THESE CONNECTIONS. ALL NECESSARY MATERIAL, LABOR, SPLICE KITS AND EQUIPMENT FOR PROPER INSTALLATION AND OPERATION SHALL BE INCIDENTAL TO PAYMENT OF THESE ITEMS.

ITEM 611 - MANHOLE, CATCH BASIN, OR INLET ADJUSTED TO GRADE

ITEM 611 - MANHOLE, CATCH BASIN OR INLET RECONSTRUCTED TO GRADE, AS PER PLAN

THE FOLLOWING ESTIMATED QUANTITY IS TO BE USED WHERE DIRECTED BY THE ENGINEER.

ITEM 611 - CATCH BASIN RECONSTRUCTED TO GRADE, AS PER PLAN

2 EACH

ITEM SPECIAL - MISCELLANEOUS METAL, AS PER PLAN

EXISTING CASTINGS MAY PROVE TO BE UNSUITABLE FOR REUSE, AS DETERMINED BY THE ENGINEER. IT SHALL BE THE CONTRACTOR'S RESPONSIBILITY TO PROVIDE THE CASTINGS OF THE REQUIRED TYPE, SIZE AND STRENGTH (HEAVY OR LIGHT DUTY) FOR THE PARTICULAR STRUCTURE IN QUESTION. ALL MATERIAL SHALL MEET ITEM 611 OF THE SPECIFICATIONS AND SHALL HAVE THE PRIOR APPROVAL OF THE ENGINEER. REPLACEMENT OF OTHER CASTINGS (I.E. VALVE BOXES, MONUMENT BOXES, ETC.) UNSUITABLE FOR REUSE WILL ALSO BE PAID UNDER THIS ITEM.

THE FOLLOWING ESTIMATED QUANTITY HAS BEEN CARRIED TO THE GENERAL SUMMARY FOR USE AT LOCATIONS DETERMINED BY THE ENGINEER:

ITEM SPECIAL - MISCELLANEOUS METAL, AS PER PLAN

2000 POUNDS

THE CONTRACTOR IS CAUTIONED TO USE EXTREME CARE IN THE REMOVAL, STORAGE AND REPLACEMENT OF ALL EXISTING CASTINGS. CASTINGS DAMAGED BY THE NEGLIGENCE OF THE CONTRACTOR, AS DETERMINED BY THE ENGINEER, SHALL BE REPLACED WITH THE PROPER NEW CASTINGS AT THE EXPENSE OF THE CONTRACTOR.

PLANED SURFACES

THE DURATION OF TIME BETWEEN MILLING AND PLACEMENT OF THE INTERMEDIATE COURSE SHALL BE NO LONGER THAN FOURTEEN (14) DAYS, UNLESS MOT NOTES STATE OTHERWISE. THE LIMIT SHALL BEGIN ON THE FIRST DAY OF PLANING AND SHALL CONTINUE BASED ON CALENDAR DAYS, MINUS ANY BAD WEATHER DAYS, UNTIL COMPLETION OF THE ASPHALT CONCRETE INTERMEDIATE COURSE.

ITEM 252 - FULL DEPTH RIGID PAVEMENT REMOVAL AND FLEXIBLE REPLACEMENT. AS PER PLAN

THIS ITEM SHALL CONSIST OF REMOVING THE EXISTING PAVEMENT (ASPHALT & CONCRETE), FULL DEPTH, AND REPLACING WITH FLEXIBLE PAVEMENT.

FOR ESTIMATING PURPOSES, THE DEPTH OF THE FULL DEPTH PAVEMENT REPAIR SHALL BE 10.5 INCHES (±1 INCH)

THE ENGINEER WILL LOCATE AND MARK ALL AREAS FOR FULL DEPTH REPAIR BEFORE THE START OF FULL DEPTH SAWING. SAW THE LIMITS OF THE FULL DEPTH REPAIR AT THE LIMITS OF THE AREA DESIGNATED BY THE ENGINEER TO BE REPAIRED.

IF, AFTER PAVEMENT REMOVAL, THE ENGINEER DETERMINES THAT THE SUBBASE OR SUBGRADE HAS FAILED OR IS PUMPING, THE ENGINEER WILL DIRECT THE CONTRACTOR TO EXCAVATE THE UNSUITABLE MATERIAL AND REPLACE IT WITH COMPACTED 304 AGGREGATE. QUANTITIES OF ITEM 203 - EXCAVATION AND ITEM 304 - AGGREGATE BASE HAVE BEEN PROVIDED TO REPAIR SAID FAILED SUBBASE OR SUBGRADE AREAS.

PAYMENT SHALL BE BASED ON THE ACTUAL NUMBER OF SQUARE YARDS OF PAVEMENT REMOVED AND REPLACED TO THE LIMITS DESIGNATED BY THE ENGINEER.

ALL COSTS ASSOCIATED WITH THIS ITEM INCLUDING THE SAWCUTTING, LABOR, MATERIALS AND EQUIPMENT SHALL BE INCLUDED IN ITEM 252 - FULL DEPTH RIGID PAVEMENT REMOVAL AND FLEXIBLE REPLACEMENT, AS PER PLAN.

THE FOLLOWING ESTIMATED QUANTITIES HAVE BEEN CARRIED OVER TO THE GENERAL SUMMARY TO BE USED AS DETERMINED BY THE ENGINEER:

ITEM 204 - EXCAVATION OF SUBGRADE, AS PER PLAN 20 CY
ITEM 252 - FULL DEPTH RIGID PAVEMENT REMOVAL & FLEXIBLE REPLACEMENT, AS PER PLAN 2000 SY
ITEM 304 - AGGREGATE BASE, AS PER PLAN 20 CY

CALCULATED
KMT
CHECKED

GENERAL NOTES

LAK-US06-02.60

\\rbe-fs01\5000-7999\7986\7986.51 LAK US006 02.60-2021\Civil\798651SH_06.dwg 07-Jan-22 1:50 PM

MAINTENANCE OF TRAFFIC

ITEM 614 - MAINTAINING TRAFFIC, AS PER PLAN

BEFORE WORK BEGINS, THE CONTRACTOR SHALL SUBMIT TO THE ENGINEER THE NAMES AND TELEPHONE NUMBERS OF A PERSON OR PERSONS WHO CAN BE CONTACTED 24 HOURS A DAY BY THE ENGINEER AND ALL INTERESTED POLICING AGENCIES. THIS PERSON OR PERSONS SHALL BE RESPONSIBLE FOR REPLACING NECESSARY TRAFFIC CONTROL DEVICES IMMEDIATELY.

THE CONTRACTOR SHALL ALSO ARRANGE HIS OPERATIONS SO AS TO PREVENT ANY INTERFERENCE TO THE CONTINUOUS FLOW OF TRAFFIC. ALL VEHICLES, EQUIPMENT, WORKERS AND THEIR ACTIVITIES ARE RESTRICTED AT ALL TIME TO ONE SIDE OF THE PAVEMENT UNLESS OTHERWISE APPROVED BY THE PROJECT ENGINEER.

THE CONTRACTOR SHALL DIVERT TRAFFIC FROM NORMAL CHANNELS BY PLASTIC DRUMS, FLASHING ARROW PANELS COMPLYING WITH SUPPLEMENTAL SPECIFICATION 821, TRAFFIC SIGNS AND WORK ZONE PAVEMENT MARKINGS.

THE CONTRACTOR SHALL FURNISH AND MAINTAIN ALL NECESSARY SAFEGUARDS, SUCH AS TYPE III BARRICADES, LIGHTING, FLAGGERS, AND SUCH OTHER TRAFFIC CONTROL DEVICES AS PROVIDED IN ITEM 614, MAINTAINING TRAFFIC, SO AS TO AVOID DAMAGE AND/OR INJURY TO VEHICLES AND PERSONS USING THE ROADWAY DURING CONSTRUCTION.

BY THE END OF EACH DAY OF WORK, THE CONTRACTOR SHALL REPLACE (WITH WORK ZONE MARKINGS) ALL LANE LINES, CENTERLINES, EDGE LINES, STOP LINES, AND CHANNELIZING LINES. THE FOLLOWING WORK ZONE PAVEMENT MARKING QUANTITIES HAVE BEEN CARRIED TO THE GENERAL SUMMARY:

PLANED SURFACE:

Table with 2 columns: Item description and quantity. Includes items like 'ITEM 614 - WORK ZONE EDGE LINE, CLASS I, 4" 4.98 MILE'.

INTERMEDIATE COURSE:

Table with 2 columns: Item description and quantity. Includes items like 'ITEM 614 - WORK ZONE EDGE LINE, CLASS I, 4" 4.98 MILE'.

SURFACE COURSE:

Table with 2 columns: Item description and quantity. Includes items like 'ITEM 614 - WORK ZONE EDGE LINE, CLASS III, 4", 642 PAINT 4.98 MILE'.

ALL DETOUR SIGNAGE, ADDITIONAL WORK ZONE PAVEMENT MARKINGS, AND ADDITIONAL ASPHALT FOR MAINTAINING TRAFFIC SHALL BE INCLUDED IN THE LUMP SUM BID FOR MAINTAINING TRAFFIC.

EXISTING TRAFFIC CONTROL DEVICES (SIGNS AND/OR TRAFFIC SIGNALS), LOCATED WITHIN THE WORK AREA, WHICH ARE REQUIRED FOR INTERIM OR PERMANENT TRAFFIC CONTROL, SHALL BE RELOCATED TO POINTS APPROVED BY THE ENGINEER. APPROPRIATE TRAFFIC CONTROL DEVICES SHALL BE MAINTAINED, IN COMPLIANCE WITH THE MANUAL, AT ALL TIMES WHILE TRAFFIC IS MAINTAINED. THE COST OF RELOCATION, IF REQUIRED, SHALL BE INCLUDED IN THE LUMP SUM PRICE BID FOR ITEM 614 - MAINTAINING TRAFFIC, AS PER PLAN.

LENGTH AND DURATION OF LANE CLOSURES AND RESTRICTIONS SHALL BE AT THE APPROVAL OF THE ENGINEER. IT IS THE INTENT TO MINIMIZE THE IMPACT TO THE TRAVELING PUBLIC. LANE CLOSURES OR RESTRICTIONS OVER SEGMENTS OF THE PROJECT, IN WHICH NO WORK IS ANTICIPATED WITHIN A REASONABLE TIME FRAME, AS DETERMINED BY THE ENGINEER, SHALL NOT BE PERMITTED. THE LEVEL OF UTILIZATION OF TRAFFIC DEVICES SHALL BE COMMENSURATE WITH THE WORK IN PROGRESS.

ALL WORK AND TRAFFIC CONTROL DEVICES SHALL BE IN ACCORDANCE WITH CMS 614 AND OTHER APPLICABLE PORTIONS OF THE SPECIFICATIONS, AS WELL AS THE OHIO MANUAL OF UNIFORM TRAFFIC CONTROL DEVICES. PAYMENT FOR ALL LABOR, EQUIPMENT AND MATERIALS SHALL BE INCLUDED IN THE LUMP SUM CONTRACT PRICE FOR ITEM 614, MAINTAINING TRAFFIC, UNLESS SEPARATELY ITEMIZED IN THE PLAN.

A MINIMUM OF 1 LANE OF TRAFFIC SHALL BE MAINTAINED AT ALL TIMES ON TWO LANE ROADWAYS BY USE OF THE EXISTING PAVEMENT. A MINIMUM OF 1 LANE OF TRAFFIC IN EACH DIRECTION SHALL BE MAINTAINED AT ALL TIMES ON FOUR LANE ROADWAYS BY USE OF THE EXISTING PAVEMENT. PART WIDTH CONSTRUCTION SHALL BE USED TO FACILITATE MAINTAINING TWO WAY TRAFFIC ON INTERSECTING STREETS. EXISTING SIGNS OR CONTRACTOR SUPPLIED SIGNS SHALL BE USED TO MAINTAIN TRAFFIC DURING CONSTRUCTION.

THE CONTRACTOR SHALL MAINTAIN SAFE AND SATISFACTORY ACCESS TO ABUTTING PROPERTY AND ADJACENT STREETS. THE CONTRACTOR SHALL MAINTAIN ADEQUATE PEDESTRIAN WALKS AT ALL INTERSECTIONS. ALL CONFLICTING SIGNS AND PAVEMENT MARKINGS, WHETHER INSIDE OR OUTSIDE THE WORK LIMITS, SHALL BE COVERED OR REMOVED. WHERE APPLICABLE, AND WHEN DIRECTED BY THE ENGINEER, THE CONTRACTOR SHALL PLACE TEMPORARY SIGNS OR TEMPORARY PAVEMENT MARKING AT THESE LOCATIONS.

MAINTENANCE OF TRAFFIC (CONT.)

SCHOOLS:

THE CONTRACTOR IS REQUIRED TO NOTIFY AND COORDINATE WITH THE WILLOUGHBY EASTLAKE SCHOOL DISTRICT FOR APPROPRIATE ACCESS AND STUDENT SAFETY CONSIDERATION DURING THE VARIOUS MOT PHASES.

BUSINESS OWNERS:

THE CONTRACTOR SHALL WORK WITH THE LOCAL BUSINESS OWNERS TO ENSURE ACCESS TO ALL PROPERTIES AT ALL TIMES. HOWEVER, SOME INCONVENIENCES WILL OCCUR. NO ADDITIONAL PAYMENT WILL BE MADE FOR THE COORDINATION OF OR PROVIDING ACCESS TO THE BUSINESSES.

ITEM 614 - LAW ENFORCEMENT OFFICER WITH PATROL CAR FOR ASSISTANCE DURING CONSTRUCTION OPERATIONS, AS PER PLAN

IN ADDITION TO THE REQUIREMENTS OF CMS 614 AND THE LATEST EDITION OF THE OHIO MANUAL OF UNIFORM TRAFFIC CONTROL DEVICES (OMUTCD), A UNIFORMED LAW ENFORCEMENT OFFICER (AND OFFICIAL PATROL CAR WITH MOUNTED EMERGENCY FLASHING LIGHTS) SHALL BE PROVIDED FOR CONTROLLING TRAFFIC FOR THE FOLLOWING TASKS AS DETERMINED BY THE ENGINEER:

FOR LANE CLOSURES: DURING INITIAL SET-UP PERIODS, TEAR DOWN PERIODS, SUBSTANTIAL SHIFTS OF A CLOSURE POINT OR WHEN NEW LANE CLOSURE ARRANGEMENTS ARE INITIATED.

DURING THE ENTIRE ADVANCE PREPARATION AND CLOSURE SEQUENCE WHERE COMPLETE BLOCKAGE OF TRAFFIC IS REQUIRED.

LAW ENFORCEMENT OFFICERS (LEO'S) SHOULD NOT BE USED WHERE THE OMUTCD INTENDS THAT FLAGGERS BE USED. THE LEO'S ARE CONSIDERED TO BE EMPLOYED BY THE CONTRACTOR AND THE CONTRACTOR SHALL BE RESPONSIBLE FOR THEIR ACTIONS. ALTHOUGH THEY ARE EMPLOYED BY THE CONTRACTOR, THE PROJECT ENGINEER SHALL HAVE CONTROL OVER THEIR PLACEMENT. THE OFFICIAL PATROL CAR SHALL BE A PUBLIC SAFETY VEHICLE AS REQUIRED BY THE OHIO REVISED CODE. THE CONTRACTOR SHALL PROVIDE THE LEO WITH A TWO WAY COMMUNICATION DEVICE WHICH SHALL BE RETURNED TO THE CONTRACTOR AT THE END OF HIS/HER SHIFT.

LEO'S SHOULD NOT FORGO THEIR TRAFFIC CONTROL RESPONSIBILITIES TO APPREHEND MOTORISTS FOR ROUTINE TRAFFIC VIOLATIONS. HOWEVER, IF A MOTORIST'S ACTIONS ARE CONSIDERED TO BE RECKLESS, THEN PURSUIT OF THE MOTORIST IS APPROPRIATE.

THE CONTRACTOR SHALL MAKE ARRANGEMENTS FOR THESE SERVICES WITH THE LAW ENFORCEMENT AGENCY LISTED BELOW:

THE CITY OF WILLOUGHBY HILLS POLICE DEPT. 35405 CHARDON ROAD WILLOUGHBY HILLS, OHIO 44094 PHONE: (440) 942-9111 EMAIL: POLICE@WILLOUGHBYHILLS-OH.GOV

LAW ENFORCEMENT OFFICERS WITH PATROL CAR REQUIRED BY THE TRAFFIC MAINTENANCE TASKS ABOVE SHALL BE INCLUDED IN THE LUMP SUM CONTRACT PRICE FOR ITEM 614 - MAINTAINING TRAFFIC.

THE HOURS SHALL INCLUDE MINIMUM SHOW-UP TIME REQUIRED BY THE LAW ENFORCEMENT AGENCY INVOLVED.

ITEM 614 - LAW ENFORCEMENT OFFICER WITH PATROL CAR, AS PER PLAN 150 HR

DRIVEWAY ACCESS

THE CONTRACTOR SHALL MAKE AVAILABLE DURING CONSTRUCTION, STEEL PLATES, BRIDGES, OR OTHER MEANS APPROVED BY THE ENGINEER TO PROVIDE FULL TIME (TWENTY-FOUR [24] HOURS, SEVEN [7] DAYS A WEEK) ACCESS TO DRIVEWAYS THAT REQUIRE IT.

ACROSS FROM EACH DRIVE WITHIN THE DETOURS SHOWN ON SHEETS 8 & 9, A ONE WAY SIGN SHALL BE ERRECTED. WHEN THE DETOUR IS NOT IN EFFECT, THE SIGNS SHALL BE COVERED. PAYMENT FOR THESE SIGNS, COVERING AND UNCOVERING OF THE SIGNS, SHALL BE INCLUDED IN THE LUMP SUM PRICE FOR ITEM 614, MAINTAINING TRAFFIC, AS PER PLAN.

MAINTENANCE OF TRAFFIC (CONT.)

REPLACEMENT SIGNS

FLAT SHEET SIGNS FURNISHED BY THE CONTRACTOR IN ACCORDANCE WITH THE REQUIREMENTS OF THE PLANS, SPECIFICATIONS, AND PROPOSAL WHICH BECOME DAMAGED BY TRAFFIC FOR REASONS BEYOND THE CONTROL OF THE CONTRACTOR SHALL BE REPLACED IN KIND WHEN ORDERED BY THE ENGINEER. REPLACEMENT SIGNS SHALL BE NEW. OTHER MATERIALS MAY BE USED, BUT MUST BE IN GOOD CONDITION SUBJECT TO THE APPROVAL OF THE ENGINEER.

PAYMENT FOR THE NEW SIGNS SHALL BE INCLUDED IN THE LUMP SUM BID FOR ITEM 614 - MAINTAINING TRAFFIC, AND SHALL INCLUDE THE COST OF REMOVING AND DISPOSING OF DAMAGED SIGNS, HARDWARE AND SUPPORTS, AND PROVIDING THE NECESSARY REPLACEMENT HARDWARE, SUPPORTS, ETC.

PHASED CONSTRUCTION

THE PROJECT HAS BEEN SEPARATED INTO THE FOLLOWING MOT PHASES:

- PHASE 1: WEST BOUND LANES OF TRAFFIC CLOSED BETWEEN SOM CENTER RD & RIVER RD
PHASE 2: EAST BOUND LANES OF TRAFFIC CLOSED BETWEEN SOM CENTER RD & RIVER RD
PHASE 3: WEST BOUND LANES OF TRAFFIC CLOSED BETWEEN RIVER RD & WORRELL RD
PHASE 4: EAST BOUND LANES OF TRAFFIC CLOSED BETWEEN RIVER RD & WORRELL RD

ALL LANES OF TRAFFIC SHALL BE FULLY OPENED TO THE PUBLIC AT THE END OF EACH WORK DAY UNLESS OTHERWISE APPROVED BY THE ENGINEER.

EQUIPMENT AND MATERIAL STORAGE

IN ORDER TO PROVIDE FOR THE SAFETY OF THE TRAVELING PUBLIC, THE CONTRACTOR'S ATTENTION IS DIRECTED TO ITEM 614.03. IN ADDITION, THE FOLLOWING PROVISIONS SHALL APPLY:

- 1. ANY REMOVED ITEMS SHALL NOT BE STORED ON THE RIGHT OF WAY FOR MORE THAN THIRTY (30) DAYS.
2. ALL DISTURBED AREAS SHALL BE RETURNED TO THEIR ORIGINAL CONDITION AT NO EXPENSE TO ODOT.

IN ORDER TO PREVENT DAMAGE TO PAVEMENT, CURBS, ETC., NO MATERIALS (GRAVEL, SOIL, ETC.) SHALL BE STORED OR STAGED ON THE PAVEMENT. MATERIALS SHALL BE TRANSFERRED DIRECTLY FROM TRUCK TO EXCAVATION OR EXCAVATION TO TRUCK.

COVERING OF SIGNS

ANY EXISTING SIGNS THAT ARE IN CONFLICT WITH THE PROPOSED MAINTENANCE OF TRAFFIC PLANS SHALL BE COVERED. THE CONTRACTOR SHALL DO SO IN SUCH A MANNER AS TO AVOID DAMAGING THE PERMANENT SIGN WHEN THE COVER IS REMOVED. THE COVER SHALL BE TOTALLY OPAQUE. THE USE OF ADHESIVE TAPE APPLIED DIRECTLY TO ANY EXISTING OR NEW SIGN FACE IS STRICTLY PROHIBITED. ANY SIGNS DAMAGED BY THE NEGLIGENCE OF THE CONTRACTOR, WHEN DETERMINED BY THE ENGINEER, SHALL BE REPLACED BY AND AT THE EXPENSE OF THE CONTRACTOR.

\\rbo-fs01\5000-7999\7986\7986.51 LAK US006 02.60-2021\Civil\798651SH_07.dwg 07-Jan-22 1:51 PM

CALCULATED
KMT
CHECKED

MAINTENANCE OF TRAFFIC GENERAL NOTES

LAK-US06-02.60

MAINTENANCE OF TRAFFIC (CONT.)

ITEM 614 - PORTABLE CHANGEABLE MESSAGE SIGNS, AS PER PLAN

THE CONTRACTOR SHALL FURNISH, INSTALL, MAINTAIN AND REMOVE, WHEN NO LONGER NEEDED, A CHANGEABLE MESSAGE SIGN. THE SIGN SHALL BE OF A TYPE SHOWN ON A LIST OF APPROVED PCMS UNITS AVAILABLE ON THE OFFICE OF MATERIALS MANAGEMENT WEB PAGE. THE LIST CONTAINS CLASS A AND B UNITS WITH MINIMUM LEGIBILITY DISTANCES OF 800 FEET AND 650 FEET, RESPECTIVELY.

EACH SIGN SHALL BE TRAILER-MOUNTED AND EQUIPPED WITH A FUNCTIONAL DIMMING MECHANISM, TO DIM THE SIGN DURING DARKNESS, AND A TAMPER AND VANDAL PROOF ENCLOSURE. EACH SIGN SHALL BE PROVIDED WITH APPROPRIATE TRAINING AND OPERATION INSTRUCTIONS TO ENABLE ON-SITE PERSONNEL TO OPERATE AND TROUBLESHOOT THE UNIT. THE SIGN SHALL ALSO BE CAPABLE OF BEING POWERED BY AN ELECTRICAL SERVICE DROP FROM A LOCAL UTILITY COMPANY. THE PCMS SHALL BE DELINEATED IN ACCORDANCE WITH C&MS 614.03.

PLACEMENT, OPERATION, MAINTENANCE AND ALL ACTIVATION OF THE SIGNS BY THE CONTRACTOR SHALL BE AS DIRECTED BY THE ENGINEER. THE PCMS SHALL BE LOCATED IN A HIGHLY VISIBLE POSITION YET PROTECTED FROM TRAFFIC. THE CONTRACTOR SHALL, AT THE DIRECTION OF THE ENGINEER, RELOCATE THE PCMS TO IMPROVE VISIBILITY OR ACCOMMODATE CHANGED CONDITIONS. WHEN NOT IN USE, THE PCMS SHALL BE TURNED OFF. ADDITIONALLY, WHEN NOT IN USE FOR EXTENDED PERIODS OF TIME, THE PCMS SHALL BE TURNED AWAY FROM ALL TRAFFIC.

THE ENGINEER SHALL BE PROVIDED ACCESS TO EACH SIGN UNIT AND SHALL BE PROVIDED WITH APPROPRIATE TRAINING AND OPERATION INSTRUCTIONS TO ENABLE ODOT PERSONNEL TO OPERATE AND TROUBLESHOOT THE UNIT, AND TO REVISE SIGN MESSAGES, IF NECESSARY.

ALL MESSAGES TO BE DISPLAYED ON THE SIGN WILL BE PROVIDED BY THE ENGINEER. A LIST OF ALL REQUIRED PRE-PROGRAMMED MESSAGES WILL BE GIVEN TO THE CONTRACTOR AT THE PROJECT PRECONSTRUCTION CONFERENCE. THE SIGN SHALL HAVE THE CAPABILITY TO STORE UP TO 99 MESSAGES. MESSAGE MEMORY OR PRE-PROGRAMMED DISPLAYS SHALL NOT BE LOST AS A RESULT OF POWER FAILURES TO THE ON-BOARD COMPUTER. THE SIGN LEGEND SHALL BE CAPABLE OF BEING CHANGED IN THE FIELD. THREE-LINE PRESENTATION FORMATS WITH UP TO SIX MESSAGE PHASES SHALL BE SUPPORTED. PCMS FORMAT SHALL PERMIT THE COMPLETE MESSAGE FOR EACH PHASE TO BE READ AT LEAST TWICE.

THE PCMS SHALL CONTAIN AN ACCURATE CLOCK AND PROGRAMMING LOGIC WHICH WILL ALLOW THE SIGN TO BE ACTIVATED, DEACTIVATED OR MESSAGES CHANGED AUTOMATICALLY AT DIFFERENT TIMES OF THE DAY FOR DIFFERENT DAYS OF THE WEEK.


THE PCMS UNIT SHALL BE MAINTAINED IN GOOD WORKING ORDER BY THE CONTRACTOR IN ACCORDANCE WITH THE PROVISIONS OF C&MS 614.07. THE CONTRACTOR SHALL, PRIOR TO ACTIVATING THE UNIT, MAKE ARRANGEMENTS, WITH AN AUTHORIZED SERVICE AGENT FOR THE PCMS, TO ASSURE PROMPT SERVICE IN THE EVENT OF FAILURE. ANY FAILURE SHALL NOT RESULT IN THE SIGN BEING OUT OF SERVICE FOR MORE THAN 12 HOURS, INCLUDING WEEKENDS. FAILURE TO COMPLY MAY RESULT IN AN ORDER TO STOP WORK AND OPEN ALL TRAFFIC LANES AND/OR IN THE DEPARTMENT TAKING APPROPRIATE ACTION TO SAFELY CONTROL TRAFFIC. THE ENTIRE COST TO CONTROL TRAFFIC, ACCRUED BY THE DEPARTMENT DUE TO THE CONTRACTOR'S NONCOMPLIANCE, WILL BE DEDUCTED FROM MONEYS DUE, OR TO BECOME DUE THE CONTRACTOR ON HIS CONTRACT.

THE CONTRACTOR SHALL BE RESPONSIBLE FOR 24-HOUR-PER-DAY OPERATION AND MAINTENANCE OF THESE SIGNS ON THE PROJECT FOR THE DURATION OF THE PHASES WHEN THE PLAN REQUIRES THEIR USE.

PAYMENT FOR THE ABOVE DESCRIBED ITEM SHALL BE AT THE CONTRACT UNIT PRICE. PAYMENT SHALL INCLUDE ALL LABOR, MATERIALS, EQUIPMENT, FUELS, LUBRICATING OILS, SOFTWARE, HARDWARE AND INCIDENTALS TO PERFORM THE ABOVE DESCRIBED WORK.

THE ESTIMATED QUANTITY PROVIDES FOR 2 PCMS UNITS AT 2 MONTHS EACH.

ITEM 614, PORTABLE CHANGEABLE MESSAGE SIGN, AS PER PLAN 4 SNMT
ASSUMING 3 PCMS SIGN(S) FOR 2 MONTH(S)

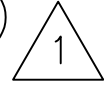

\\rbe-fs01\5000-7999\7986\7986.51 LAK US006 02.60-2021\Civil\7986\TSH-07A.dwg 07/25/22 1:51 PM

CALCULATED
KMT
CHECKED

MAINTENANCE OF TRAFFIC GENERAL NOTES

LAK-US06-02.60

