




FHWA REGION	STATE	PROJECT
5	OHIO	M + R

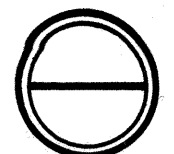

LAW-775-1532

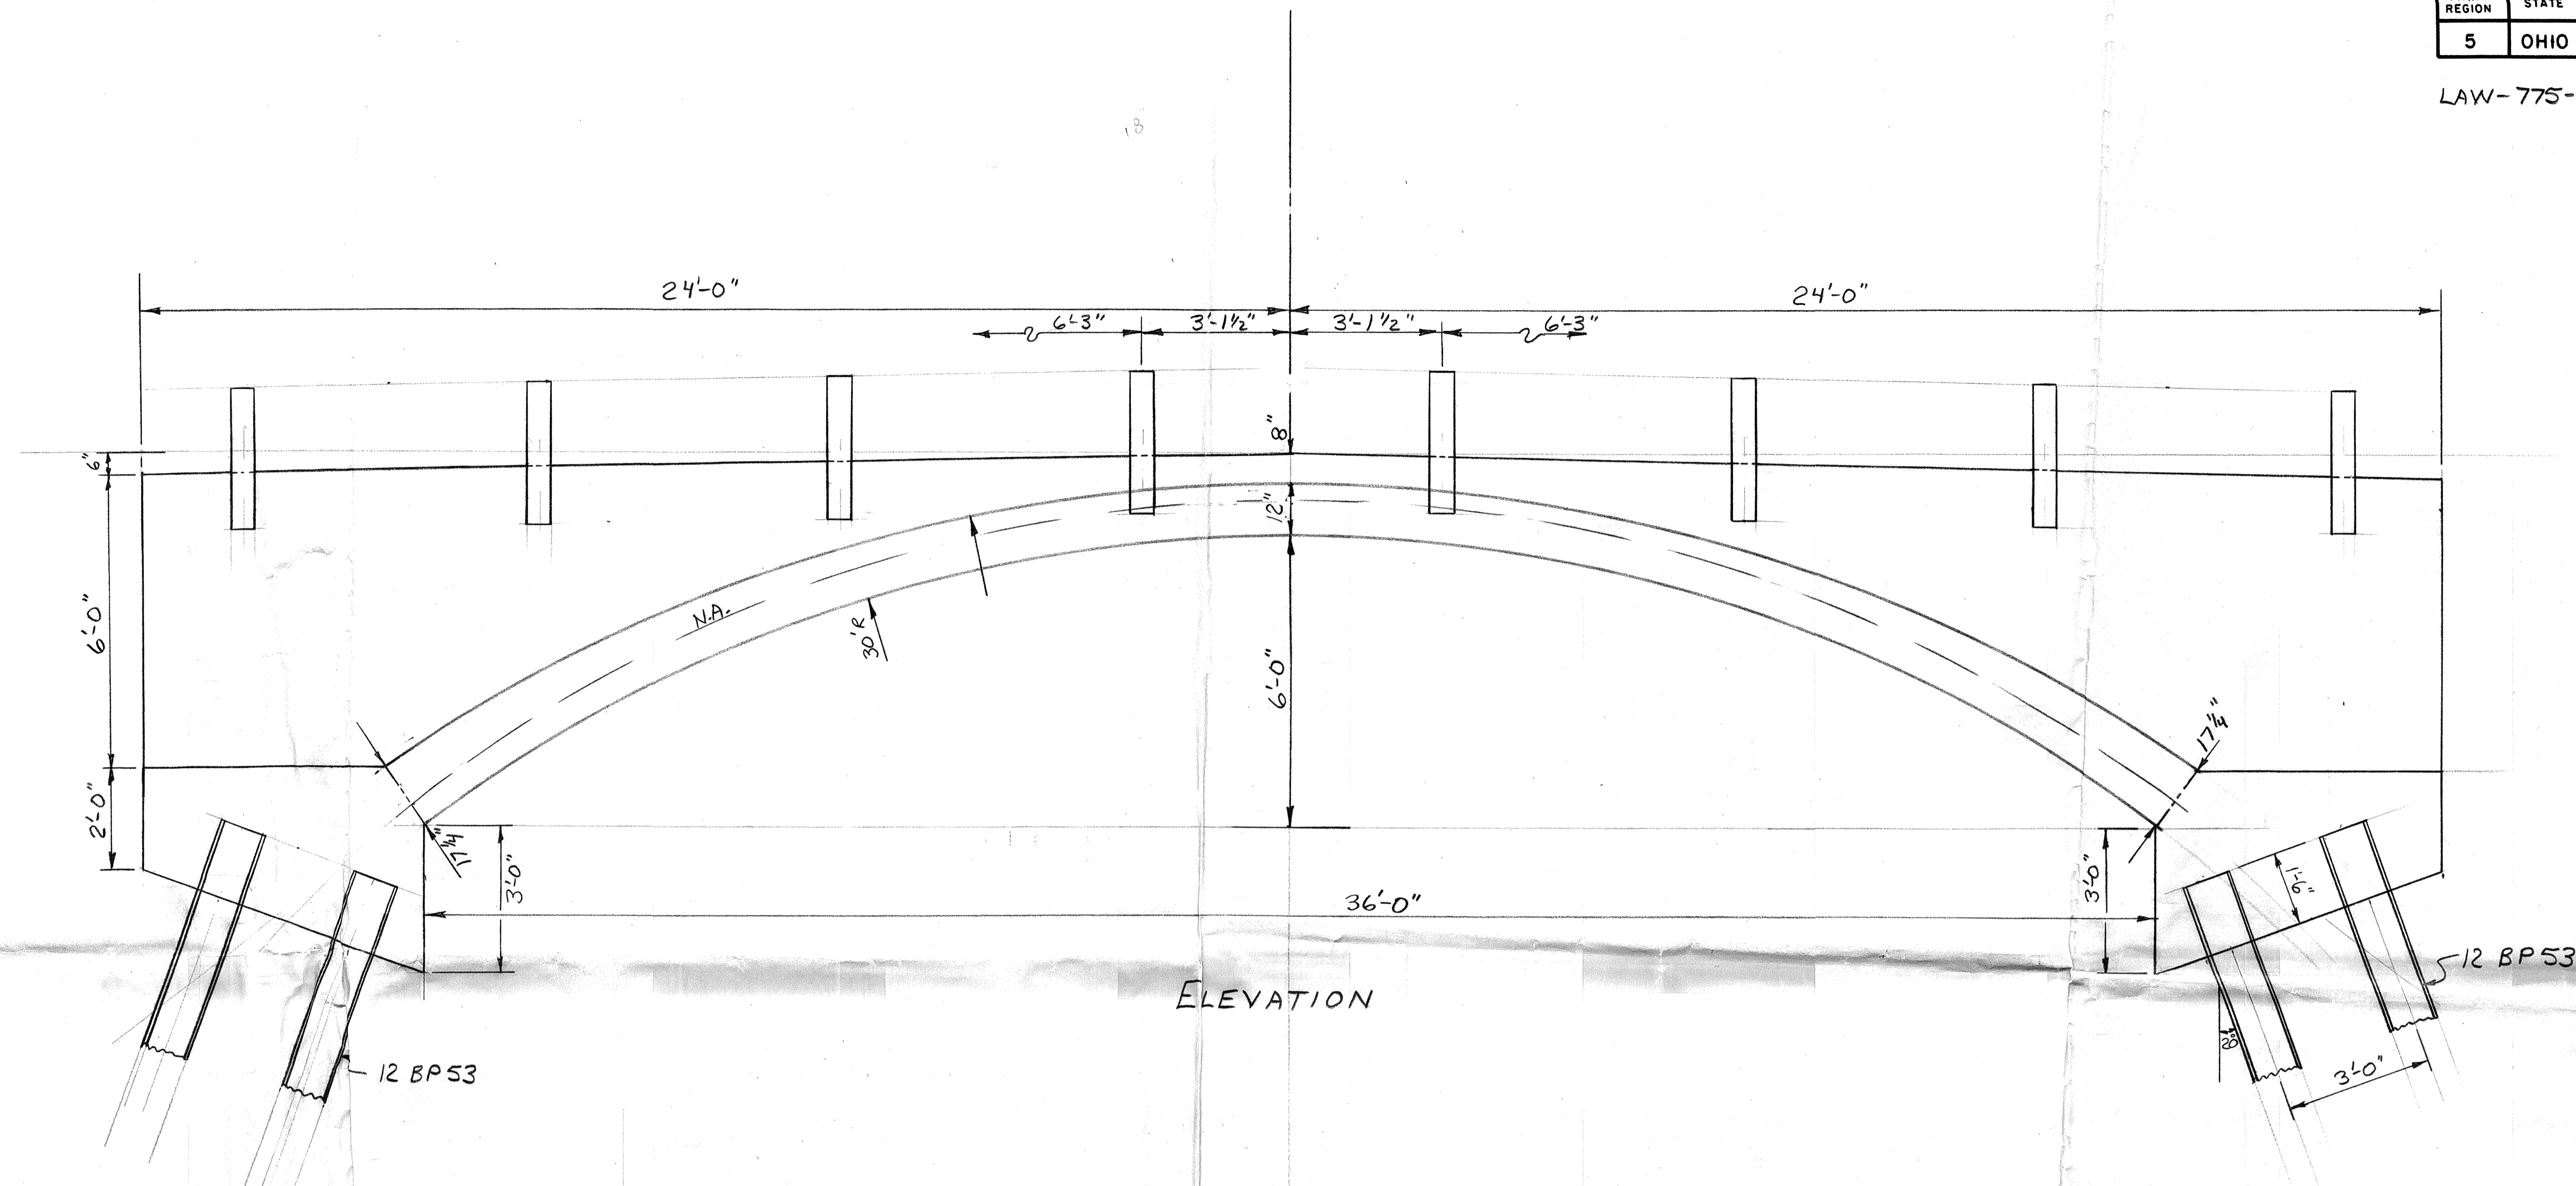

ELEVATION


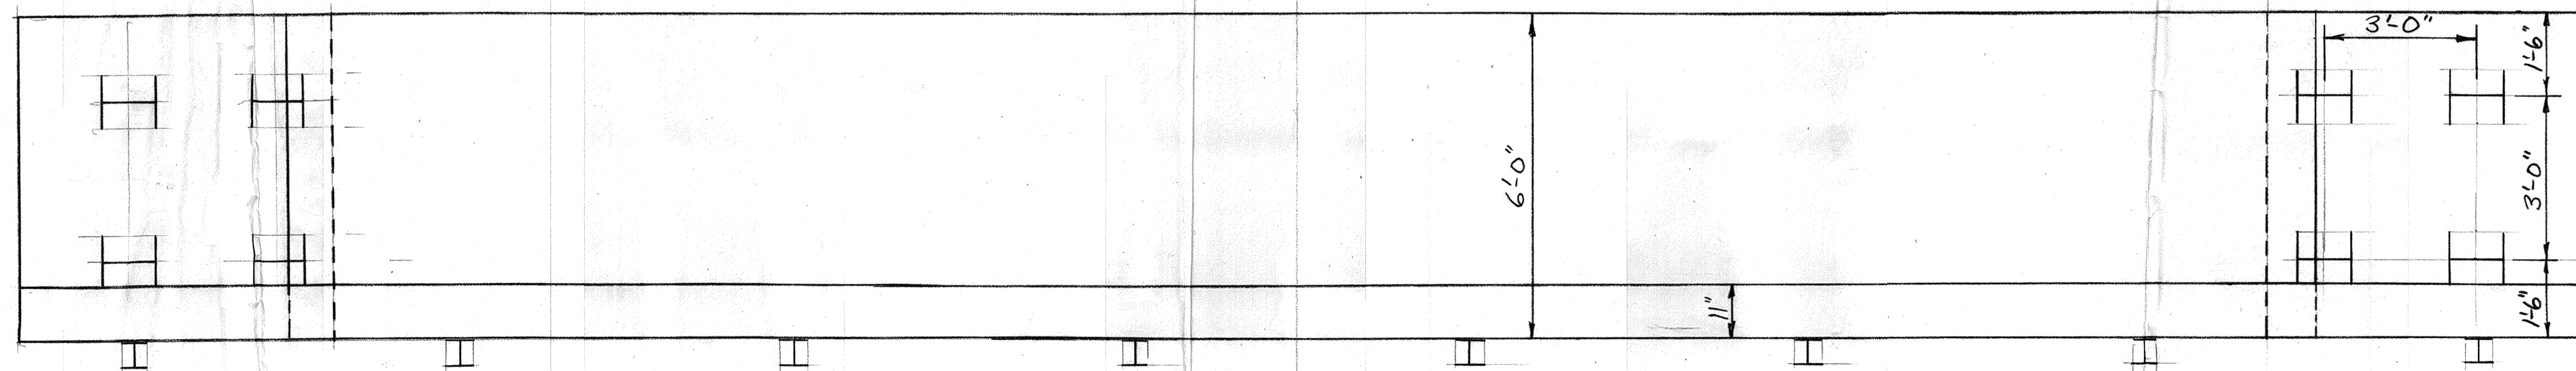



PLAN (TYPICAL EACH SIDE)

STATE OF OHIO
DEPARTMENT OF TRANSPORTATION
DIVISION OF HIGHWAYS
DISTRICT 9 BRIDGE DEPT.


LAW-775-1532
OVER LONG CREEK



DESIGNED	DRAWN	TRACED	CHECKED	REVIEWED	DATE	REVISED
JB	JB					

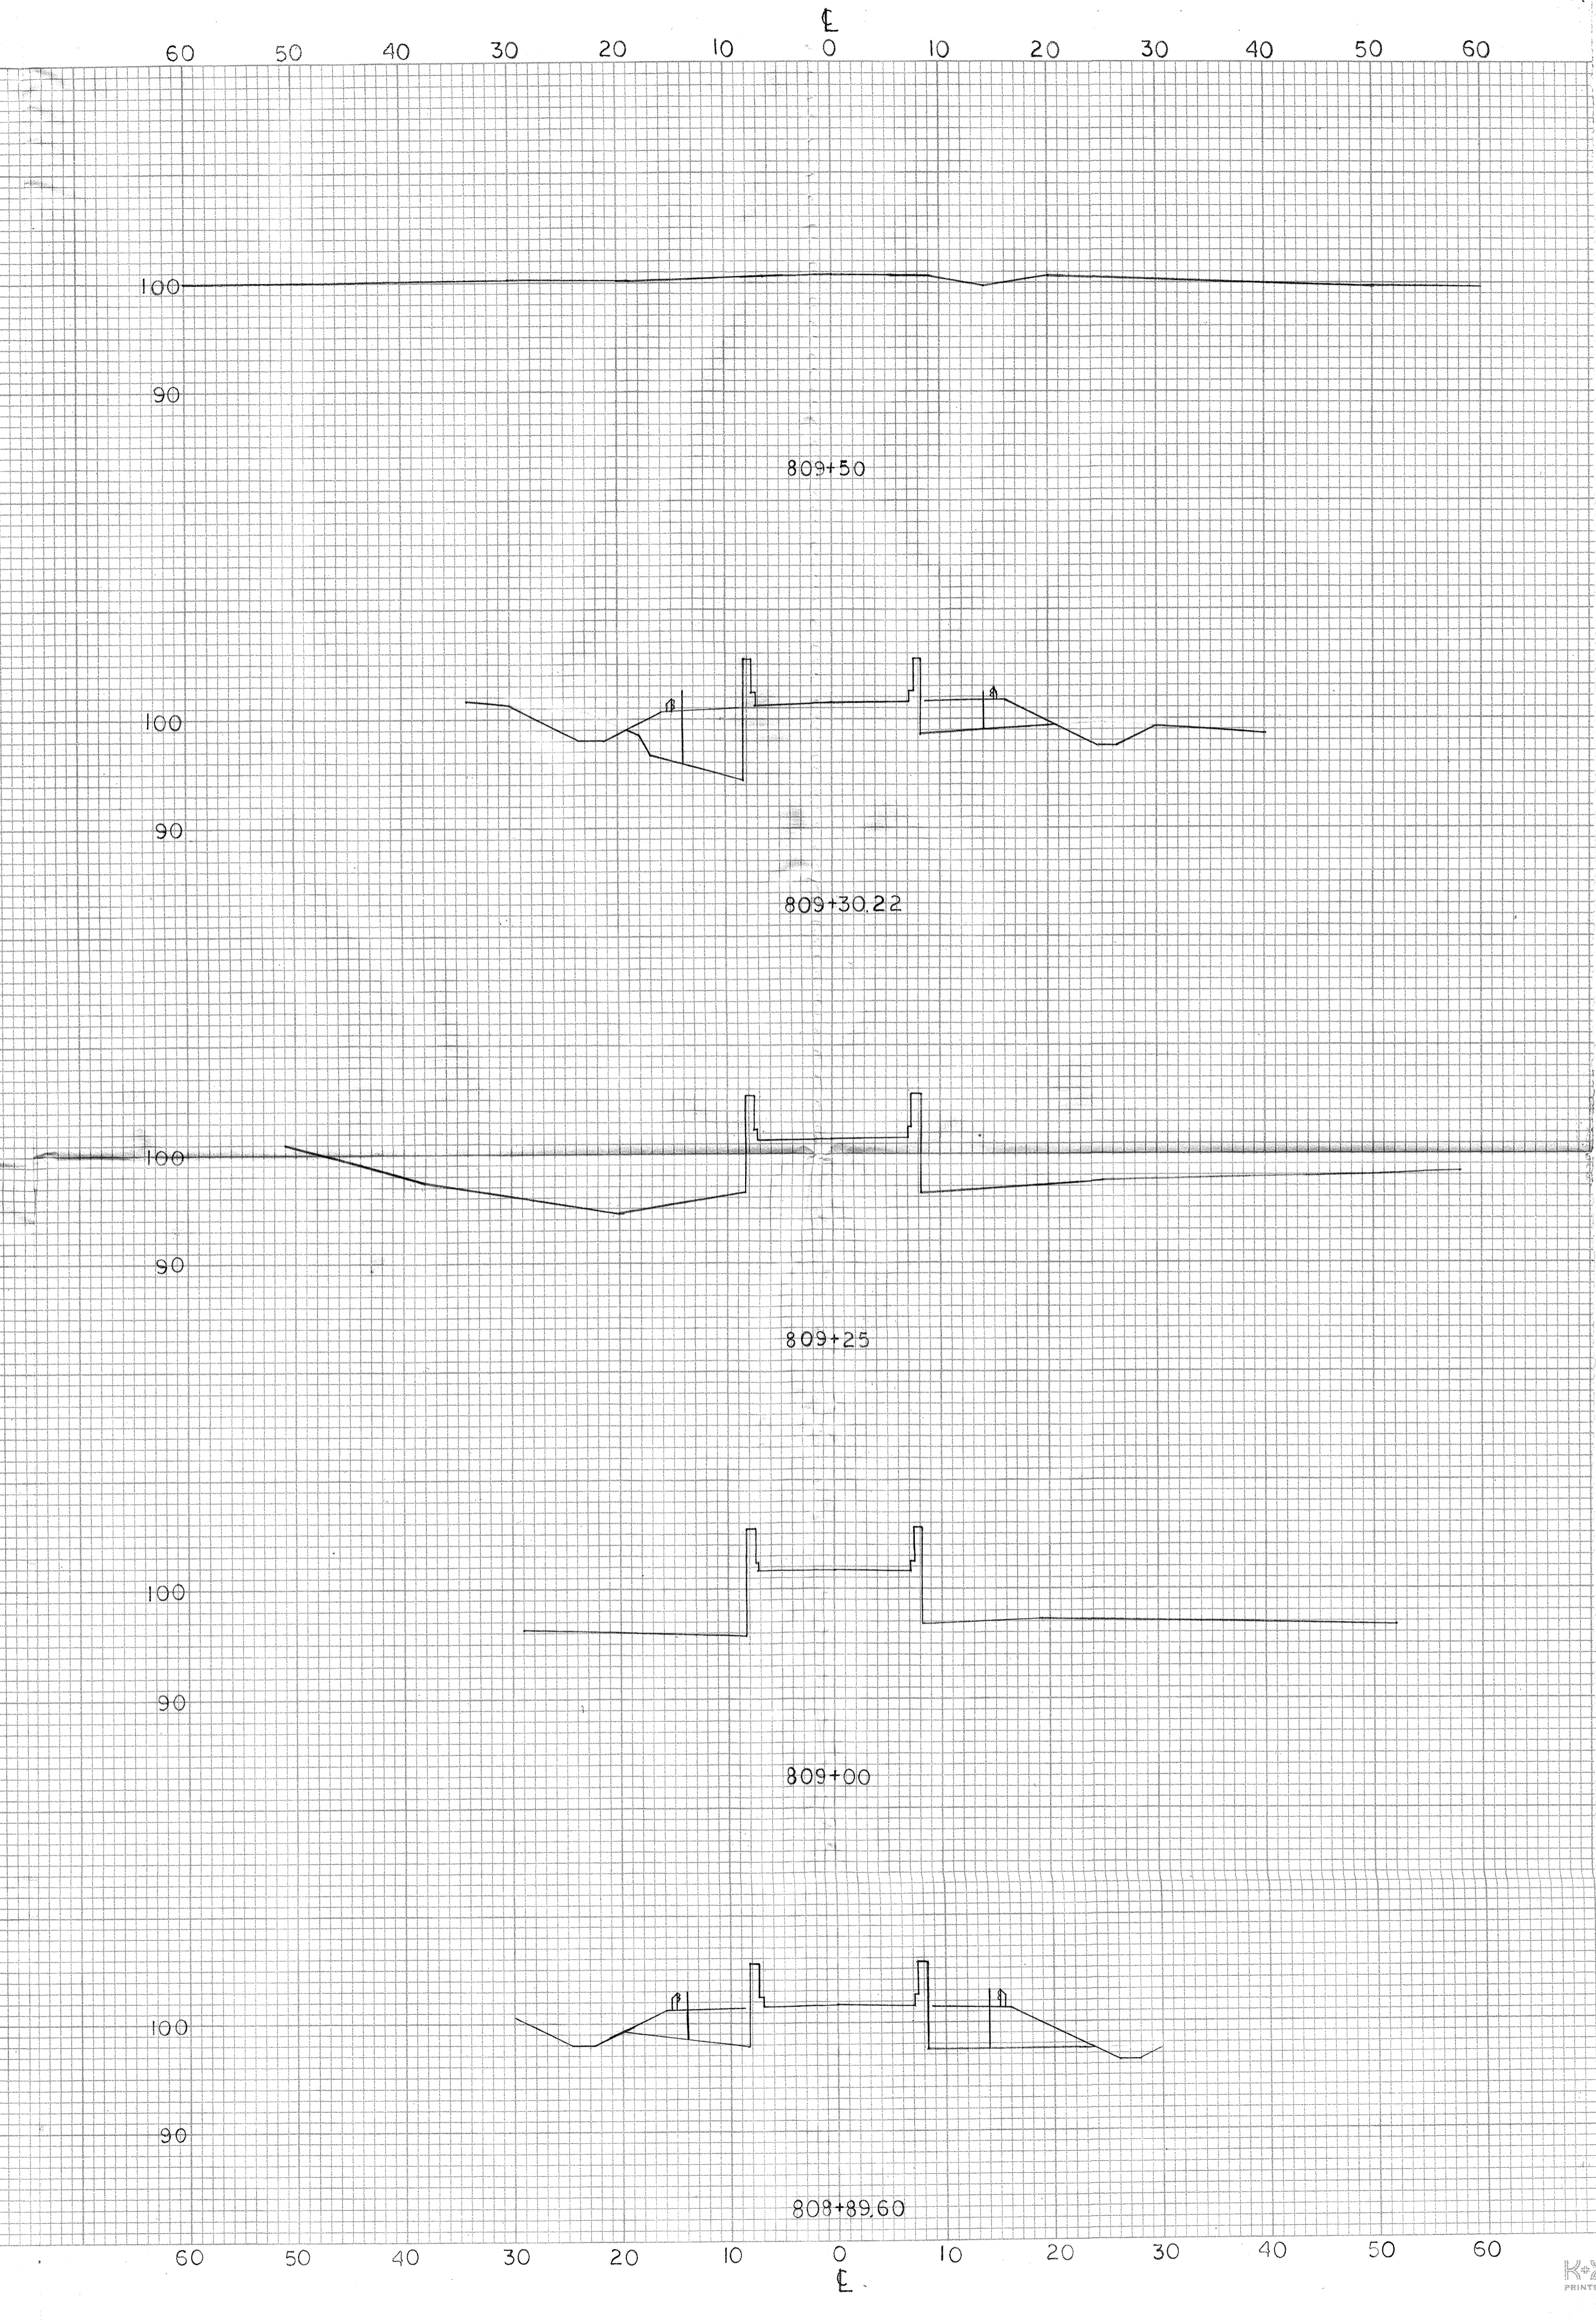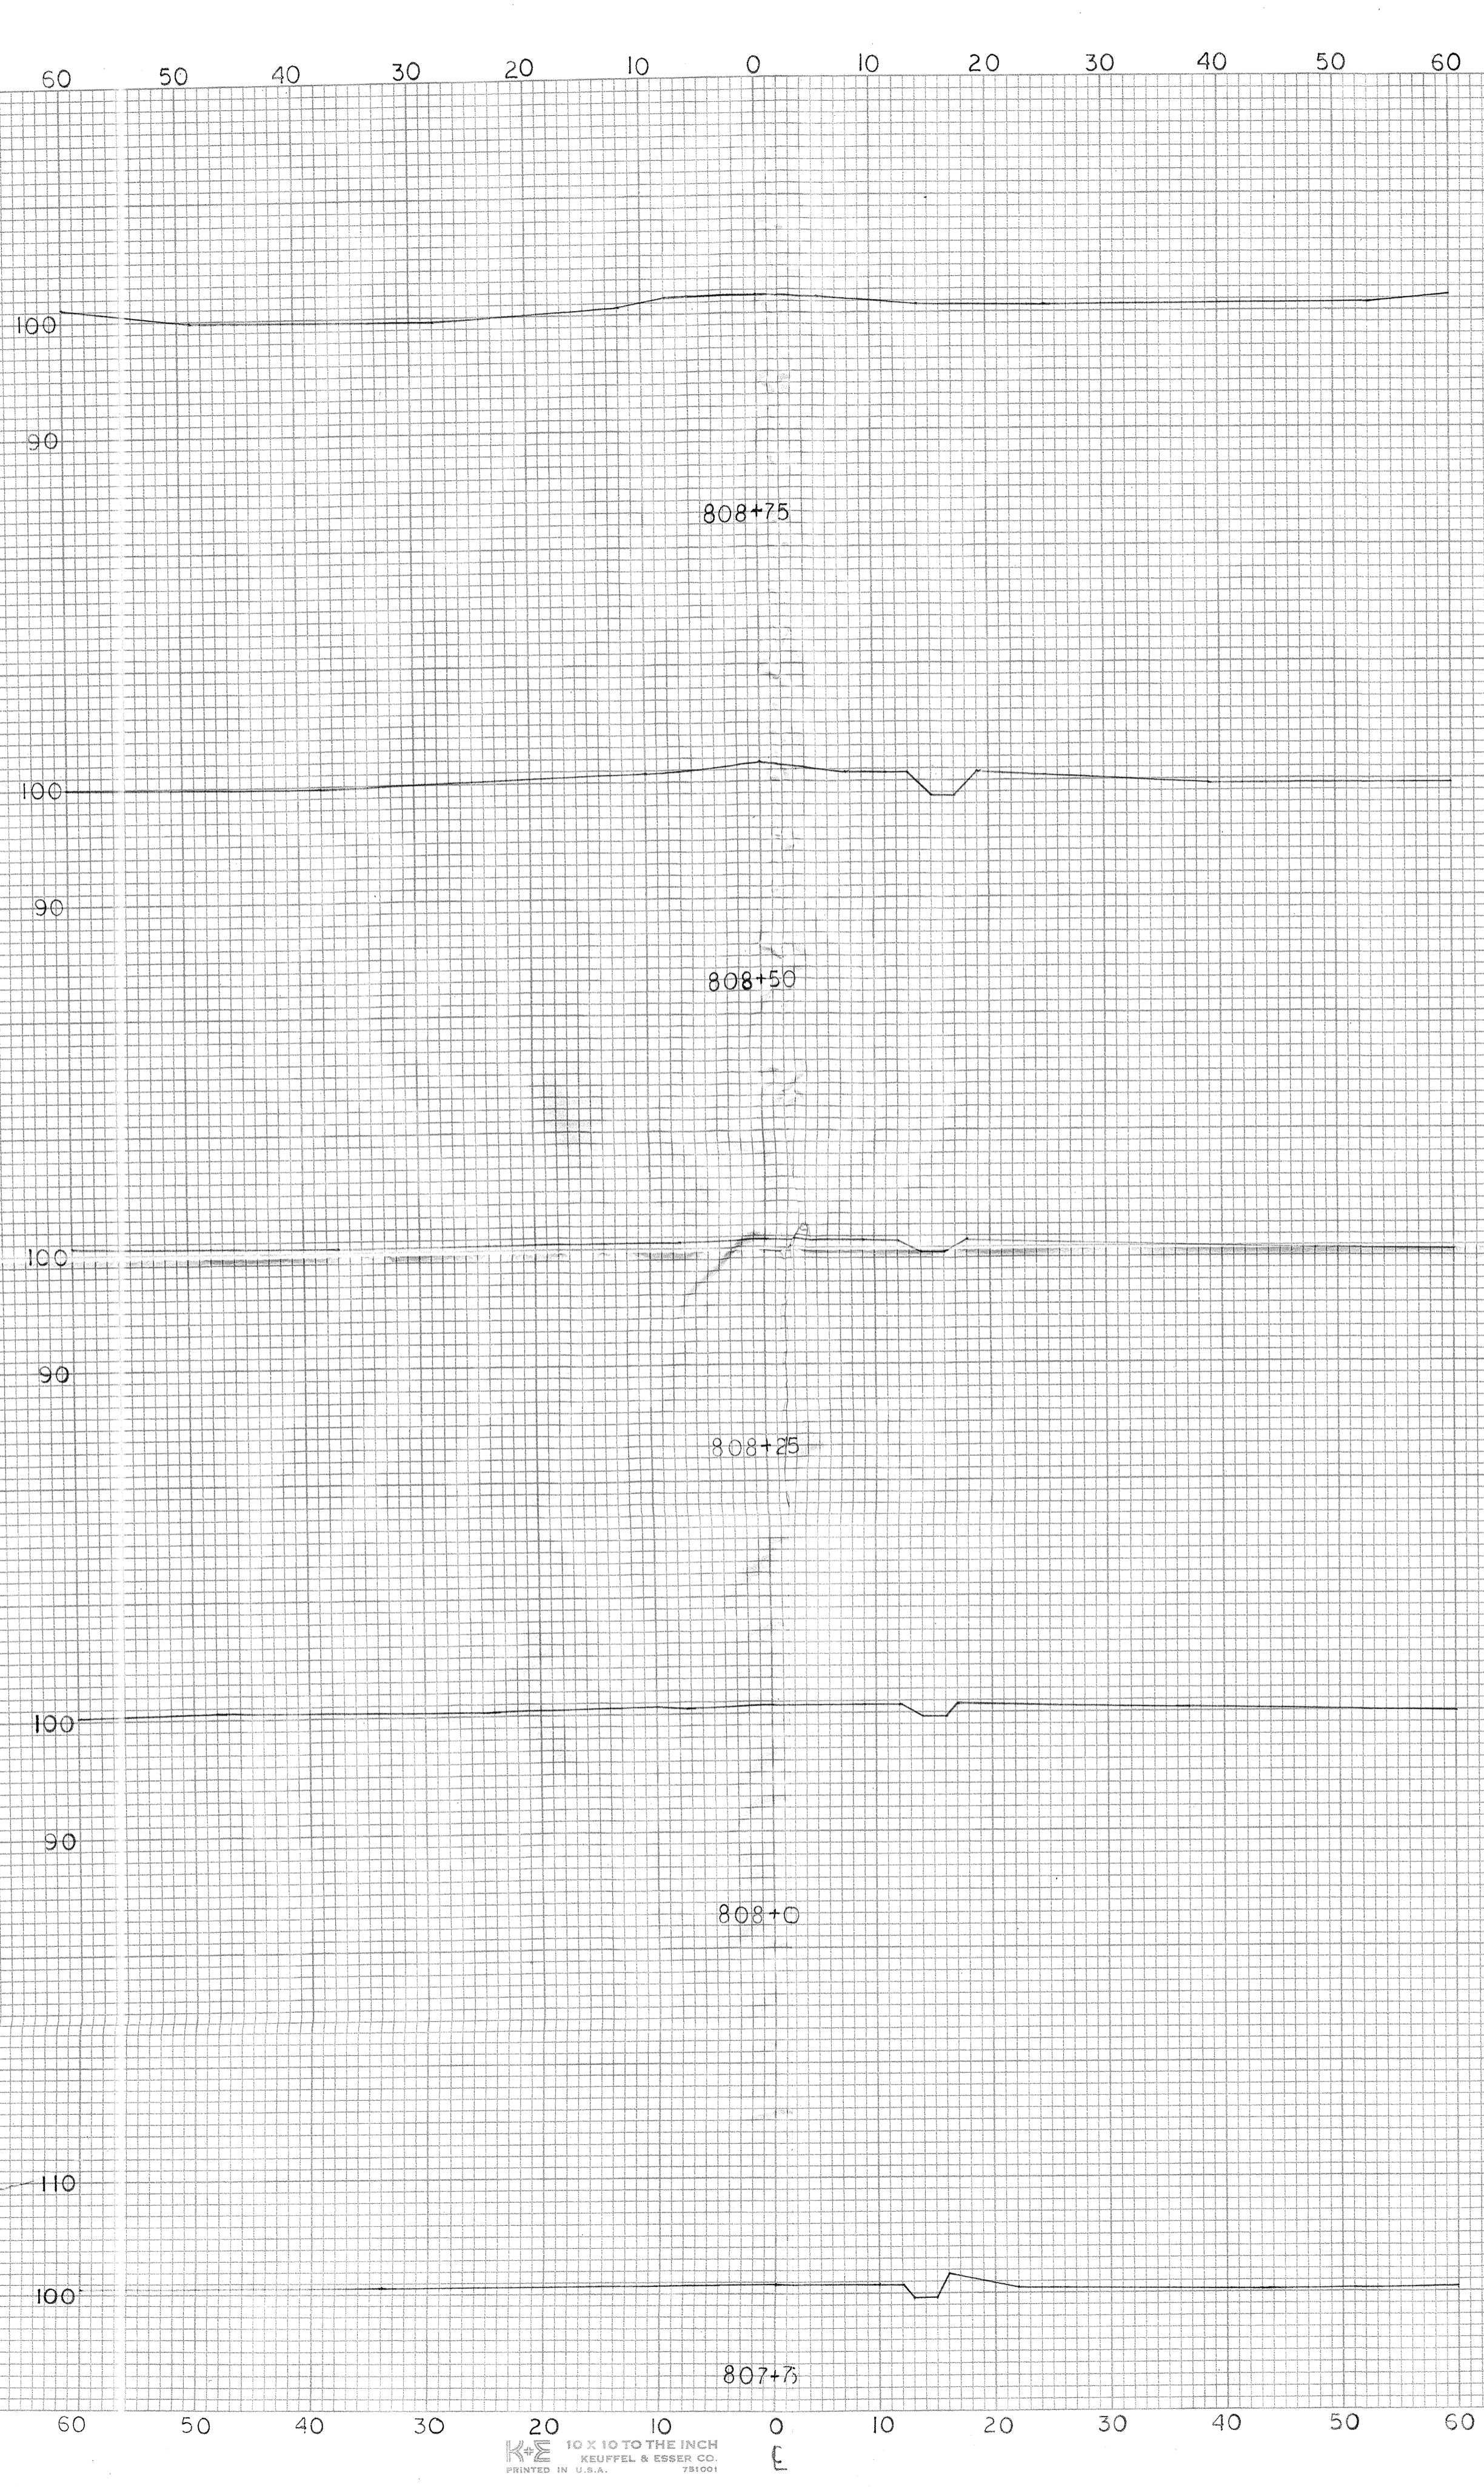

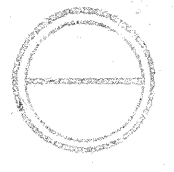

1" = 2'
4.5
25 SHEETS
 $\frac{1}{X} = \frac{2}{4.5}$
2X = 4.5

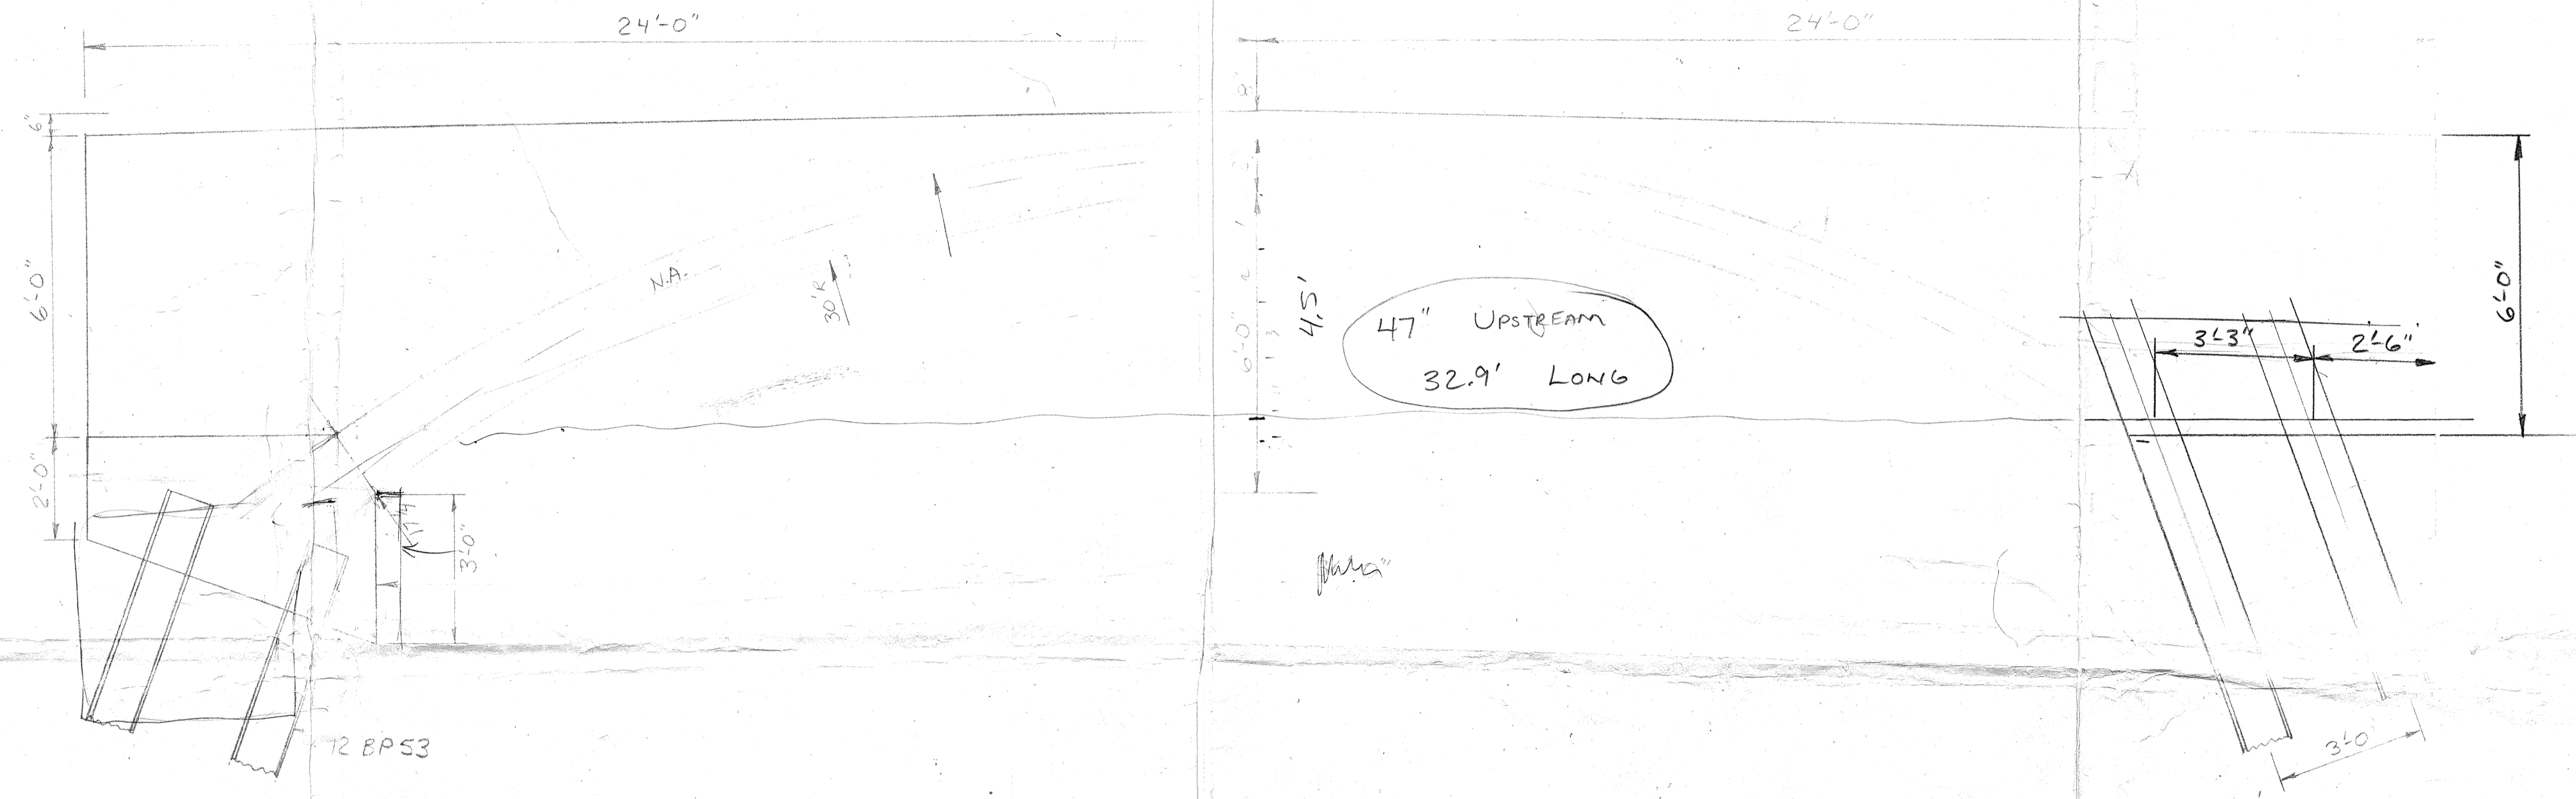

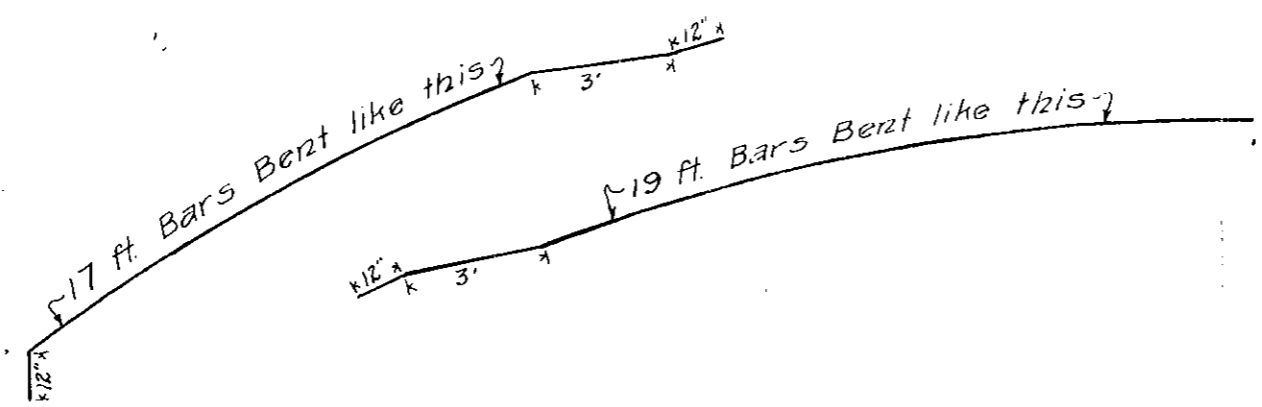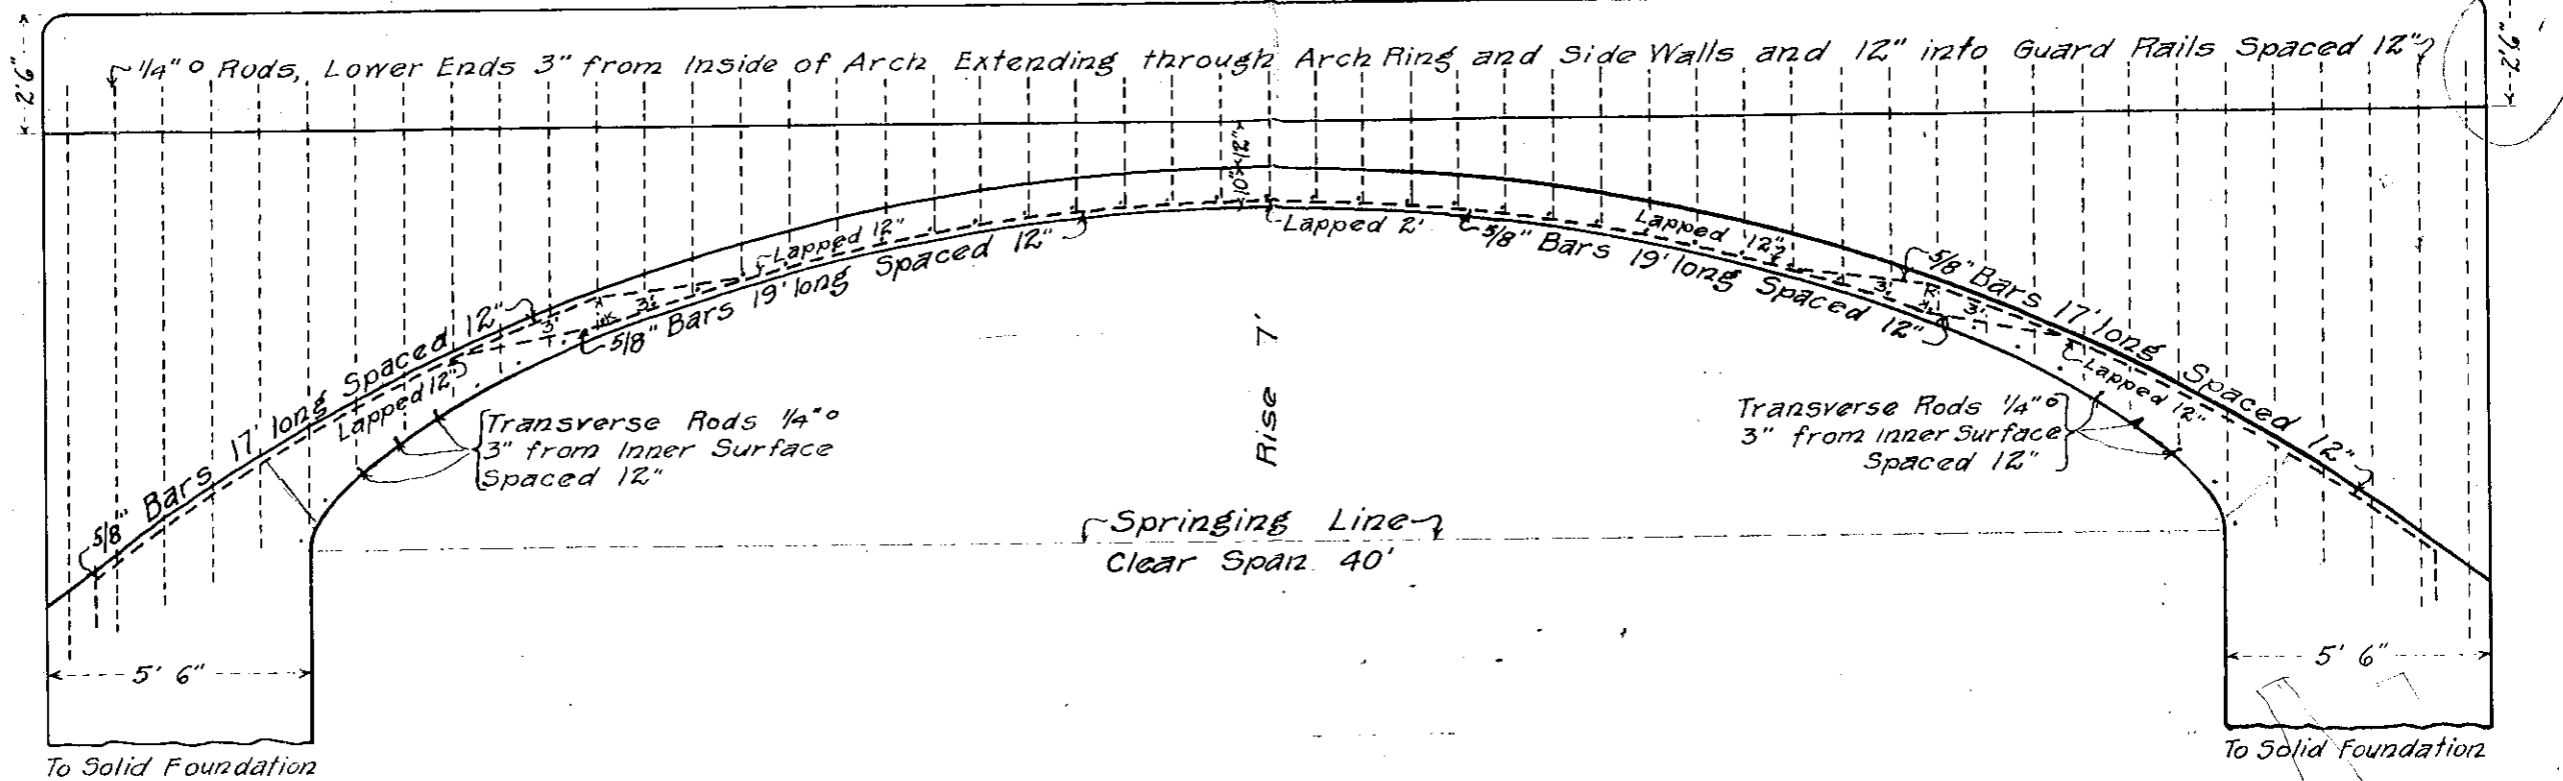

- 68 5/8" Twisted Lug Bars 19 ft. long
- 68 5/8" " " " 17 " "

PLAN OF CONCRETE BRIDGES
OVER