

PAGE 1

BUCKEYE REC

BLUE: Remove

RED: Construction

GREEN: Existing

RECEIVED
JUL 18 2024
ODOT DISTRICT 9
PLANNING & ENGINEERING

(VBF) DENOTES LOCATION OF VEGETATED BIOFILTER

QUANTITIES ARE INCLUDED IN REFERENCE NUMBER I-R FOR THE REMOVAL OF EXISTING PAVEMENT, REGRADING TO ENSURE A DRAINABLE SURFACE AND SEEDING AND MULCHING OF THE AREA SHOWN.

ROCK CHANNEL PROTECTION,
TYPE C WITH FILTER
(156' x 12.5' x 1.5' / 27 = 108.33 CY)

SEEDING AND EROSION CONTROL
WITH TURF REINFORCING MAT, TYPE T
(250' x 14.5' / 9 = 402.78 SY)

DITCH EROSION PROTECTION (VBF)
(582' x 14.5' / 9 = 837.67 SY)

ROCK CHANNEL PROTECTION,
TYPE C WITH FILTER
(56' x 9' x 1.5' / 27 = 28 CY)

Location 1
STA 175+00 @ 26' LT
Remove BREC Pole 51AY17
and Spans

Location 2
STA 177+01 @ 5' RT
Remove BREC Pole 51AY16
and Spans

Location 3
STA 178+50 @ 31' LT
Remove BREC Pole 51AY15
and Spans

Location 4
STA 180+37 @ 68' LT
Remove BREC Pole 51AY14
and Spans

Location 5
STA 181+90 @ 86' LT
Remove BREC Pole 51AY13
and Spans

Location 6
STA 179+47 @ 123' RT
Remove BREC Pole
51AY15-1 and Spans

Location 7
STA 182+18 @ 203' RT


(LF) DESIGNATES
LEACH FIELD

U:\173608714\LA\75923\roadway\sheet\75923GP006-2.A.dgn 3/23/2023 11:05:30 AM SLParker

PLAN - S.R. 7
STA. 171+00 TO STA. 183+00

LAW-7-2.17

33
297

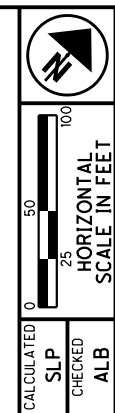


CALCULATED SLP CHECKED ALB

PLAN - S.R. 7
STA. 183+00 TO STA. 195+00

LAW-7-72.17

35
297

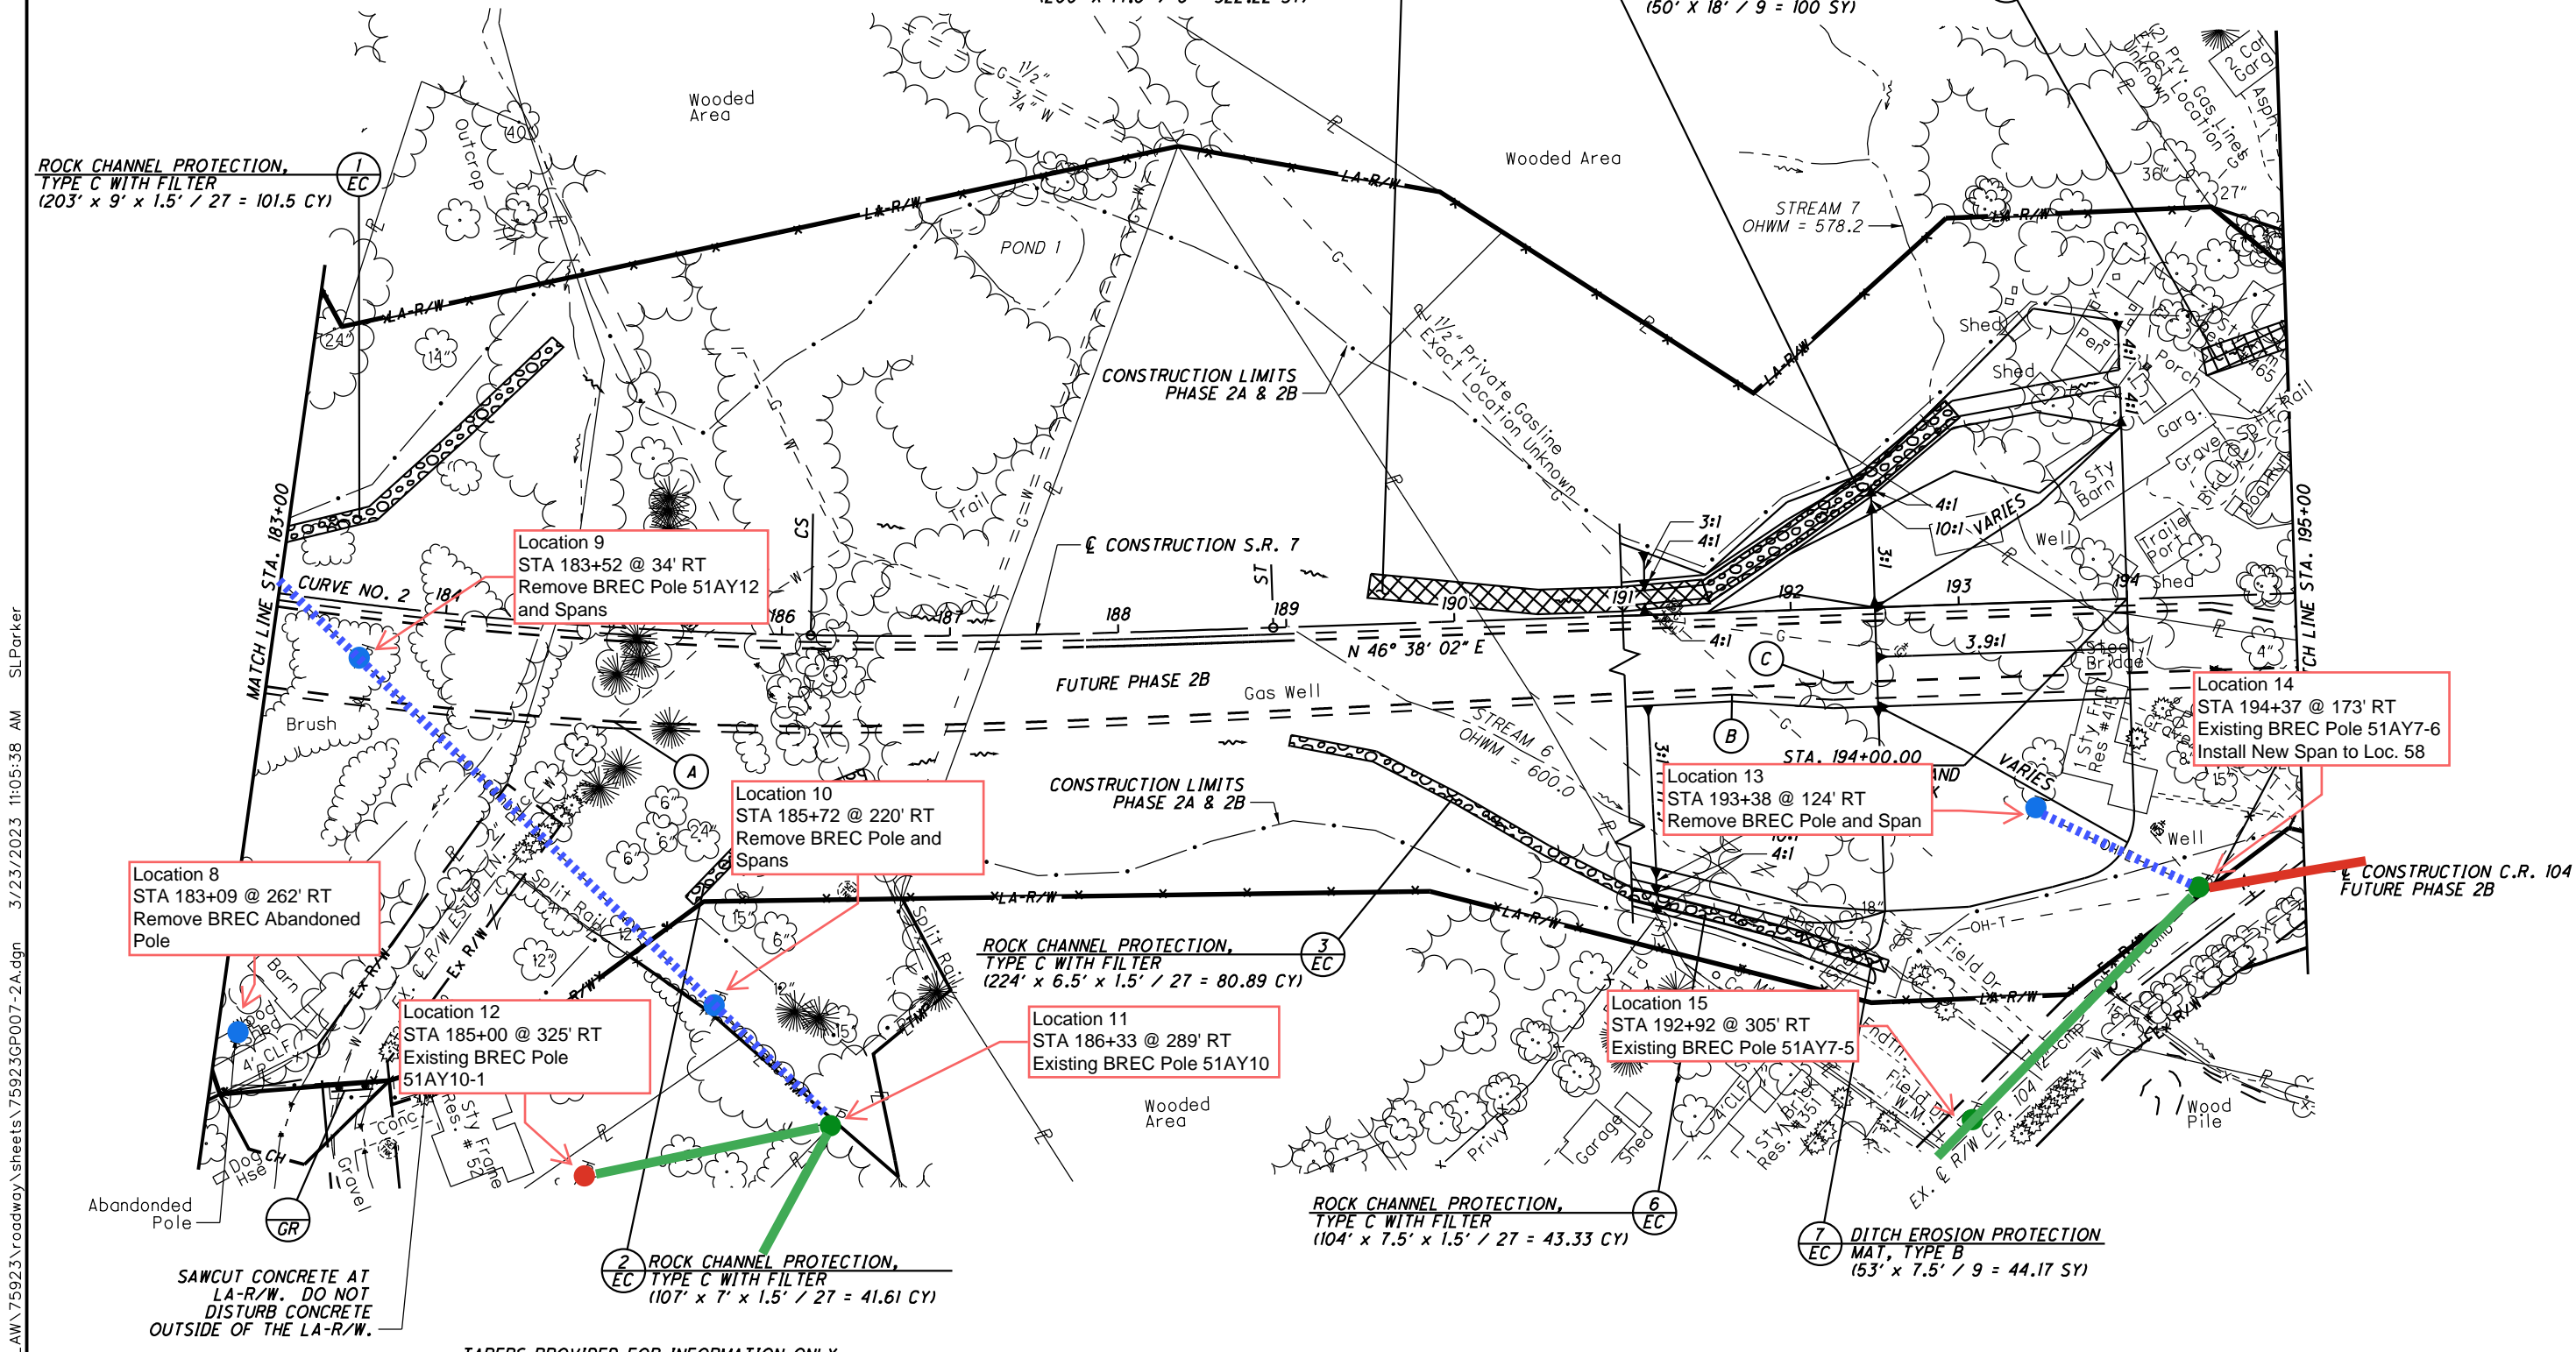

ROCK CHANNEL PROTECTION,
TYPE C WITH FILTER
(203' x 9' x 1.5' / 27 = 101.5 CY)

ROCK CHANNEL PROTECTION,
TYPE B WITH FILTER
(150' x 13' x 2.5' / 27 = 180.56 CY)

SEEDING AND EROSION CONTROL WITH
TURF REINFORCING MAT, TYPE 2
(200' x 14.5' / 9 = 322.22 SY)

SEEDING AND EROSION CONTROL
WITH TURF REINFORCING MAT, TYPE 2

Location 9
STA 183+52 @ 34' RT
Remove BREC Pole 51AY12
and Spans

Location 8
STA 183+09 @ 262' RT
Remove BREC Abandoned
Pole

Location 10
STA 185+72 @ 220' RT
Remove BREC Pole and
Spans

Location 12
STA 185+00 @ 325' RT
Existing BREC Pole
51AY10-1

Location 11
STA 186+33 @ 289' RT
Existing BREC Pole 51AY10

Location 15
STA 192+92 @ 305' RT
Existing BREC Pole 51AY7-5

Location 14
STA 194+37 @ 173' RT
Existing BREC Pole 51AY7-6
Install New Span to Loc. 58

Location 13
STA 193+38 @ 124' RT
Remove BREC Pole and Span

CONSTRUCTION C.R. 104
FUTURE PHASE 2B

SAWCUT CONCRETE AT
LA-R/W. DO NOT
DISTURB CONCRETE
OUTSIDE OF THE LA-R/W.

ROCK CHANNEL PROTECTION,
TYPE C WITH FILTER
(107' x 7' x 1.5' / 27 = 41.61 CY)

ROCK CHANNEL PROTECTION,
TYPE C WITH FILTER
(224' x 6.5' x 1.5' / 27 = 80.89 CY)

ROCK CHANNEL PROTECTION,
TYPE C WITH FILTER
(104' x 7.5' x 1.5' / 27 = 43.33 CY)

DITCH EROSION PROTECTION
MAT, TYPE B
(53' x 7.5' / 9 = 44.17 SY)

TAPERS PROVIDED FOR INFORMATION ONLY

(A) - STA. 185+03.46
BEGIN PAVEMENT TAPER, 56' RT.

(B) - STA. 191+63.46
BEGIN SHOULDER TAPER, 49' RT.

(C) - STA. 192+23.46
END PAVEMENT TAPER, 44' RT.
END SHOULDER TAPER, 54' RT.

FOR PROFILE, SEE SHEET 36

U:\173608714\LAW\759233\roadway_sheets\759233\007-2A.dgn 3/23/2023 11:05:38 AM SLParker

- 2 ARTICULATING CONCRETE BLOCK REVETMENT SYSTEM, TYPE 1 (30' X 9' / 9 = 30 SY)
- 3 SEEDING AND EROSION CONTROL WITH TURF REINFORCING MAT, TYPE 2 (255' X 14.5' / 9 = 410.83 SY)




PLAN - S.R. 7
 STA. 195+00 TO STA. 207+00

LAW-7-2.17

37
 297

U:\173608714\LAW\75923\roadway_sheets\75923GP008-2A.dgn 3/23/2023 11:05:52 AM SLParker

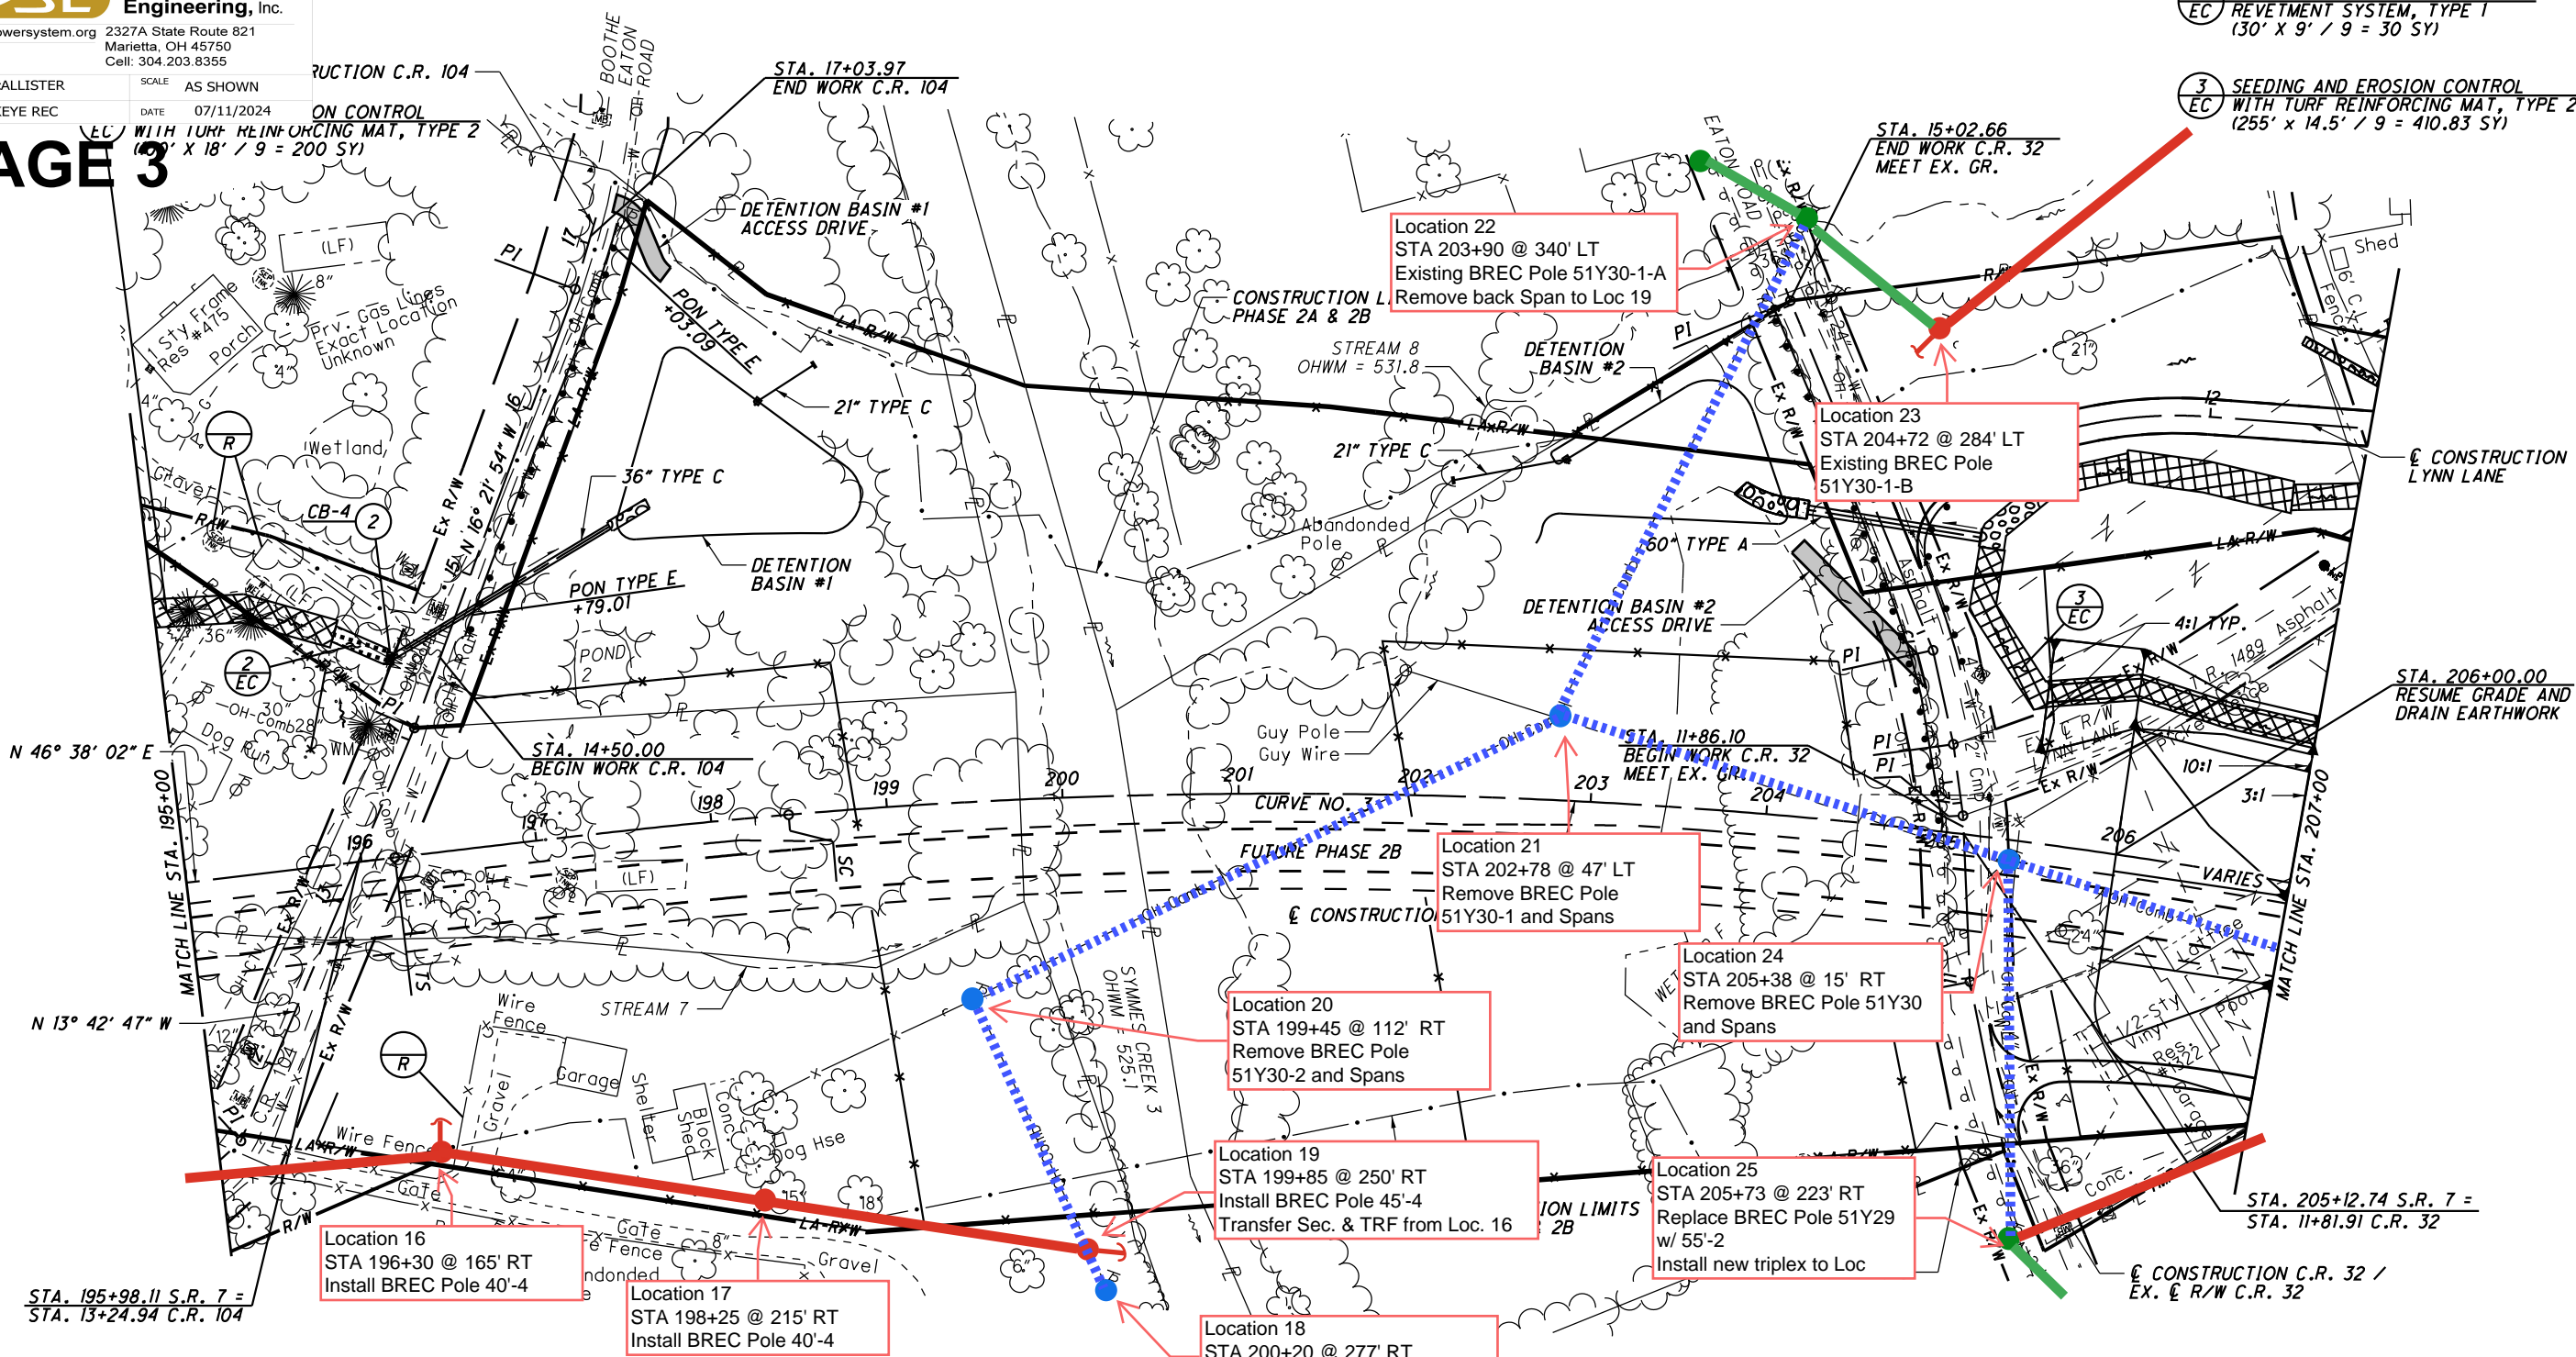

CURVE DATA
 S.R. 7
 CURVE NO. 3

P.I. STA. 205+33.31	θs = 1° 58' 07"
Δ = 27° 30' 45" (RT)	Ls = 225.00'
Dc = 1° 45' 00"	Ts = 914.18'
R = 3,274.04'	LT = 150.01'
T = 683.24'	ST = 75.01'
L = 1,347.14'	e _{max} = 4.60%
E = 70.53'	CS STA. 211+91.27
TS STA. 196+19.13	ST STA. 214+16.27
SC STA. 198+44.13	

C.R. 104

P.I. STA. 11+53.11	P.I. STA. 12+33.35
Δ = 2° 41' 45"	Δ = 4° 36' 08"
NO CURVE	NO CURVE
P.I. STA. 14+07.46	P.I. STA. 12+87.96
Δ = 2° 39' 07"	Δ = 9° 55' 50"
NO CURVE	NO CURVE
P.I. STA. 16+72.90	P.I. STA. 15+02.34
Δ = 4° 02' 33"	Δ = 0° 49' 53"
NO CURVE	NO CURVE

C.R. 32


P.I. STA. 10+98.09
Δ = 9° 00' 49"
NO CURVE
P.I. STA. 11+92.44
Δ = 5° 16' 18"
NO CURVE

(LF) DESIGNATES LEACH FIELD

FOR PROFILE, SEE SHEET 38
 FOR LYNN LANE PLAN AND PROFILE, SEE SHEET 249
 FOR CULVERT DETAIL, SEE SHEET 279
 FOR STORM SEWER PROFILES, SEE SHEET 274
 FOR DETENTION BASIN DETAILS, SEE SHEETS 292-294

DWN BY P. McALLISTER SCALE AS SHOWN 7"
DWN FOR BUCKEYE REC DATE 07/11/2024

PAGE 4

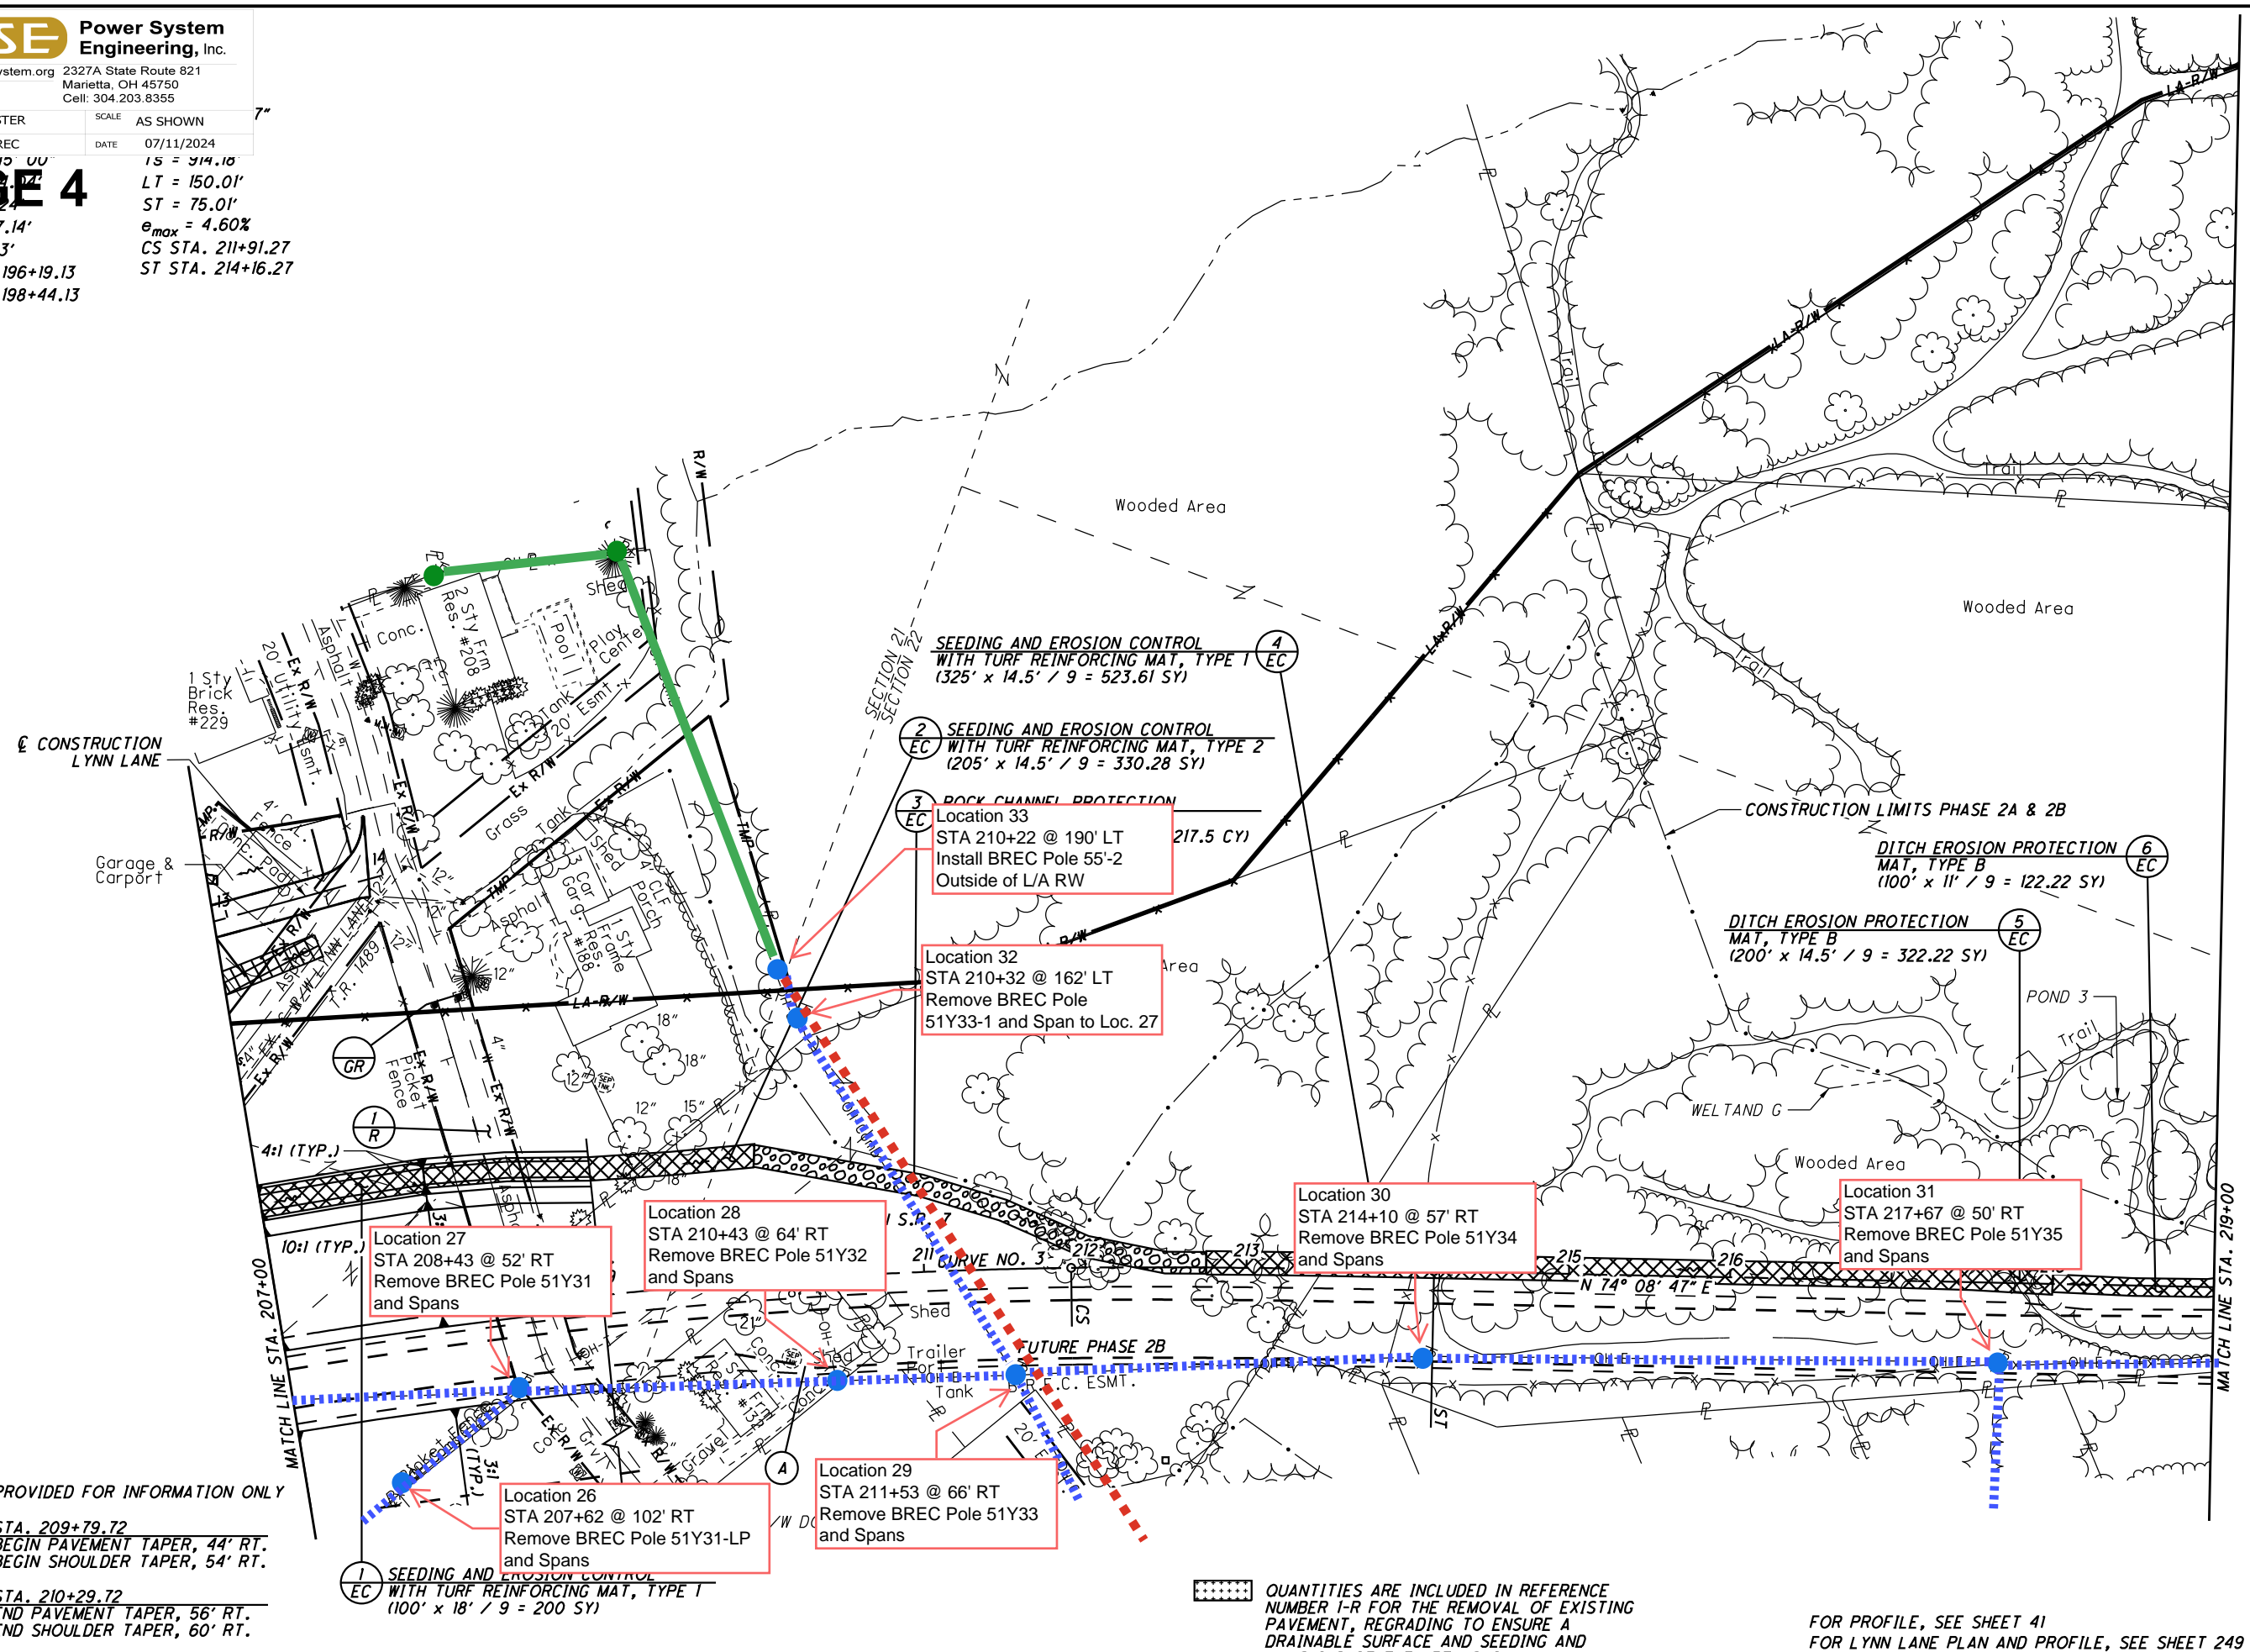

TAPERS PROVIDED FOR INFORMATION ONLY
 STA. 209+79.72
 BEGIN PAVEMENT TAPER, 44' RT.
 BEGIN SHOULDER TAPER, 54' RT.
 STA. 210+29.72
 END PAVEMENT TAPER, 56' RT.
 END SHOULDER TAPER, 60' RT.

1 SEEDING AND EROSION CONTROL WITH TURF REINFORCING MAT, TYPE 1 (100' x 18' / 9 = 200 SY)

4 SEEDING AND EROSION CONTROL WITH TURF REINFORCING MAT, TYPE 1 (325' x 14.5' / 9 = 523.61 SY)

2 SEEDING AND EROSION CONTROL WITH TURF REINFORCING MAT, TYPE 2 (205' x 14.5' / 9 = 330.28 SY)

3 ROCK CHANNEL PROTECTION Location 33 STA 210+22 @ 190' LT Install BREC Pole 55'-2 Outside of L/A RW 217.5 CY

Location 32 STA 210+32 @ 162' LT Remove BREC Pole 51Y33-1 and Span to Loc. 27

6 DITCH EROSION PROTECTION MAT, TYPE B (100' x 11' / 9 = 122.22 SY)

5 DITCH EROSION PROTECTION MAT, TYPE B (200' x 14.5' / 9 = 322.22 SY)

Location 27 STA 208+43 @ 52' RT Remove BREC Pole 51Y31 and Spans

Location 28 STA 210+43 @ 64' RT Remove BREC Pole 51Y32 and Spans

Location 30 STA 214+10 @ 57' RT Remove BREC Pole 51Y34 and Spans

Location 31 STA 217+67 @ 50' RT Remove BREC Pole 51Y35 and Spans


Location 26 STA 207+62 @ 102' RT Remove BREC Pole 51Y31-LP and Spans

Location 29 STA 211+53 @ 66' RT Remove BREC Pole 51Y33 and Spans

QUANTITIES ARE INCLUDED IN REFERENCE NUMBER I-R FOR THE REMOVAL OF EXISTING PAVEMENT, REGADING TO ENSURE A DRAINABLE SURFACE AND SEEDING AND MULCHING OF THE AREA SHOWN.

FOR PROFILE, SEE SHEET 41
FOR LYNN LANE PLAN AND PROFILE, SEE SHEET 249

U:\173608714\LA\75923\roadway_sheets\75923\09-2.dgn 3/23/2023 11:05:59 AM SLParker

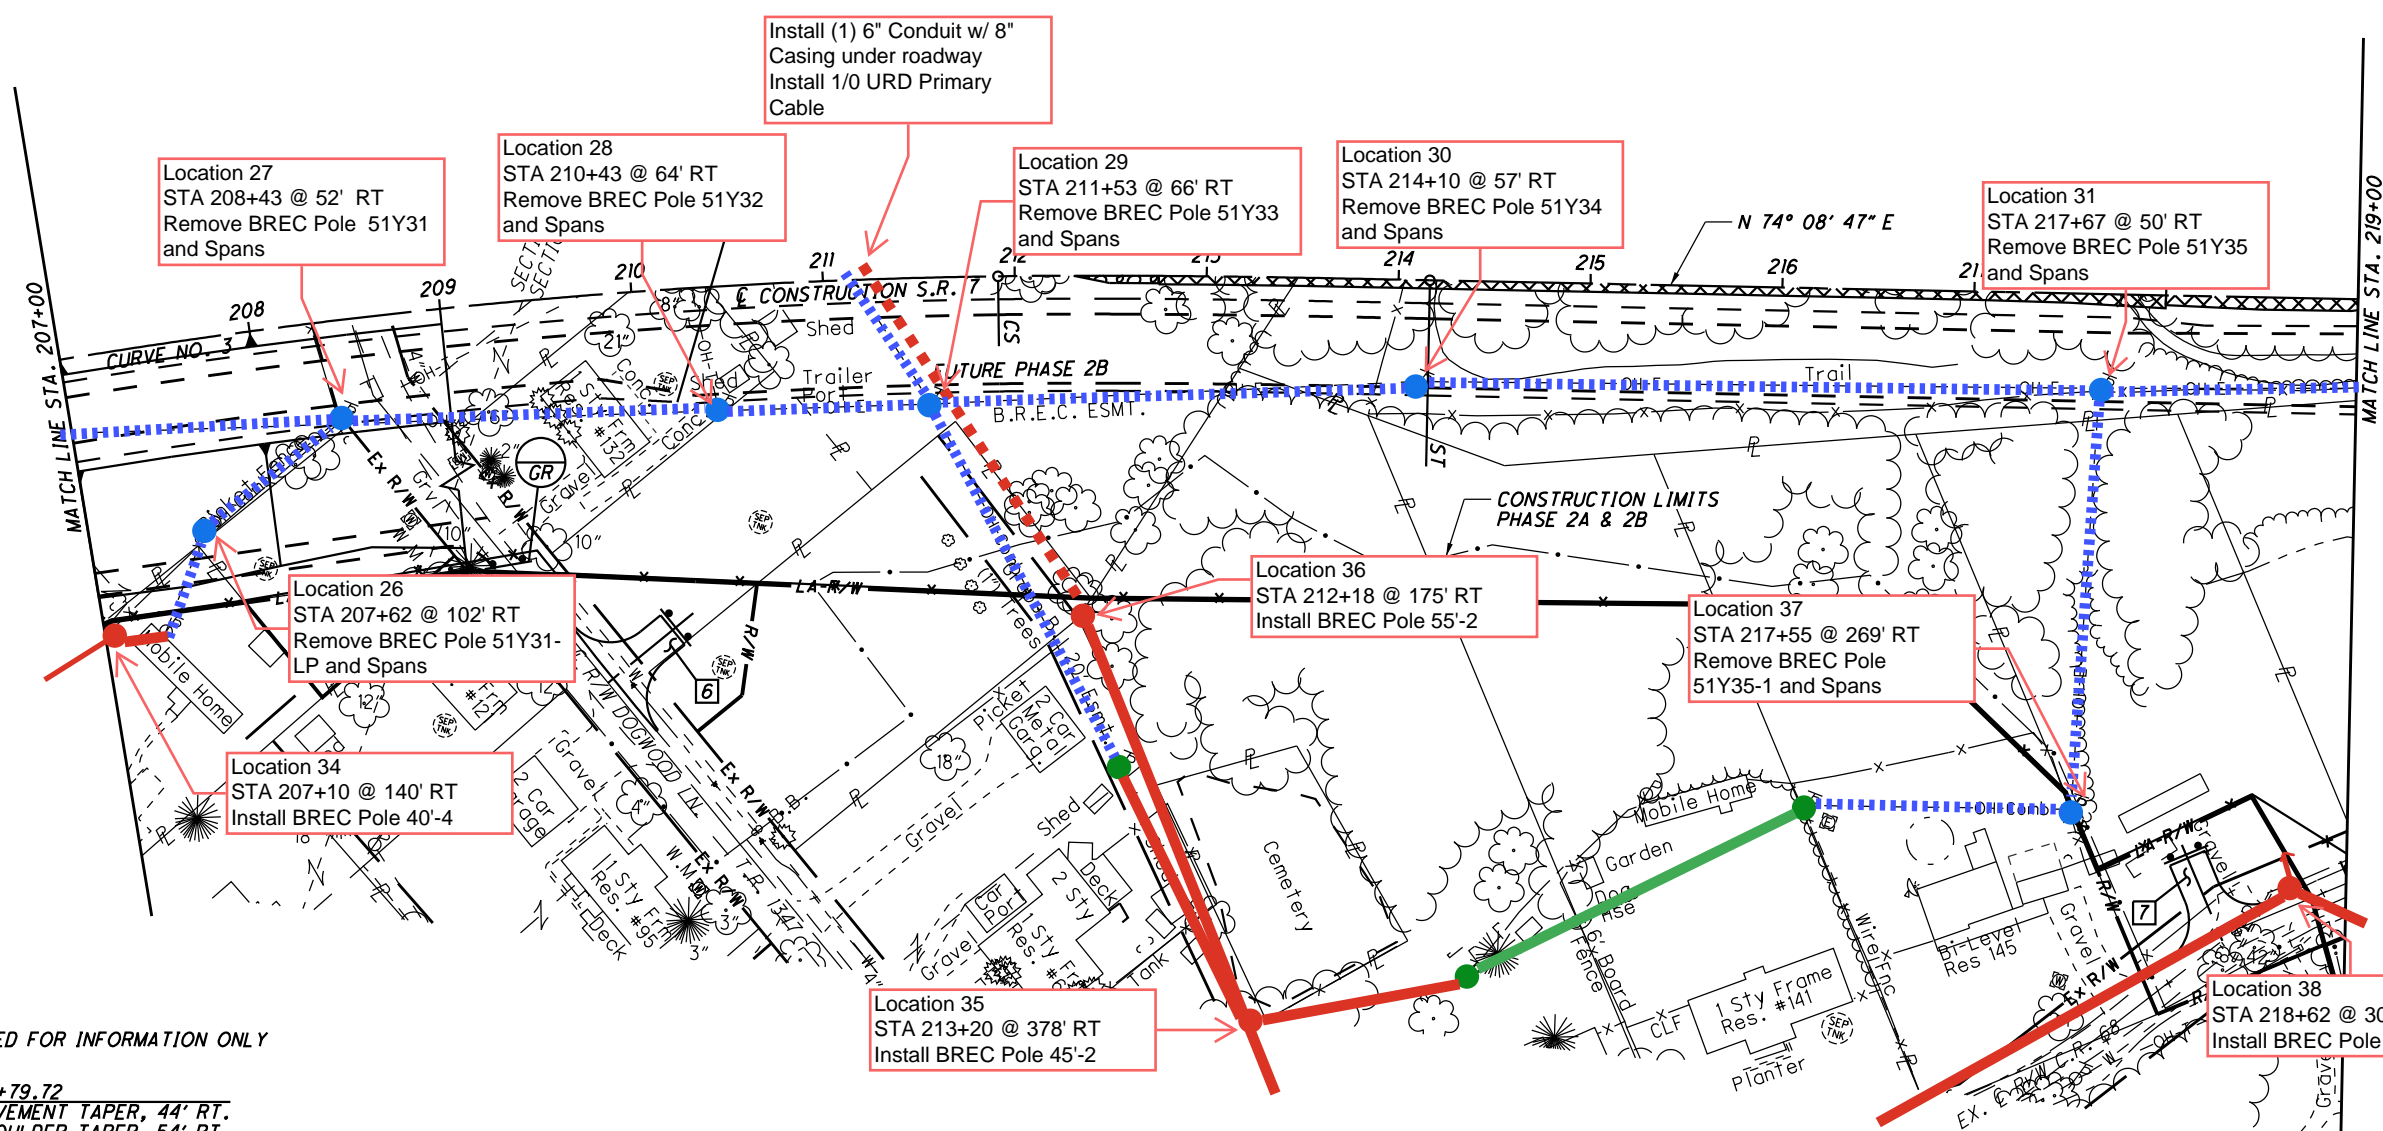

TAPERS PROVIDED FOR INFORMATION ONLY


- STA. 209+79.72
BEGIN PAVEMENT TAPER, 44' RT.
BEGIN SHOULDER TAPER, 54' RT.
- STA. 210+29.72
END PAVEMENT TAPER, 56' RT.
END SHOULDER TAPER, 60' RT.

U:\17360874\LAW\75923\roadway_sheets\75923\009A-2A.dgn 3/23/2023 11:06:02 AM SLParker

LAWRENCE COUNTY
UNION TOWNSHIP
SECT. 21 & 22, T-1-N, R-16-W

FOR LOCATION AND TYPE OF LA-R/W FENCE
SEE THE TABLE IN THE ROADWAY PLAN

PAGE 6

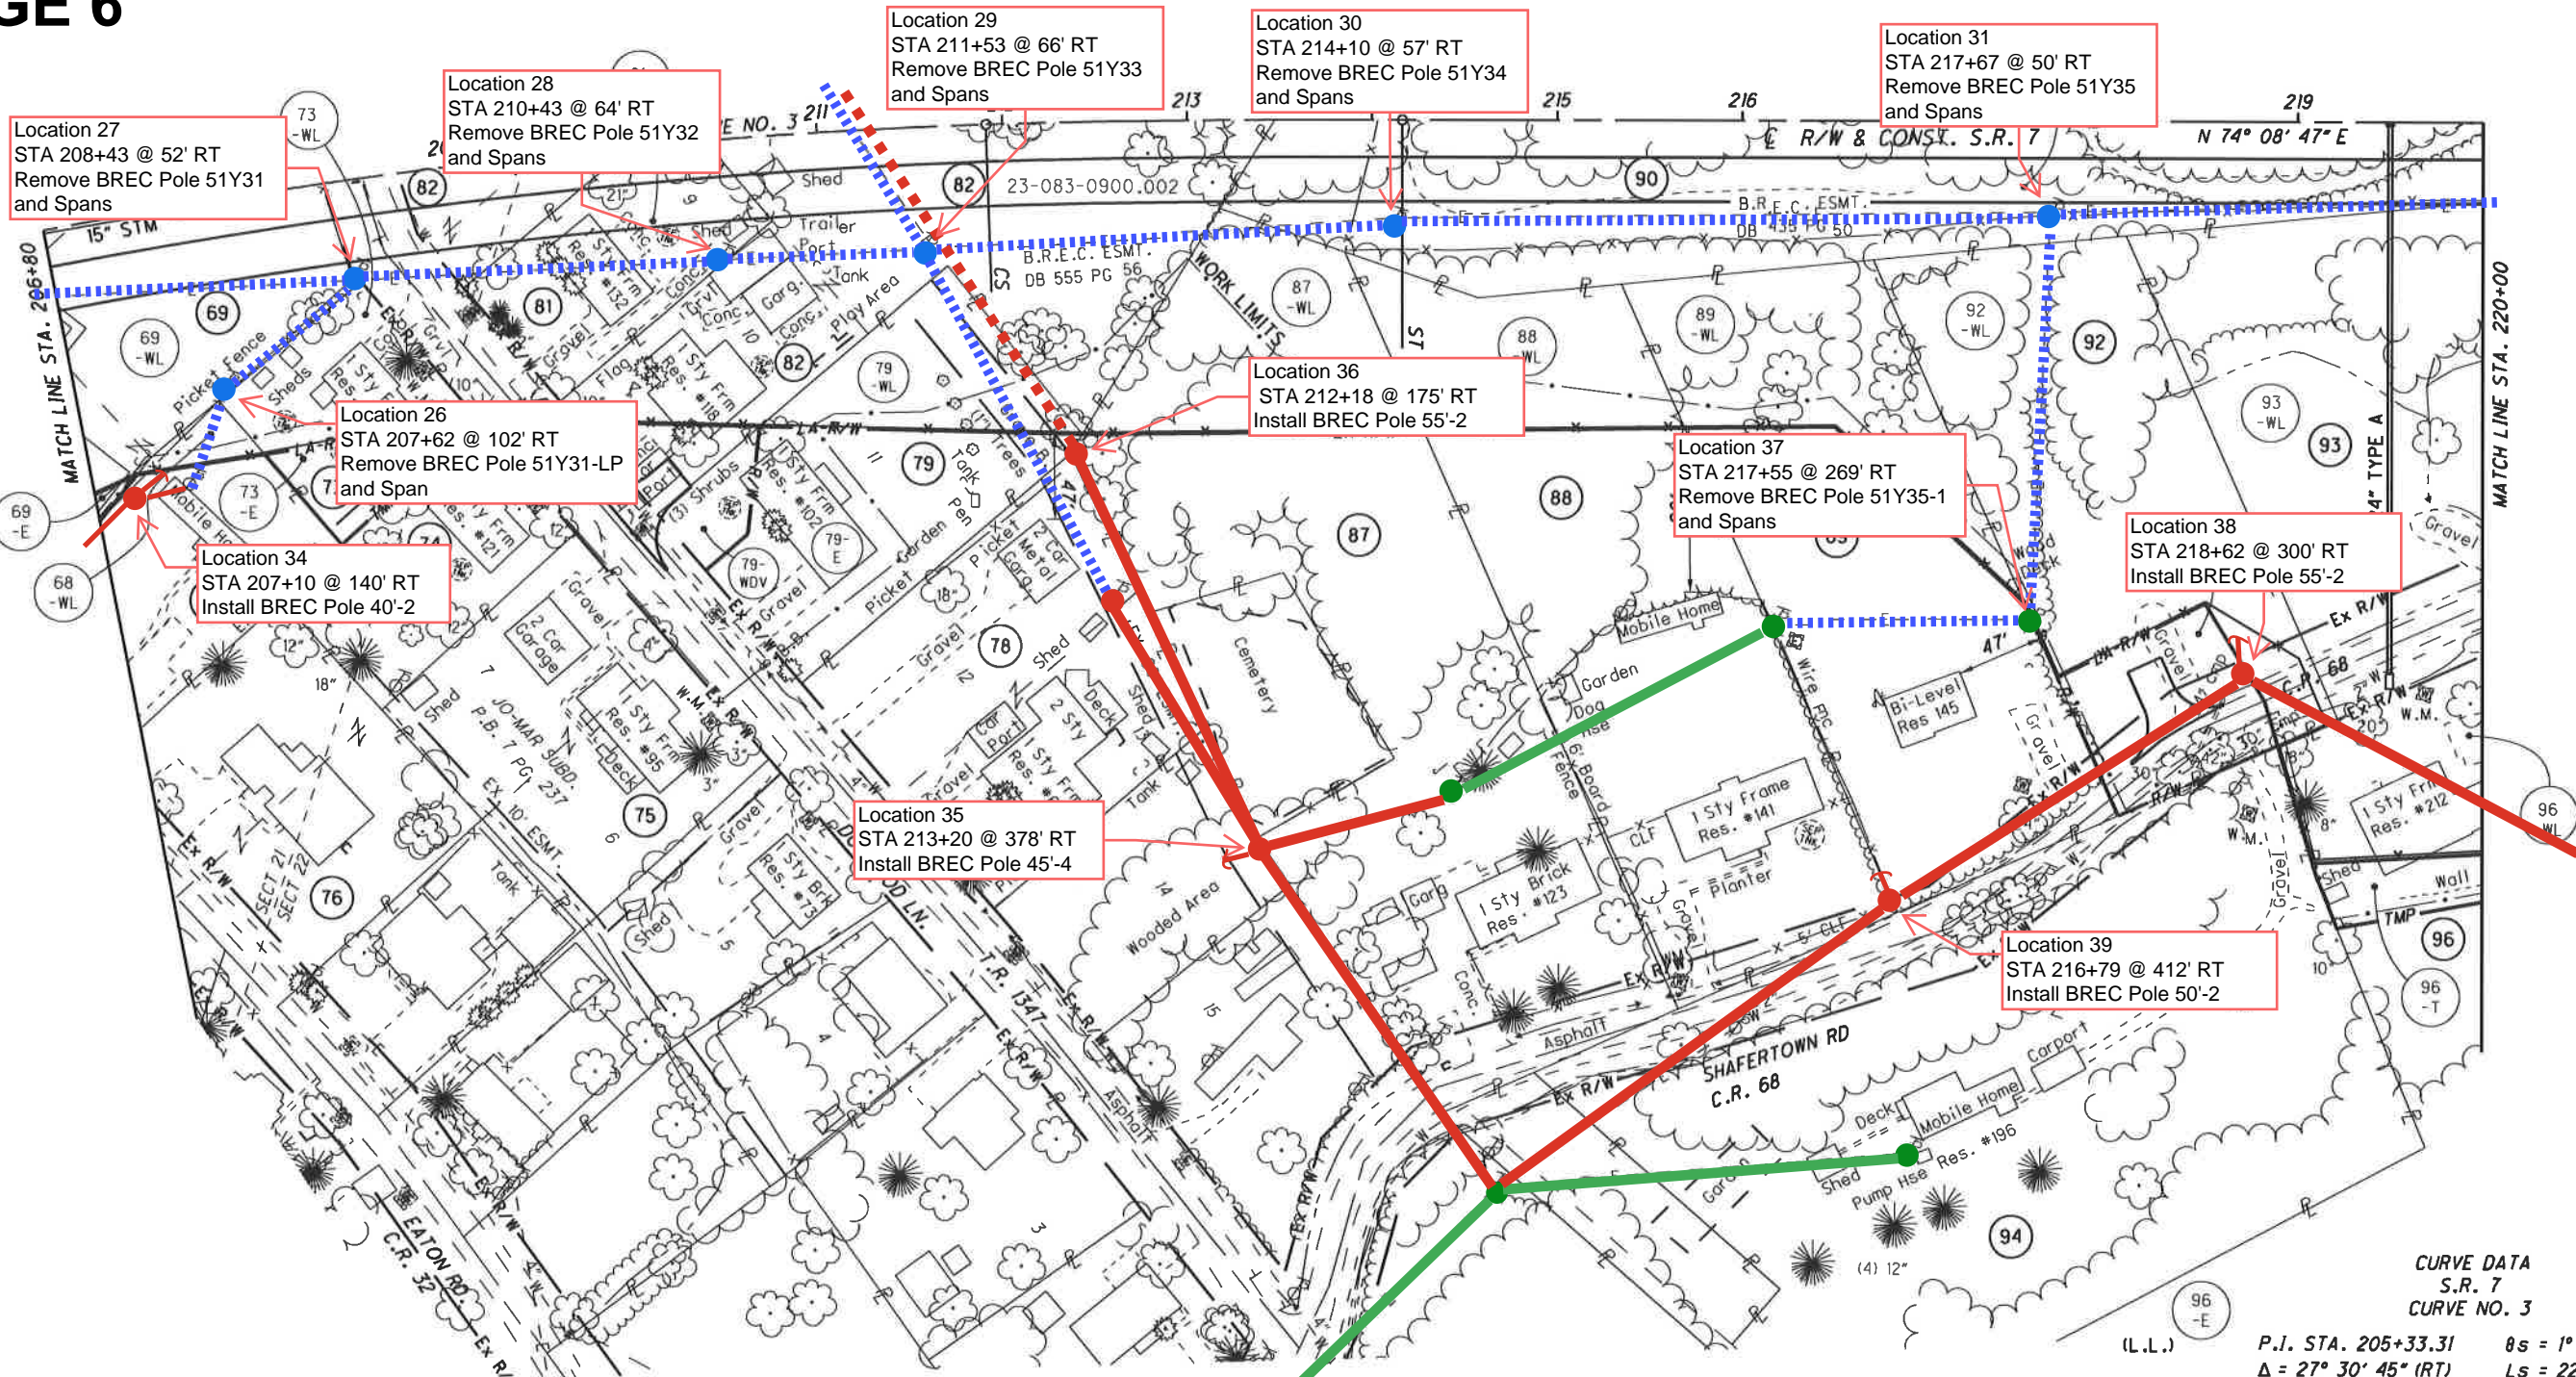

- | | | | |
|----------------------------------|--------------------------------|---|--------------------------------|
| 68 WALTER L. PLUMLEY | 76 KAREN EVANS | 87 JAMES A. MONTGOMERY | 93 JAMES H. & ROSA SMITH |
| 69 WALTER L. & BRENDA H. PLUMLEY | 78 NANCY MCKENZIE | 88 JAMES G. SMITH | 94 CHARLES W. & MAZIE L. RULEN |
| 73 STATE OF OHIO | 79 STATE OF OHIO | 89 FRANCIS JAMES BUDD & BRANDY RENAY BUDD | 96 JASPER & DELLA M. RIGNEY |
| 74 MARY R. SMITH | 81 RAYMOND R. & ALMA J. MCHONE | 90 BILL A. BROWN | |
| 75 DONNA M. ADKINS | 82 STATE OF OHIO | 92 JOHNNY E. & JANIE E. SMITH | |

CURVE DATA
S.R. 7
CURVE NO. 3

P.I. STA. 205+33.31	θs = 1° 58' 07"
Δ = 27° 30' 45" (RT)	Ls = 225.00'
Dc = 1° 45' 00"	Ts = 914.18'
R = 3,274.04'	LT = 150.01'
T = 683.24'	ST = 75.01'
L = 1,347.14'	CS STA. 211+91.27
E = 70.53'	ST STA. 214+16.27
TS STA. 196+19.13	
SC STA. 198+44.13	


(LF) DESIGNATES LEACH FIELD

REV. BY	DATE	DESCRIPTION

PID NO. 75923
 R/W DESIGNER TB
 R/W REVIEWER SER
RIGHT OF WAY TOPO SHEET
STA. 206+80 TO STA. 220+00 (SOUTH)
LAW-7-2.17

U:\173608714\LA75923\row\sheet75923RTO11.dgn 12/9/2014 11:17:18 AM siparker

P.I. STA. 232+01.52	$\theta s = 9^\circ 30' 00''$
$\Delta = 34^\circ 12' 59''$ (LT)	$Ls = 400.00'$
$Dc = 4^\circ 45' 00''$	$Ts = 572.79'$
$R = 1,206.23'$	$LT = 267.05'$
$T = 161.12'$	$ST = 133.68'$
$L = 320.35'$	$e_{max} = 8.00\%$
$E = 10.71'$	$CS STA. 233+49.08$
$TS STA. 226+28.73$	$ST STA. 237+49.08$
$SC STA. 230+28.73$	

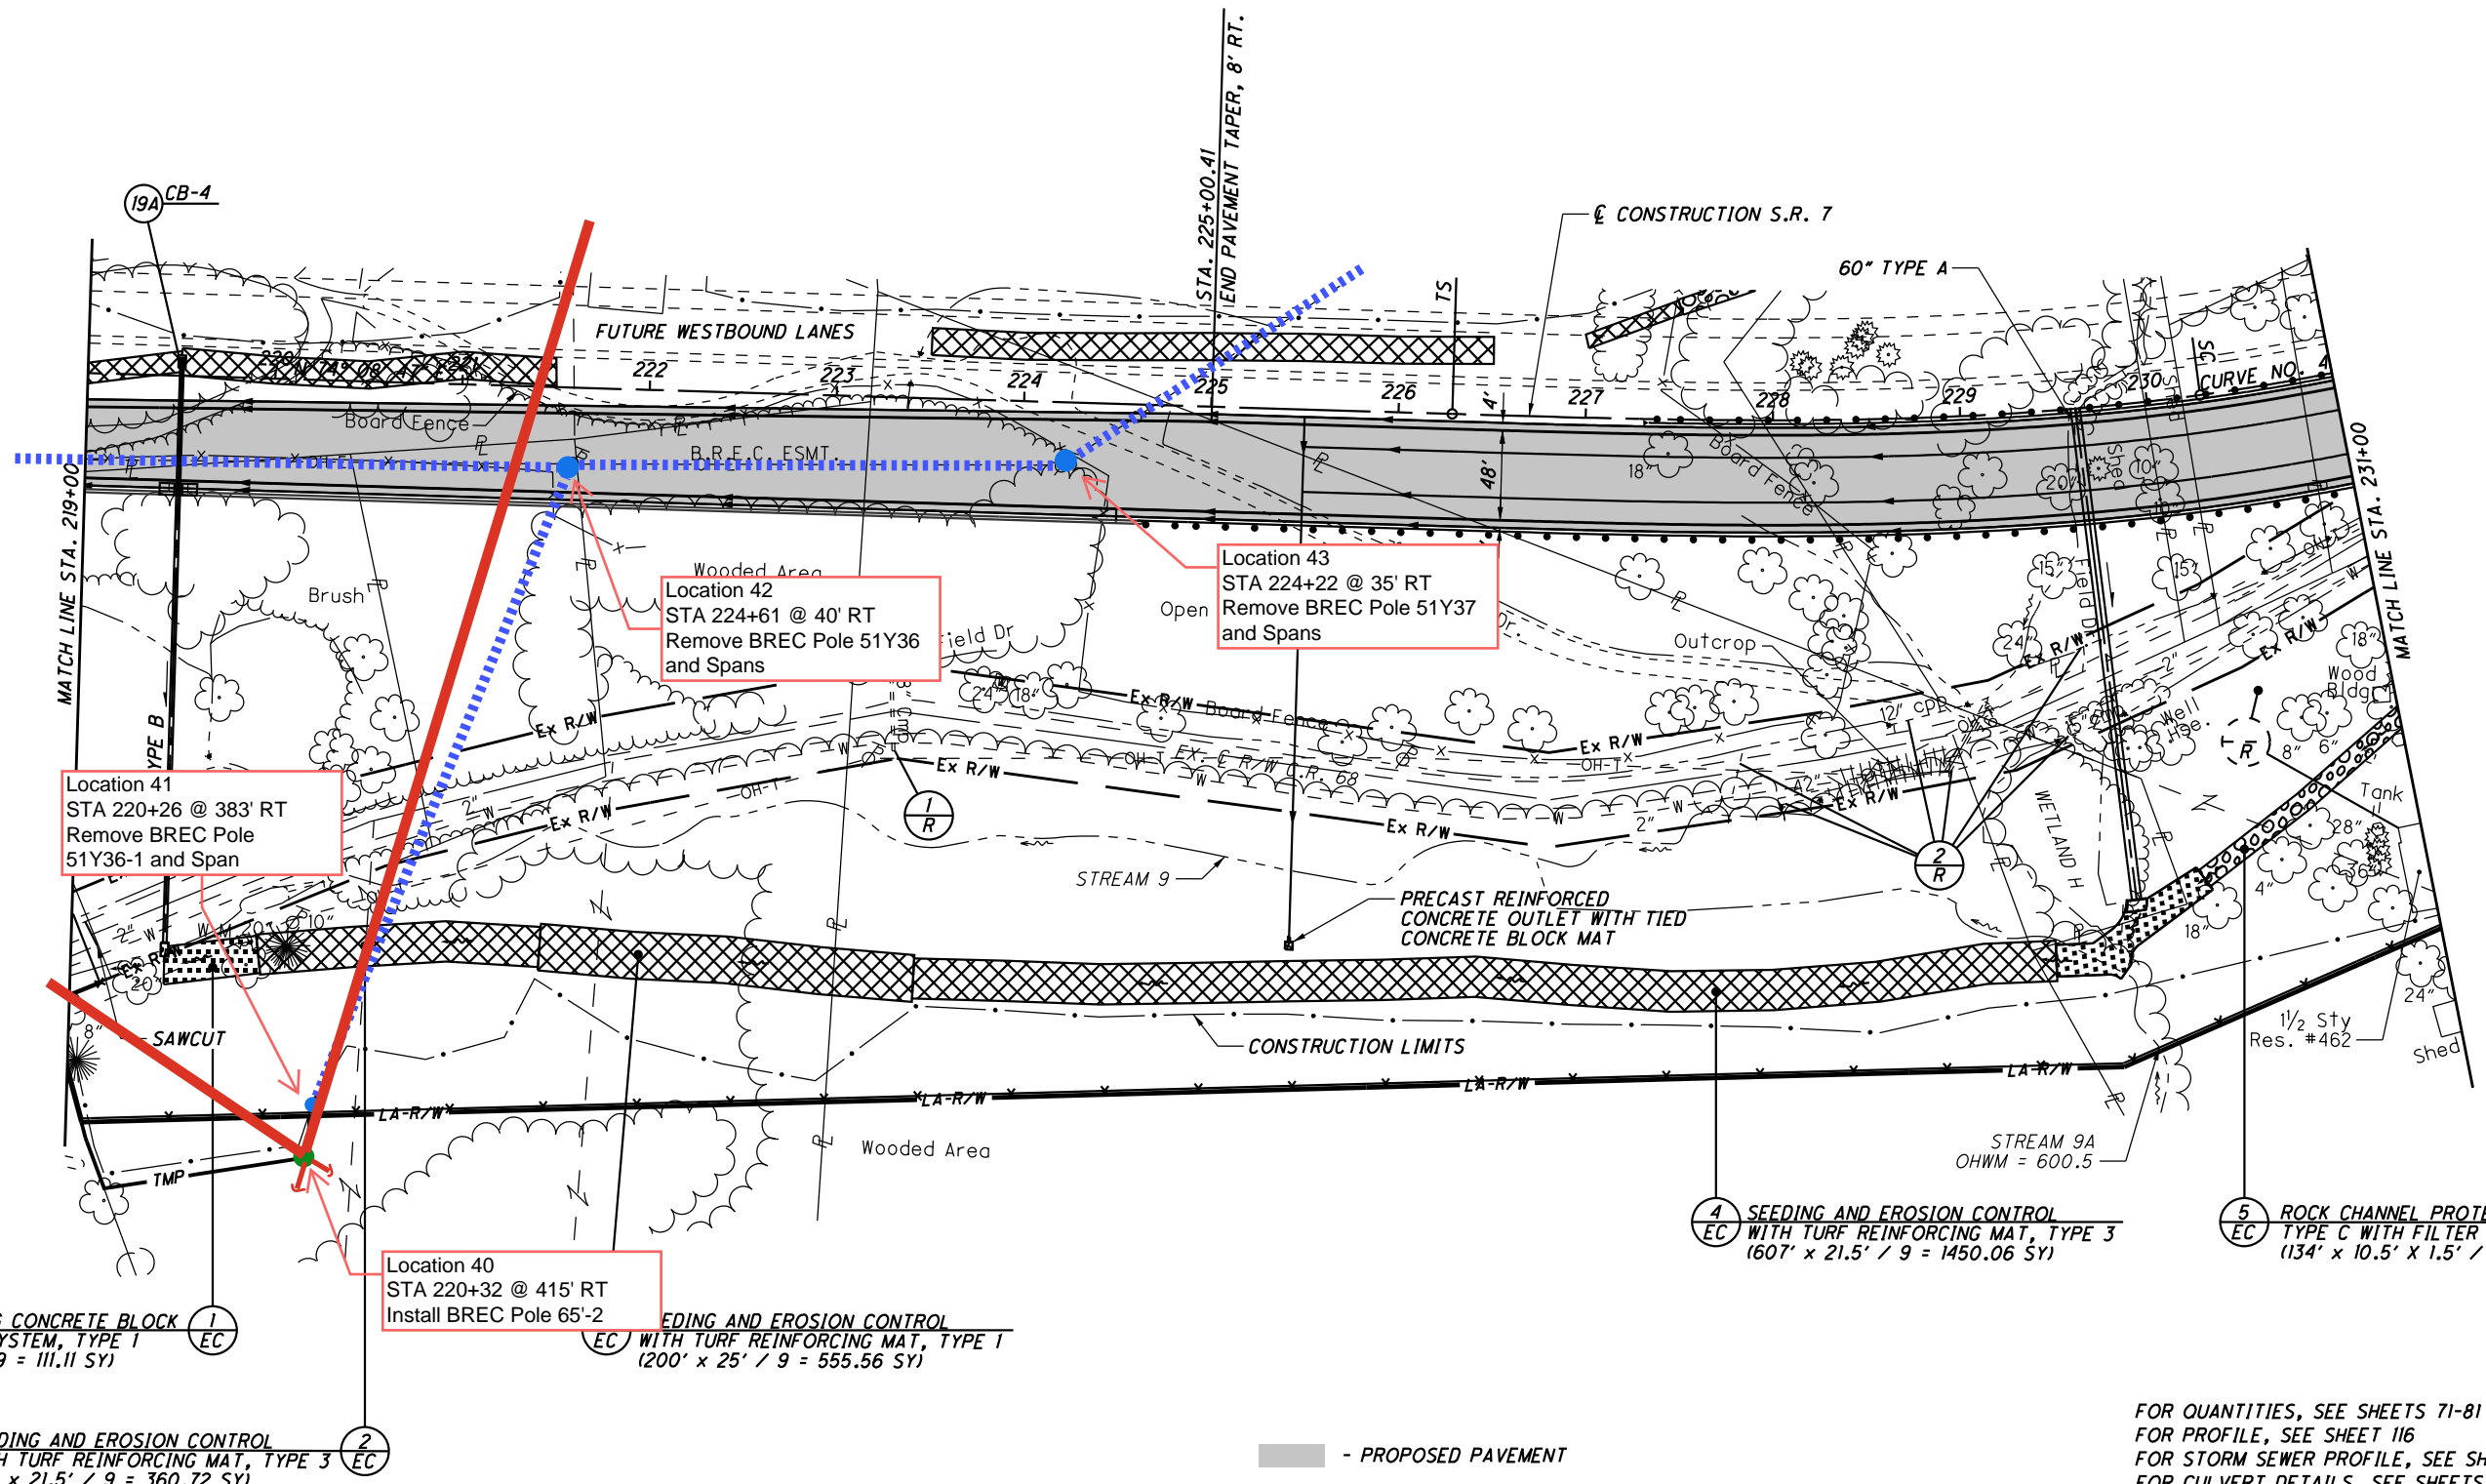

Location 41
STA 220+26 @ 383' RT
Remove BREC Pole
51Y36-1 and Span

Location 42
STA 224+61 @ 40' RT
Remove BREC Pole 51Y36
and Spans

Location 43
STA 224+22 @ 35' RT
Remove BREC Pole 51Y37
and Spans

Location 40
STA 220+32 @ 415' RT
Install BREC Pole 65'-2

1 **EC**
ARTICULATING CONCRETE BLOCK
REVTMENT SYSTEM, TYPE 1
(150' x 20' / 9 = 111.11 SY)

2 **EC**
SEEDING AND EROSION CONTROL
WITH TURF REINFORCING MAT, TYPE 3
(151' x 21.5' / 9 = 360.72 SY)

3 **EC**
SEEDING AND EROSION CONTROL
WITH TURF REINFORCING MAT, TYPE 1
(200' x 25' / 9 = 555.56 SY)

4 **EC**
SEEDING AND EROSION CONTROL
WITH TURF REINFORCING MAT, TYPE 3
(607' x 21.5' / 9 = 1450.06 SY)

5 **EC**
ROCK CHANNEL PROTECTION.
TYPE C WITH FILTER
(134' x 10.5' x 1.5' / 27 = 78.17 CY)

■ - PROPOSED PAVEMENT

FOR QUANTITIES, SEE SHEETS 71-81
FOR PROFILE, SEE SHEET 116
FOR STORM SEWER PROFILE, SEE SHEET 231
FOR CULVERT DETAILS, SEE SHEETS 658
FOR UNDERDRAIN TABLES, SEE SHEETS 674-678
FOR TRAFFIC CONTROL PLAN, SEE SHEETS 713-733A
FOR FENCE TABLES, SEE SHEETS 1039-1041

U:\173608714\LA\75923\roadway_sheets\75923GP010A-2A.dgn 5/21/2024 4:50:12 PM SL Parker

PLAN - S.R. 7
STA. 219+00 TO STA. 231+00 (SOUTH)

LAW-7-2.17

FOR QUANTITIES, SEE SHEETS 71-81
FOR PROFILE, SEE SHEET 116
FOR STORM SEWER PROFILE, SEE SHEET 231
FOR CULVERT DETAILS, SEE SHEETS 658
FOR UNDERDRAIN TABLES, SEE SHEETS 674-678
FOR TRAFFIC CONTROL PLAN, SEE SHEETS 713-733A
FOR FENCE TABLES, SEE SHEETS 1039-1041




PLAN - S.R. 7
STA. 219+00 TO STA. 231+00 (NORTH)

LAW-7-2.17

114
1247

U:\173608714\Law\75923\roadway_sheets\759230P010-2A.dgn 5/21/2024 4:50:11 PM SL Parker

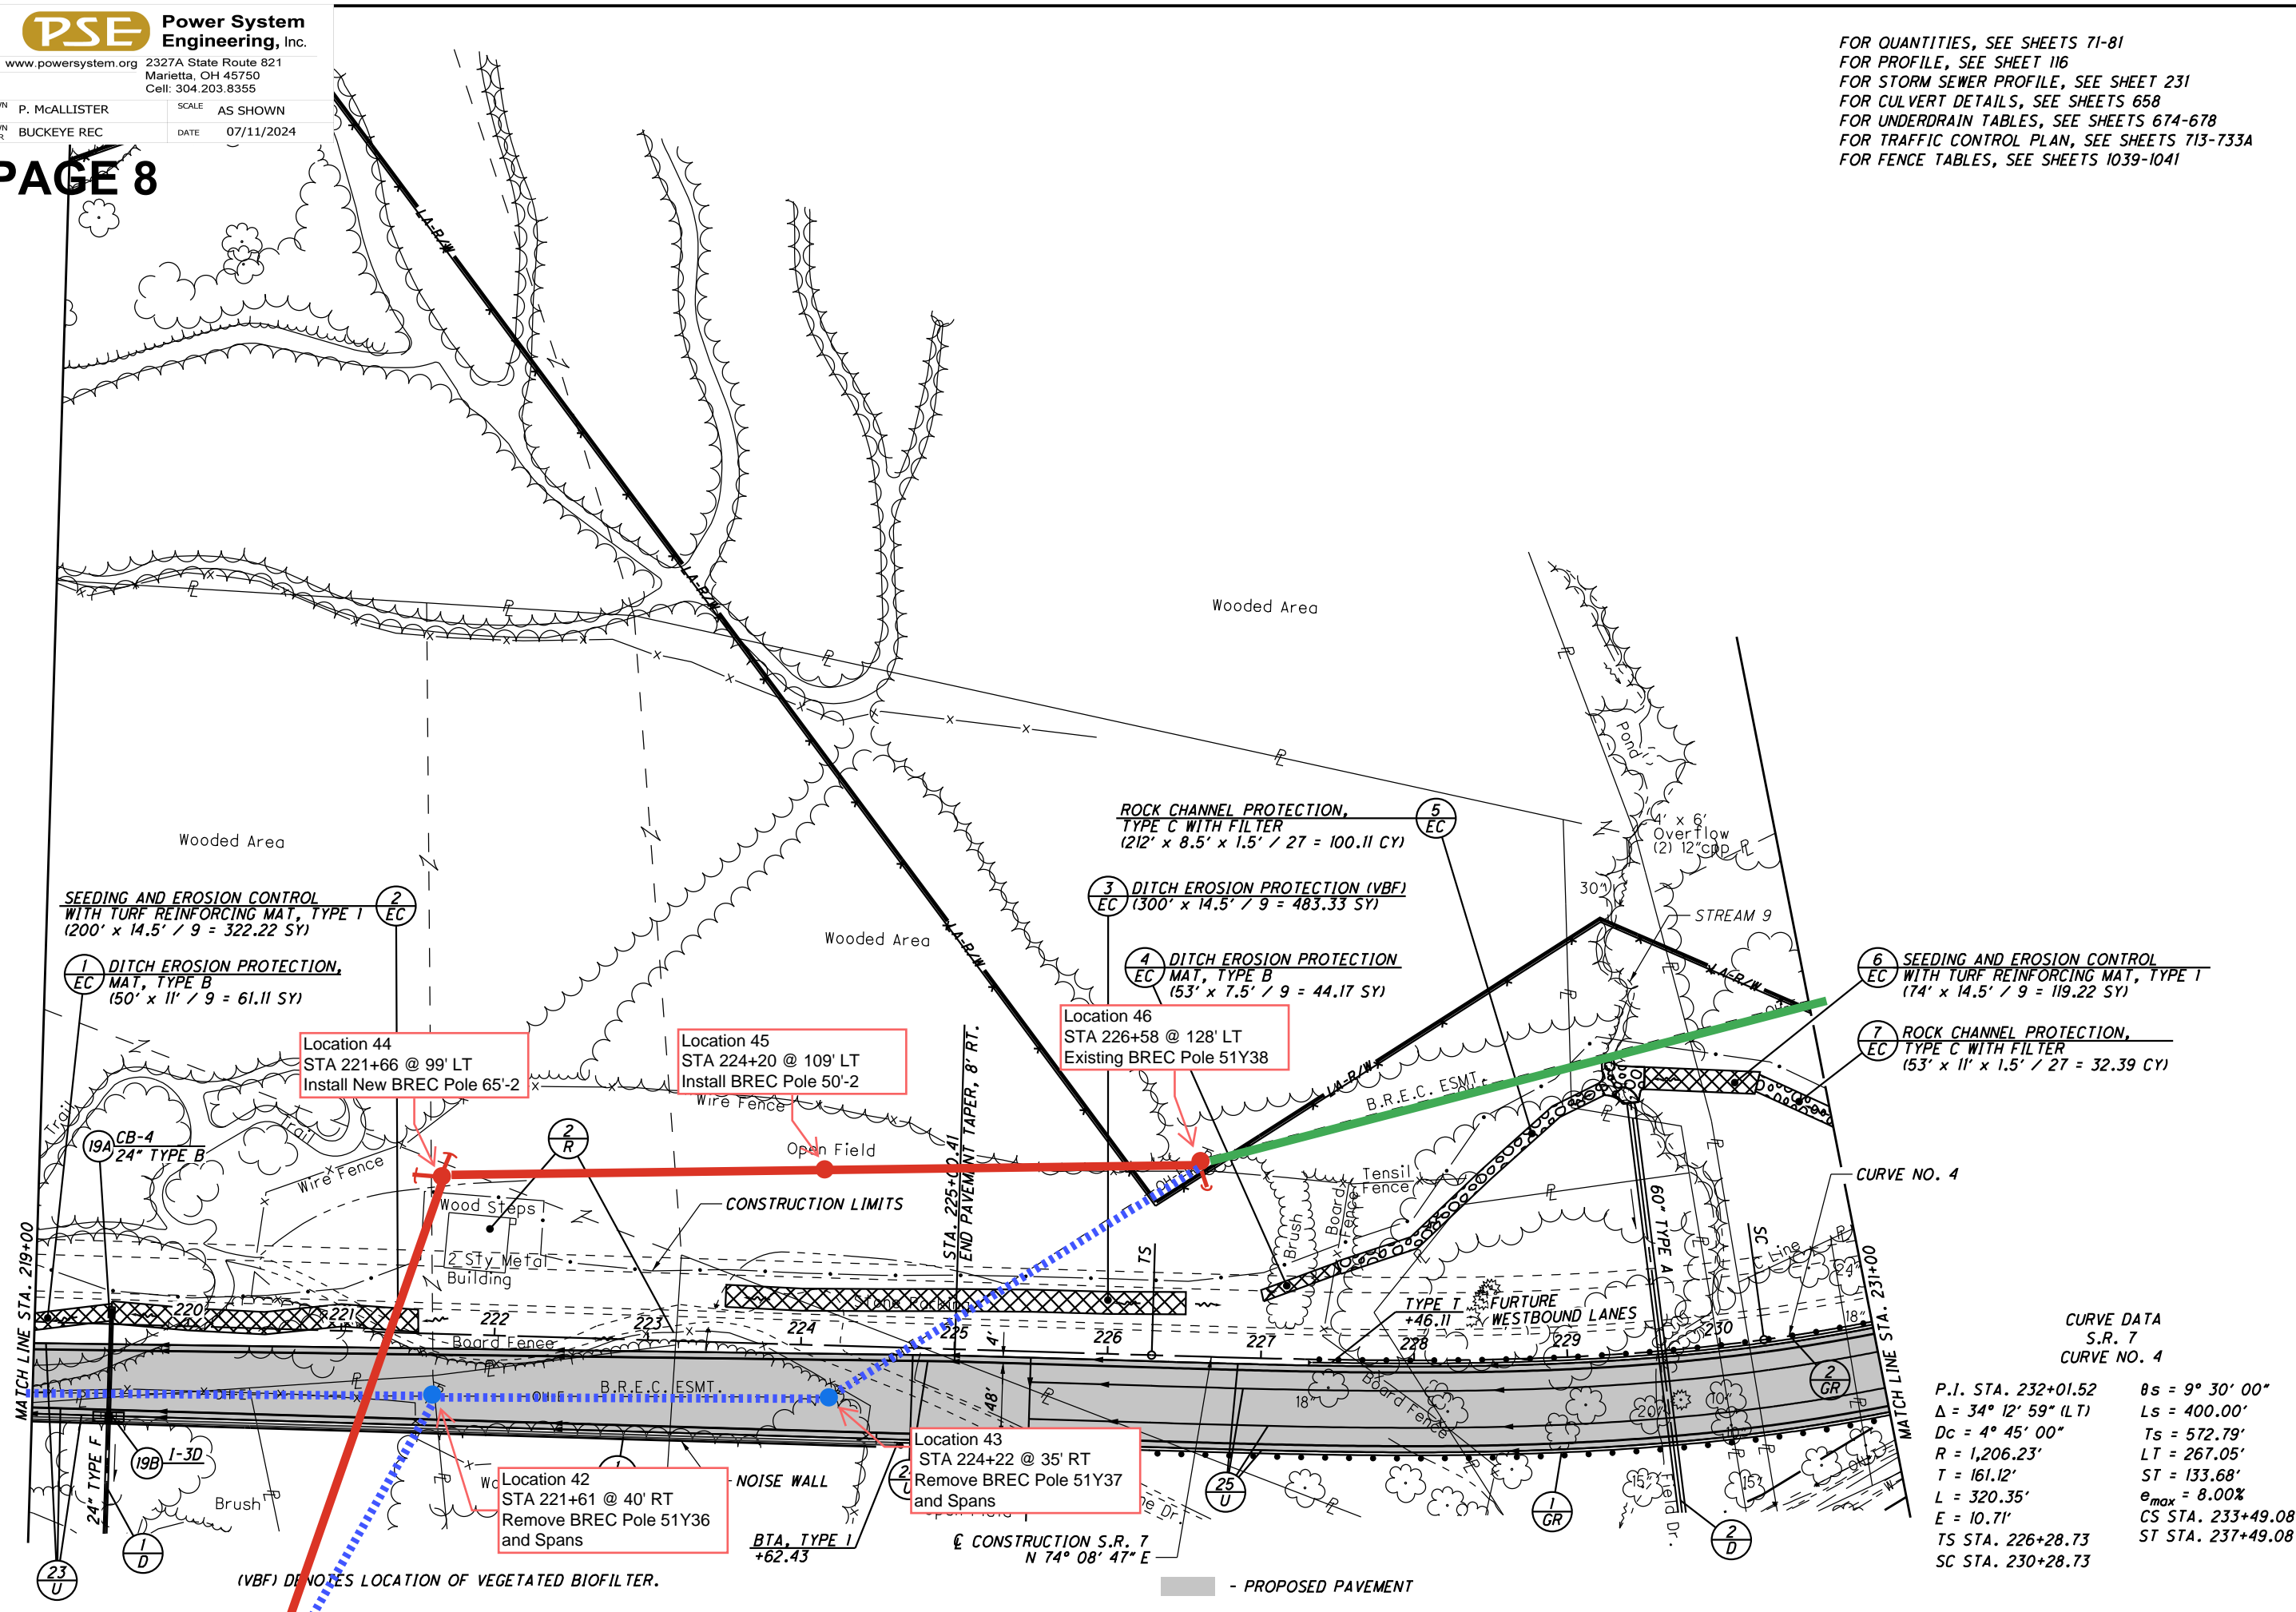

SEEDING AND EROSION CONTROL WITH TURF REINFORCING MAT, TYPE I (200' x 14.5' / 9 = 322.22 SY)


Location 44
STA 221+66 @ 99' LT
Install New BREC Pole 65'-2

Location 45
STA 224+20 @ 109' LT
Install BREC Pole 50'-2

Location 46
STA 226+58 @ 128' LT
Existing BREC Pole 51Y38

ROCK CHANNEL PROTECTION, TYPE C WITH FILTER (212' x 8.5' x 1.5' / 27 = 100.11 CY)

3 DITCH EROSION PROTECTION (VBF) EC (300' x 14.5' / 9 = 483.33 SY)


6 SEEDING AND EROSION CONTROL WITH TURF REINFORCING MAT, TYPE I (74' x 14.5' / 9 = 119.22 SY)


Location 43
STA 224+22 @ 35' RT
Remove BREC Pole 51Y37 and Spans

Location 42
STA 221+61 @ 40' RT
Remove BREC Pole 51Y36 and Spans

CURVE DATA
S.R. 7
CURVE NO. 4

P.I. STA. 232+01.52 $\theta_s = 9^\circ 30' 00''$
 $\Delta = 34^\circ 12' 59''$ (LT) $L_s = 400.00'$
 $D_c = 4^\circ 45' 00''$ $T_s = 572.79'$
 $R = 1,206.23'$ $LT = 267.05'$
 $T = 161.12'$ $ST = 133.68'$
 $L = 320.35'$ $e_{max} = 8.00\%$
 $E = 10.71'$ $CS STA. 233+49.08$
 $TS STA. 226+28.73$ $ST STA. 237+49.08$
 $SC STA. 230+28.73$

(VBF) DENOTES LOCATION OF VEGETATED BIOFILTER.

- PROPOSED PAVEMENT

PAGE 9
R = 1,206.23'
L = 320.35'
E = 10.71'
TS STA. 226+28.73
SC STA. 230+28.73

LT = 267.05'
ST = 133.68'
e_{max} = 8.00%
CS STA. 233+49.08
ST STA. 237+49.08

**ROCK CHANNEL PROTECTION,
TYPE C WITH FILTER**
(53' x 6' x 1.5' / 27 = 17.67 CY)

**SEEDING AND EROSION CONTROL
WITH TURF REINFORCING MAT, TYPE 1**
(196' x 11' / 9 = 239.56 SY)

**ROCK CHANNEL PROTECTION,
TYPE C WITH FILTER**
(157' x 11' x 1.5' / 27 = 34.83 CY)

**SEEDING AND EROSION CONTROL
WITH TURF REINFORCING MAT, TYPE 2**
(355' x 14.5' / 9 = 571.94 SY)

Location 47
STA 231+38 @ 215' LT
Existing BREC Pole 51Y39

Location 48
STA 235+10 @ 173' LT
Existing BREC Pole 51Y40

Location 50
STA 238+10 @ 380' LT
Existing BREC Pole 51Y42

Location 49
STA 236+78 @ 292' LT
Existing BREC Pole 51Y41

Location 51
STA 231+98 @ 97' LT
Remove BREC Pole and Span

Location 52
STA 232+12 @ 55' LT
Remove BREC Pole and Span

Location 59
STA 235+36 @ 10' LT
Remove BREC Pole
51Y40-1 and Span

Location 53
STA 231+42 @ 155' RT
Remove BREC Pole
51Y39-1 and Spans

Location 54
STA 232+56 162' RT
Remove BREC Pole
51Y39-2 and Spans

Location 58
STA 235+36 @ 115' RT
Remove BREC Pole
51Y39-4ZB

Location 57
STA 234+27 @ 185' RT
Remove BREC Pole
51Y39-4 and Spans

Location 55
STA 231+75 @ 238' RT
Remove BREC Pole and Span

Location 56
STA 233+42 @ 218' RT
Remove BREC Pole
57Y39-3 and Spans

**ROCK CHANNEL PROTECTION,
TYPE C WITH FILTER**
(243' x 10.5' x 1.5' / 27 = 141.75 CY)

**DITCH EROSION PROTECTION
MAT, TYPE B**
(57' x 11' / 9 = 69.67 SY)

**DITCH EROSION PROTECTION
MAT, TYPE B**
(153' x 11' / 9 = 187 SY)

**ROCK CHANNEL PROTECTION,
TYPE C WITH FILTER**
(152' x 12' x 1.5' / 27 = 101.33 CY)

(A) - STA. 235+13.20
BEGIN PAVEMENT TAPER, 56' RT.

(C) - STA. 242+33.20
END PAVEMENT TAPER, 44' RT.
END SHOULDER TAPER, 54' RT.

(B) - STA. 241+73.20
BEGIN SHOULDER TAPER, 49' RT.

(D) - PRECAST REINFORCED OUTLET WITH
TIED CONCRETE BLOCK MAT


(LF) DESIGNATES
LEACH FIELD

█ - PROPOSED PAVEMENT

CONTRACTOR TO FILL AND REGRADE THE EXISTING CHANNEL TO TIE INTO THE PROPOSED ROADSIDE DITCH USING THE TYPICAL SECTION ABOVE. THE FOLLOWING QUANTITIES ARE INCLUDED IN REFERENCE NUMBER 8-EC TO COMPLETE THIS WORK.

ITEM 203 - EXCAVATION	5 CY
ITEM 203 - EMBANKMENT	1932 CY
ITEM 601 - ROCK CHANNEL PROTECTION, TYPE C WITH FILTER	203 CY
ITEM 659 - SEEDING AND MULCHING	1100 SY


DITCH TYPICAL SECTION

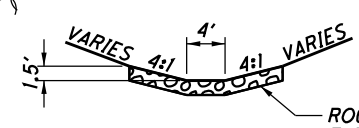

CONSTRUCTION LIMITS

SEE DITCH TYPICAL SECTION THIS SHEET
EX. E = 646.00

ROCK CHANNEL PROTECTION, TYPE C WITH FILTER

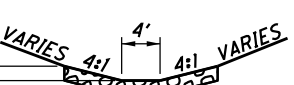

STREAM 10 OHWM = 637.4

STREAM 10A OHWM = 636.7

CONSTRUCTION S.R. 7

FUTURE WESTBOUND LANES

WOODED AREA

BRUSH

TRAIL

LA-R/W

EX-R/W

SEPTIC DR.

IS

25A U

26 U

27 U

U:\173608714\LAW\75923\roadway_sheets\75923GP011-2A.dgn 5/21/2024 4:50:15 PM SLParker

DWN BY P. McALLISTER SCALE AS SHOWN
 DWN FOR BUCKEYE REC DATE 07/11/2024

P.I. Sta. 12+94.82
 $\Delta = 6^\circ 05' 09''$ (RT)
 $\Delta = 6^\circ 05' 09''$ (RT)
 $Dc = 19^\circ 05' 55''$
 $R = 650.00'$
 $T = 77.56'$
 $L = 154.40'$
 $E = 0.54'$
 $e_{max} = 1.60\%$
 PC Sta. 10+85.87
 PRC Sta. 11+21.82
 $Dc = 8^\circ 48' 53''$
 $R = 350.00'$
 $T = 18.61'$
 $L = 37.18'$
 $E = 0.49'$
 $e_{max} = 1.60\%$
 PRC Sta. 11+21.82
 PCC Sta. 12+76.21
 $Dc = 16^\circ 22' 13''$
 $R = 350.00'$
 $T = 18.61'$
 $L = 37.18'$
 $E = 0.49'$
 $e_{max} = 1.60\%$
 PCC Sta. 12+76.21
 CS Sta. 13+13.39

CURVE DATA
 S.R. 243
 CURVE NO. 4

P.I. Sta. 15+51.11
 $\Delta = 5^\circ 37' 36''$ (LT)
 $Dc = 1^\circ 30' 00''$
 $R = 3,819.72'$
 $T = 137.62'$
 $L = 275.13'$
 $E = 2.48'$
 TS STA. 13+13.39
 SC STA. 14+13.39
 $\theta_s = 00^\circ 45' 00''$
 $L_s = 100.00'$
 $T_s = 237.72'$
 $LT = 66.67'$
 $ST = 33.33'$
 $e_{max} = 3.50\%$
 CS Sta. 16+88.52
 ST Sta. 17+88.52


FOR QUANTITIES, SEE SHEETS 71-81
 FOR S.R. 7 PLAN & PROFILE, SEE SHEETS 119-120
 FOR PROFILE, SEE SHEET 491
 FOR INTERSECTION DETAILS, SEE SHEETS 625
 FOR DRIVE DETAILS, SEE SHEETS 636-638
 FOR STORM SEWER PROFILE, SEE SHEET 647
 FOR DETENTION BASIN DETAILS, SEE SHEETS 667 & 672
 FOR UNDERDRAIN TABLES, SEE SHEETS 674-678
 FOR TRAFFIC CONTROL PLAN, SEE SHEETS 713-733A
 FOR FENCE TABLES, SEE SHEETS 1039-1041



PLAN
 S.R. 243

LAW-7-2.17

490
 1247

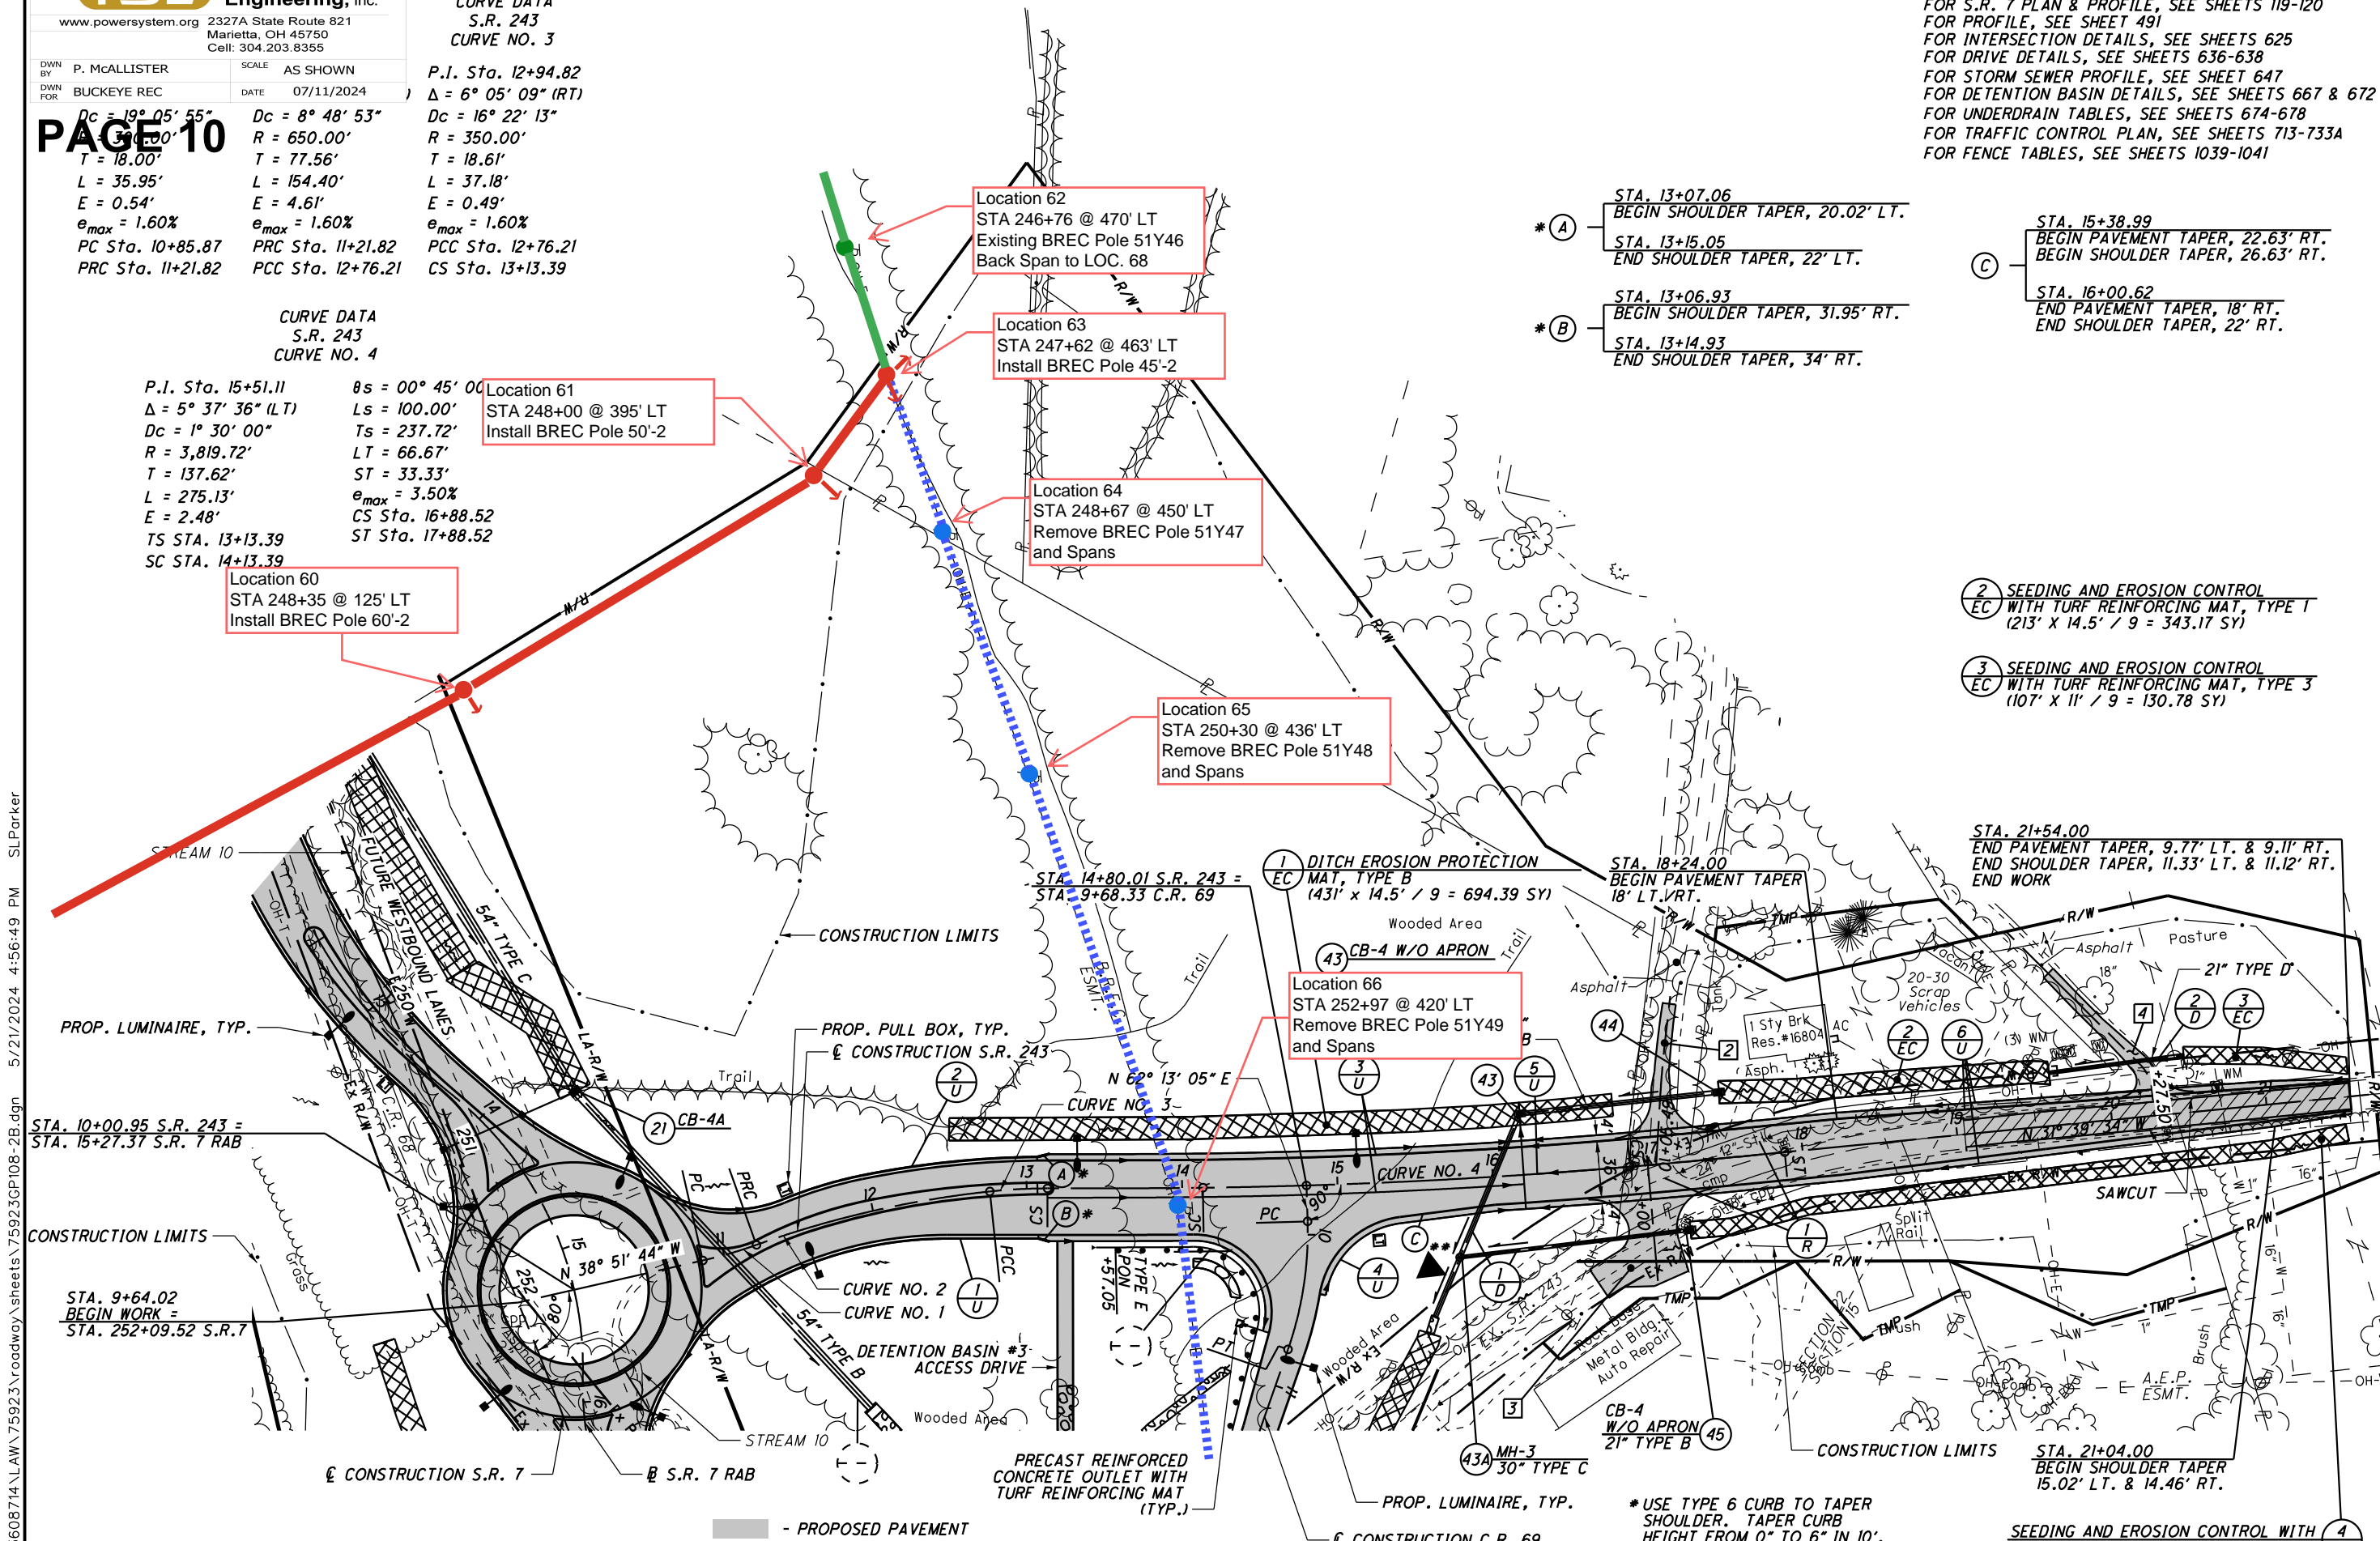

STA. 13+07.06
 BEGIN SHOULDER TAPER, 20.02' LT.
 STA. 13+15.05
 END SHOULDER TAPER, 22' LT.
 STA. 13+06.93
 BEGIN SHOULDER TAPER, 31.95' RT.
 STA. 13+14.93
 END SHOULDER TAPER, 34' RT.

STA. 15+38.99
 BEGIN PAVEMENT TAPER, 22.63' RT.
 BEGIN SHOULDER TAPER, 26.63' RT.
 STA. 16+00.62
 END PAVEMENT TAPER, 18' RT.
 END SHOULDER TAPER, 22' RT.

2 SEEDING AND EROSION CONTROL
 EC WITH TURF REINFORCING MAT, TYPE 1
 (213' X 14.5' / 9 = 343.17 SY)
 3 SEEDING AND EROSION CONTROL
 EC WITH TURF REINFORCING MAT, TYPE 3
 (107' X 11' / 9 = 130.78 SY)

1 DITCH EROSION PROTECTION
 EC MAT, TYPE B
 (431' X 14.5' / 9 = 694.39 SY)

STA. 18+24.00
 BEGIN PAVEMENT TAPER
 18' LT./RT.

STA. 21+54.00
 END PAVEMENT TAPER, 9.77' LT. & 9.11' RT.
 END SHOULDER TAPER, 11.33' LT. & 11.12' RT.
 END WORK

Location 66
 STA 252+97 @ 420' LT
 Remove BREC Pole 51Y49
 and Spans

STA. 21+04.00
 BEGIN SHOULDER TAPER
 15.02' LT. & 14.46' RT.


* USE TYPE 6 CURB TO TAPER SHOULDER. TAPER CURB HEIGHT FROM 0" TO 6" IN 10'.
 ** LIGHTING CONTROL CENTER

PROPOSED PAVEMENT
 3-1/4" MILL/FILL

DWN BY P. McALLISTER SCALE AS SHOWN
DWN FOR BUCKEYE REC DATE 07/11/2024
FOR Δ = 58° 46' 06" (R/L) LS = 350.00'
R = 1,762.95' LT = 1,169.30'
T = 773.76' ST = 116.78'
L = 1,458.26' e_{max} = 7.10%
E = 162.33' CS STA. 268+28.71
TS STA. 250+20.45 ST STA. 271+78.71
SC STA. 253+70.45

PAGE 11

CURVE DATA S.R. 7 RAB @ CURVE NO. 1	CURVE DATA S.R. 7 RAB @ CURVE NO. 2	CURVE DATA S.R. 7 RAB @ CURVE NO. 3	CURVE DATA S.R. 7 RAB @ CURVE NO. 4
P.I. Sta. 12+93.43	P.I. Sta. 14+87.13	P.I. Sta. 16+43.83	P.I. Sta. 18+27.99
Δ = 27° 26' 21" (LT)	Δ = 52° 43' 55" (RT)	Δ = 30° 24' 24" (LT)	Δ = 31° 15' 43" (RT)
Dc = 16° 22' 13"	Dc = 25° 27' 53"	Dc = 25° 27' 53"	Dc = 12° 43' 57"
R = 350.00'	R = 225.00'	R = 225.00'	R = 450.00'
T = 85.45'	T = 111.52'	T = 61.15'	T = 125.90'
L = 167.62'	L = 207.08'	L = 119.41'	L = 245.53'
E = 10.28'	E = 26.12'	E = 8.16'	E = 17.28'
PC Sta. 12+07.99	PRC Sta. 13+75.60	PRC Sta. 15+82.68	PRC Sta. 17+02.09
PT Sta. 13+75.60	PT Sta. 15+82.68	PT Sta. 17+02.09	PT Sta. 19+47.62

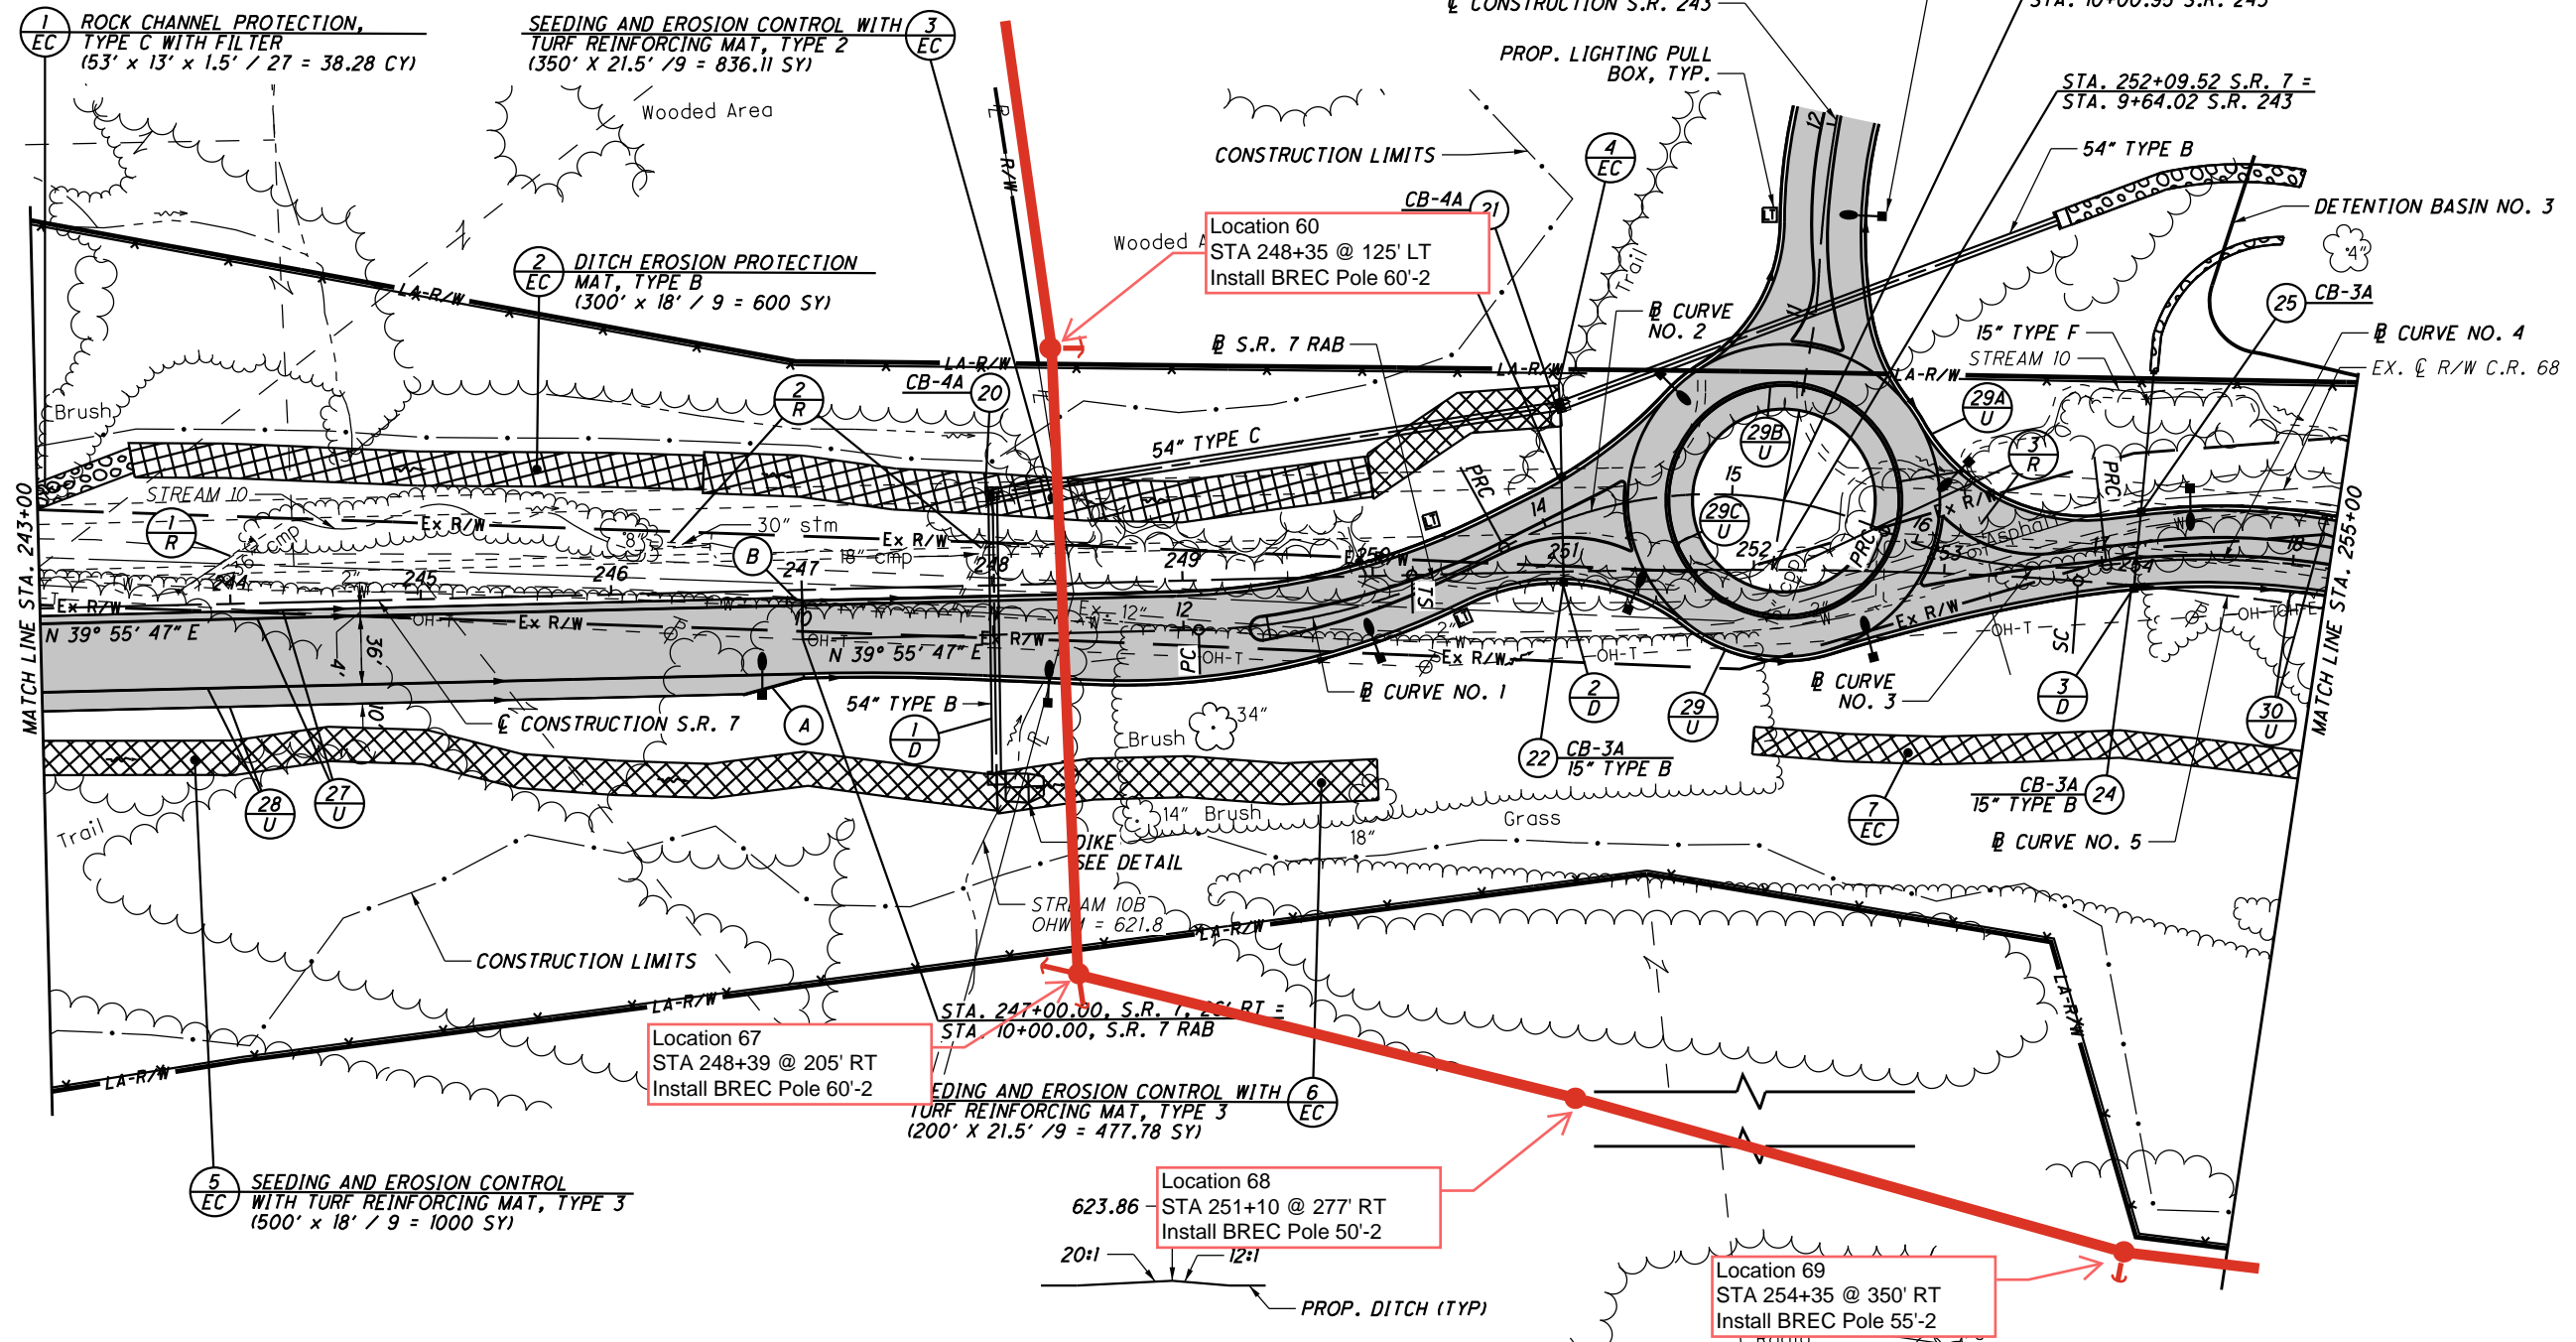

- (A) STA. 246+68.00
BEGIN SHOULDER TAPER, 54' RT.
STA. 247+00.00
END SHOULDER TAPER, 58' RT.
- (B) STA. 246+92.00
BEGIN SHOULDER TAPER, 4' LT.
STA. 247+00.00
END SHOULDER TAPER, 6' LT.

(4) DITCH EROSION PROTECTION
MAT, TYPE B
(100' X 21.5' / 9 = 238.89 SY)

(7) SEEDING AND EROSION CONTROL WITH
TURF REINFORCING MAT, TYPE 1
(288' X 14.5' / 9 = 464 SY)

DIKE DETAIL
EMBANKMENT INCLUDED IN THE COST OF
ITEM 611 - 54" CONDUIT, TYPE B

- PROPOSED PAVEMENT
* USE TYPE 6 CURB TO TAPER
SHOULDER. TAPER CURB HEIGHT
FROM 0" TO 6" IN 10'.

FOR QUANTITIES, SEE SHEETS 71-81
FOR PROFILE, SEE SHEETS 120-121
FOR S.R. 243 PLAN AND PROFILE, SEE SHEETS 490-491
FOR PAVEMENT DETAILS, SEE SHEETS 607-609
FOR STORM SEWER PROFILES, SEE SHEETS 257, 259 & 642
FOR UNDERDRAIN TABLES, SEE SHEETS 674-678
FOR TRAFFIC CONTROL PLAN, SEE SHEETS 713-733A
FOR FENCE TABLES, SEE SHEETS 1039-1041



PLAN - S.R. 7
STA. 243+00 TO STA. 255+00 (NORTH)


LAW - 7 - 2.17

119
1247

U:\173608714\LA\75923\roadway_sheets\75923GP012-2A.dgn 5/21/2024 4:50:20 PM SLParker

CONSTRUCTION S.R. 7 RAB

SEEDING AND EROSION CONTROL WITH TURF REINFORCING MAT, TYPE 1 (382' x 14.5' / 9 = 615.44 SY)

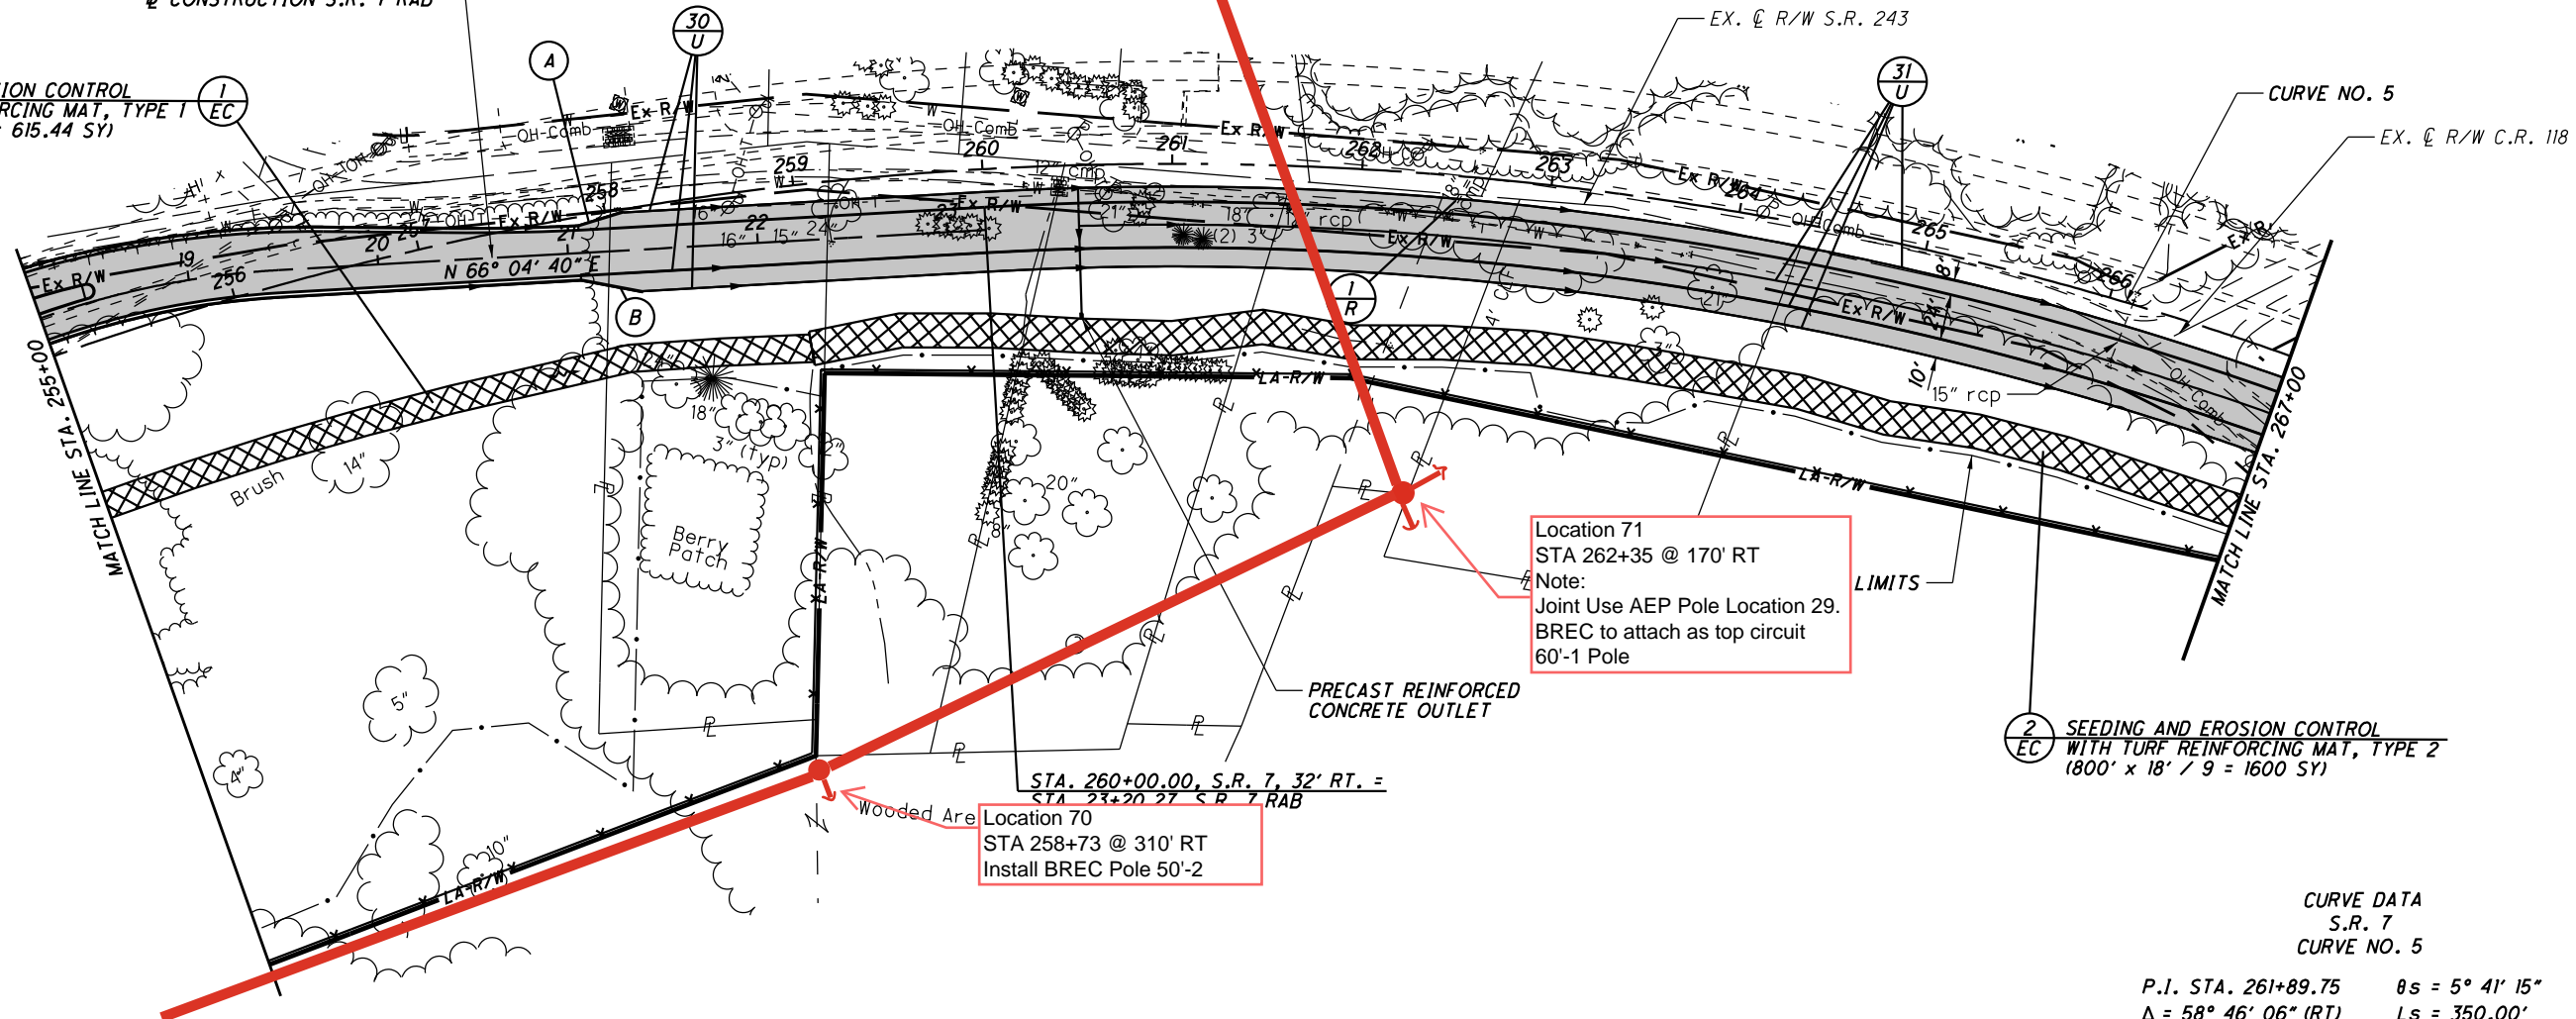

Location 71
STA 262+35 @ 170' RT
Note:
Joint Use AEP Pole Location 29.
BREC to attach as top circuit
60'-1 Pole

Location 70
STA 258+73 @ 310' RT
Install BREC Pole 50'-2


CURVE DATA
S.R. 7
CURVE NO. 5

P.I. STA. 261+89.75	θs = 5° 41' 15"
Δ = 58° 46' 06" (RT)	Ls = 350.00'
Dc = 3° 15' 00"	Ts = 1,169.30'
R = 1,762.95'	LT = 233.45'
T = 773.76'	ST = 116.78'
L = 1,458.26'	θmax = 7.10%
E = 162.33'	CS STA. 268+28.71
TS STA. 250+20.45	ST STA. 271+78.71
SC STA. 253+70.45	

- * (A) - STA. 257+84.79
BEGIN SHOULDER TAPER, 4.87' RT.
STA. 258+09.36
END SHOULDER TAPER, 1.71' RT.
- * (B) - STA. 257+81.31
BEGIN SHOULDER TAPER, 32.70' RT.
STA. 258+12.87
END SHOULDER TAPER, 44.33' RT.

* USE TYPE 6 CURB TO TAPER SHOULDER. TAPER CURB HEIGHT FROM 0" TO 6" IN 10'.

█ - PROPOSED PAVEMENT


FOR QUANTITIES, SEE SHEETS 71-81
FOR PROFILE, SEE SHEET 124
FOR PAVEMENT DETAILS, SEE SHEETS 609
FOR UNDERDRAIN TABLES, SEE SHEETS 674-678
FOR TRAFFIC CONTROL PLAN, SEE SHEETS 713-733A
FOR FENCE TABLES, SEE SHEETS 1039-1041

PLAN - S.R. 7
STA. 255+00 TO STA. 267+00 (SOUTH)


LAW-7-2.17

U:\173608714\LA\75923\roadway_sheets\75923GP013A-2A.dgn 5/21/2024 4:50:25 PM SLParker


$\Delta = 30^\circ 40' 00" (RT)$
 $T = 773.76'$
 $L = 1,458.26'$
 $E = 162.33'$
 $TS STA. 250+20.45$
 $SC STA. 253+70.45$
 $LS = 300.00'$
 $Ts = 1,169.30'$
 $LT = 233.45'$
 $ST = 116.78'$
 $e_{max} = 7.10\%$
 $CS STA. 268+28.71$
 $ST STA. 271+78.71$

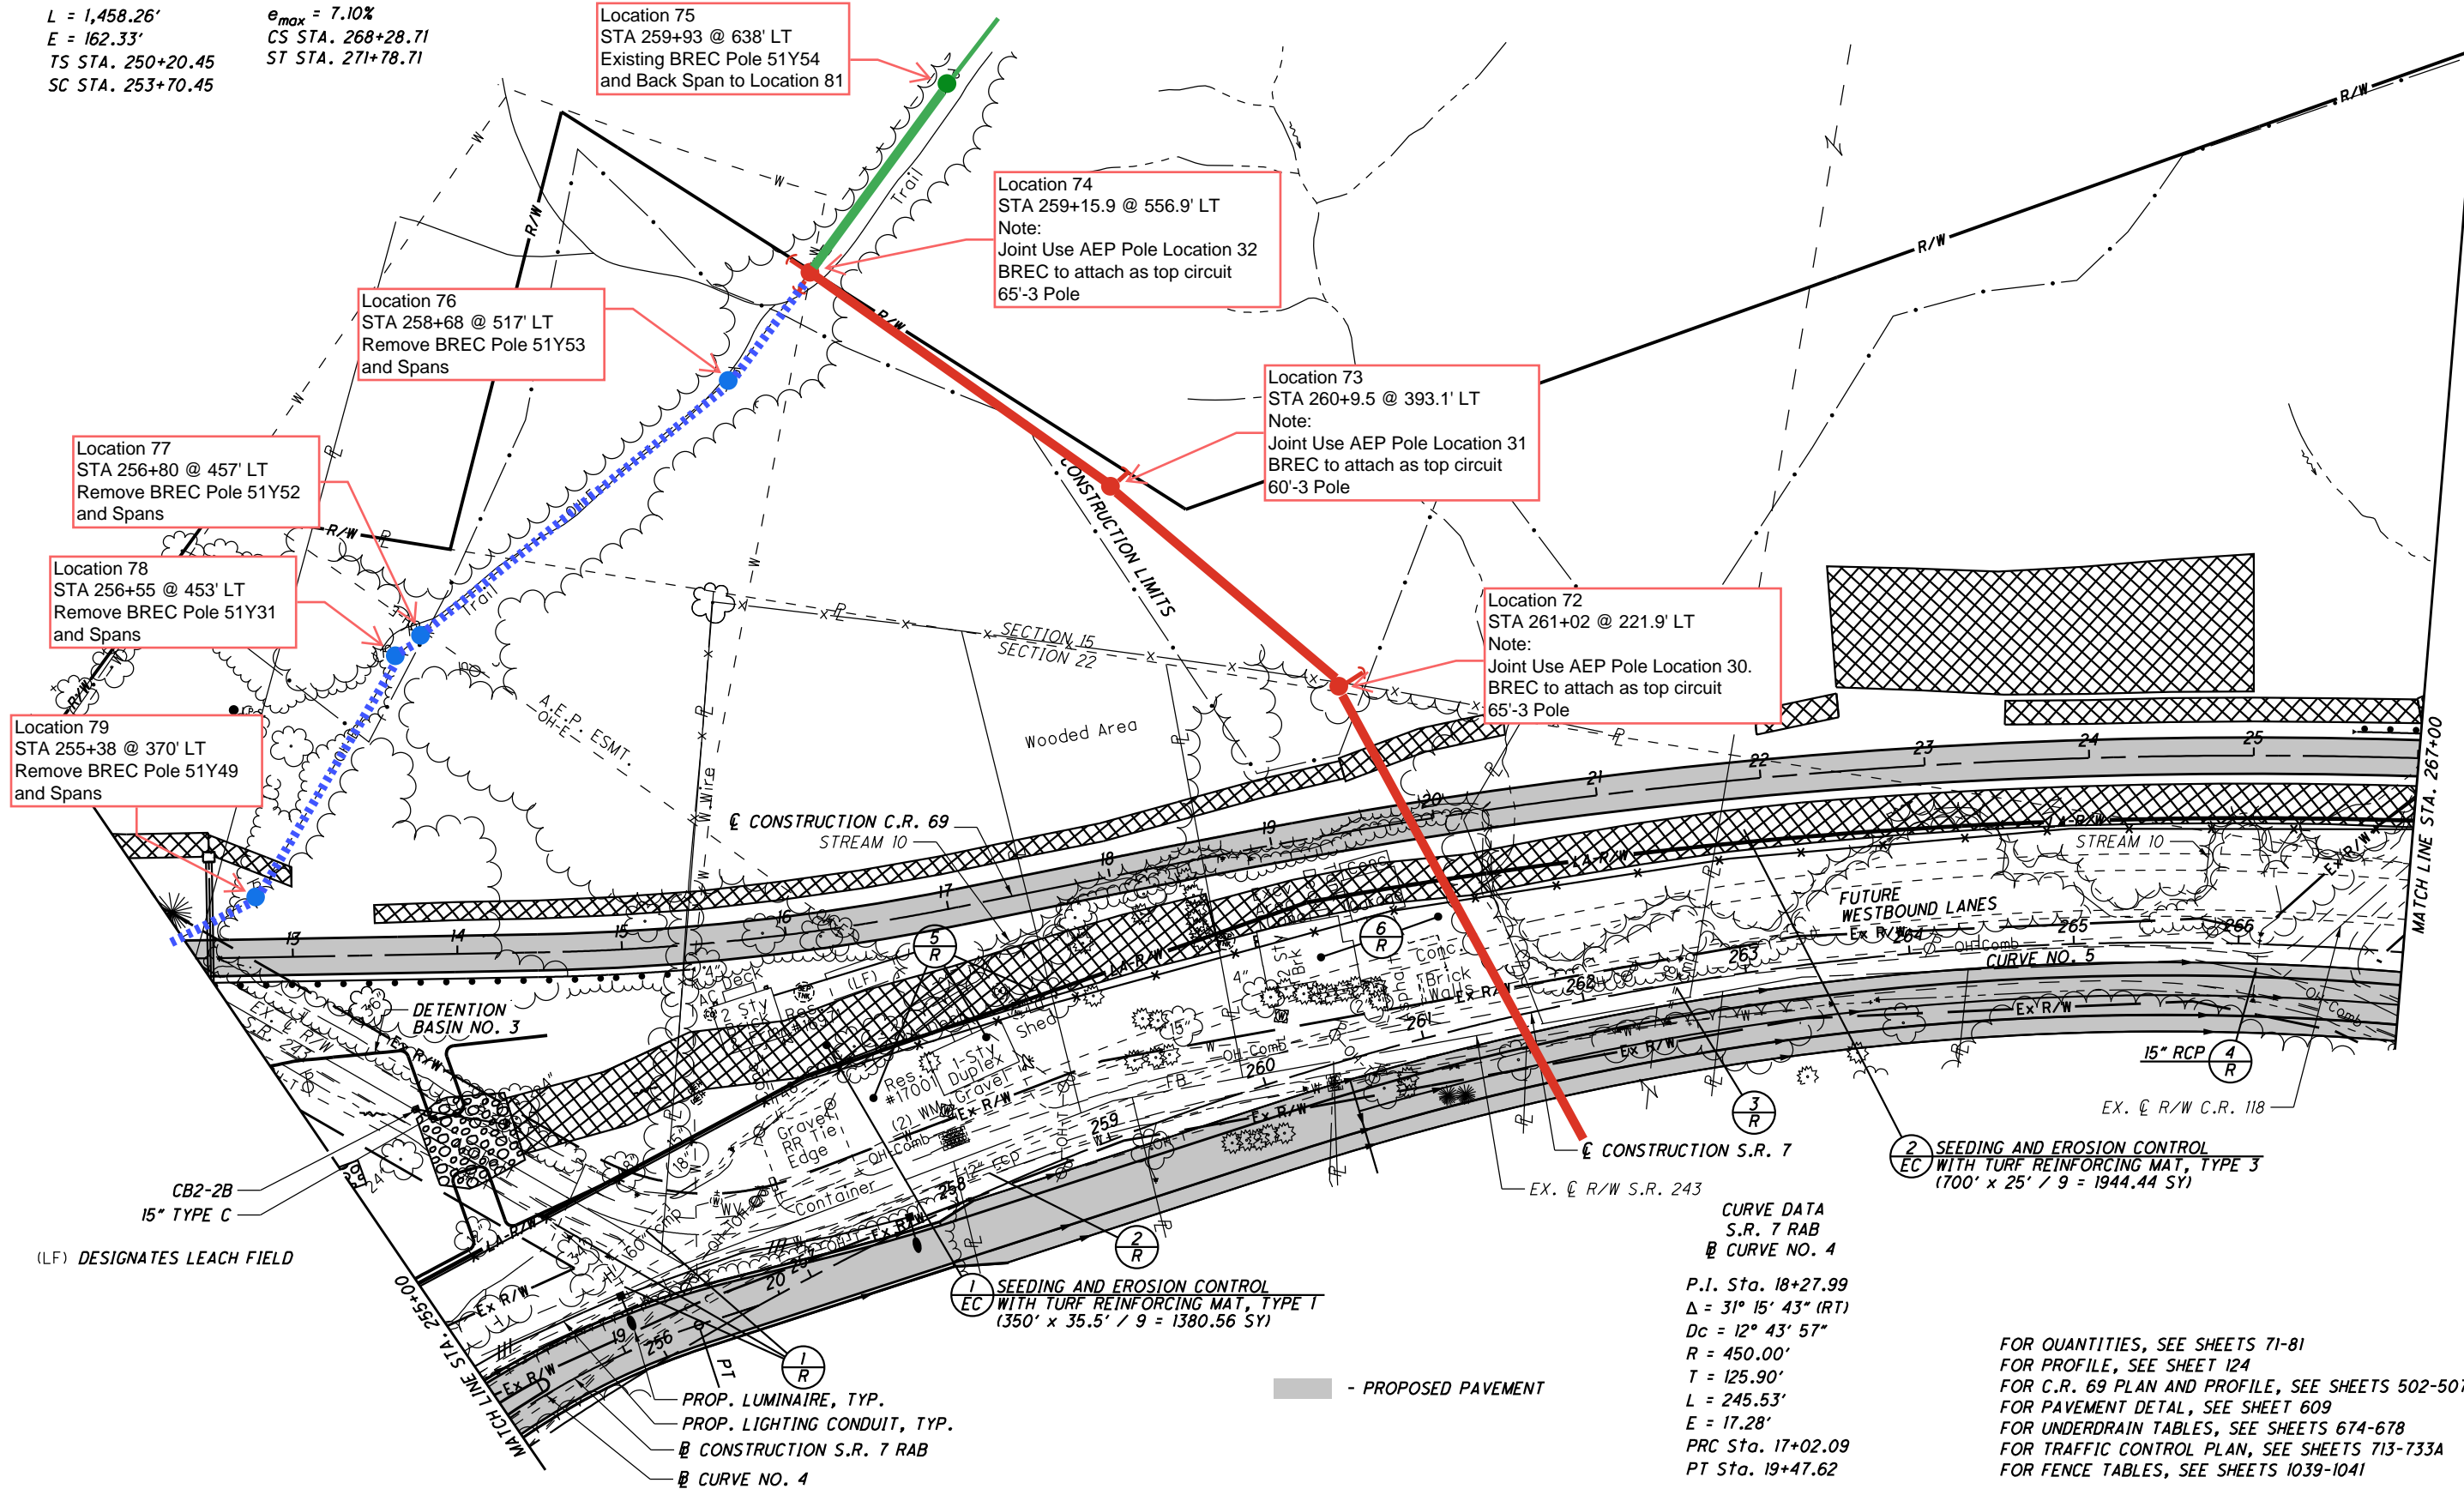


U:\173608714\LAW\759233\roadway_sheets\759233\013-2A.dgn 5/21/2024 4:50:24 PM SLPariker

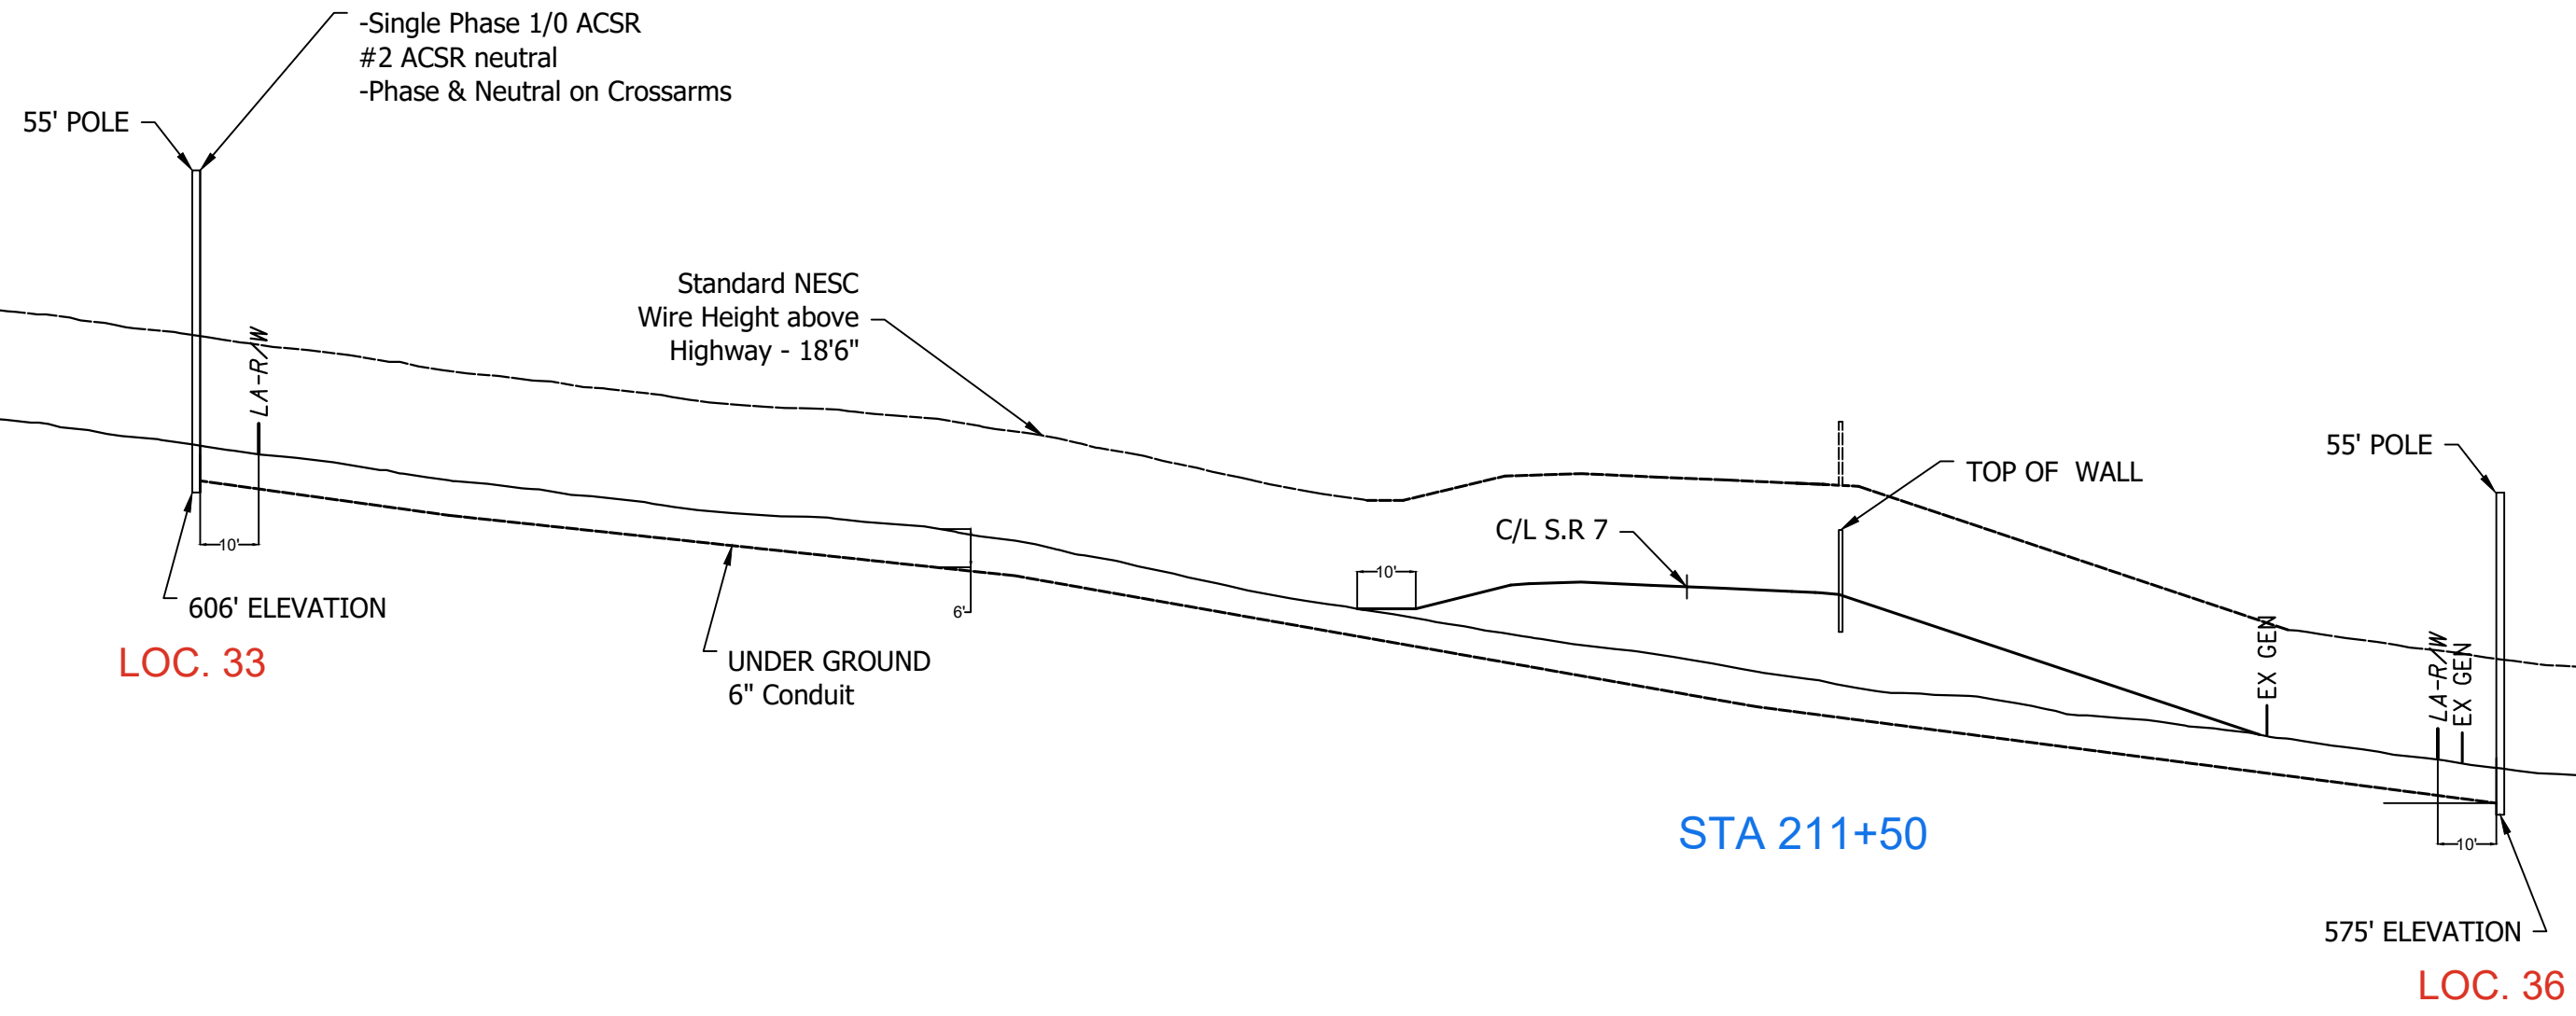

<p>THIS DRAWING IS DISTRIBUTED UPON THE CONDITION THAT IT IS NOT TO BE REPRODUCED OR BE COPIED, IN WHOLE OR IN PART WITHOUT THE EXPRESSED WRITTEN CONSENT OF POWER SYSTEM ENGINEERING, INC.</p>					<p>PSE Power System Engineering, Inc. www.powersystem.org 2327-A State Route 821 Marietta, OH 45750 Tel: 740.568.9221</p>			<p>BREC S.R. 7 ROAD CROSSING STA 211+50</p>	
NO.	REVISION AND RECORD OF ISSUE	BY	ENGR.	DATE	ENGR.	DATE	SCALE	PROJECT NO.	DRAWING NO.
-	-	-	-	-	-	-	NTS	OH00623187	400

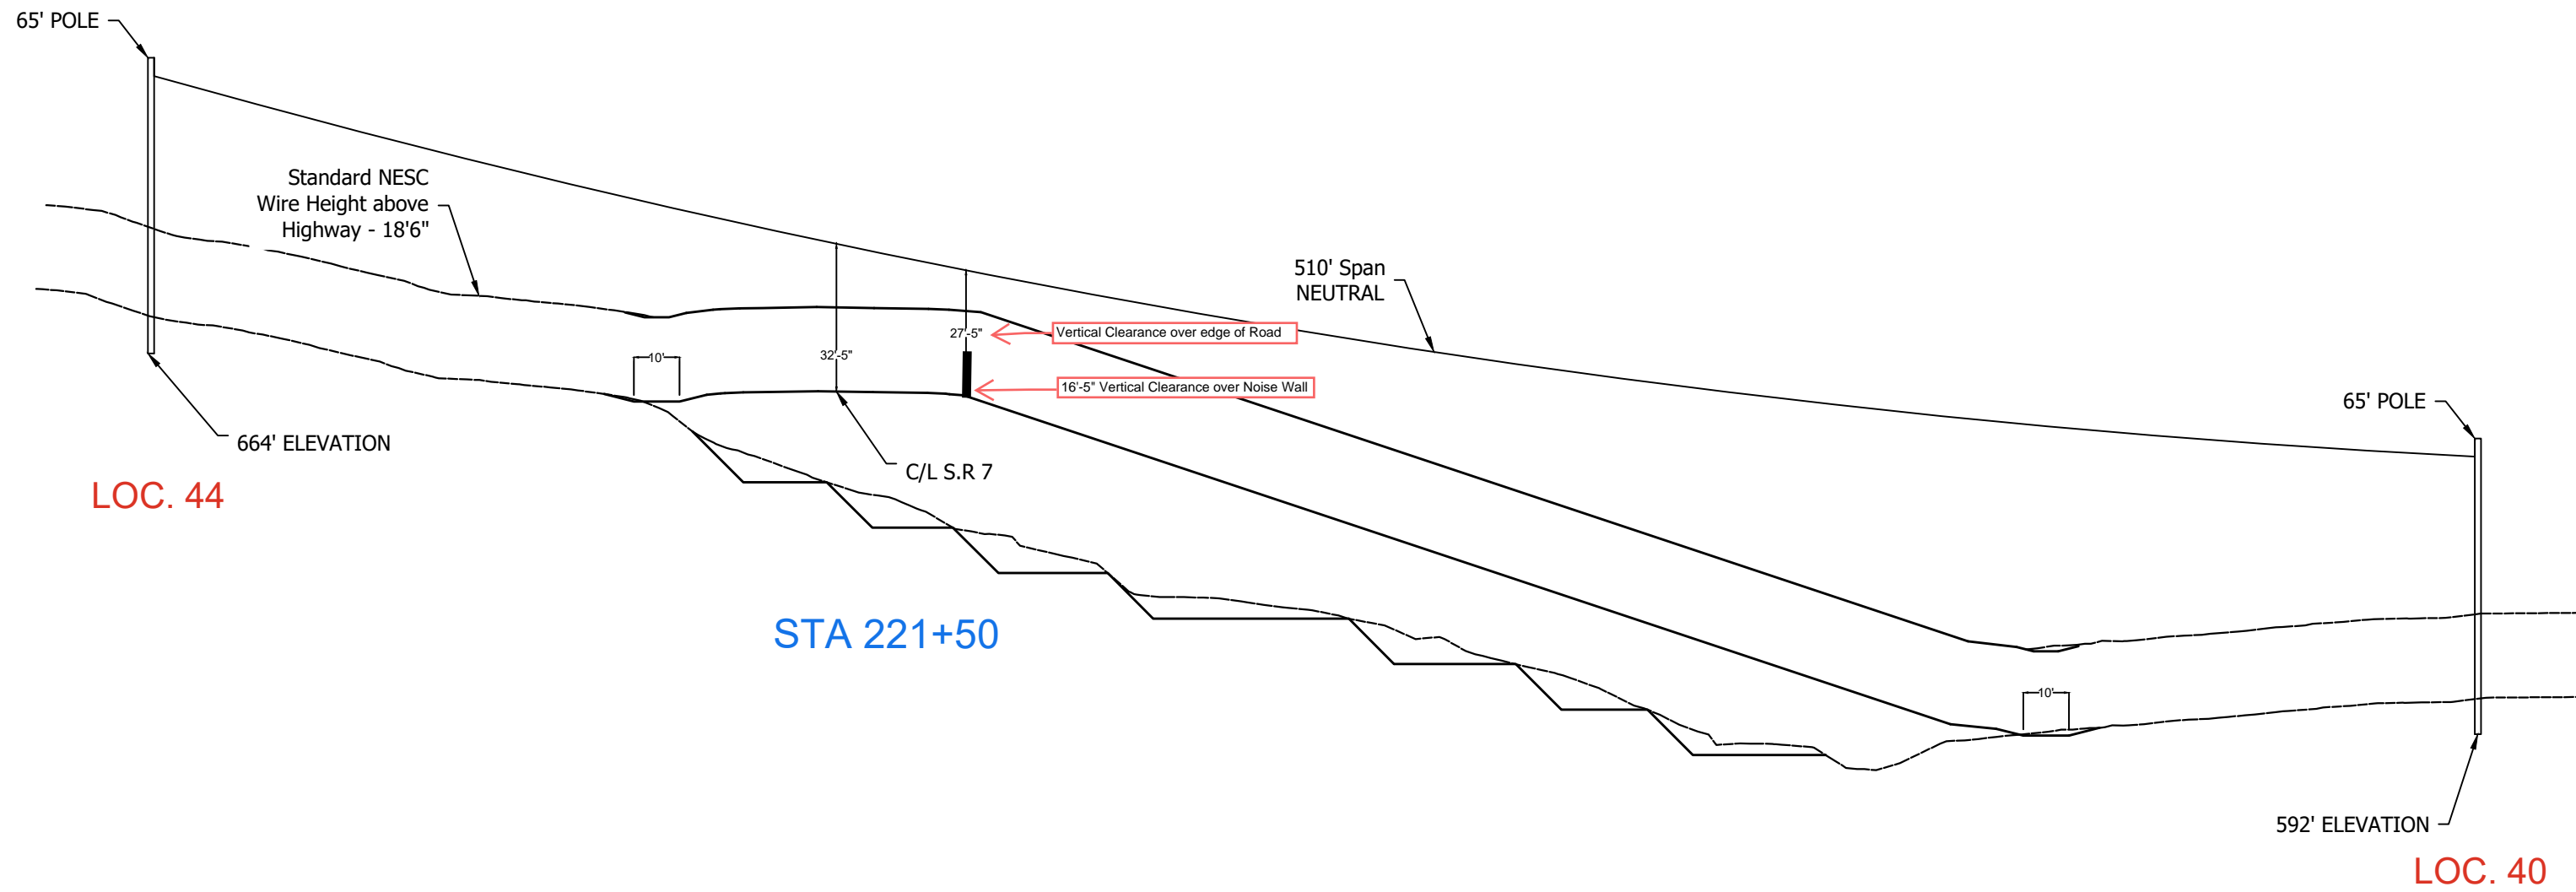

THIS DRAWING IS DISTRIBUTED UPON THE CONDITION THAT IT IS NOT TO BE REPRODUCED OR BE COPIED, IN WHOLE OR IN PART WITHOUT THE EXPRESSED WRITTEN CONSENT OF POWER SYSTEM ENGINEERING, INC.					 www.powersystem.org 2327-A State Route 821 Marietta, OH 45750 Tel: 740.568.9221	BRECS.R. 7 ROAD CROSSING STATION 221.5		PROJECT NO. OH00623187	DRAWING NO. 400
	NO.	REVISION AND RECORD OF ISSUE	BY	ENGR.		DATE	ENGR. APPD.	DATE	SCALE NTS

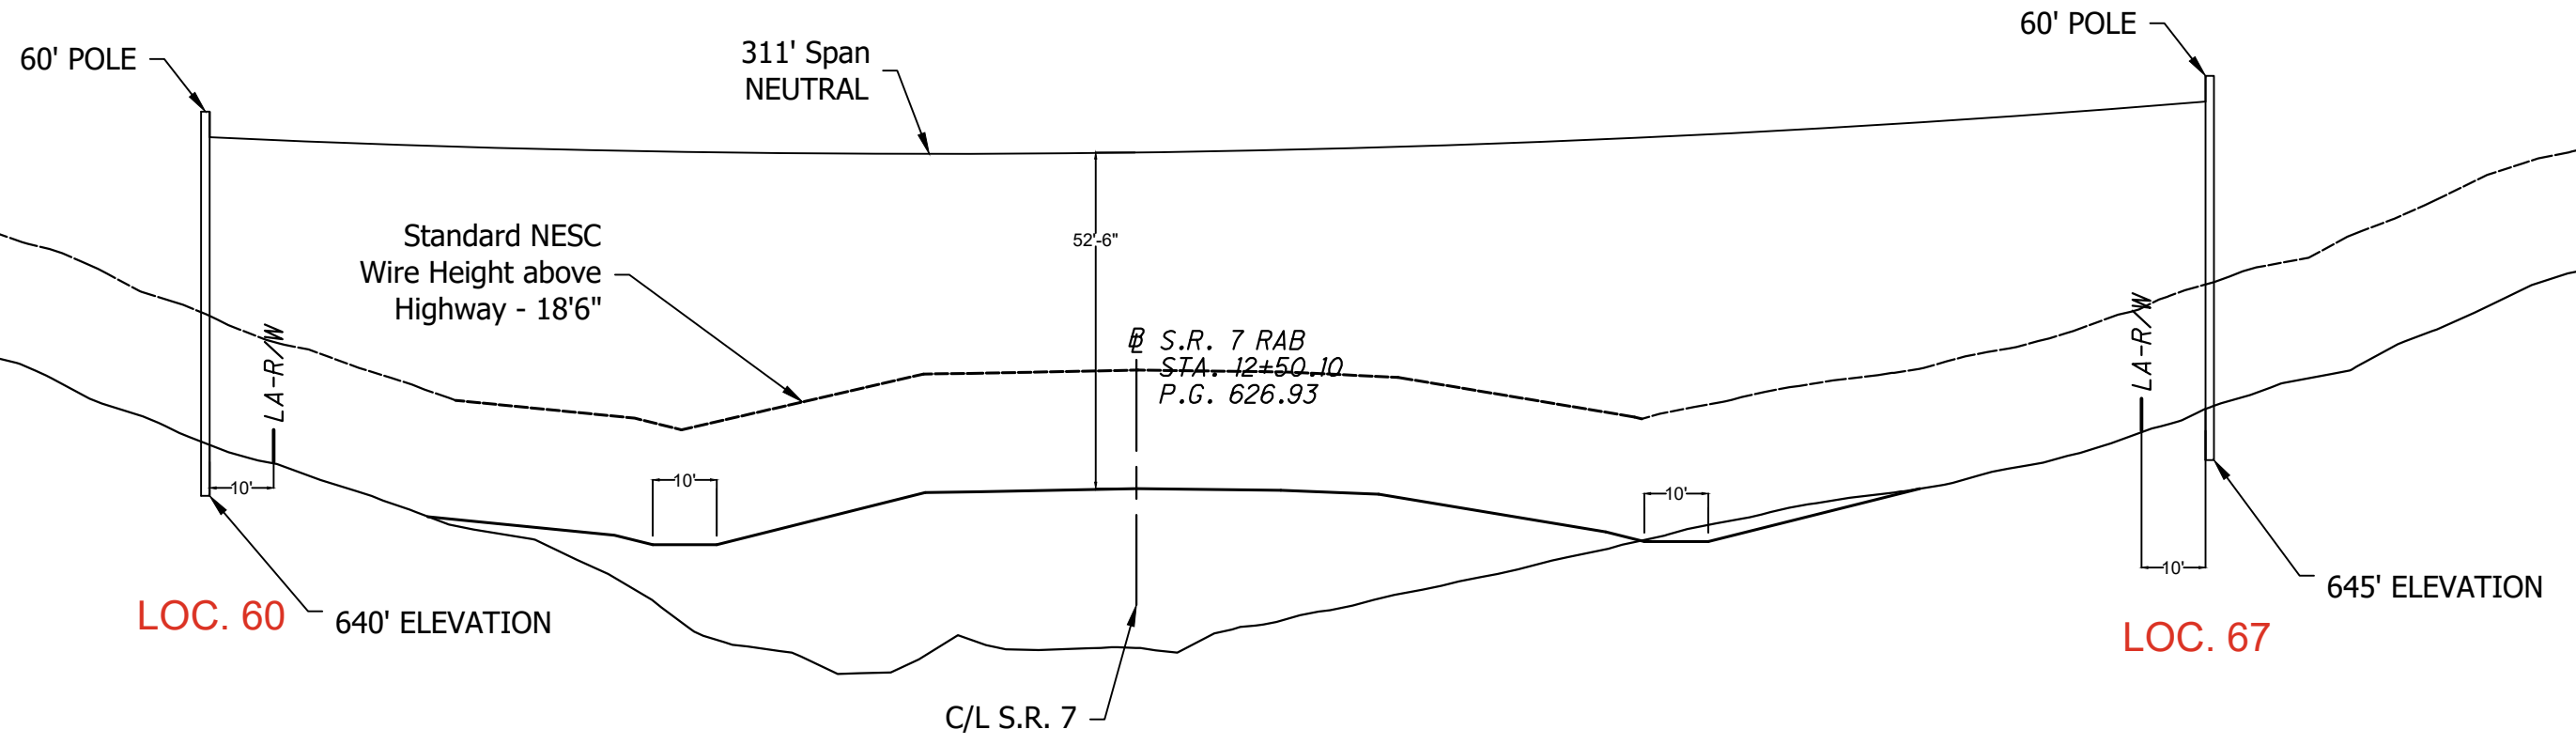


STA 248+50

THIS DRAWING IS DISTRIBUTED UPON THE CONDITION THAT IT IS NOT TO BE REPRODUCED OR BE COPIED, IN WHOLE OR IN PART WITHOUT THE EXPRESSED WRITTEN CONSENT OF POWER SYSTEM ENGINEERING, INC.	www.powersystem.org			PSE Power System Engineering, Inc. 2327-A State Route 821 Marietta, OH 45750 Tel: 740.568.9221		BREC S.R. 7 ROAD CROSSING STA 248+50		SCALE: NTS	PROJECT NO.: OH00623187	DRAWING NO.: 400
	ENGR. - DWN. BY -	CHK'D/ APP'D - DATE -	NO. - REVISION AND RECORD OF ISSUE	BY - ENGR. - DATE -	ENGR. - DATE -	FILE NAME: BREC S.R. 7 CROSSING 3				

Vertical Clearance for State Route 7 and County Route 69 for Communication Lines


Not to Scale

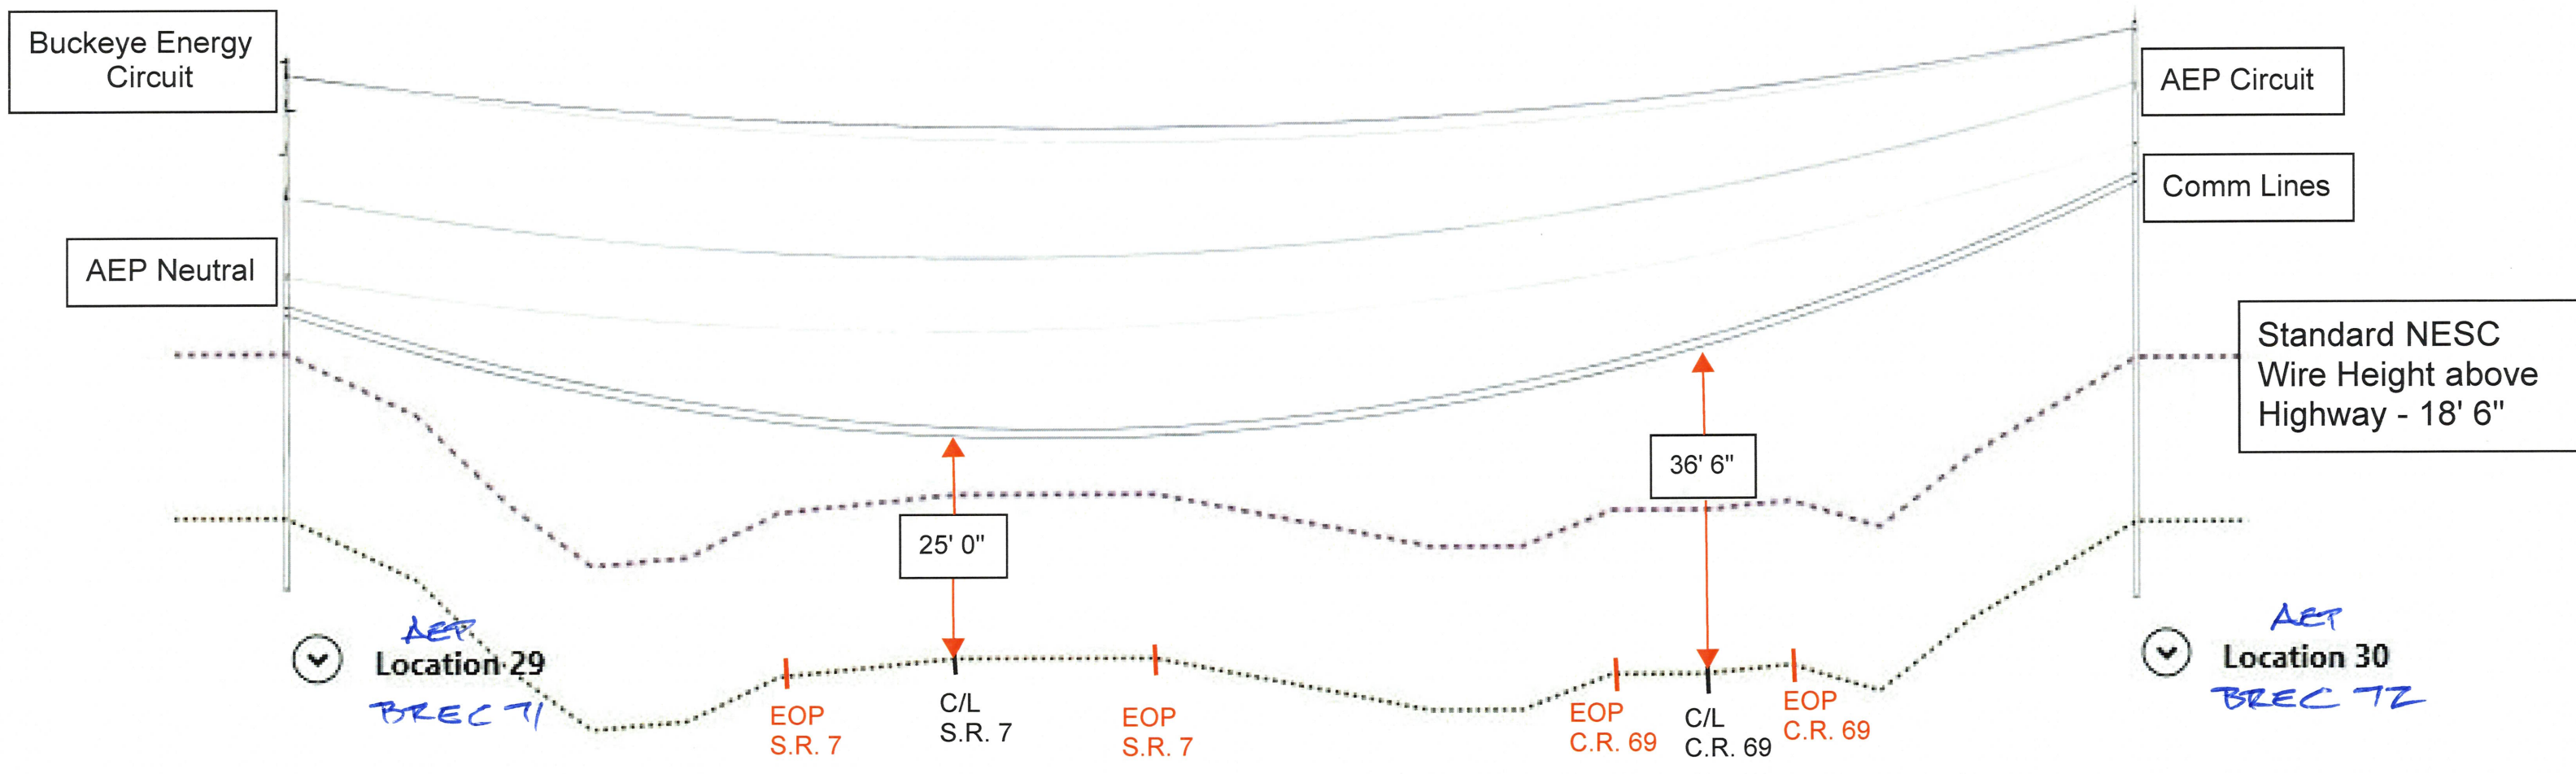

Note: There are 2 total communication lines on this span. Heights shown are vertical clearance to lowest communication line. All communication lines are spaced 1 foot apart from each other.

Vertical Clearance for State Route 7 and County Route 69 for AEP Circuit

Not to Scale

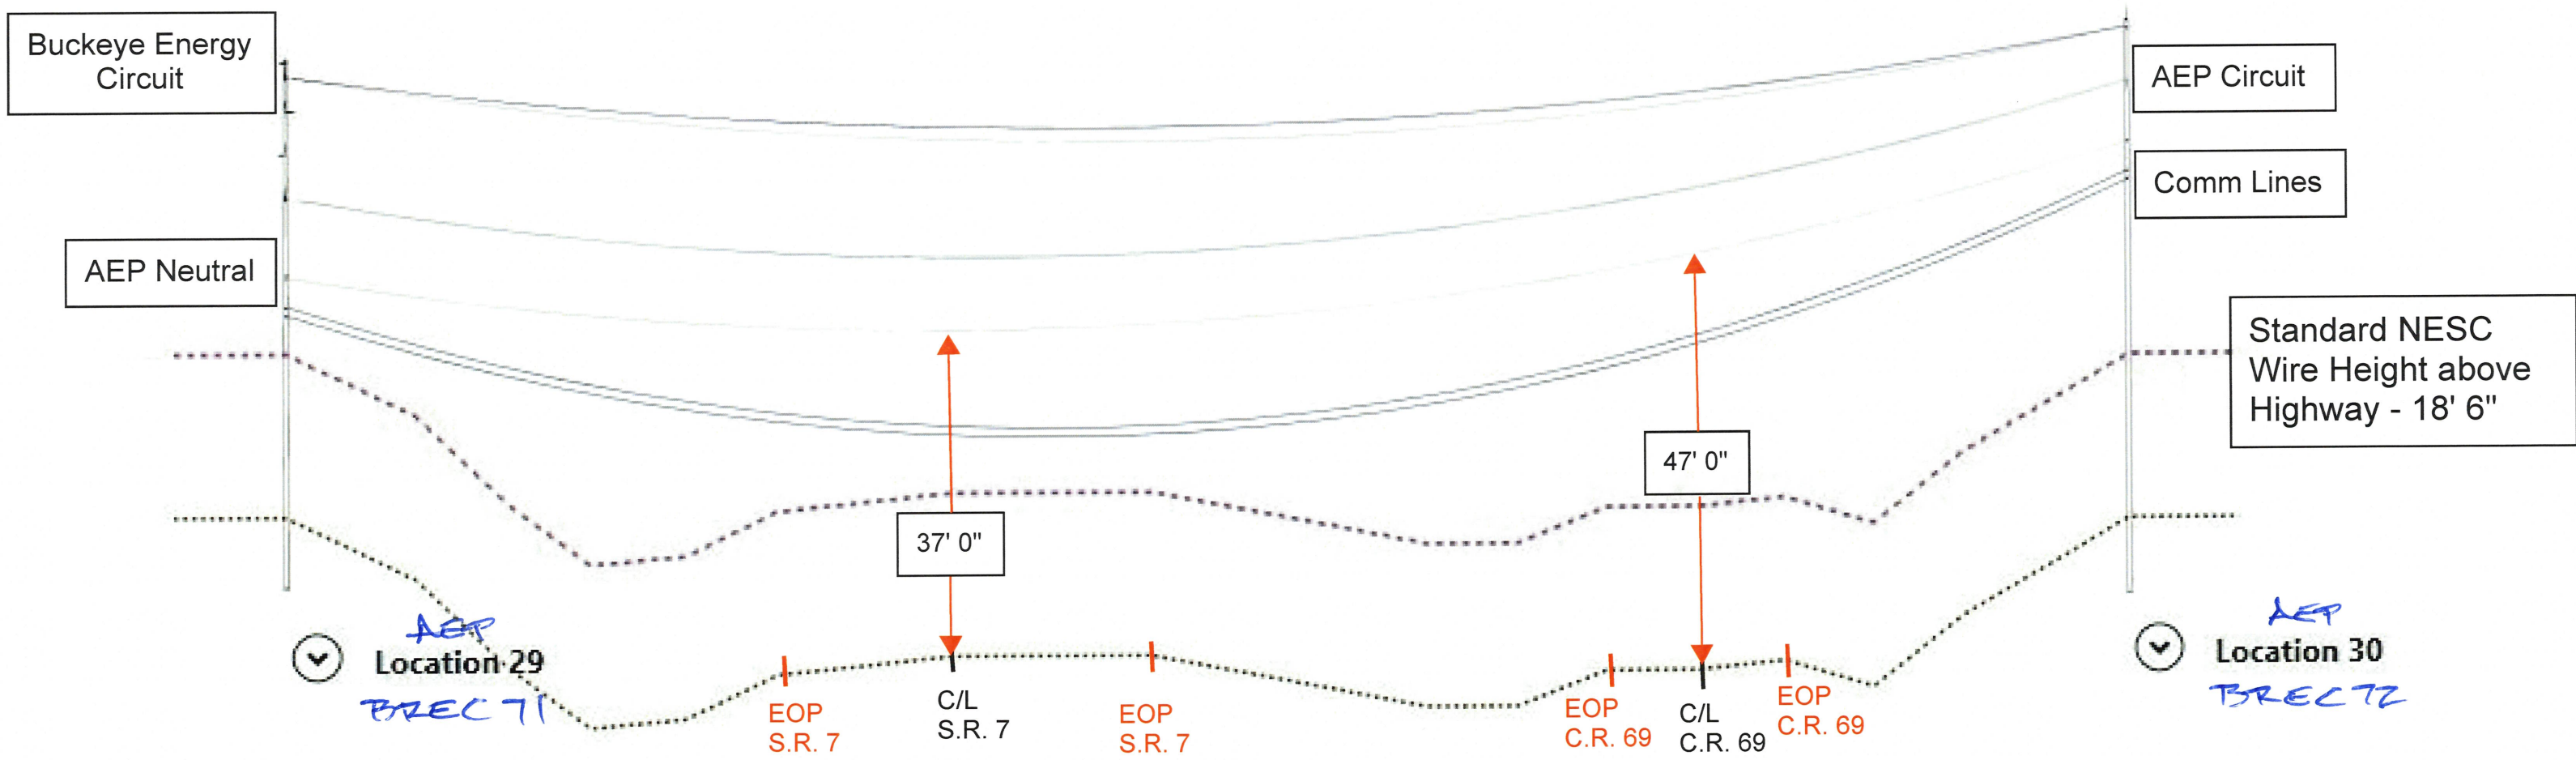

Note: AEP circuit as bottom circuit pole attachment. One 3 phase circuit with neutral below circuit. Heights shown are for lowest hanging AEP wire. (Buckeye Rural Energy as top circuit)