
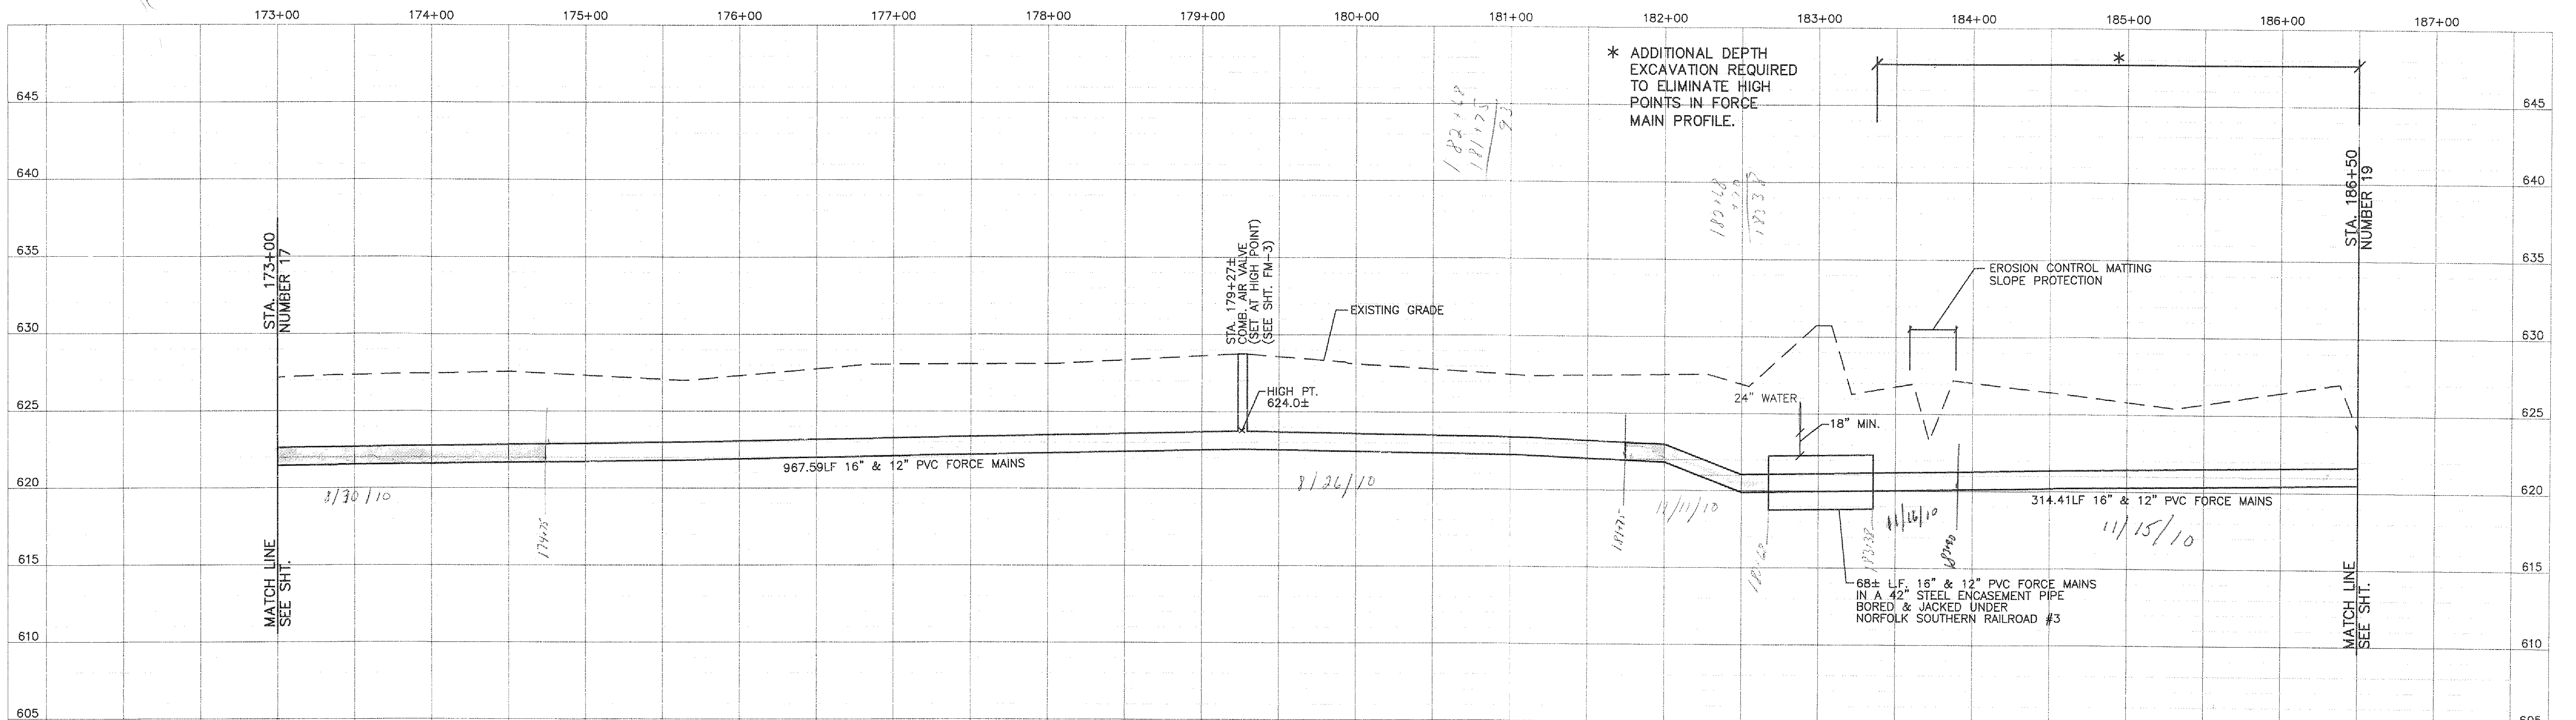


PRINTED: 10/15/2009 @ 4:22PM

FILE NAME: U:\3328\05\Cadd\3328-05-18.dwg

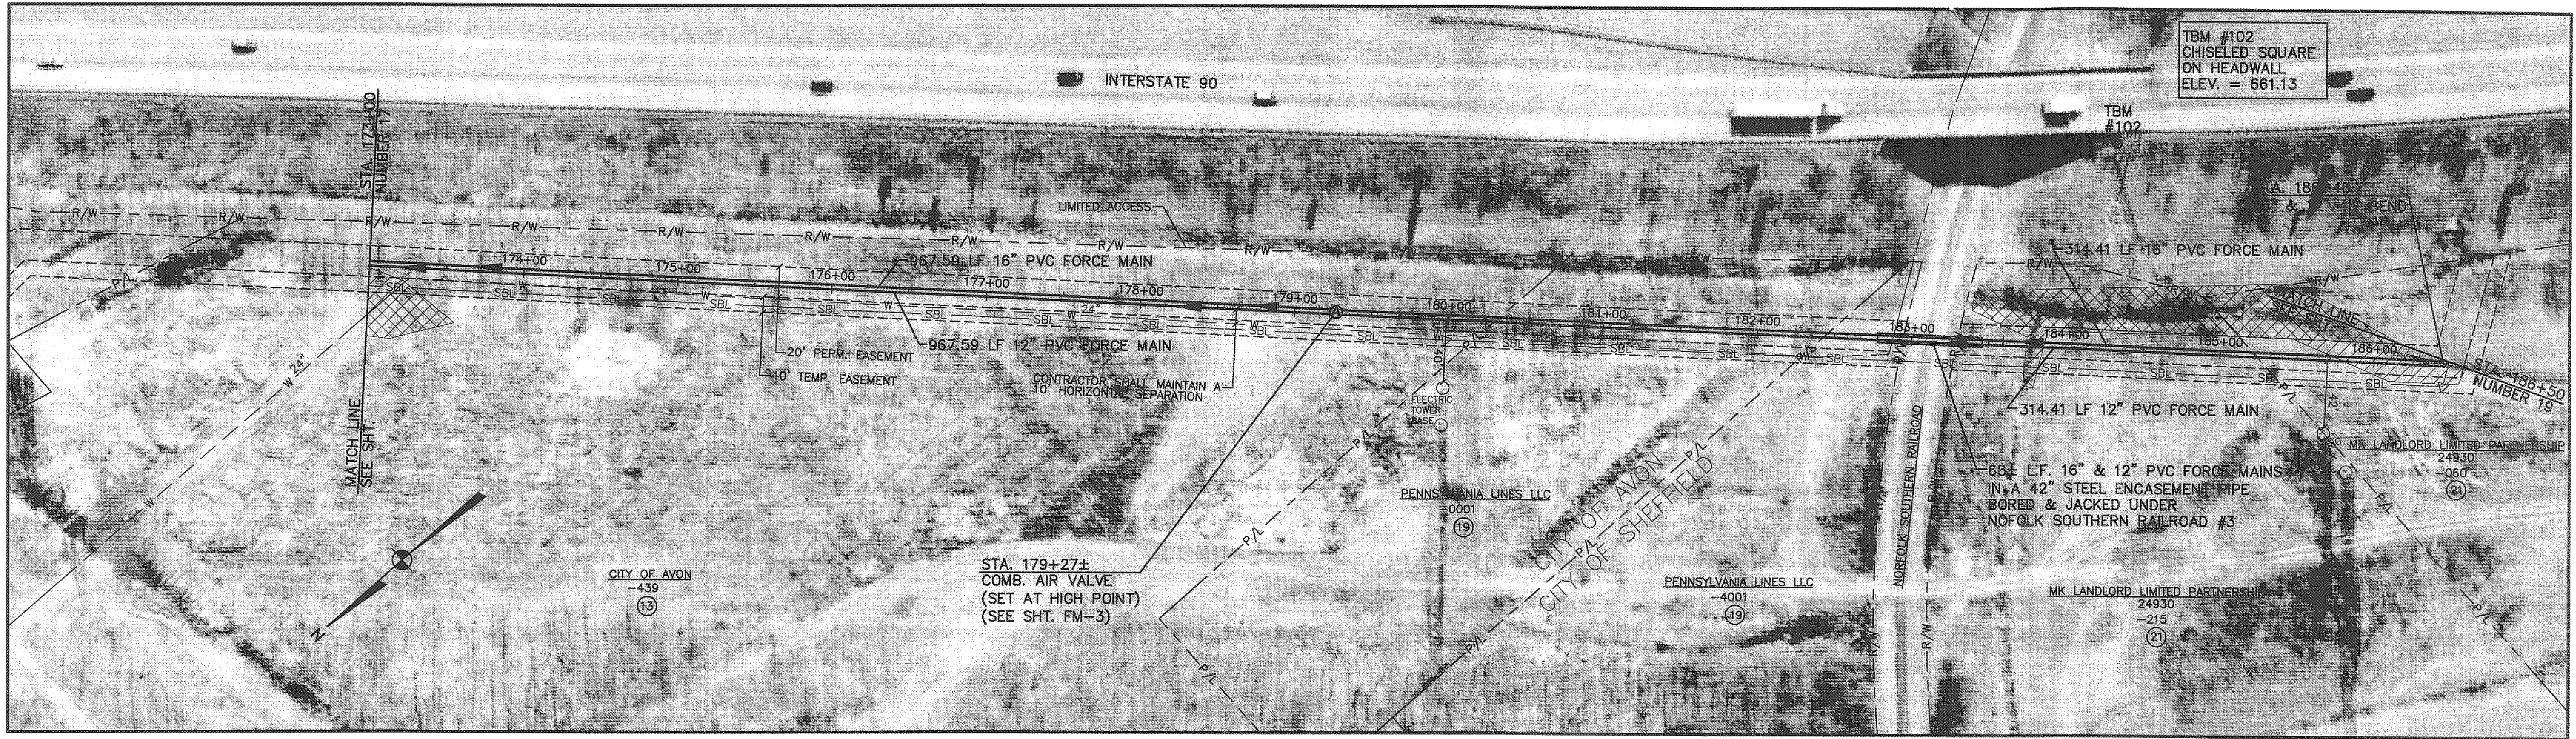

* ADDITIONAL DEPTH
EXCAVATION REQUIRED
TO ELIMINATE HIGH
POINTS IN FORCE
MAIN PROFILE.

CONTRACT 5A
GRW PROJECT NO. 3328-05
STA. 173+00 TO STA. 186+50
WASTEWATER FORCE MAIN
CONTRACT 5A
AVON LAKE MUNICIPAL UTILITIES

DESIGNED:	KAZ	DATE:	JANUARY, 2009
DRAWN:	RLT	SCALE:	1" = 50' Horiz. 1" = 5' Vert.
REVIEWED:	RCS	DWG. NO.:	18
APPROVED:	RCS		

GRW Engineers, Inc.
Engineers, Architects, Planners
LEXINGTON LOUISVILLE NASHVILLE DAYTON/SPRINGFIELD
PURE MARIETTA EVANSTON ARLINGTON

2/26/09

CONSTRUCTION DOCUMENTS

ALL RIGHTS RESERVED.
THIS DOCUMENT IS THE PROPERTY OF GRW ENGINEERS, INC. AND SHALL NOT BE REPRODUCED IN WHOLE OR IN PART OR USED FOR CONSTRUCTION OF OTHER THAN THIS SPECIFIC PROJECT WITHOUT WRITTEN PERMISSION OF GRW ENGINEERS, INC.

BIDDING DOCUMENTS ISSUED	3/05/09		
NO.	DESCRIPTION	DATE	BY
	REVISIONS		

