

UNLESS OTHERWISE NOTED, UTILITY LINE LIMITS DEPICTED REPRESENT FIELD DESIGNATING LIMITS AND NOT ENDPOINT OF UTILITIES.

ELECTRIC — — — — E — — — — —

CABLE TV — — — — FO — — — — —

TELEPHONE — — — — T — — — — —

WATER — — — — W — — — — —

GAS — — — — G — — — — —

FIBER OPTIC — — — — FO — — — — —

STORM DRAIN - - - - -

TC SIGNAL

SANITARY — — — — SAN — — — — —

UNKNOWN - - - - -

END OF INFORMATION S

T2UE TEST HOLE ⊗

UNLESS OTHERWISE NOTED, UTILITY LINE LIMITS DEPICTED REPRESENT FIELD DESIGNATING LIMITS AND NOT ENDPOINT OF UTILITIES.

ELECTRIC — — — — E — — — — —

CABLE TV — — — — FO — — — — —

TELEPHONE — — — — T — — — — —

WATER — — — — W — — — — —

GAS — — — — G — — — — —

FIBER OPTIC — — — — FO — — — — —

STORM DRAIN - - - - -

TC SIGNAL

SANITARY — — — — SAN — — — — —

UNKNOWN - - - - -


END OF INFORMATION S

T2UE TEST HOLE ⊗

UTILITY CONTACTS

COLUMBIA GAS OF OHIO
ADAM WOODIE, P.E.
3101 NORTH RIDGE ROAD E
LORAIN, OHIO 44055
440-242-5672 (Cell)
awoodie@nsource.com

RURAL LORAIN COUNTY WATER AUTHORITY
JOE DEMCZYK
42401 S.R. 303, P.O. BOX 567
LAGRANGE, OHIO 44050
440-355-5121
jdemczyk@rlcwa.com

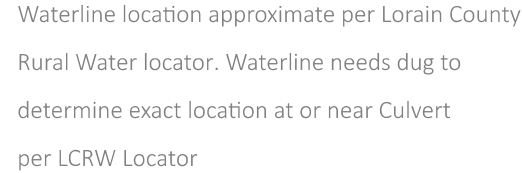

PH09501904