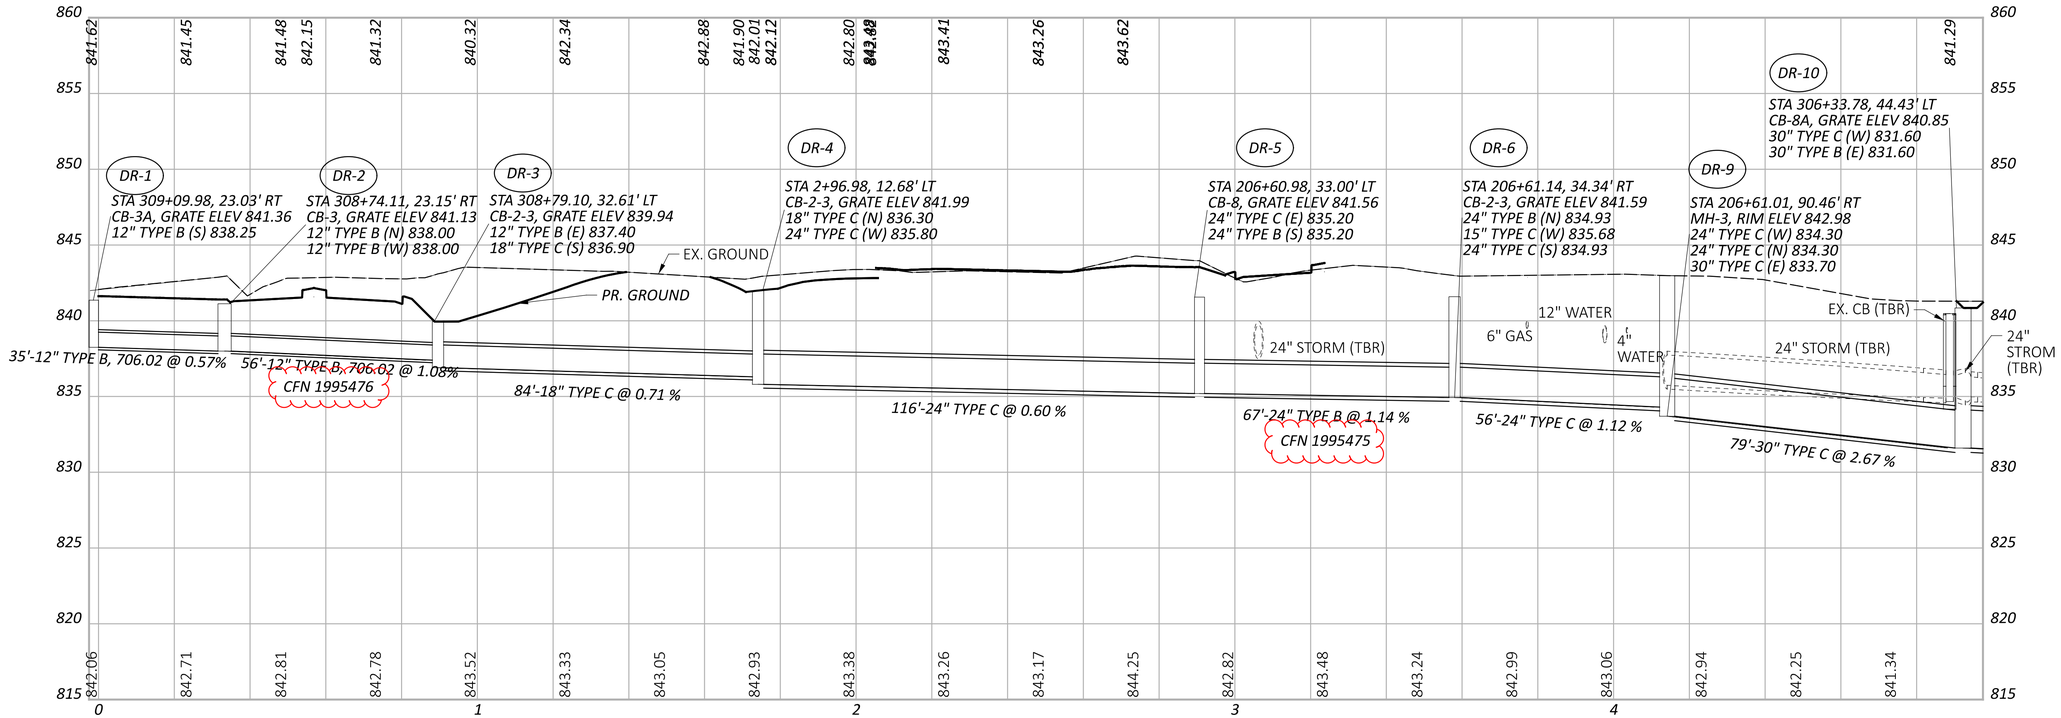

STORM SEWER PROFILES
DR-1 TO DR-11

DESIGN AGENCY
Mead & Hunt

CLIENT

DESIGNER	TK
REVIEWER	SJS 10-14-24
PROJECT ID	118318
SHEET	P.71
TOTAL	103

L0R-20-2.05

MODEL: Profile Run - Profile 1 [Sheet] PAPERSIZE: 34x22 (in.) DATE: 1/6/2025 TIME: 8:50:03 AM USER: 02676
pw:\\ohiodot-pw.bentley.com:ohiodot-pw-02\Documents\01 Active Projects\District 03\Lorain\118318\401-Engineering_MeadHunt\Drainage\Sheets\118318_DF001.dgn