

61 TREES TO BE REMOVED  
WITHIN CONSTRUCTION LIMITS  
BASED ON THE SURVEY BASEMAP  
PROVIDED BY ODOT FOR  
PROJECT BID



0 25 50 100  
HORIZONTAL  
SCALE IN FEET


CALCULATED  
PEK  
CHECKED  
PRS

PROJECT TREE COUNT  
STA 547+00 TO STA 561+50

APPROVED FOR CONSTRUCTION 5-23-2013

MAD-70-10.27

14  
97

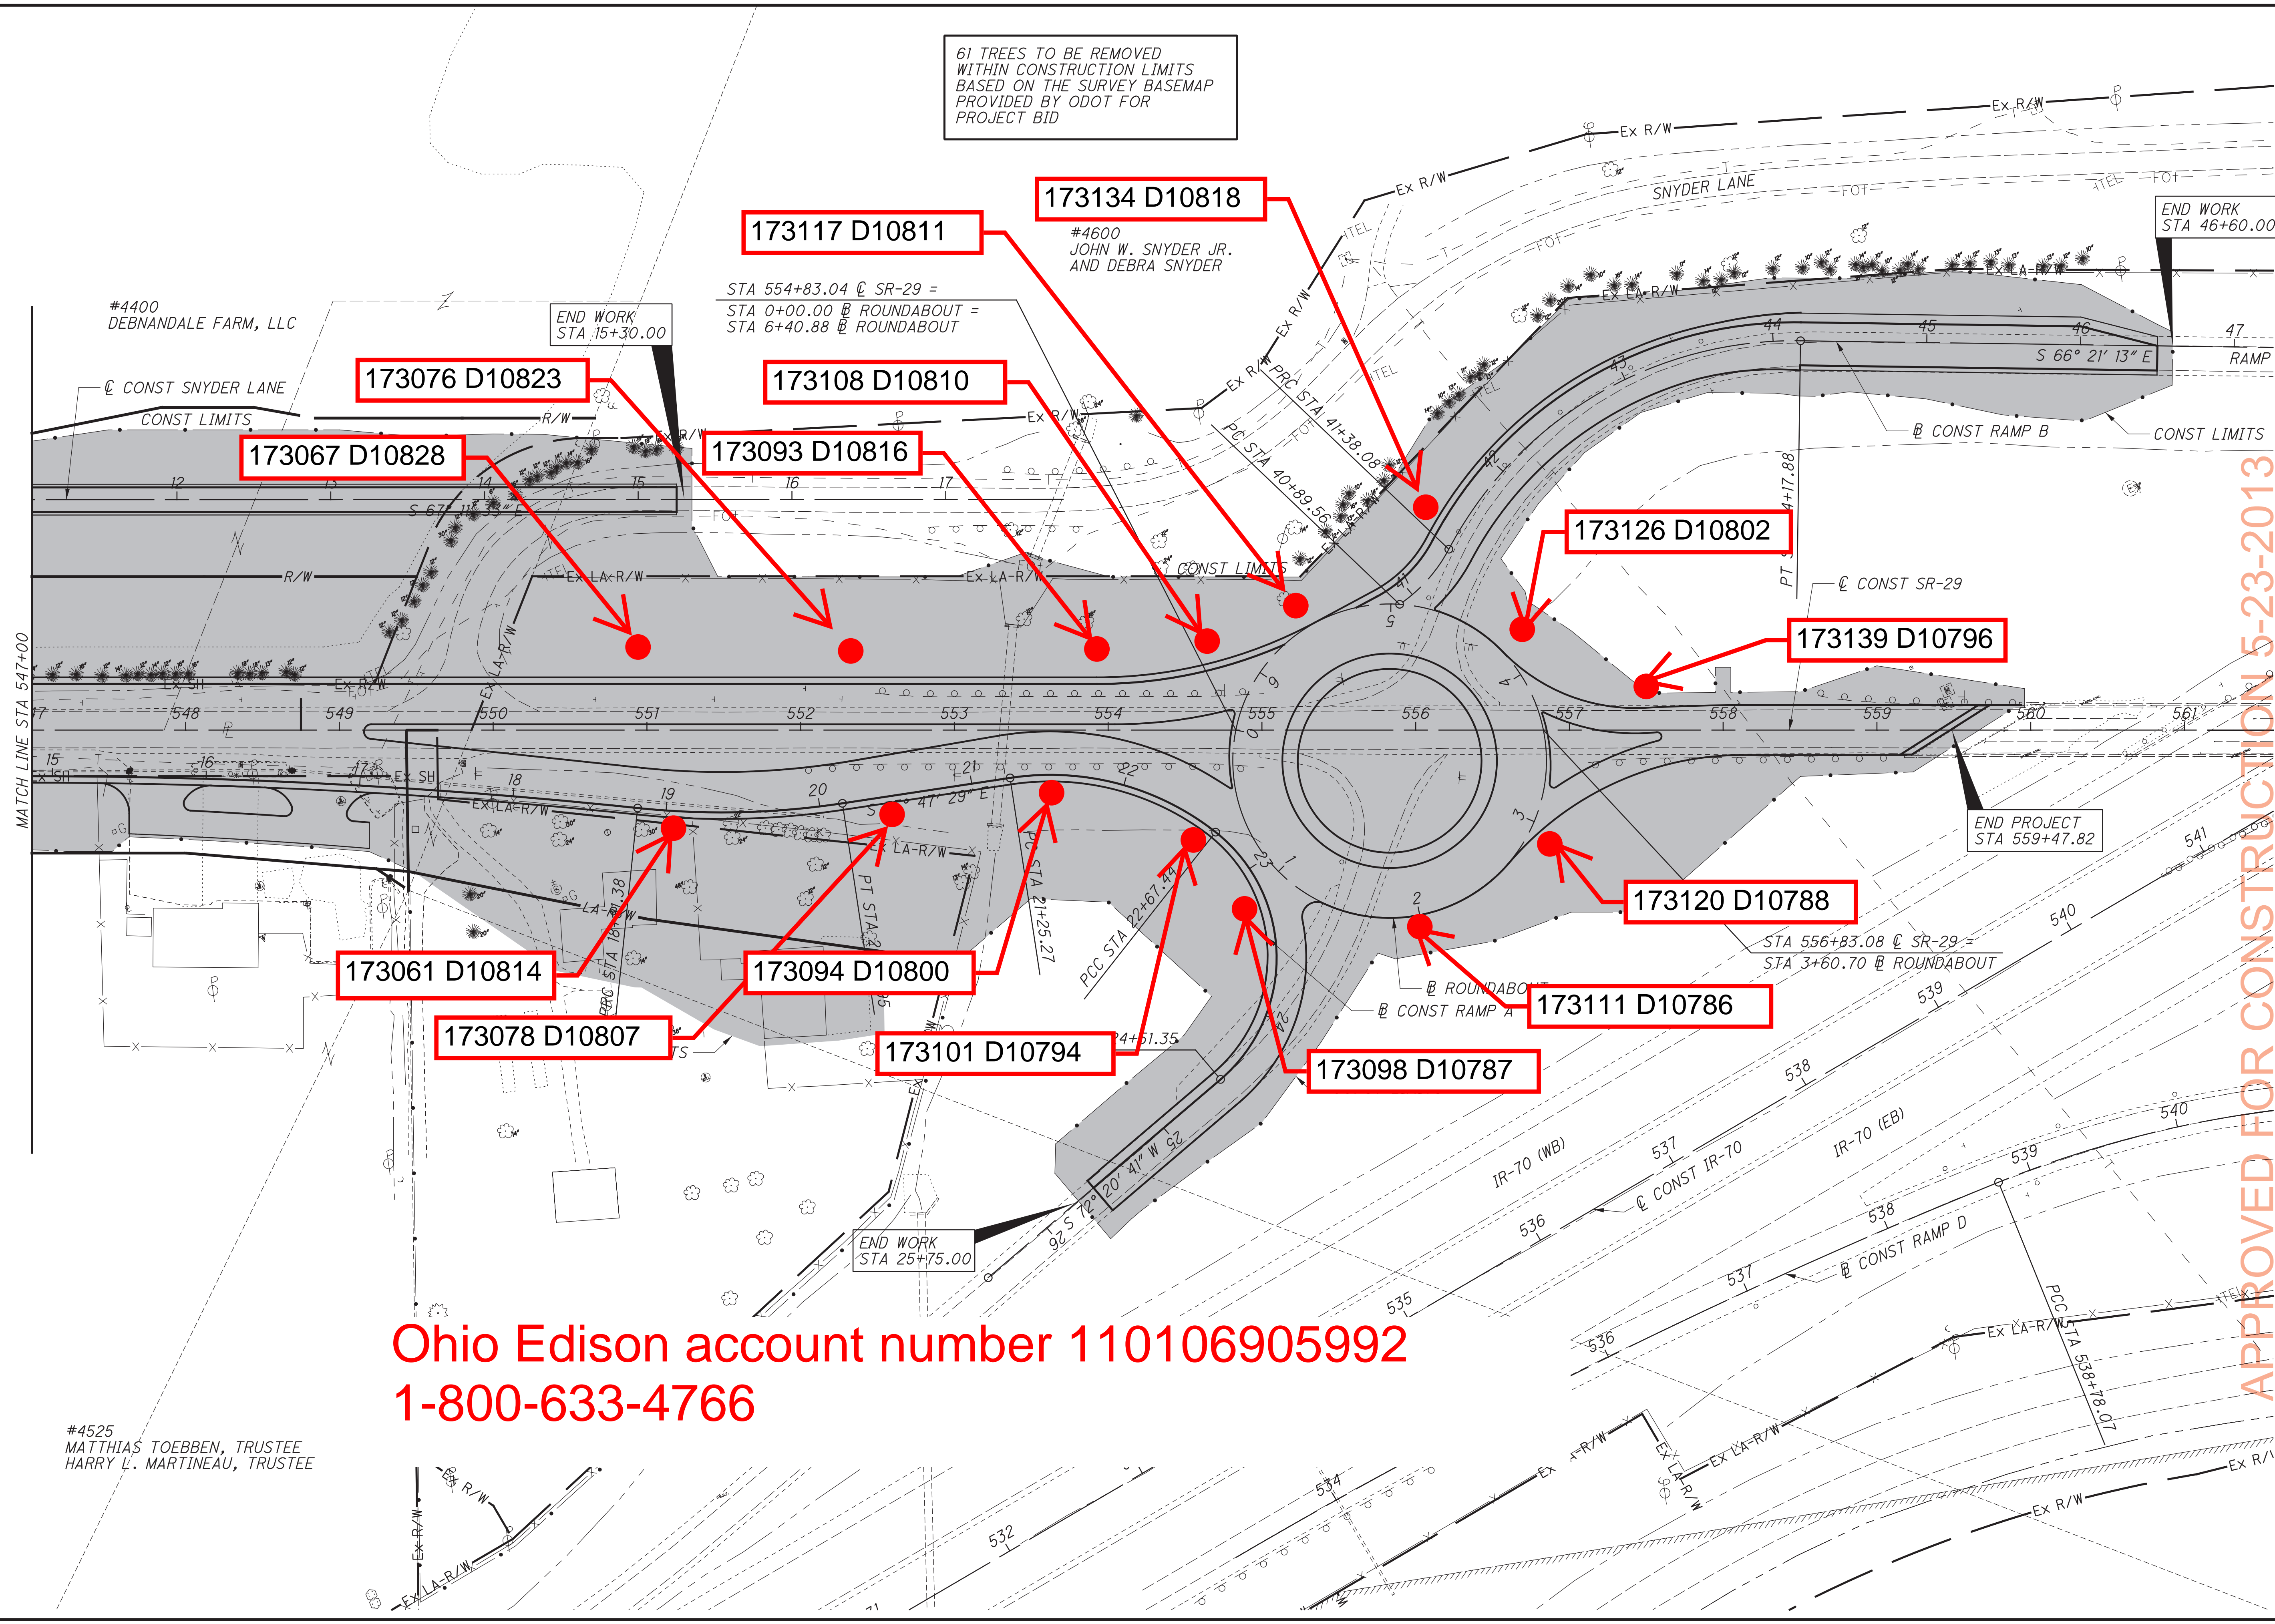

#4400  
DEBNANDALE FARM, LLC

#4525  
MATTHIAS TOEBBEN, TRUSTEE  
HARRY L. MARTINEAU, TRUSTEE

STA 554+83.04 @ SR-29 =  
STA 0+00.00 @ ROUNDABOUT =  
STA 6+40.88 @ ROUNDABOUT

STA 556+83.08 @ SR-29 =  
STA 3+60.70 @ ROUNDABOUT

Ohio Edison account number 110106905992  
1-800-633-4766

c:\pwworking\gfpw01\wbinkley\d0164699\83245GP002\_trees.dgn 5/16/2013 1:05:42 PM wbinkley