

STATE OF OHIO
DEPARTMENT OF TRANSPORTATION

MAH-680-0.68 / 3.73

**AUSTINTOWN TOWNSHIP
CITY OF YOUNGSTOWN
MAHONING COUNTY**

PROJECT DESCRIPTION

THIS PROJECT CONSISTS OF A DECK REPLACEMENT ON STRUCTURE MAH-680-0068 (FOUR MILE RUN ROAD) OVER I.R. 680 AND SUPERSTRUCTURE REPLACEMENT ON STRUCTURE MAH-680-0373 (BELLE VISTA AVENUE) OVER I.R. 680. ALSO INCLUDES MINIMAL APPROACH ROADWAY WORK.

EARTH DISTURBED AREAS - MAH-680-0.68

PROJECT EARTH DISTURBED AREA: 0.5 ACRES
ESTIMATED CONTRACTOR EARTH DISTURBED AREA: 0.3 ACRES
NOTICE OF INTENT EARTH DISTURBED AREA: N/A
(NOI NOT REQUIRED)

EARTH DISTURBED AREAS - MAH-680-3.73

PROJECT EARTH DISTURBED AREA: 0.5 ACRES
ESTIMATED CONTRACTOR EARTH DISTURBED AREA: 0.3 ACRES
NOTICE OF INTENT EARTH DISTURBED AREA: N/A
(NOI NOT REQUIRED)

LIMITED ACCESS

THIS IMPROVEMENT IS ESPECIALLY DESIGNED FOR THROUGH TRAFFIC AND HAS BEEN DECLARED A LIMITED ACCESS HIGHWAY OR FREEWAY BY ACTION OF THE DIRECTOR IN ACCORDANCE WITH THE PROVISIONS OF SECTION 5511.02 OF THE OHIO REVISED CODE.



2019 SPECIFICATIONS

THE STANDARD SPECIFICATIONS OF THE STATE OF OHIO, DEPARTMENT OF TRANSPORTATION, INCLUDING SUPPLEMENTAL SPECIFICATIONS LISTED IN THE PLANS AND CHANGES LISTED IN THE PROPOSAL SHALL GOVERN THIS IMPROVEMENT.

I HEREBY APPROVE THESE PLANS AND DECLARE THAT THE MAKING OF THIS IMPROVEMENT WILL NOT REQUIRE THE CLOSING TO TRAFFIC OF THE HIGHWAY EXCEPT FOR THE SIDE ROADS AS DESCRIBED ON SHEETS 8-13 AND THAT PROVISIONS FOR THE MAINTENANCE AND SAFETY OF TRAFFIC WILL BE AS SET FORTH ON THE PLANS AND ESTIMATES.

APPROVED: *[Signature]*
DATE: 6/24/21 DISTRICT DEPUTY DIRECTOR

APPROVED: _____
DATE: _____ DIRECTOR, DEPARTMENT OF TRANSPORTATION

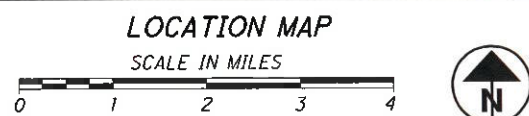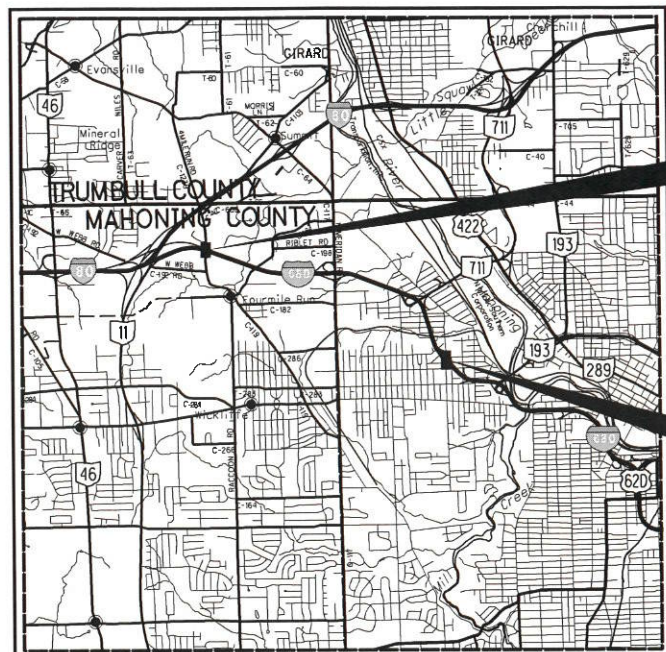

PORTION TO BE IMPROVED	_____
INTERSTATE HIGHWAY	_____
FEDERAL ROUTES	_____
STATE ROUTES	_____
COUNTY & TOWNSHIP ROADS	_____
OTHER ROADS	_____

DESIGN DESIGNATION

	FOUR MILE RUN RD.	BELLE VISTA AVE.
CURRENT ADT (2020)	6200	6600
DESIGN YEAR ADT (2040)	7300	7800
DESIGN HOURLY VOLUME (2040)	730	780
DIRECTIONAL DISTRIBUTION	0.60	0.60
TRUCKS (24 HOUR B&C)	3%	3%
DESIGN SPEED	40 MPH	40 MPH
LEGAL SPEED	35 MPH	35 MPH
DESIGN FUNCTIONAL CLASSIFICATION:		
05 - MAJOR COLLECTOR (URBAN) - FOUR MILE RUN RD.		
05 - MAJOR COLLECTOR (URBAN) - BELLE VISTA AVE.		
NHS PROJECT	NO	NO

DESIGN EXCEPTIONS

NONE REQUIRED

ADA DESIGN WAIVERS

NONE REQUIRED

UNDERGROUND UTILITIES

Contact Two Working Days Before You Dig



OHIO811, 8-1-1, or 1-800-362-2764 (Non-members must be called directly)

PLAN PREPARED BY:
CARPENTER MARTY transportation
6812 SINGLETREE DRIVE COLUMBUS, OH 43229
614.556.2424 WWW.CMTTRAN.COM

INDEX OF SHEETS:

TITLE SHEET	1
TYPICAL SECTIONS	2-4
GENERAL NOTES	5-7
MAINTENANCE OF TRAFFIC	8-15
GENERAL SUMMARY	16-18
ESTIMATED QUANTITIES	19-20
PLAN & PROFILE - FOUR MILE RUN RD.	21-22
CROSS SECTIONS - FOUR MILE RUN RD.	23-27
PLAN & PROFILE - BELLE VISTA AVE.	28-29
CROSS SECTIONS - BELLE VISTA AVE.	30-35
PLAN - I.R. 680	36
DRIVE DETAILS	37-38, 37A
INTERSECTION DETAILS	39-40
CURB RAMP DETAILS	41
DRAINAGE DETAIL	42
WATER WORK	43-48
TRAFFIC CONTROL	49-53
FENCE PLAN	54
LIGHTING	55-57, 55A, 57A
STRUCTURES (OVER 20' SPAN):	
MAH-680-0068	58-79
MAH-680-0373	80-118, 82A
RIGHT-OF-WAY	119-126

ENGINEERS SEAL:
STRUCTURE MAH-680-0373

SIGNED: *[Signature]*
DATE: 6/22/2021

LOCATION	LATITUDE	LONGITUDE
1	41°07'35" N	80°44'15" W
2	41°06'30" N	80°41'20" W

ENGINEERS SEAL:
STRUCTURE MAH-680-0068

SIGNED: *[Signature]*
DATE: 6/22/2021

ENGINEERS SEAL:
FOR ENTIRE PLAN EXCEPT STRUCTURES OVER 20'

SIGNED: *[Signature]*
DATE: 6/22/2021

STANDARD CONSTRUCTION DRAWINGS										SUPPLEMENTAL SPECIFICATIONS		SPECIAL PROVISIONS	
BP-3.1	1/17/20	F-3.3	7/19/13	RM-1.1	1/15/21	HL-10.13	4/17/20	MT-101.75	1/17/20	800-2019	7/16/21	SP1	10/05/2018
BP-4.1	7/19/13	F-3.4	7/19/13	RM-4.2	4/17/20	HL-20.11	1/15/21	MT-101.90	7/17/20	813	10/19/18	SP2	9/25/2018
BP-5.1	1/18/19			RM-4.5	7/21/17	HL-20.14	4/17/20	MT-102.20	4/19/19	821	4/20/12		
BP-7.1	7/17/20	HW-2.1	7/20/18	RM-4.6	7/19/13	HL-30.11	1/15/21	MT-105.10	1/17/20	825	1/17/20		
		HW-2.2	7/20/18			HL-30.22	1/15/21	MT-110.10	7/19/13	832	10/19/18		
CB-1.1	7/19/19			AS-1-15	7/17/15	HL-30.32	4/17/20			840	1/15/21		
CB-2.2	1/15/21	MGS-1.1	1/19/18	AS-2-15	1/18/19	HL-40.20	7/17/20	TC-22.20	1/17/14	845	4/20/18		
		MGS-2.1	1/19/18	BR-2-15	7/17/15	HL-50.21	1/15/21	TC-41.20	10/18/13	863	10/17/14		
DM-1.1	7/17/20	MGS-3.1	1/19/18	EXJ-6-17	1/15/21	HL-60.11	7/21/17	TC-41.30	10/18/13	869	10/17/14		
DM-1.2	1/18/13	MGS-3.2	1/18/13	GSD-1-19	1/18/19	HL-60.31	1/17/20	TC-42.20	10/18/13	902	7/19/19		
DM-4.1	7/17/20	MGS-4.2	7/19/13	SBR-1-20	7/17/20			TC-52.10	10/18/13	913	4/21/17		
DM-4.3	1/15/16	MGS-4.3	1/18/13	SICD-1-96	7/18/14	MT-95.30	7/19/19	TC-52.20	1/15/21	921	4/20/12		
DM-4.4	1/15/16	MGS-6.2	7/19/19	SICD-2-14	7/18/14	MT-95.45	1/17/20	TC-61.10	1/17/20	922	4/18/14		
				VPF-1-90	7/20/18	MT-97.10	4/19/19	TC-61.30	7/19/19				
F-1.1	7/19/13	MH-1.1	1/15/16			MT-99.60	7/15/16	TC-71.10	1/19/18				
F-2.1	7/20/18	MH-1.2	1/15/16	HL-10.11	1/15/21	MT-101.60	1/17/20						
F-3.1	7/19/13			HL-10.12	1/20/17	MT-101.70	1/17/20						

P:\DDT\04\0022_MAH-680-00.68_03.73\105857\Design\Roadway\Sheets\105857_G1001.dgn_Sheet 6/22/2021 2:57:13 PM CMT1008

FEDERAL PROJECT NO. E171 (454)

PID NO. 105857

CONSTRUCTION PROJECT NO.

RAILROAD INVOLVEMENT NONE

MAH-680-0.68 / 3.73

REFER TO THE FOLLOWING STANDARD BRIDGE DRAWINGS:

AS-1-15	REVISED	7-17-2015
AS-2-15	REVISED	1-18-2019
BR-2-15	DATED	7-17-2015
EXJ-6-17	REVISED	1-15-2021
GSD-1-19	DATED	1-18-2019
SICD-1-96	REVISED	7-18-2014
SICD-2-14	DATED	7-18-2014
VPF-1-90	REVISED	7-20-2018

AND TO THE FOLLOWING SUPPLEMENTAL SPECIFICATIONS:

840	DATED	1-17-2020
845	DATED	4-20-2018
863	DATED	10-17-2014
869	DATED	10-17-2014

DESIGN SPECIFICATIONS:

THIS STRUCTURE CONFORMS TO THE 8TH EDITION OF THE "LRFD BRIDGE DESIGN SPECIFICATIONS" ADOPTED BY THE AMERICAN ASSOCIATION OF STATE HIGHWAY AND TRANSPORTATION OFFICIALS, 2017 AND THE ODOT BRIDGE DESIGN MANUAL, 2020.

SPECIAL DESIGN SPECIFICATIONS:

THIS BRIDGE REQUIRED THE USE OF A TWO DIMENSIONAL MODEL USING THE FINITE ELEMENT DESIGN METHOD TO ANALYZE THE STRUCTURE. THE COMPUTER PROGRAM USED FOR STRUCTURAL ANALYSIS WAS LEAP BRIDGE STEEL. THE BRIDGE COMPONENTS DESIGNED BY THIS METHOD WERE THE STEEL BEAMS AND CROSSFRAMES.

DEAD LOAD DISTRIBUTION: WEIGHT OF DECK AND STEEL BEAMS WERE USED FOR THE NON-COMPOSITE DEAD LOAD BASED ON TRIBUTARY AREA. THE WEIGHT OF THE APPURTENANCES AND FUTURE WEARING SURFACE COURSE WERE DIVIDED EQUALLY AMONG THE BEAMS FOR THE COMPOSITE DEAD LOAD.

LIVE LOAD DISTRIBUTION FACTORS:

EXTERIOR MEMBERS - DIRECT LANE LOADING FOR WHEEL (OR AXLE) LOAD & FOR LANE LOAD MOMENTS. DIRECT LANE LOADING FOR WHEEL (OR AXLE) LOAD & LANE LOAD SHEARS.

INTERIOR MEMBERS - DIRECT LANE LOADING FOR WHEEL (OR AXLE) LOAD & FOR LANE LOAD MOMENTS. DIRECT LANE LOADING FOR WHEEL (OR AXLE) LOAD & LANE LOAD SHEARS.

DESIGN LOADING:

HL-93 (SUPERSTRUCTURE)

CF 2000(57) (SUBSTRUCTURE)

FUTURE WEARING SURFACE (FWS) OF 0.060 KIPS/FT²

DESIGN DATA:

CONCRETE CLASS QC2 WITH QC/OA - COMPRESSIVE STRENGTH 4.5 KSI (SUPERSTRUCTURE)

CONCRETE CLASS QC1 - COMPRESSIVE STRENGTH 4.0 KSI (SUBSTRUCTURE)

REINFORCING STEEL - MINIMUM YIELD STRENGTH 60 KSI

STRUCTURAL STEEL - ASTM A709 GRADE 50 - YIELD STRENGTH 50 KSI

DECK PROTECTION METHOD:

EPOXY COATED REINFORCING STEEL

2 1/2" CONCRETE COVER

MONOLITHIC WEARING SURFACE:

MONOLITHIC WEARING SURFACE IS ASSUMED, FOR DESIGN PURPOSES, TO BE 1 INCH THICK.

ITEM 202 - PORTIONS OF STRUCTURE REMOVED, OVER 20 FOOT SPAN, AS PER PLAN:

THIS ITEM SHALL INCLUDE THE ELEMENTS INDICATED IN THE PLANS AND GENERAL NOTES AND THAT ARE NOT SEPARATELY LISTED FOR PAYMENT, EXCEPT FOR WEARING COURSE REMOVAL. ITEMS TO BE REMOVED INCLUDE ALL EXISTING MATERIALS BEING REPLACED BY NEW CONSTRUCTION AND MISCELLANEOUS ITEMS THAT ARE NOT SHOWN TO BE INCORPORATED INTO THE FINAL CONSTRUCTION AND ARE DIRECTED TO BE REMOVED BY THE ENGINEER. THE USE OF EXPLOSIVES, HEADACHE BALLS AND/OR HOE-RAMS WILL NOT BE PERMITTED. THE METHOD OF REMOVAL AND THE WEIGHT OF HAMMER SHALL BE APPROVED BY THE ENGINEER. PERFORM ALL WORK IN A MANNER THAT WILL NOT CUT, ELONGATE OR DAMAGE THE EXISTING REINFORCING STEEL TO BE PRESERVED. CHIPPING HAMMERS SHALL NOT BE HEAVIER THAN THE NOMINAL 90-POUND CLASS. PNEUMATIC HAMMERS SHALL NOT BE PLACED IN DIRECT CONTACT WITH REINFORCING STEEL THAT IS TO BE RETAINED IN THE REBUILT STRUCTURE. SUBMIT CONSTRUCTION PLANS ACCORDING TO C&MS 501.05

CUT LINE CONSTRUCTION JOINT PREPARATION: SAW CUT BOUNDARIES OF PROPOSED CONCRETE REMOVALS 1 INCH DEEP. REMOVE CONCRETE TO A ROUGH SURFACE. LEAVE THE EXISTING REINFORCING STEEL, IF REQUIRED IN THE PLANS, IN PLACE. INSTALL DOWEL BARS IF SPECIFIED. PRIOR TO CONCRETE PLACEMENT ABRASIVELY CLEAN JOINT SURFACES AND EXISTING EXPOSED REINFORCEMENT TO REMOVE LOOSE AND DISINTEGRATED CONCRETE AND LOOSE RUST. THOROUGHLY CLEAN THE JOINT SURFACE AND EXPOSED REINFORCEMENT OF ALL DIRT, DUST, RUST, OR OTHER FOREIGN MATERIAL BY THE USE OF WATER, AIR UNDER PRESSURE, OR OTHER METHODS THAT PRODUCE SATISFACTORY RESULTS. EXISTING REINFORCING STEEL DOES NOT HAVE TO HAVE A BRIGHT STEEL FINISH, BUT REMOVE ALL PACK AND LOOSE RUST. THOROUGHLY DRENCH EXISTING CONCRETE SURFACES WITH CLEAN WATER AND ALLOW TO DRY TO A DAMP CONDITION BEFORE PLACING CONCRETE.

SUBSTRUCTURE CONCRETE REMOVAL: REMOVE CONCRETE BY MEANS OF APPROVED PNEUMATIC HAMMERS EMPLOYING POINTED AND BLUNT CHISEL TOOLS. HYDRAULIC HOE-RAM TYPE HAMMERS WILL NOT BE PERMITTED. THE WEIGHT OF THE HAMMER SHALL NOT BE MORE THAN 35 POUNDS FOR REMOVAL WITHIN 18 INCHES OF PORTIONS TO BE PRESERVED. OUTSIDE THE 18 INCH LIMIT, THE CONTRACTOR MAY USE HAMMERS NOT EXCEEDING 90 POUNDS UPON THE APPROVAL OF THE ENGINEER. DO NOT PLACE PNEUMATIC HAMMERS IN DIRECT CONTACT WITH REINFORCING STEEL THAT IS TO BE RETAINED IN THE REBUILT STRUCTURE.

MEASUREMENT AND PAYMENT: THE DEPARTMENT WILL MEASURE THE QUANTITY OF REMOVALS ON A LUMP SUM BASIS. THE DEPARTMENT WILL PAY FOR THE ACCEPTED QUANTITIES OF REMOVALS AT THE CONTRACT PRICE FOR ITEM 202, PORTIONS OF STRUCTURE REMOVED, OVER 20 FOOT SPAN, AS PER PLAN.

EXISTING STRUCTURE VERIFICATION

DETAILS AND DIMENSIONS SHOWN ON THESE PLANS PERTAINING TO THE EXISTING STRUCTURE HAVE BEEN OBTAINED FROM PLANS OF THE EXISTING STRUCTURE AND FROM FIELD OBSERVATIONS AND MEASUREMENTS. CONSEQUENTLY, THEY ARE INDICATIVE OF THE EXISTING STRUCTURE AND THE PROPOSED WORK BUT THEY SHALL BE CONSIDERED TENTATIVE AND APPROXIMATE. THE CONTRACTOR IS REFERRED TO C&MS SECTIONS 102.05, 105.02, AND 513.04.

BASE CONTRACT BID PRICES UPON A RECOGNITION OF THE UNCERTAINTIES DESCRIBED ABOVE AND UPON A PREBID EXAMINATION OF THE EXISTING STRUCTURE. HOWEVER, THE DEPARTMENT WILL PAY FOR ALL PROJECT WORK BASED UPON ACTUAL DETAILS AND DIMENSIONS THAT HAVE BEEN VERIFIED IN THE FIELD.

UTILITY LINES:

THE UTILITIES SHALL BORE ALL EXPENSE INVOLVED IN RELOCATING (INSTALLING) THE AFFECTED UTILITY LINES. THE CONTRACTOR AND UTILITIES ARE TO COOPERATE BY ARRANGING THEIR WORK IN SUCH A MANNER THAT INCONVENIENCE TO EITHER WILL BE HELD TO A MINIMUM.

DECK PLACEMENT DESIGN ASSUMPTIONS:

THE FOLLOWING ASSUMPTIONS OF CONSTRUCTION MEANS AND METHODS WERE MADE FOR THE ANALYSIS AND DESIGN OF THE SUPERSTRUCTURE. THE CONTRACTOR IS RESPONSIBLE FOR THE DESIGN OF THE FALSEWORK SUPPORT SYSTEM WITHIN THESE PARAMETERS AND WILL ASSUME RESPONSIBILITY FOR SUPERSTRUCTURE ANALYSIS FOR DEVIATION FROM THESE DESIGN ASSUMPTIONS.

AN EIGHT WHEEL FINISHING MACHINE WITH A MAXIMUM WHEEL LOAD OF 2.74 KIPS.

A MINIMUM OUT-TO-OUT WHEEL SPACING AT EACH END OF THE MACHINE OF 103".

A MAXIMUM SPACING OF OVERHANG FALSEWORK BRACKETS OF 48 IN.

A MAXIMUM DISTANCE FROM THE CENTERLINE OF THE FASCIA BEAM TO THE FACE OF THE SAFETY HANDRAIL OF 65".

ITEM 519 - PATCHING CONCRETE STRUCTURES, AS PER PLAN:

PRIOR TO THE SURFACE CLEANING SPECIFIED IN C&MS 519.04 AND WITHIN 24 HOURS OF PLACING PATCHING MATERIAL, BLAST CLEAN ALL SURFACES TO BE PATCHED INCLUDING THE EXPOSED REINFORCING STEEL. ACCEPTABLE METHODS INCLUDE HIGH-PRESSURE WATER BLASTING WITH OR WITHOUT ABRASIVES IN THE WATER, ABRASIVE BLASTING WITH CONTAINMENT, OR VACUUM ABRASIVE BLASTING.

ASBESTOS NOTIFICATION

A CERTIFIED ASBESTOS HAZARD EVALUATION SPECIALIST SURVEYED THE BRIDGE STRUCTURE SCHEDULED FOR DEMOLITION AND/OR REHABILITATION; THE SURVEY DETERMINED THAT 35 S.F. ON MAH-680-0373 OF ASBESTOS IS PRESENT ON THE BRIDGE STRUCTURE. ODOT SHALL PROVIDE A COPY OF THE OHIO ENVIRONMENTAL PROTECTION AGENCY (OEPA) NOTIFICATION OF DEMOLITION AND RENOVATION FORM, PARTIALLY COMPLETED AND SIGNED BY THE BRIDGE OWNER, TO THE SUCCESSFUL BIDDER. THE CONTRACTOR SHALL COMPLETE THE FORM AND SUBMIT IT TO ONE OF THE ADDRESSES BELOW AT LEAST TEN (10) WORKING DAYS PRIOR TO THE START OF ANY DEMOLITION AND/OR RENOVATION.

ASBESTOS PROGRAM

OHIO EPA, DAPC
P.O. BOX 1049
COLUMBUS, OH 43216-1049
OR
ASBESTOS PROGRAM
OHIO EPA, DAPC
50 W. TOWN ST., SUITE 700
COLUMBUS, OH 43215

THE CONTRACTOR SHALL PROVIDE A COPY OF THE COMPLETED FORMS TO THE ENGINEER AT LEAST TEN (10) WORKING DAYS PRIOR TO THE START OF ANY DEMOLITION AND/OR RENOVATION. THE FORMS SHALL INCLUDE: 1) THE CONTRACTORS NAME AND ADDRESS, 2) THE SCHEDULED DATES FOR THE START AND COMPLETION OF THE BRIDGE REMOVAL AND 3) A DESCRIPTION OF THE PLANNED DEMOLITION WORK AND THE METHOD(S) TO BE USED. COPIES OF THE OEPA FORMS AND BRIDGE INSPECTION REPORTS ARE AVAILABLE FOR REVIEW AT THE ODOT DISTRICT 4 OFFICE, 2088 S. ARLINGTON ROAD, AKRON, OHIO 44306.

BASIS FOR PAYMENT - THE CONTRACTOR SHALL FURNISH ALL FEES, LABOR, AND MATERIAL NECESSARY TO COMPLETE AND SUBMIT THE OEPA NOTIFICATION FORMS. PAYMENT FOR THIS WORK SHALL BE INCLUDED IN ITEM 202 - PORTIONS OF STRUCTURE REMOVED, AS PER PLAN.

ITEM 510 - DOWEL HOLES WITH NONSHRINK, NONMETALLIC GROUT:

PRIOR TO DRILLING HOLES, LOCATE ALL EXISTING REINFORCING STEEL BARS IN THE AREA OF THE HOLE WITH THE AIDE OF A REINFORCING STEEL BAR LOCATOR (PACHOMETER). IF AN EXISTING BAR IS ENCOUNTERED AT THE SAME LOCATION AS A PROPOSED DOWEL HOLE, MOVE THE DOWEL HOLE TO EITHER SIDE OF THE EXISTING BAR. THE DEPARTMENT WILL PAY FOR DOWEL HOLES AND GROUTING WITH ITEM 510 - DOWEL HOLES WITH NONSHRINK, NONMETALLIC GROUT.

ITEM 513 - STRUCTURAL STEEL MEMBERS, LEVEL 2, AS PER PLAN

PERFORM THE WORK PER C&MS 513, EXCEPT AS NOTED BELOW.

SELECT ONE OF THE TWO OPTIONS DESCRIBED BELOW:

OPTION 1: GALVANIZING

1.0 DESCRIPTION

IN ADDITION TO THE REQUIREMENTS OF CONSTRUCTION AND MATERIAL SPECIFICATION 513, THIS ITEM SHALL CONSIST OF FURNISHING ALL NECESSARY LABOR, MATERIALS AND EQUIPMENT TO CLEAN AND GALVANIZE ALL STRUCTURAL STEEL SURFACES, AS SPECIFIED HEREIN. THE GALVANIZED COATING SYSTEM MAY BE APPLIED BY A GALVANIZER NOT QUALIFIED AS A FABRICATION SHOP UNDER CONSTRUCTION AND MATERIAL SPECIFICATION 513, BUT THE APPROVED FABRICATOR OF THE STRUCTURAL STEEL SHALL BE RESPONSIBLE FOR THE QUALITY OF THE APPLIED GALVANIZED COATING SYSTEM AND ANY REPAIRS, RE-FABRICATING, ADDITIONAL LAYDOWNS REQUIRED TO ASSURE THE FABRICATED STEEL MEETS ALL REQUIREMENTS OF THIS SPECIFICATION. SECTIONS 513.27 AND 513.28 SHALL NOT APPLY.

THIS ITEM SHALL ALSO INCLUDE GALVANIZING, PER 711.02, OF ALL NUTS, WASHERS, BOLTS, ANCHOR BOLTS.

SHEAR STUDS SHALL BE INSTALLED AS PER SECTION 513.22.

2.0 PRE-FABRICATION MEETING

IN ADDITION TO THE PRE-FABRICATION MEETING REQUIREMENTS UNDER 513.07, BOTH THE FABRICATOR'S QUALITY CONTROL SPECIALIST, (QCS) AND GALVANIZER'S QCS COATING APPLICATOR SHALL BE PRESENT AND DISCUSS METHODS OF OPERATION, QUALITY CONTROL, INCLUDING REPAIRS, TRANSPORTATION, ERECTION METHODS TO ACCOMPLISH ALL PHASES OF THE PREPARATION AND COATING WORK REQUIRED BY THIS SPECIFICATION.

3.0 QUALITY CONTROL

3.1 QUALITY CONTROL SPECIALIST

THE GALVANIZER'S QCS (QUALITY CONTROL SPECIALIST) REQUIRED UNDER 514, IS RESPONSIBLE FOR ALL QUALITY CONTROL REQUIREMENTS OF THIS SPECIFICATION. THE QCS SHALL HAVE THE TESTING EQUIPMENT SPECIFIED IN 514.05

3.2 QUALITY CONTROL POINTS (QCP)

QUALITY CONTROL POINTS (QCP) ARE POINTS IN TIME WHEN ONE PHASE OF THE WORK IS COMPLETE AND READY FOR INSPECTION BY THE FABRICATOR'S QCS AND THE DEPARTMENT'S QA REPRESENTATIVE. THE NEXT OPERATIONAL STEP MUST NOT PROCEED UNLESS THE QCP HAS BEEN ACCEPTED OR QA INSPECTION WAIVED BY THE DEPARTMENT'S QA REPRESENTATIVE. AT THESE POINTS THE FABRICATOR MUST AFFORD ACCESS TO INSPECT ALL AFFECTED SURFACES. IF INSPECTION INDICATES A DEFICIENCY, THAT PHASE OF THE WORK MUST BE CORRECTED IN ACCORDANCE WITH THESE SPECIFICATIONS PRIOR TO BEGINNING THE NEXT PHASE OF WORK. DISCOVERY OF DEFECTIVE WORK OR MATERIAL AFTER A QUALITY CONTROL POINT IS PAST OR FAILURE OF THE FINAL PRODUCT BEFORE FINAL ACCEPTANCE, MUST NOT IN ANY WAY PREVENT REJECTION OR OBLIGATE THE DEPARTMENT TO FINAL ACCEPTANCE.

QUALITY CONTROL POINTS	
QUALITY CONTROL POINTS (QCP)	PURPOSE
A. SOLVENT CLEANING	REMOVE ASPHALTIC CEMENT, OIL, GREASE, SALT, DIRT, ETC.
B. GRINDING EDGES	REMOVE SHARP CORNERS PER AWS.
C. ABRASIVE BLASTING	BLAST SURFACES, INCLUDING REPAIR FINS, TEARS, SLIVERS OR SHARP EDGES.
D. GALVANIZING	CHECK COATING THICKNESS.
E. FAYING SURFACE CLEANING	CHECK FAYING SURFACE ROUGHNESS. CHECK BOLT HOLE CLEARANCE. CHECK FOR OTHER FIELD CONNECTIONS UNIFORM COATING THICKNESS.
F. SECOND LAY DOWN	CHECK SWEEP AND CAMBER TOLERANCES OF EACH STRUCTURAL MEMBER.
G. FIELD REPAIR OF DAMAGED AREAS	CHECK FOR DAMAGE AREAS AFTER ERECTION OF STRUCTURE. PERFORM DAMAGE REPAIRS.
H. FINAL REVIEW	CLEAN STRUCTURE AS PER QCP #1. VISUALLY INSPECT SYSTEM FOR ACCEPTANCE.

A. SOLVENT CLEANING (QCP #1)

THE STEEL MUST BE SOLVENT CLEANED WHERE NECESSARY TO REMOVE ALL TRACES OF ASPHALTIC CEMENT, OIL, GREASE, DIESEL FUEL DEPOSITS, AND OTHER SOLUBLE CONTAMINANTS PER SSPC-SP 1 SOLVENT CLEANING. UNDER NO CIRCUMSTANCES MUST ANY ABRASIVE BLASTING BE DONE TO AREAS WITH ASPHALTIC CEMENT, OIL, GREASE, OR DIESEL FUEL DEPOSITS. STEEL MUST BE ALLOWED TO DRY BEFORE BLAST CLEANING BEGINS. THE GALVANIZER'S QCS SHALL INSPECT AND DOCUMENT THAT THE CLEANING CONFORMS TO SSPC-SPI AND PROVIDE A COVER LETTER LISTING EACH MAIN MEMBER INSPECTED.

B. GRINDING EDGES (QCP #2)

ALL CORNERS OF THERMALLY CUT OR SHEARED EDGES MUST HAVE A 1/16 INCH RADIUS OR EQUIVALENT FLAT SURFACE AT A SUITABLE ANGLE. THERMALLY CUT MATERIAL THICKER THAN 1 1/2 INCH MUST HAVE THE SIDES GROUND TO REMOVE THE HEAT EFFECTED ZONE, AS NECESSARY TO ACHIEVE THE SPECIFIED SURFACE CLEANING. THE GALVANIZER'S QCS MUST VISUALLY INSPECT AND DOCUMENT THAT THE GRINDING CONFORMS TO THIS SPECIFICATION AND PROVIDE A COVER LETTER LISTING EACH MAIN MEMBER INSPECTED.

P:\DDT\04-00222_MAH-680-00-68_03-73-105857\Design\Structure-es\MAH680_0373C_Sheets\680_0373C_Sheet 9/20/2021 12:38:21 PM CMT006



DATE 7-29-20
REVIEWED GDU
STRUCTURE FILE NUMBER 5006759

DRAWN MTJ
CHECKED ERK
DESIGNED ERK
STK

GENERAL NOTES
BRIDGE NO. MAH-680-0373
BELLE VISTA AVE. OVER I.R. 680

MAH-680-0.68 / 3.73
PID No. 105857

2 / 39

81
126

P:\DDT\04\00222_MAH-680-00-68_03.73\105857\Design\Structures\MAH680_0373C_S\02.dgn Sheet 9/20/2021 10:36:58 AM CMT006

C. ABRASIVE BLASTING (QCP #3)

BEAMS AND GIRDERS MUST BE PREPARED BY THE FABRICATOR TO STEEL STRUCTURES PAINTING COUNCIL (SSPC) GRADE SIX (6) COMMERCIAL BLAST CLEANING PRIOR TO GALVANIZING. ALL MATERIAL MUST BE FREE OF PAINT MARKS. SECONDARY ANGLE, PLATES, BARS AND SHAPES NEED NOT BE BLAST CLEANED.

ABRASIVES MUST ALSO BE CHECKED FOR OIL CONTAMINATION BEFORE USE. A SMALL SAMPLE OF ABRASIVES MUST BE ADDED TO ORDINARY TAP WATER. ANY DETECTION OF AN OIL FILM ON THE SURFACE OF THE WATER MUST BE CAUSE FOR REJECTION. THE GALVANIZER'S OCS MUST PERFORM AND RECORD THIS TEST AT THE START OF EACH SHIFT.

ALL FINN, TEARS, SLIVERS AND BURRED OR SHARP EDGES THAT ARE PRESENT ON ANY STEEL MEMBER OR THAT APPEAR AFTER THE BLASTING OPERATION MUST BE CONDITIONED PER ASTM A6. WELDING REPAIRS MUST ONLY BE PERFORMED BY THE 513 FABRICATOR.

THE GALVANIZER'S OCS MUST VISUALLY INSPECT AND DOCUMENT THAT THE BLAST CONFORMS TO SSPC-SP6, THAT ALL CONDITIONING IS PERFORMED PER ASTM A6, AND PROVIDE A COVER LETTER LISTING EACH MAIN MEMBER INSPECTED.

D. GALVANIZING (QCP #4)

GALVANIZED PER 711.02 AND THIS SPECIFICATION. COATING THICKNESS MUST BE A MINIMUM OF 4 MILS MEASURED AS SPECIFIED.

MATERIAL MUST BE FREE OF IMPERFECTIONS OR DEPRESSIONS CAUSED BY MATERIAL HANDLING. THE FABRICATOR, GALVANIZER AND ERECTOR MUST USE LIFTING CLAMPS OR SOFTENERS FOR HANDLING. PRIOR TO GALVANIZING, SURFACE IMPERFECTIONS MAY BE REPAIRED BY THE FABRICATOR IN CONFORMANCE WITH ASTM A6. IMPERFECTIONS GREATER THAN THE LIMITS ALLOWED BY ASTM A6 MUST BE DOCUMENTED. REPAIR OR REPLACEMENT OF THIS MEMBER WILL BE AT THE DISCRETION OF THE DEPARTMENT.

ALL DAMAGED GALVANIZING MUST BE REPAIRED IN ACCORDANCE WITH 711.02.

DOCUMENTATION OF COATING THICKNESS MUST BE PERFORMED BY THE GALVANIZER'S OCS. THE GALVANIZER'S OCS MUST RECORD THE GAGE READINGS AND PROVIDE A COVER LETTER LISTING EACH MAIN MEMBER INSPECTED.

E. FAYING SURFACE CLEANING (QCP #5)

AREAS OF FIELD CONNECTIONS MUST HAVE A UNIFORM GALVANIZED COATING THICKNESS FREE OF LOCAL EXCESSIVE ROUGHNESS WHICH WOULD PREVENT SPLICE PLATES, BEARINGS OR OTHER FIELD CONNECTIONS FROM MAKING INTIMATE CONTACT.

FAYING SURFACES OF THE BOLTED SPLICES MUST BE ROUGHENED IN THE SHOP AFTER GALVANIZING BY HAND WIRE BRUSHING. POWER WIRE BRUSHING IS NOT PERMITTED. ALL FIELD SPLICE BOLT HOLES MUST BE FREE OF ZINC BUILD UP. AFTER GALVANIZING, CLEAN EACH HOLE AS NECESSARY SO THAT A DRIFT PIN 1/16" LESS THAN THE DIAMETER OF THAT HOLE CAN BE FULLY INSERTED. CONSIDERATION WILL BE GIVEN TO OTHER METHODS OF TREATING THE FAYING SURFACES AND BOLT HOLES IF A WRITTEN REQUEST IS SUBMITTED TO THE OFFICE OF MATERIAL MANAGEMENT (OMM) IN ACCORDANCE WITH C&MS 108.05.

INSPECTION OF THE ROUGHENING OF THE FAYING SURFACES AND CHECKING OF HOLES WITH DRIFT PINS MUST BE PERFORMED BY THE GALVANIZER'S OCS. ACCEPTANCE OF THE FAYING SURFACES AND HOLES SHALL BE DOCUMENTED BY THE GALVANIZER'S OCS.

F. SECOND LAY DOWN (QCP #6)

AFTER GALVANIZING, MATERIALS MUST BE PLACED IN A SECOND SHOP ASSEMBLY PER C&MS SECTION 513.24 TO CHECK ALIGNMENT OF HOLES, SWEEP AND CAMBER AGAINST THE FABRICATORS ORIGINAL RECORDED LAY DOWN DIMENSIONS. THIS SHOP ASSEMBLY MAY BE PERFORMED AT THE GALVANIZER'S FACILITY, BY THE FABRICATORS PERSONNEL, IF APPROVED BY THE OFFICE OF MATERIAL MANAGEMENT (OMM). THE SECOND LAY DOWN MAY BE WAIVED BY THE OMM IF THE FABRICATOR RECORDS INDIVIDUAL BEAM CAMBERS AND SWEEPS DURING THE FIRST LAY DOWN, AND THE NEW INDIVIDUAL BEAM CAMBERS AND SWEEPS, AFTER GALVANIZING, COMPARED TO THE FIRST LAY DOWN ARE WITHIN THE FOLLOWING TOLERANCES:

BEARING POINTS AFTER GALVANIZING MUST BE WITHIN ± 1/8 INCH OF THE APPROVED SHOP DRAWING LAY DOWN.

CAMBER POINTS AFTER GALVANIZING MUST BE + 1/4" OR - 0 INCH FROM THE FIRST LAY DOWN.

SWEEP POINTS AFTER GALVANIZING MUST BE ± 3/8" FROM THE FIRST LAY DOWN.

INDIVIDUAL BEAMS THAT EXCEED THE LISTED TOLERANCES MUST BE PLACED WITH AT LEAST TWO ADJACENT BEAMS IN LAY DOWN FOR CHECKING AGAINST THE RECORDED SHOP ASSEMBLY RECORDS PER 513.24. DOCUMENTATION OF THE SECOND LAY DOWN OR INDIVIDUAL MEMBER CAMBERS MUST BE RECORDED BY THE FABRICATOR'S OCS OR GALVANIZER'S OCS PER 513.24.

G. FIELD REPAIR OF DAMAGED AREAS (QCP #7)

MATERIAL MUST BE FREE OF IMPERFECTIONS OR DEPRESSIONS CAUSED BY MATERIAL HANDLING. THE CONTRACTOR MUST USE LIFTING CLAMPS OR SOFTENERS FOR HANDLING. IMPERFECTIONS MAY BE REPAIRED BY GRINDING AS ALLOWED BY ASTM A6 BY THE CONTRACTOR. IMPERFECTIONS THAT ARE GREATER THAN THE GRINDING LIMITS ALLOWED BY ASTM A6 MUST BE DOCUMENTED. REPAIR OR REPLACEMENT OF THIS MEMBER WILL BE AT THE DISCRETION OF THE OMM.

ALL DAMAGED GALVANIZING MUST BE REPAIRED IN ACCORDANCE WITH 711.02.

DAMAGED GALVANIZING WHICH WILL BE INACCESSIBLE FOR REPAIR AFTER ERECTION MUST BE REPAIRED PRIOR TO ERECTION.

IN ORDER TO MINIMIZE DAMAGE TO THE GALVANIZED STEEL, CONCRETE SPLATTER AND FORM LEAKAGE MUST BE WASHED FROM THE SURFACE OF THE STEEL SHORTLY AFTER THE CONCRETE IS PLACED AND BEFORE IT IS DRY. IF THE CONCRETE DRIES, IT MUST BE REMOVED.

TEMPORARY ATTACHMENTS, SUPPORTS FOR SCAFFOLDING AND FINISHING MACHINE OR FORMS MUST NOT DAMAGE THE COATING SYSTEM. IN PARTICULAR, SUFFICIENT SIZE SUPPORT PADS MUST BE USED ON THE FASCIAS WHERE BRACING IS USED.

DOCUMENTATION OF GALVANIZING REPAIRS MUST BE PERFORMED BY THE GALVANIZER'S OCS BY A COVER LETTER LISTING EACH MAIN MEMBER INSPECTED.

H. FINAL REVIEW (QCP #8)

AFTER THE ERECTION WORK HAS BEEN COMPLETED, INCLUDING ALL CONNECTIONS AND THE APPROVED REPAIR OF ANY DAMAGED BEAMS, GIRDERS OR OTHER STEEL MEMBERS, AND THE DECK HAS BEEN PLACED, THE CONTRACTOR AND ENGINEER MUST INSPECT THE STRUCTURE FOR DAMAGED COATING. (QCP #8). DAMAGED AREAS MUST BE REPAIRED BY QCP #7. AT THE COMPLETION OF CONSTRUCTION, THE GALVANIZING MUST BE UNDAMAGED AND THE SURFACES FREE FROM GREASE, OIL, CHALK MARKS, PAINT, CONCRETE SPLATTER OR OTHER SILAGE. SUCH SILAGE WILL BE REMOVED BY SOLVENT CLEANING PER SSPC-SP1 (QCP #1).

DOCUMENTATION OF FINAL REVIEW MUST BE PERFORMED BY THE GALVANIZER'S OCS BY A COVER LETTER LISTING EACH MAIN MEMBER INSPECTED.

4.0 TESTING EQUIPMENT

THE FABRICATOR MUST PROVIDE THE GALVANIZER'S OCS INSPECTOR THE FOLLOWING TESTING EQUIPMENT IN GOOD WORKING ORDER FOR THE DURATION OF THE PROJECT. ONE (POSITECTOR 2000 OR 6000, QUANIX 2200, OR ELCOMETER A345FB11) AND THE CALIBRATION PLATES, 38-200 MM AND 250-625 MM [1.5-8 MILS AND 10-25 MILS] AS PER THE NBS CALIBRATION STANDARDS IN ACCORDANCE WITH ASTM D-1186.

5.0 COATING THICKNESS

GALVANIZED THICKNESS MUST BE DETERMINED BY USE OF TYPE 2 MAGNETIC GAGE IN ACCORDANCE WITH THE FOLLOWING:

FIVE SEPARATE SPOT MEASUREMENTS MUST BE MADE, SPACED EVENLY OVER ONE (1) RANDOMLY SELECTED, 100 SQUARE FEET OF SURFACE AREA ON EACH STRUCTURAL MEMBER. THREE GAGE READINGS MUST BE MADE FOR EACH SPOT MEASUREMENT. THE PROBE MUST BE MOVED A DISTANCE OF 1 TO 3 INCHES FOR EACH NEW GAGE READING. ANY UNUSUALLY HIGH OR LOW GAGE READING THAT CANNOT BE REPEATED CONSISTENTLY MUST BE DISCARDED. THE AVERAGE (MEAN) OF THE 3 GAGE READINGS MUST BE USED AS THE SPOT MEASUREMENT. THE AVERAGE OF FIVE SPOT MEASUREMENTS FOR EACH SUCH 100 SQUARE FOOT AREA MUST NOT BE LESS THAN THE SPECIFIED THICKNESS. NO SINGLE SPOT MEASUREMENT IN ANY 100 SQUARE FOOT AREA MUST BE LESS THAN 80% OF THE SPECIFIED MINIMUM THICKNESS. ANY ONE OF 3 READINGS WHICH ARE AVERAGED TO PRODUCE EACH SPOT MEASUREMENT, MAY UNDER-RUN OR OVER-RUN BY A GREATER AMOUNT. THE 5 SPOT MEASUREMENTS MUST BE MADE FOR ONE (1) RANDOMLY SELECTED, 100 SQUARE FEET OF AREA ON EACH STRUCTURAL MEMBER. ALL SPLICE MATERIAL AND SECONDARY MEMBERS MUST HAVE AT LEAST ONE SPOT MEASURED ON EACH PIECE. THE PROBE MUST BE MOVED SO THAT ONE READING IS TAKEN AT EACH END AND MIDDLE OF THE PIECE FOR A TOTAL OF THREE READINGS.

THE GALVANIZER'S OCS MUST INSPECT AND PROVIDE DOCUMENTATION OF ACTUAL DATA, THE GALVANIZED THICKNESS CHECKS WERE PERFORMED PER SPECIFICATION, AND THE COATING THICKNESS MEETS SPECIFICATION REQUIREMENTS.

6.0 HANDLING AND SHIPPING

REASONABLE CARE MUST BE EXERCISED IN HANDLING THE GALVANIZED STEEL DURING SHIPPING, ERECTION, AND SUBSEQUENT CONSTRUCTION OF THE BRIDGE. THE STEEL MUST BE INSULATED FROM THE BINDING CHAINS BY SOFTENERS. HOOKS AND SLINGS USED TO HOIST STEEL MUST BE PADDEN. DIAPHRAGMS AND SIMILAR PIECES MUST BE SPACED IN SUCH A WAY THAT NO RUBBING WILL OCCUR DURING SHIPMENT THAT MAY DAMAGE THE GALVANIZING. THE STEEL MUST BE STORED ON PALLETS AT THE JOB SITE, OR BY OTHER MEANS, SO THAT IT DOES NOT REST ON THE GROUND OR SO THAT COMPONENTS DO NOT FALL OR REST ON EACH OTHER.

7.0 SAFETY REQUIREMENT AND PRECAUTIONS

THE CONTRACTOR MUST MEET THE SAFETY REQUIREMENTS OF THE OHIO INDUSTRIAL COMMISSION AND THE OCCUPATIONAL SAFETY AND HEALTH ADMINISTRATION (OSHA), IN ADDITION TO THE SCAFFOLDING REQUIREMENTS BELOW.

THE CONTRACTOR IS REQUIRED TO MEET THE APPLICABLE SAFETY REQUIREMENTS OF THE OHIO INDUSTRIAL COMMISSION IN ADDITION TO THE SCAFFOLDING REQUIREMENTS SPECIFIED BELOW.

8.0 SCAFFOLDING

RUBBER ROLLERS, OR OTHER PROTECTIVE DEVICES MEETING THE APPROVAL OF THE ENGINEER, MUST BE USED ON SCAFFOLD FASTENINGS. METAL ROLLERS OR CLAMPS AND OTHER TYPES OF FASTENINGS WHICH WILL MAR OR DAMAGE COATED SURFACES MUST NOT BE USED.

9.0 INSPECTION ACCESS FOR FIELD REPAIR

IN ADDITION TO THE REQUIREMENT OF 105.10, THE CONTRACTOR MUST FURNISH, ERECT, AND MOVE SCAFFOLDING AND OTHER APPROPRIATE EQUIPMENT, TO PERMIT THE INSPECTOR THE OPPORTUNITY TO INSPECT CLOSELY OBSERVE, ALL AFFECTED SURFACES. THIS OPPORTUNITY MUST BE PROVIDED TO THE INSPECTOR DURING ALL PHASES OF THE WORK AND CONTINUE FOR A PERIOD OF AT LEAST TEN (10) WORKING DAYS AFTER THE TOUCH-UP WORK HAS BEEN COMPLETED. WHEN SCAFFOLDING IS USED, IT MUST BE PROVIDED IN ACCORDANCE WITH THE FOLLOWING REQUIREMENTS. WHEN SCAFFOLDING, OR THE HANGERS ATTACHED TO THE SCAFFOLDING ARE SUPPORTED BY HORIZONTAL WIRE ROPES, OR WHEN SCAFFOLDING IS PLACED DIRECTLY UNDER THE SURFACE TO BE PAINTED, THE FOLLOWING REQUIREMENTS MUST BE COMPLIED WITH:

WHEN SCAFFOLDING IS SUSPENDED 43" OR MORE BELOW THE COATED SURFACE TO BE REPAIRED, TWO ROWS OF GUARDRAIL MUST BE PLACED ON ALL SIDES OF THE SCAFFOLDING. ONE ROW OF GUARDRAIL MUST BE PLACED AT 42" ABOVE THE SCAFFOLDING AND THE OTHER ROW AT 20" ABOVE THE SCAFFOLDING.

WHEN THE SCAFFOLDING IS SUSPENDED AT LEAST 21", BUT LESS THAN 43" BELOW THE COATED SURFACE TO BE REPAIRED, A ROW OF GUARDRAIL MUST BE PLACED ON ALL SIDES OF THE SCAFFOLDING AT 20" ABOVE THE SCAFFOLDING.

TWO ROWS OF GUARDRAIL MUST BE PLACED ON ALL SIDES OF SCAFFOLDING NOT PREVIOUSLY MENTIONED. THE ROWS OF GUARDRAIL MUST BE PLACED AT 42" AND 20" ABOVE SCAFFOLDING, AS PREVIOUSLY MENTIONED.

ALL SCAFFOLDING MUST BE AT LEAST 24" WIDE WHEN GUARDRAIL IS USED AND 28" WIDE WHEN THE SCAFFOLDING IS SUSPENDED LESS THAN 21" BELOW THE COATED SURFACE TO BE REPAIRED AND GUARDRAIL IS NOT USED. IF TWO OR MORE SCAFFOLDING ARE LAID PARALLEL TO ACHIEVE THE PROPER WIDTH, THEY MUST BE RIGIDLY ATTACHED TO EACH OTHER TO PRECLUDE ANY DIFFERENTIAL MOVEMENT.

ALL GUARDRAILS MUST BE CONSTRUCTED AS A SUBSTANTIAL BARRIER WHICH IS SECURELY FASTENED IN PLACE AND IS FREE FROM PROTRUDING OBJECTS SUCH AS NAILS, SCREWS AND BOLTS. THERE MUST BE AN OPENING IN THE GUARDRAIL, PROPERLY LOCATED, TO ALLOW THE INSPECTOR ACCESS ONTO THE SCAFFOLDING.

THE RAILS AND UPRIGHTS MUST BE EITHER METAL OR WOOD. IF PIPE RAILING IS USED, THE RAILING MUST HAVE A NOMINAL DIAMETER OF NO LESS THAN ONE AND ONE HALF INCHES. IF STRUCTURAL STEEL RAILING IS USE, THE RAILS MUST BE 2 X 2 X 3/8 INCH STEEL ANGLES OR OTHER METAL SHAPES OF EQUAL OR GREATER STRENGTH. IF WOOD RAILING IS USED, THE RAILING MUST BE 2 X 4 INCH (NOMINAL) STOCK. ALL UPRIGHTS MUST BE SPACED AT NO MORE THAN 8 FEET ON CENTER. IF WOOD UPRIGHTS ARE USED, THE UPRIGHTS MUST BE 2 X 4 INCHES (NOMINAL) STOCK.

WHEN THE SURFACE TO BE INSPECTED IS MORE THAN 15 FEET ABOVE THE GROUND OR WATER, AND THE SCAFFOLDING IS SUPPORTED FROM THE STRUCTURE BEING PAINTED, THE CONTRACTOR MUST PROVIDE THE INSPECTOR WITH A SAFETY BELT AND LIFELINE. THE LIFELINE MUST NOT ALLOW A FALL GREATER THAN 6 FEET. THE CONTRACTOR MUST PROVIDE A METHOD OF ATTACHING THE LIFELINE TO THE STRUCTURE INDEPENDENT OF THE SCAFFOLDING, CABLES, OR BRACKETS SUPPORTING THE SCAFFOLDING. WHEN SCAFFOLDING IS MORE THAN TWO AND ONE HALF FEET ABOVE THE GROUND, THE CONTRACTOR MUST PROVIDE A LADDER FOR ACCESS ONTO THE SCAFFOLDING. THE LADDER AND ANY EQUIPMENT USED TO ATTACH THE LADDER TO THE STRUCTURE MUST BE CAPABLE OF SUPPORTING 250 POUNDS WITH A SAFETY FACTOR OF AT LEAST FOUR (4). ALL RUNGS, STEPS, CLEATS, OR TREADS MUST HAVE UNIFORM SPACING AND MUST NOT EXCEED 12" ON CENTER. AT LEAST ONE SIDE RAIL MUST EXTEND AT LEAST 36" ABOVE THE LANDING NEAR THE TOP OF THE LADDER.

AN ADDITIONAL LANDING MUST BE REQUIRED WHEN THE DISTANCE FROM THE LADDER TO THE POINT WHERE THE SCAFFOLDING MAY BE ACCESSED, EXCEEDS 12". THE LANDING MUST BE A MINIMUM OF AT LEAST 24" WIDE AND 24" LONG. IT MUST ALSO BE OF ADEQUATE SIZE AND SHAPE SO THAT THE DISTANCE FROM THE LANDING TO THE POINT WHERE THE SCAFFOLDING IS ACCESSED DOES NOT EXCEED 12". THE LANDING MUST BE RIGID AND FIRMLY ATTACHED TO THE LADDER; HOWEVER, IT MUST NOT BE SUPPORTED BY THE LADDER. THE SCAFFOLDING MUST BE CAPABLE OF SUPPORTING A MINIMUM OF 1000 LBS.

IN ADDITION TO THE AFOREMENTIONED REQUIREMENTS, THE CONTRACTOR IS STILL RESPONSIBLE TO OBSERVE AND COMPLY WITH ALL FEDERAL, STATE AND LOCAL LAWS, ORDINANCES, REGULATIONS, ORDERS AND DECREES.

THE CONTRACTOR MUST FURNISH ALL NECESSARY TRAFFIC CONTROL TO PERMIT INSPECTION DURING AND AFTER ALL PHASES OF THE PROJECT.

10.0 PROTECTION OF PERSONS AND PROPERTY

THE CONTRACTOR MUST INSTALL AND MAINTAIN SUITABLE SHIELDS OR ENCLOSURES TO PREVENT DAMAGE TO ADJACENT BUILDINGS, PARKED CARS, TRUCKS, BOATS, OR VEHICLES TRAVELING ON, OVER, OR UNDER STRUCTURES HAVING GALVANIZED REPAIRS. THEY MUST BE SUITABLY ANCHORED AND REINFORCED TO PREVENT INTERFERING WITH NORMAL TRAFFIC OPERATIONS IN THE OPEN LANES. PAYMENT FOR THE SHIELDS MUST BE INCLUDED AS INCIDENTAL TO THE APPLICABLE FIELD COATING OPERATION. WORK MUST BE SUSPENDED WHEN DAMAGE TO ADJACENT BUILDINGS, MOTOR VEHICLES, BOATS, OR OTHER PROPERTY IS OCCURRING.

WHEN OR WHERE ANY DIRECT OR INDIRECT DAMAGE OR INJURY IS DONE TO PUBLIC OR PRIVATE PROPERTY, THE CONTRACTOR MUST RESTORE, AT HIS OWN EXPENSE, SUCH PROPERTY, TO A CONDITION SIMILAR OR EQUAL TO THAT EXISTING BEFORE SUCH DAMAGE OR INJURY WAS DONE.



DESIGNED	ERK	CHECKED	STK
DRAWN	MTJ	REVISED	
REVIEWED	GDJ	DATE	7-29-20
DATE	7-29-20	STRUCTURE FILE NUMBER	5006759

GENERAL NOTES
BRIDGE NO. MAH-680-0373
BELLE VISTA AVE. OVER I.R. 680

MAH-680-0.68 / 3.73
PID No. 105857

3 / 39

82
126

11.0 POLLUTION CONTROL

THE CONTRACTOR MUST TAKE ALL NECESSARY PRECAUTIONS TO COMPLY WITH POLLUTION CONTROL LAWS, RULES OR REGULATIONS OF FEDERAL, STATE OR LOCAL AGENCIES.

12.0 METHOD OF MEASUREMENT

THE COST OF ALL LABOR, MATERIALS, EQUIPMENT NECESSARY TO GALVANIZE AND TO FABRICATE THE STRUCTURAL STEEL IN ACCORDANCE WITH 513 AND PERFORM ANY NECESSARY FIELD REPAIR SHALL BE INCLUDED IN THIS 513, AS PER PLAN ITEM.

13.0 BASIS OF PAYMENT

PAYMENT WILL BE MADE AT THE CONTRACT PRICE FOR THE ITEM 513, STRUCTURAL STEEL MEMBERS, LEVEL 2, AS PER PLAN. THE QUANTITY FOR THE GALVANIZING OPTION ASSUMES TWO SPLICES PER BEAM LINE.

OPTION 2: SHOP METALIZING

DELETE THE REQUIREMENTS OF 513.27. SHOP METALIZE ALL STRUCTURAL STEEL SURFACES PER SUPPLEMENTAL SPECIFICATION (SS) 845, INCLUDING BUT NOT LIMITED TO BEAMS, CROSSFRAMES, CONNECTION PLATES, SPLICE PLATES, AND BEARING LOAD PLATES, EXCEPT DO NOT METALIZE THE TOP SURFACE OF BEAM TOP FLANGES. APPLY A PRIME COAT, 708.01, IN THE SHOP TO THE TOP SURFACE OF THE BEAM TOP FLANGES, THE PRIME COAT SHALL BE MIST COATING FROM 0.5 TO 1.5 MILS.

FOR OPTION 2, THE CONTRACTOR HAS THE OPTION OF MAKING ONE OF THE FIELD SPLICES OPTIONAL.

REPAIR DAMAGE TO THE METALIZING CAUSED DURING STORAGE, TRANSPORTATION, ERECTION, BOLTING, WELDING, FORMING, CONCRETE PLACEMENT, AND FORM REMOVAL OPERATION, ACCORDING TO C&MS 711.02. EXERCISE EXTREME CARE WHILE HANDLING THE STEEL DURING ERECTION, AND DURING SUBSEQUENT CONSTRUCTION OF THE BRIDGE. INSULATE THE STEEL FROM BINDING CHAINS BY SOFTENERS AND PAD ALL HOOKS AND SLINGS THAT ARE USED TO HOIST/ERECT THE STEEL MEMBERS.

FOR OPTION 2, SURFACE PREPARATION, METALIZING, SEALING, PRIME COAT, AND REPAIR WORK ARE CONSIDERED INCIDENTAL TO ITEM 513 - STRUCTURAL STEEL MEMBERS, LEVEL 2, AS PER PLAN. ALL APPLICABLE PROVISIONS OF C&MS 514 SHALL APPLY.



REVIEWED WHM DATE 9-20-21
STRUCTURE FILE NUMBER 5006759

DRAWN AMR REVISIONS
DESIGNED AMR CHECKED STK

GENERAL NOTES
BRIDGE NO. MAH-680-0373
BELLE VISTA AVE. OVER I.R. 680

MAH-680-0.68 / 3.73
PID No. 105857

3A / 39

82A
126

P:\DDT\04\0022_MAH-680-00.68.03.73\105857\Design\Structures\MAH680_0373C_Sheets\680_0373C_50001.dgn Sheet 9/20/2021 10:40:40 AM CMT006

ESTIMATED QUANTITIES							DESIGN: GDJ	CHECK: ERK		
							DATE: 5-24-2021	DATE: 5-24-2021		
ITEM	EXTENSION	TOTAL 01/IMS/BR	TOTAL 03/IMS/OT/DEOG	UNIT	DESCRIPTION	ABUT.	PIERS	SUPER.	GEN.	SHEET #
202	11203	LS		-	PORTIONS OF STRUCTURE REMOVED, OVER 20 FOOT SPAN, AS PER PLAN					2, 6-9, 35
202	22900	271		SY	APPROACH SLAB REMOVED				271	
202	23500	919		SY	WEARING COURSE REMOVED				919	
203	10000	201		CY	EXCAVATION				201	
204	30010	17		CY	GRANULAR MATERIAL, TYPE B				17	
204	50001	350		SY	GEOTEXTILE FABRIC, AS PER PLAN				350	33
503	21300	LS		-	UNCLASSIFIED EXCAVATION					
509	10000	99817		LB	EPOXY COATED REINFORCING STEEL	843	4241	91873	2860	
510	10000	346		EACH	DOWEL HOLES WITH NONSHRINK, NONMETALLIC GROUT	98			248	
511	21522	357		CY	CLASS QC2 CONCRETE WITH OC/OA, SUPERSTRUCTURE			357		
511	33501	2		EACH	SEMI-INTEGRAL DIAPHRAGM GUIDE, AS PER PLAN	2				10, 12
511	42510	40		CY	CLASS QC1 CONCRETE, PIER CAP		40			
511	44110	10		CY	CLASS QC1 CONCRETE, ABUTMENT NOT INCLUDING FOOTING	10				
511	51512	76		CY	CLASS QC2 CONCRETE WITH OC/OA, SIDEWALK			76		
511	53012	16		CY	CLASS QC2 CONCRETE, MISC.: RETAINING WALLS				16	13, 35, 36
512	10050	356		SY	SEALING OF CONCRETE SURFACES (NON-EPOXY)			281	75	
512	10100	1465		SY	SEALING OF CONCRETE SURFACES (EPOXY-URETHANE)	691	197	442	135	
513	10241	345400		LB	STRUCTURAL STEEL MEMBERS, LEVEL 2, AS PER PLAN			345400		2-3A
513	20000	3582		EACH	WELDED STUD SHEAR CONNECTORS			3582		
516	10010	67		FT	ARMORLESS PREFORMED JOINT SEAL				67	
516	12310	396		LB	SIDEWALK COVER PLATE				396	
516	13600	122		SF	1" PREFORMED EXPANSION JOINT FILLER			37	85	
516	13900	71		SF	2" PREFORMED EXPANSION JOINT FILLER	71				
516	14000	52		SF	PREFORMED EXPANSION JOINT FILLER, MISC.: 4" THICK	52				10, 12
516	14020	177		FT	SEMI-INTEGRAL ABTUMENT EXPANSION JOINT SEAL	177				
516	44200	6		EACH	ELASTOMERIC BEARING WITH INTERNAL LAMINATES AND LOAD PLATE (NEOPRENE) (12" X 20" X 3.124" WITH A 13" X 21" X 2" LOAD PLATE)	6				
516	44200	6		EACH	ELASTOMERIC BEARING WITH INTERNAL LAMINATES AND LOAD PLATE (NEOPRENE) (16" X 20" X 3.124" WITH A 17" X 21" X 2" LOAD PLATE)		6			
516	44200	6		EACH	ELASTOMERIC BEARING WITH INTERNAL LAMINATES AND LOAD PLATE (NEOPRENE) (12" X 20" X 3.124" WITH A 13" X 26" X 2" LOAD PLATE)	6				
517	74501	459		FT	RAILING, CONCRETE, AS PER PLAN			383	76	27
518	21200	33		CY	POROUS BACKFILL WITH GEOTEXTILE FABRIC				33	
519	11101	198		SF	PATCHING CONCRETE STRUCTURE, AS PER PLAN	198				2, 6-7
526	30011	309		SY	REINFORCED CONCRETE APPROACH SLABS WITH OC/OA (T=17"), AS PER PLAN				309	28-31
526	90020	58		SY	TYPE B INSTALLATION				58	
526	90030	67		FT	TYPE C INSTALLATION				67	
607	39930	555		FT	VANDAL PROTECTION FENCE, 12' CURVED, COATED FABRIC	17		384	154	
SPECIAL	69098400		LS	-	DOMINION ENERGY OHIO STABILIZERS AND SUPPORTS					4
840	23000	184		CY	SELECT GRANULAR BACKFILL				184	
863	00300	987		SY	GEOGRID, TYPE P3				987	



DESIGNED BY: ERK
 CHECKED BY: GDJ
 DRAWN BY: ERK
 REVISIONS: 0
 REVIEWED BY: STK
 DATE: 7-29-20
 STRUCTURE FILE NUMBER: 5006759

ESTIMATED QUANTITIES
 BRIDGE NO. MAH-680-0373
 BELLE VISTA AVE. OVER I.R. 680

MAH-680-0.68 / 3.73
 PID No. 105857