


J:\ODOT\02738-MED-3-12.00\Design\Roadway\Sheet\02738-GG002.dgn Sheet 10/9/2019 11:48:55 AM david-m

SHEET NUM.										PART.	ITEM	ITEM	GRAND	UNIT	DESCRIPTION	SEE SHEET NO.
5		32		40		43				01/S>2/BR	ITEM	EXT	TOTAL			
WATER WORK																
		141								141	638	01301	141	FT	8" WATER MAIN DUCTILE IRON PIPE ANSI CLASS 52, MECHANICAL JOINTS AND FITTINGS, AS PER PLAN	19-22
		157								157	638	01901	157	FT	10" WATER MAIN DUCTILE IRON PIPE ANSI CLASS 52, MECHANICAL JOINTS AND FITTINGS, AS PER PLAN	19-22
		30								30	638	04900	30	FT	1" COPPER SERVICE BRANCH	
		2								2	638	07901	2	EACH	8" GATE VALVE AND VALVE BOX, AS PER PLAN	23-24
		2								2	638	08001	2	EACH	10" GATE VALVE AND VALVE BOX, AS PER PLAN	23-24
		1								1	SPECIAL	63820912	1	EACH	1" CURB VALVE AND BOX , CITY OF MEDINA STANDARDS	28
		17								17	638	98000	17	EACH	WATER WORK, MISC.: FITTINGS FOR USE WITH CLASS 52 DUCTILE IRON WATER MAIN	25-26
		2								2	638	98000	2	EACH	WATER WORK, MISC.: TEMPORARY FLUSHING ASSEMBLY	27-28
TRAFFIC CONTROL																
				33						33	630	02100	33	FT	GROUND MOUNTED SUPPORT, NO. 2 POST	
				1						1	630	80100	1	SF	SIGN, FLAT SHEET	
				5						5	630	85100	5	EACH	REMOVAL OF GROUND MOUNTED SIGN AND REERECTION	
				3						3	630	86002	3	EACH	REMOVAL OF GROUND MOUNTED POST SUPPORT AND DISPOSAL	
				0.06						0.06	642	00104	0.06	MILE	EDGE LINE, 6", TYPE 1	
				0.03						0.03	642	00300	0.03	MILE	CENTER LINE, TYPE 1	
STRUCTURE 20 FOOT SPAN AND UNDER (MED-003-1199)																
						LS				LS	202	11201	LS		PORTIONS OF STRUCTURE REMOVED, AS PER PLAN	42
						LS				LS	503	11101	LS		COFFERDAMS AND EXCAVATION BRACING, AS PER PLAN	42
						LS				LS	503	21300	LS		UNCLASSIFIED EXCAVATION	
						2,972				2,972	509	10000	2,972	LB	EPOXY COATED REINFORCING STEEL	
						64				64	511	46001	64	SY	CLASS QC1 CONCRETE, RETAINING/WINGWALL NOT INCLUDING FOOTING, AS PER PLAN	42
						36				36	511	46510	36	CY	CLASS QC1 CONCRETE, FOOTING	
						76				76	512	10050	76	SY	SEALING OF CONCRETE SURFACES (NON-EPOXY)	
						229				229	512	33000	229	SY	TYPE 2 WATERPROOFING	
						52				52	516	13600	52	SF	1" PREFORMED EXPANSION JOINT FILLER	
						37				37	517	75120	37	FT	RAILING (CONCRETE PARAPET WITH TWIN STEEL TUBE RAILING)	
						26				26	518	21200	26	CY	POROUS BACKFILL WITH GEOTEXTILE FABRIC	
						20				20	518	40000	20	FT	6" PERFORATED CORRUGATED PLASTIC PIPE	
						12				12	518	40010	12	FT	6" NON-PERFORATED CORRUGATED PLASTIC PIPE, INCLUDING SPECIALS	
						83				83	601	32000	83	CY	ROCK CHANNEL PROTECTION, TYPE A WITH FILTER	
						75				75	611	95600	75	FT	12' X 4' CONDUIT, TYPE A, 706.05	
MAINTENANCE OF TRAFFIC																
		16								16	614	11110	16	HOUR	LAW ENFORCEMENT OFFICER WITH PATROL CAR FOR ASSISTANCE	
		LS								LS	614	12420	LS		DETOUR SIGNING	
		6								6	614	18601	6	SNMT	PORTABLE CHANGEABLE MESSAGE SIGN, AS PER PLAN	5
		1								1	616	10000	1	MGAL	WATER	
INCIDENTALS																
		LS								LS	614	11000	LS		MAINTAINING TRAFFIC	
										6	619	16000	6	MNTH	FIELD OFFICE, TYPE A	
										LS	623	10000	LS		CONSTRUCTION LAYOUT STAKES AND SURVEYING	
										LS	624	10000	LS		MOBILIZATION	

GENERAL SUMMARY


MED - SR 3 - 12.00

J:\ODOT\102738_MED-3-12.00\Design\Traffic\Sheets\102738_TP001.dgn Sheet 10/9/2019 11:51:45 AM david-m

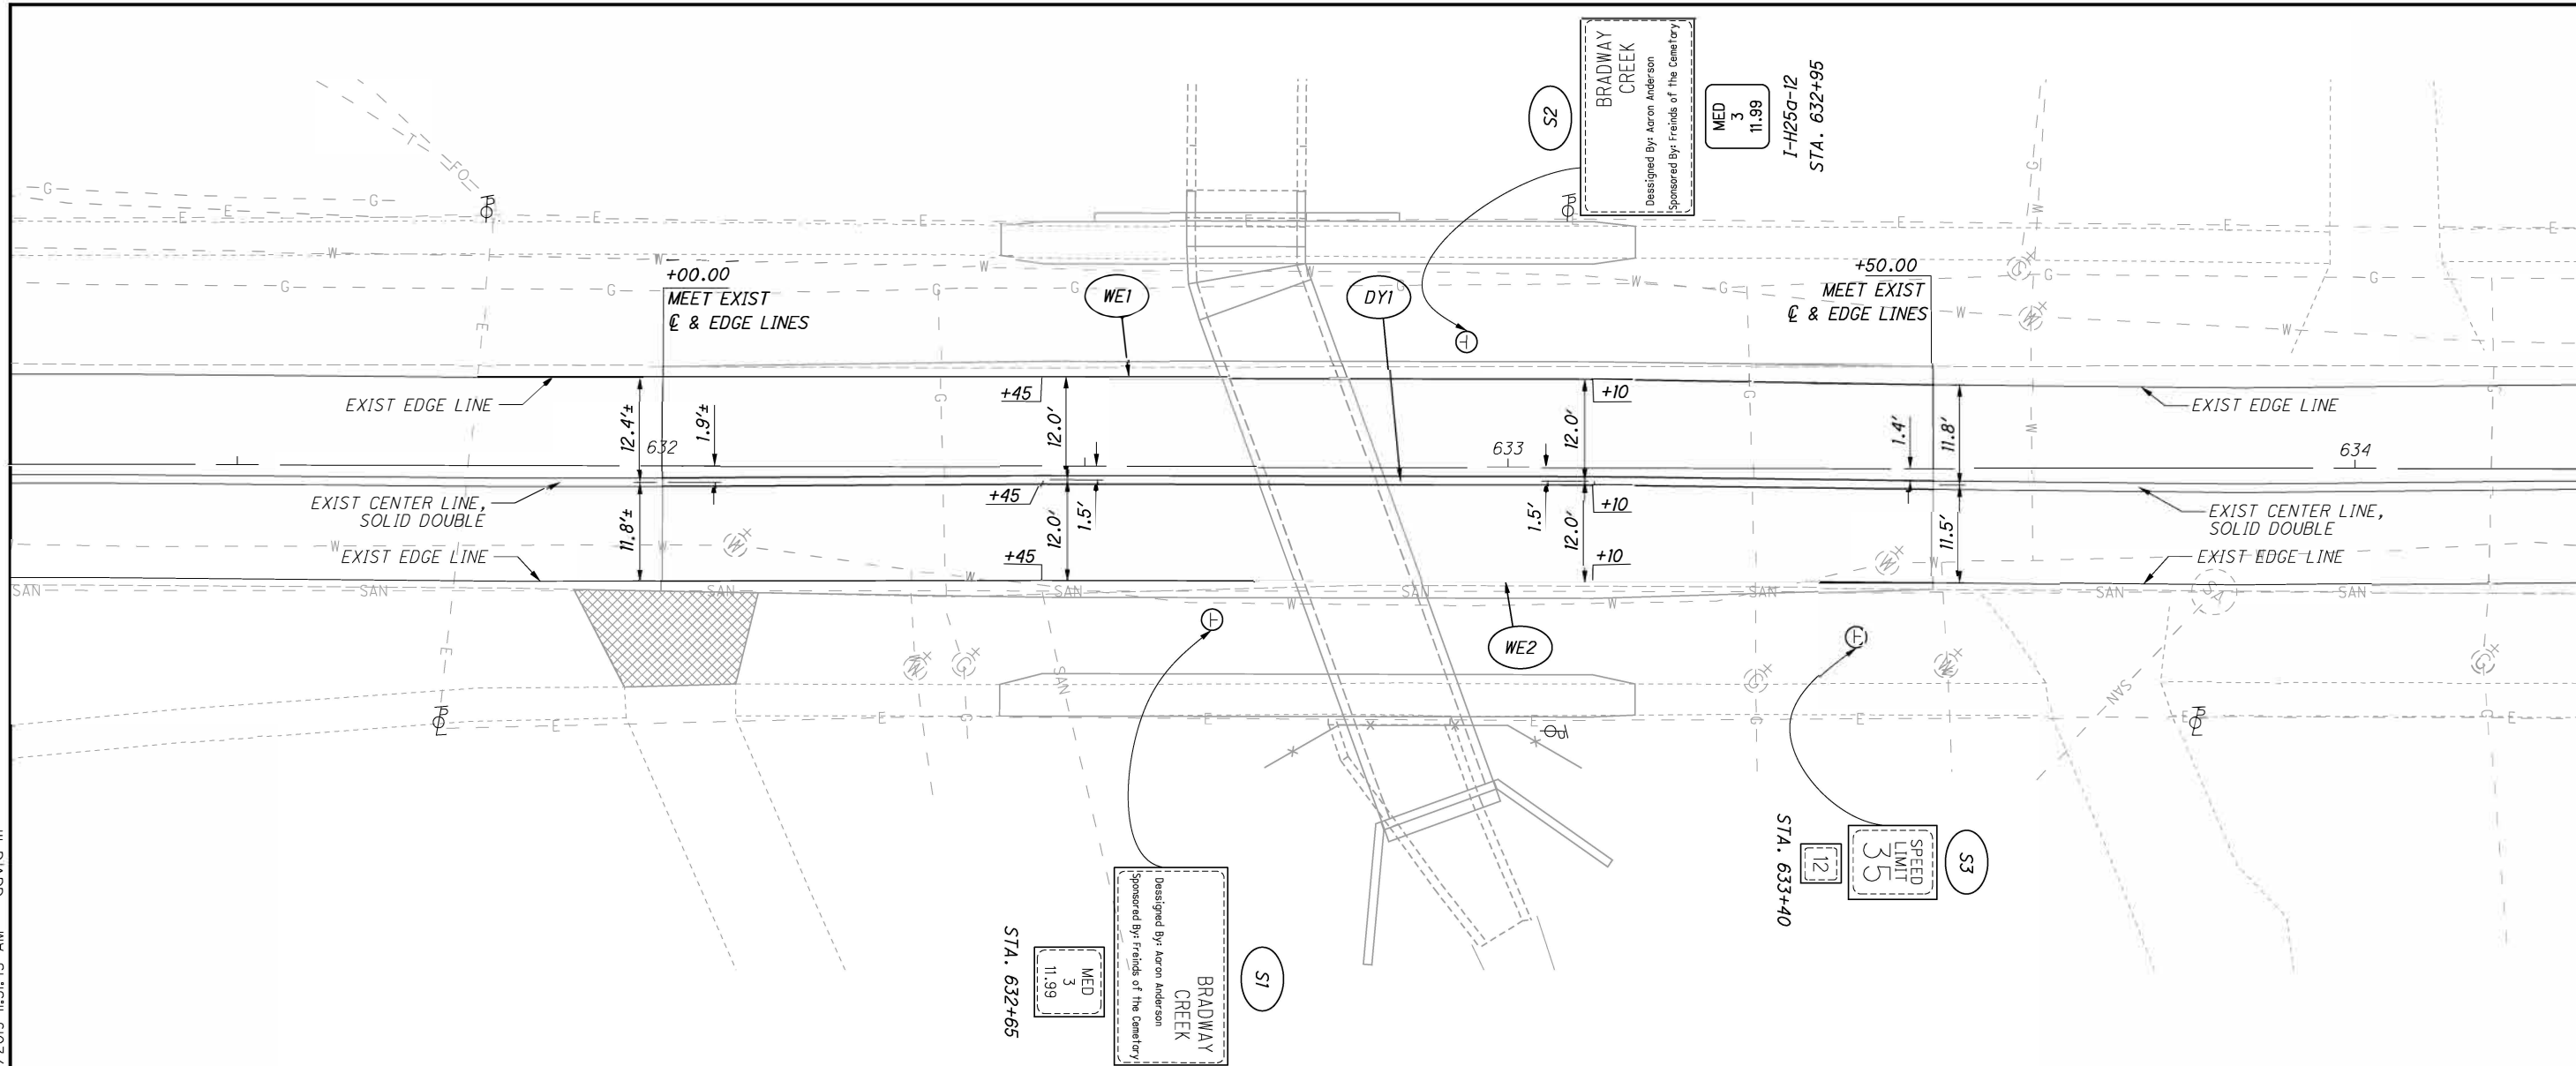

REFERENCE NO.	STATION	SIDE	CODE	SIZE (INCHES)	630			
					GROUND MOUNTED SUPPORT, NO. 2 POST	SIGN, FLAT SHEET	REMOVAL OF GROUND MOUNTED SIGN AND REERECTION	REMOVAL OF GROUND MOUNTED POST SUPPORT AND DISPOSAL
					FT	SQ FT	EA	EA
S1	632+65.00	RT			11.0		2	1
S2	632+95.00	LT	I-25a-12	12 x 12	11.0	1.0	1	1
S3	633+40.00	RT			11.0		2	1
TOTALS CARRIED TO GENERAL SUMMARY					33.0	1.0	5	3

REFERENCE NO.	STATION		LOCATION	LENGTH	642	
	FROM	TO			EDGE LINE, 6" TYPE 1 (W)	CENTER LINE, TYPE 1 (DY)
					MILE	MILE
WE1	632+00.00	633+50.00		150	0.03	
DY1	632+00.00	633+50.00		150		0.03
WE2	632+00.00	633+50.00		150	0.03	
TOTALS CARRIED TO GENERAL SUMMARY					0.06	0.03

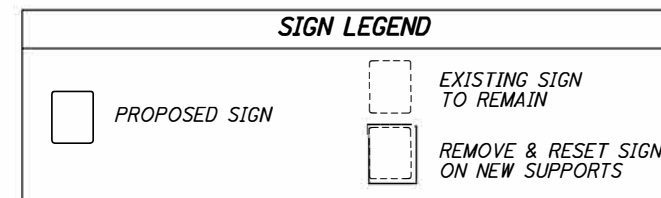

ITEM	ODOT LINE SPECIFICATIONS
644	EDGE LINE, WHITE, 6", TYPE 1
	CENTER LINE, SOLID DOUBLE, YELLOW, TYPE 1



SIGNING AND PAVEMENT MARKING PLAN

MED-SR3-12.00

40
57