


CALCULATED
BRO
CHECKED
PSB

SCHEMATIC PLAN

MED - 3 - 09 . 04

P:\Columbus-OH\Projects\Infrastructure\TOH00T18\PE01 - MED-3-9-05\107070_MED-3-9-05\107070_Design\Roadway\Sheets\107070_GB001.dgn Sheet 3/19/2021 8:05:03 AM MBur-ger

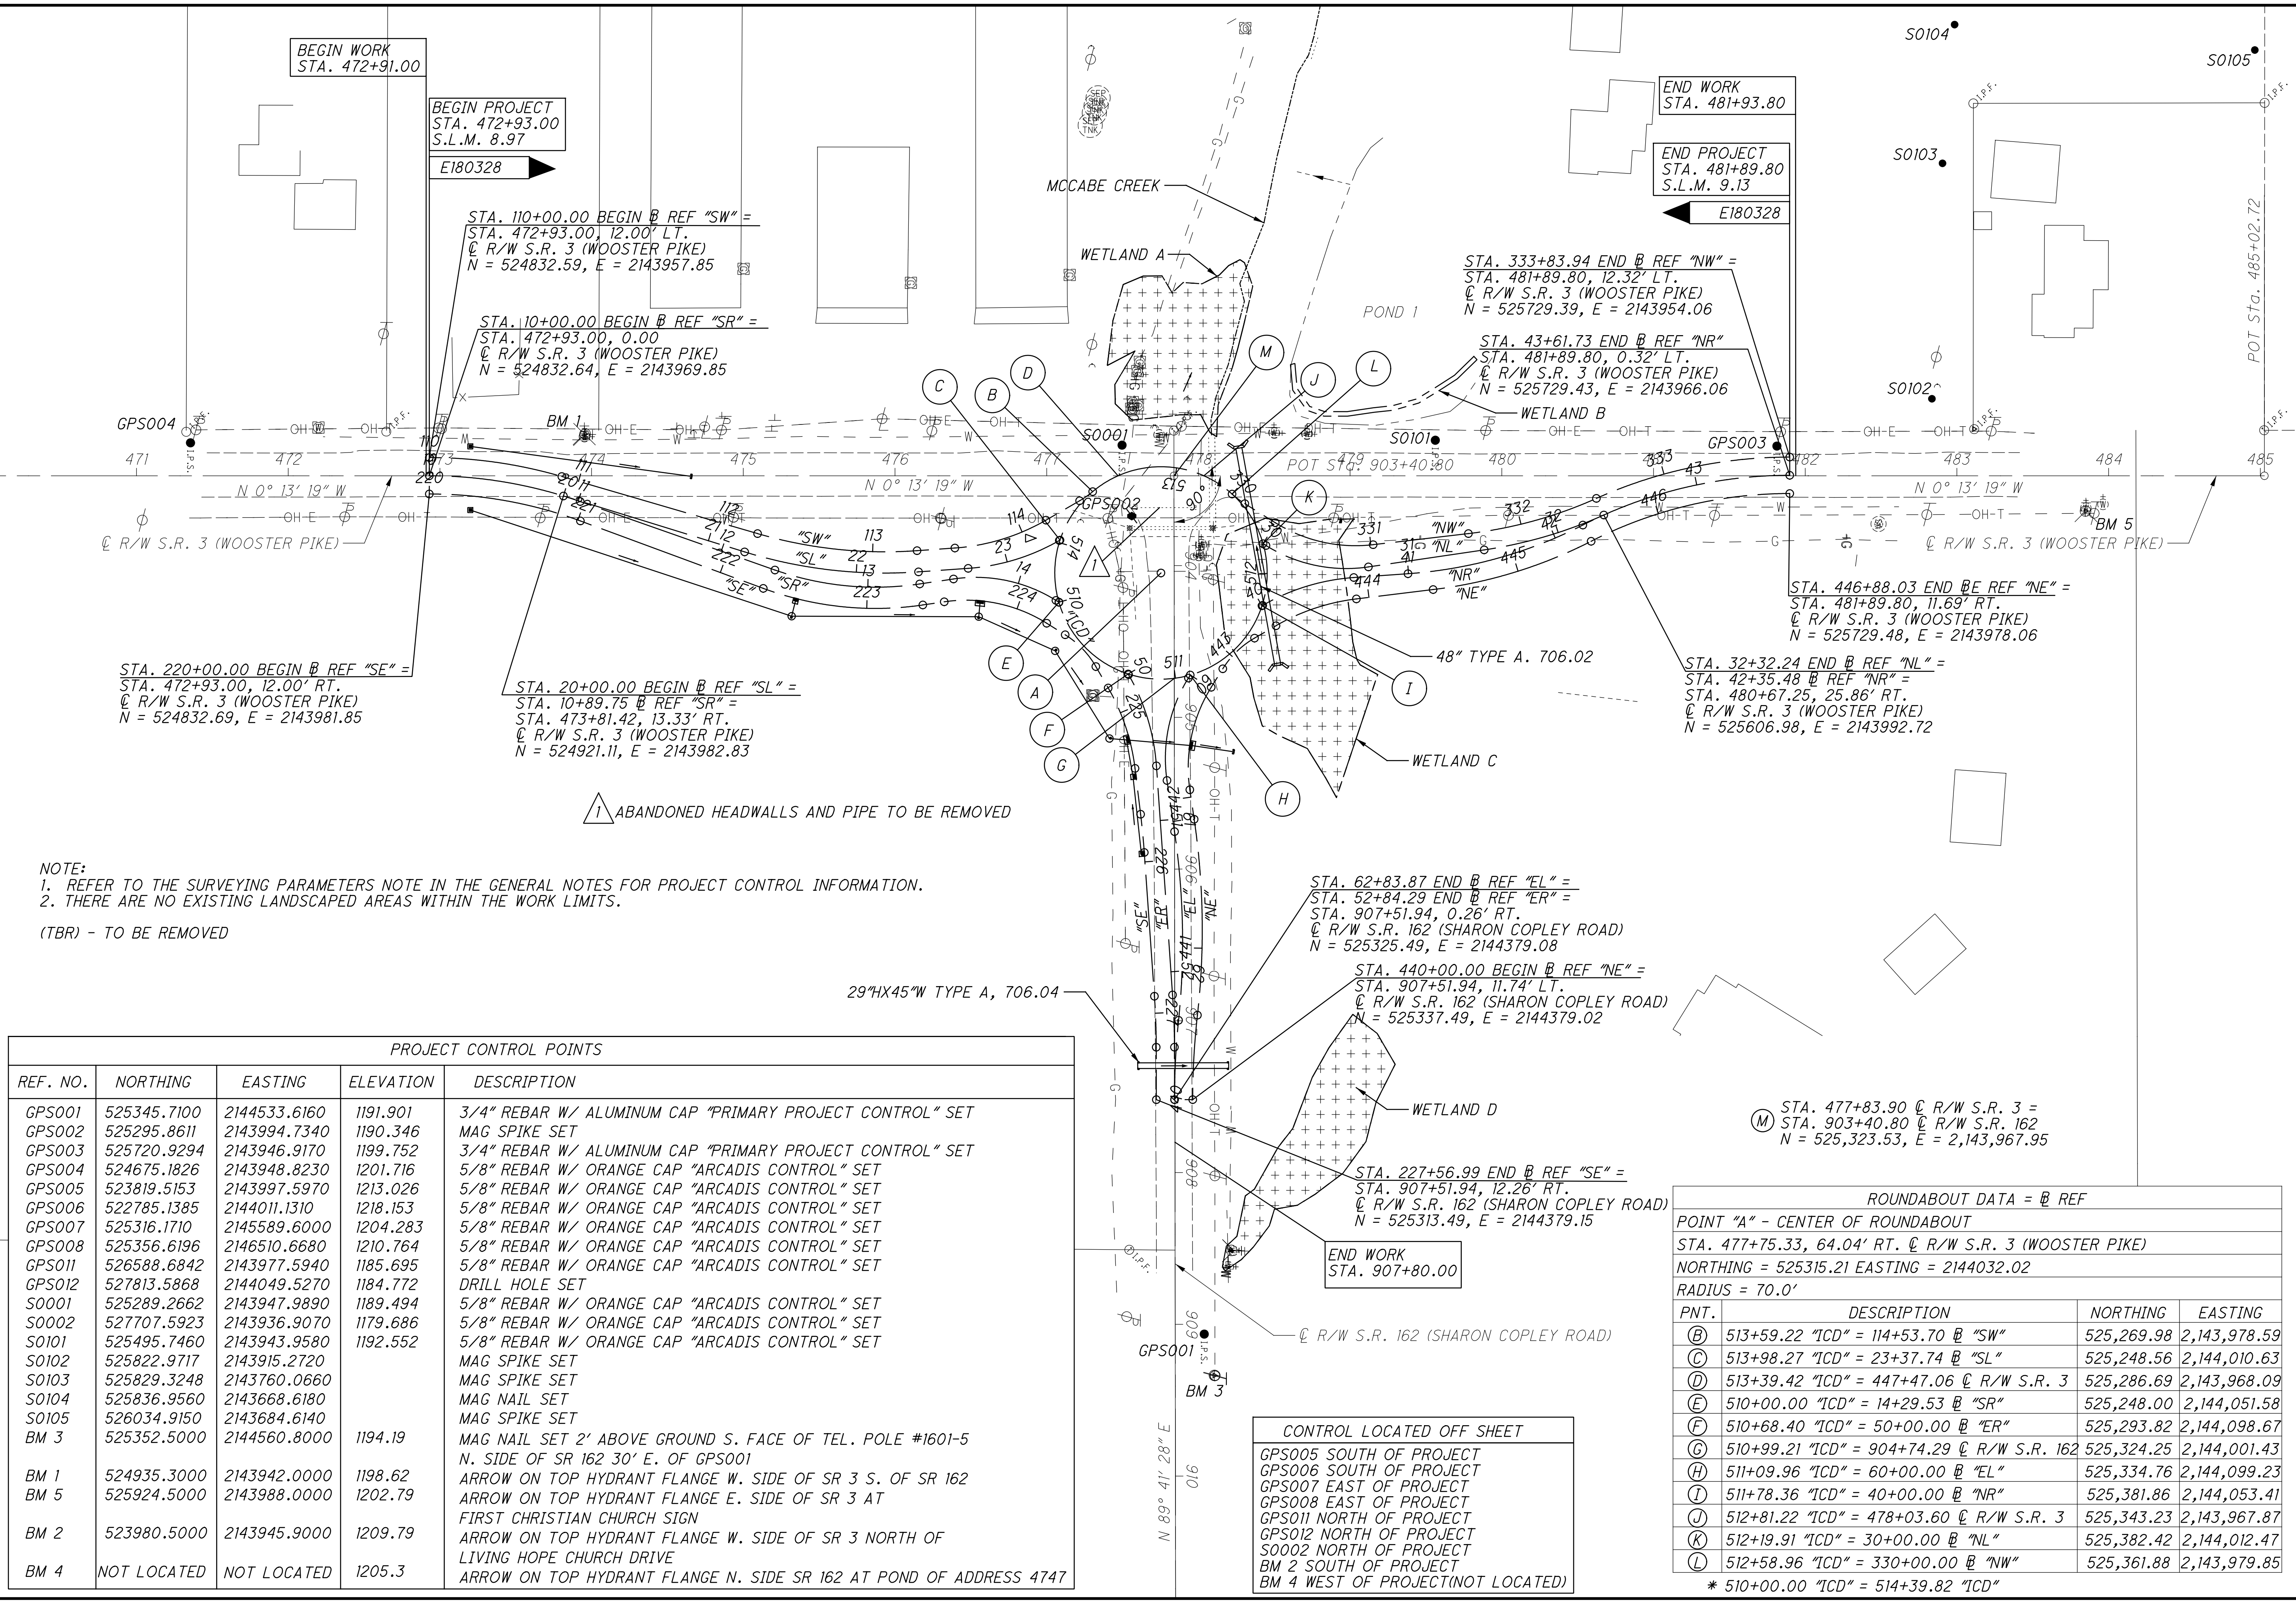

BEGIN WORK
STA. 472+91.00

BEGIN PROJECT
STA. 472+93.00
S.L.M. 8.97
E180328

END WORK
STA. 481+93.80

END PROJECT
STA. 481+89.80
S.L.M. 9.13
E180328

STA. 110+00.00 BEGIN @ REF "SW" =
STA. 472+93.00, 12.00' LT.
@ R/W S.R. 3 (WOOSTER PIKE)
N = 524832.59, E = 2143957.85

STA. 472+93.00, 0.00
@ R/W S.R. 3 (WOOSTER PIKE)
N = 524832.64, E = 2143969.85

STA. 333+83.94 END @ REF "NW" =
STA. 481+89.80, 12.32' LT.
@ R/W S.R. 3 (WOOSTER PIKE)
N = 525729.39, E = 2143954.06

STA. 43+61.73 END @ REF "NR" =
STA. 481+89.80, 0.32' LT.
@ R/W S.R. 3 (WOOSTER PIKE)
N = 525729.43, E = 2143966.06

STA. 446+88.03 END @ REF "NE" =
STA. 481+89.80, 11.69' RT.
@ R/W S.R. 3 (WOOSTER PIKE)
N = 525729.48, E = 2143978.06

STA. 32+32.24 END @ REF "NL" =
STA. 42+35.48 @ REF "NR" =
STA. 480+67.25, 25.86' RT.
@ R/W S.R. 3 (WOOSTER PIKE)
N = 525606.98, E = 2143992.72

STA. 220+00.00 BEGIN @ REF "SE" =
STA. 472+93.00, 12.00' RT.
@ R/W S.R. 3 (WOOSTER PIKE)
N = 524832.69, E = 2143981.85

STA. 20+00.00 BEGIN @ REF "SL" =
STA. 10+89.75 @ REF "SR" =
STA. 473+81.42, 13.33' RT.
@ R/W S.R. 3 (WOOSTER PIKE)
N = 524921.11, E = 2143982.83

STA. 62+83.87 END @ REF "EL" =
STA. 52+84.29 END @ REF "ER" =
STA. 907+51.94, 0.26' RT.
@ R/W S.R. 162 (SHARON COPLEY ROAD)
N = 525325.49, E = 2144379.08

STA. 440+00.00 BEGIN @ REF "NE" =
STA. 907+51.94, 11.74' LT.
@ R/W S.R. 162 (SHARON COPLEY ROAD)
N = 525337.49, E = 2144379.02

STA. 227+56.99 END @ REF "SE" =
STA. 907+51.94, 12.26' RT.
@ R/W S.R. 162 (SHARON COPLEY ROAD)
N = 525313.49, E = 2144379.15

STA. 477+83.90 @ R/W S.R. 3 =
STA. 903+40.80 @ R/W S.R. 162
N = 525,323.53, E = 2,143,967.95

ABANDONED HEADWALLS AND PIPE TO BE REMOVED

NOTE:
1. REFER TO THE SURVEYING PARAMETERS NOTE IN THE GENERAL NOTES FOR PROJECT CONTROL INFORMATION.
2. THERE ARE NO EXISTING LANDSCAPED AREAS WITHIN THE WORK LIMITS.

(TBR) - TO BE REMOVED

PROJECT CONTROL POINTS

REF. NO.	NORTHING	EASTING	ELEVATION	DESCRIPTION
GPS001	525345.7100	2144533.6160	1191.901	3/4" REBAR W/ ALUMINUM CAP "PRIMARY PROJECT CONTROL" SET
GPS002	525295.8611	2143994.7340	1190.346	MAG SPIKE SET
GPS003	525720.9294	2143946.9170	1199.752	3/4" REBAR W/ ALUMINUM CAP "PRIMARY PROJECT CONTROL" SET
GPS004	524675.1826	2143948.8230	1201.716	5/8" REBAR W/ ORANGE CAP "ARCADIS CONTROL" SET
GPS005	523819.5153	2143997.5970	1213.026	5/8" REBAR W/ ORANGE CAP "ARCADIS CONTROL" SET
GPS006	522785.1385	2144011.1310	1218.153	5/8" REBAR W/ ORANGE CAP "ARCADIS CONTROL" SET
GPS007	525316.1710	2145589.6000	1204.283	5/8" REBAR W/ ORANGE CAP "ARCADIS CONTROL" SET
GPS008	525356.6196	2146510.6680	1210.764	5/8" REBAR W/ ORANGE CAP "ARCADIS CONTROL" SET
GPS011	526588.6842	2143977.5940	1185.695	5/8" REBAR W/ ORANGE CAP "ARCADIS CONTROL" SET
GPS012	527813.5868	2144049.5270	1184.772	DRILL HOLE SET
S0001	525289.2662	2143947.9890	1189.494	5/8" REBAR W/ ORANGE CAP "ARCADIS CONTROL" SET
S0002	527707.5923	2143936.9070	1179.686	5/8" REBAR W/ ORANGE CAP "ARCADIS CONTROL" SET
S0101	525495.7460	2143943.9580	1192.552	5/8" REBAR W/ ORANGE CAP "ARCADIS CONTROL" SET
S0102	525822.9717	2143915.2720		MAG SPIKE SET
S0103	525829.3248	2143760.0660		MAG SPIKE SET
S0104	525836.9560	2143668.6180		MAG NAIL SET
S0105	526034.9150	2143684.6140		MAG SPIKE SET
BM 3	525352.5000	2144560.8000	1194.19	MAG NAIL SET 2' ABOVE GROUND S. FACE OF TEL. POLE #1601-5 N. SIDE OF SR 162 30' E. OF GPS001
BM 1	524935.3000	2143942.0000	1198.62	ARROW ON TOP HYDRANT FLANGE W. SIDE OF SR 3 S. OF SR 162
BM 5	525924.5000	2143988.0000	1202.79	ARROW ON TOP HYDRANT FLANGE E. SIDE OF SR 3 AT FIRST CHRISTIAN CHURCH SIGN
BM 2	523980.5000	2143945.9000	1209.79	ARROW ON TOP HYDRANT FLANGE W. SIDE OF SR 3 NORTH OF LIVING HOPE CHURCH DRIVE
BM 4	NOT LOCATED	NOT LOCATED	1205.3	ARROW ON TOP HYDRANT FLANGE N. SIDE SR 162 AT POND OF ADDRESS 4747

ROUNDABOUT DATA = @ REF

POINT "A" - CENTER OF ROUNDABOUT
STA. 477+75.33, 64.04' RT. @ R/W S.R. 3 (WOOSTER PIKE)
NORTHING = 525315.21 EASTING = 2144032.02
RADIUS = 70.0'

PNT.	DESCRIPTION	NORTHING	EASTING
(B)	513+59.22 "ICD" = 114+53.70 @ "SW"	525,269.98	2,143,978.59
(C)	513+98.27 "ICD" = 23+37.74 @ "SL"	525,248.56	2,144,010.63
(D)	513+39.42 "ICD" = 447+47.06 @ R/W S.R. 3	525,286.69	2,143,968.09
(E)	510+00.00 "ICD" = 14+29.53 @ "SR"	525,248.00	2,144,051.58
(F)	510+68.40 "ICD" = 50+00.00 @ "ER"	525,293.82	2,144,098.67
(G)	510+99.21 "ICD" = 904+74.29 @ R/W S.R. 162	525,324.25	2,144,001.43
(H)	511+09.96 "ICD" = 60+00.00 @ "EL"	525,334.76	2,144,099.23
(I)	511+78.36 "ICD" = 40+00.00 @ "NR"	525,381.86	2,144,053.41
(J)	512+81.22 "ICD" = 478+03.60 @ R/W S.R. 3	525,343.23	2,143,967.87
(K)	512+19.91 "ICD" = 30+00.00 @ "NL"	525,382.42	2,144,012.47
(L)	512+58.96 "ICD" = 330+00.00 @ "NW"	525,361.88	2,143,979.85

* 510+00.00 "ICD" = 514+39.82 "ICD"

CONTROL LOCATED OFF SHEET
GPS005 SOUTH OF PROJECT
GPS006 SOUTH OF PROJECT
GPS007 EAST OF PROJECT
GPS008 EAST OF PROJECT
GPS011 NORTH OF PROJECT
GPS012 NORTH OF PROJECT
S0002 NORTH OF PROJECT
BM 2 SOUTH OF PROJECT
BM 4 WEST OF PROJECT (NOT LOCATED)

ROUNDING

THE ROUNDING AT SLOPE BREAKPOINTS SHOWN ON THE TYPICAL SECTIONS APPLIES TO ALL CROSS-SECTIONS EVEN THOUGH OTHERWISE SHOWN.

UTILITIES

LISTED BELOW ARE ALL UTILITIES LOCATED WITHIN THE PROJECT CONSTRUCTION LIMITS TOGETHER WITH THEIR RESPECTIVE OWNERS:

WATER, SEWER & SANITARY

MEDINA COUNTY SANITARY ENGINEERS
ATTN: JEREMY SINKO
791 WEST SMITH ROAD
MEDINA, OH 44256
330-764-8331
JSINKO@MEDINACO.ORG

GAS

ASPIRE ENERGY OF OHIO, LLC
ATTN: ANTHONY D'EDIGIO
300 TRACY BRIDGE ROAD
ORRVILLE, OH 44667
330-682-1642
ADEGIDIO@CHPK.COM

COLUMBIA GAS OF OHIO
ATTN: TOM JADLOS
7080 FRY ROAD
MIDDLEBURG HEIGHTS, OH 44130
440-891-2493
TJADLOS@NISOURCE.COM

COMMUNICATIONS

FRONTIER COMMUNICATIONS
ATTN: RANDY HOWARD
6223 NORWALK ROAD
MEDINA, OH 44256
330-722-9586
J.HOWARD@FTR.COM

ARMSTRONG CABLE
ATTN: MARK LOYER
1141 LAFAYETTE ROAD
MEDINA, OH 44256
330-802-5991
MLOYER@AGOC.COM

ALLIED CABLE
ATTN: BOB LUCARELLI, CEO
800 WEST LIBERTY ST.,
MEDINA, OH 44256
440-582-0111
SALES@ALLIEDCABLE.COM

CHARTER COMMUNICATIONS
ATTN: JUSTIN HALFORD
1200 BROWNSTONE AVE.
AKRON, OH 44310
330-622-5634
JUSTIN.HALFORD@CHARTER.COM

ACD.NET
ATTN: KATE BARLAS
1800 NORTH GRAND RIVER AVENUE
LANSING, MI 48906
517-999-9999
BARLAS.KATE@ACD.NET

MEDINA COUNTY FIBER NETWORK
ATTN: DAVE CORRADO, CEO
144 NORTH BROADWAY ST.
MEDINA, OH 44256
216-832-7059
DCORRADO@FIBERCOUNTY.COM

MEDINA COUNTY SCHOOLS
ATTN: RYAN O'GULL
777 EAST UNION STREET
MEDINA, OH 44256
330-636-3231
OCULLR@MEDINABEES.ORG

ELECTRIC

OHIO EDISON COMPANY
ATTN: BRAD COWLING
6326 LAKE AVENUE
ELYRIA, OH 44035
419-326-3238
BCOWLING@FIRSTENERGYCORP.COM

OHIO EDISON
ATTN: ERIC YOUNG
76 SOUTH MAIN STREET
AKRON, OH 44308
330-419-2798
YOUNGE@FIRSTENERGYCORP.COM

THE LOCATION OF THE UNDERGROUND UTILITIES SHOWN ON THE PLANS ARE AS OBTAINED FROM THE OWNERS AS REQUIRED BY SECTION 153.64 O.R.C.

CONSTRUCTION NOISE

ACTIVITIES AND LAND USE ADJACENT TO THIS PROJECT MAY BE AFFECTED BY CONSTRUCTION NOISE. IN ORDER TO MINIMIZE ANY ADVERSE CONSTRUCTION NOISE IMPACTS, DO NOT OPERATE POWER-OPERATED CONSTRUCTION-TYPE DEVICES BETWEEN THE HOURS OF 7PM AND 7AM. IN ADDITION, DO NOT OPERATE AT ANY TIME ANY DEVICE IN SUCH A MANNER THAT THE NOISE CREATED SUBSTANTIALLY EXCEEDS THE NOISE CUSTOMARILY AND NECESSARILY ATTENDANT TO THE REASONABLE AND EFFICIENT PERFORMANCE OF SUCH EQUIPMENT.

SURVEYING PARAMETERS

PRIMARY PROJECT CONTROL MONUMENTS GOVERN ALL POSITIONING ON ODOT PROJECTS. SEE SHEET 2 OF THE PLANS FOR A TABLE CONTAINING PROJECT CONTROL INFORMATION.

USE THE FOLLOWING PROJECT CONTROL, VERTICAL POSITIONING, AND HORIZONTAL POSITIONING PARAMETERS FOR ALL SURVEYING:

PROJECT CONTROL

POSITIONING METHOD: STATIC GNSS
MONUMENT TYPE: B

VERTICAL POSITIONING

ORTHOMETRIC HEIGHT DATUM: NAVD88
GEOID: 12B

HORIZONTAL POSITIONING

REFERENCE FRAME: NAD83 (2011)
ELLIPSOID: GRS80
MAP PROJECTION: LAMBERT CONFORMAL CONIC
COORDINATE SYSTEM: OHIO STATE PLANE, NORTH ZONE
COMBINED SCALE FACTOR: 1.0001121934 (FROM GRID TO GROUND)
ORIGIN OF COORDINATE SYSTEM: 0,0

USE THE POSITIONING METHODS AND MONUMENT TYPE USED IN THE ORIGINAL SURVEY TO RESTORE ALL MONUMENTS RELATED TO PRIMARY PROJECT CONTROL THAT ARE DAMAGED OR DESTROYED BY CONSTRUCTION ACTIVITIES. RESTORE THE DAMAGED OR DESTROYED MONUMENTS IN ACCORDANCE WITH CMS 623.

UNITS ARE IN U.S. SURVEY FEET.

WORK LIMITS

THE WORK LIMITS SHOWN ON THESE PLANS ARE FOR PHYSICAL CONSTRUCTION ONLY. PROVIDE THE INSTALLATION AND OPERATION OF ALL WORK ZONE TRAFFIC CONTROL AND WORK ZONE TRAFFIC CONTROL DEVICES REQUIRED BY THESE PLANS WHETHER INSIDE OR OUTSIDE THESE WORK LIMITS.

CLEARING AND GRUBBING

A LUMP SUM QUANTITY IS INCLUDED IN THE GENERAL SUMMARY FOR ITEM 201, CLEARING AND GRUBBING. ALL PROVISIONS AS SET FORTH IN THE SPECIFICATIONS UNDER THIS ITEM ARE INCLUDED IN THE LUMP SUM PRICE BID FOR ITEM 201, CLEARING AND GRUBBING.

MONUMENT ASSEMBLIES

CONSTRUCT MONUMENT ASSEMBLIES IN ACCORDANCE WITH THE DETAILS SHOWN ON THE STANDARD CONSTRUCTION DRAWINGS AND AT THE LOCATIONS SHOWN ON SHEET NO. 72.

ITEM 206 - CEMENT STABILIZED SUBGRADE, 14 INCHES DEEP

CEMENT SHALL BE USED UTILIZED AS THE CHEMICAL ADDITIVE AND SHALL EXTEND TO A DEPTH OF 14 INCHES BELOW THE PROPOSED SUBGRADE LEVEL AND 18 INCHES OUTSIDE THE EDGE OF THE PROPOSED PAVEMENT OR PAVED SHOULDER, INCLUDING BENEATH THE CURB AND GUTTER.

ITEM 204 - EXCAVATION OF SUBGRADE AND EMBANKMENT

PRIOR TO COMMENCING EARTHWORK OPERATIONS, ALL EXISTING PAVEMENT, GRANULAR BASE, SOD, TOPSOIL, AND OTHER MISCELLANEOUS MATERIALS MUST BE REMOVED FROM THE ENTIRE FOOTPRINT OF THE PROPOSED ROADWAY IMPROVEMENT. THE ENTIRE EXPOSED SUBGRADE AND EMBANKMENT FOUNDATION SURFACE MUST BE EXAMINED BY THE DESIGNATED REPRESENTATIVE TO IDENTIFY ANY WEAK, WET, ORGANIC, OR OTHERWISE UNSUITABLE SOILS. APPROXIMATE LIMITS OF UNSUITABLE SUBGRADE IS SHOWN AND LABELED IN THE CROSS SECTIONS.

ANY SUCH MATERIALS IDENTIFIED SHALL BE REMOVED AND REPLACED WITH SUITABLE COMPACTED FILL ITEM 203 EMBANKMENT.

THE SUBGRADE FOUNDATION SHOULD BE COMPACTED AND TEST ROLLED IN ACCORDANCE WITH ITEM 204 OF THE ODOT CMS, WITH ANY WEAK OR UNSUITABLE AREAS IN ACCORDANCE WITH ITEM 204.07.

ALL SOIL PLACED AS BORROW WITHIN 2 FEET OF THE PROPOSED PAVEMENT SUBGRADE ELEVATION MUST BE TESTED IN THE LABORATORY TO DETERMINE THAT THE PLASTICITY INDEX OF THE BORROW SOIL IS LESS THAN 20. LAB TESTING OF THE BORROW SOILS SHALL BE PERFORMED PRIOR TO IMPORTING BORROW TO THE SITE.

THE FOLLOWING ESTIMATED QUANTITIES HAVE BEEN INCLUDED IN THE GENERAL SUMMARY FOR THE WORK NOTED ABOVE:

ITEM 203 - EMBANKMENT	1,000 CU YD
ITEM 204 - EXCAVATION OF SUBGRADE	1,000 CU YD
ITEM 204 - SUBGRADE COMPACTION	1,500 SQ YD

ITEM 204 - PROOF ROLLING

THE FOLLOWING QUANTITY IS PROVIDED IN THE GENERAL SUMMARY TO ADDRESS LOCATIONS REQUIRING PROOF ROLLING.

ITEM 204 - PROOF ROLLING 4 HOUR.

 ABANDONED HEADWALLS AND PIPE TO BE REMOVED

SUBGRADE COMPACTION

SUBGRADE COMPACTION SHALL BE REQUIRED UNDER DRIVES. FOLLOW THE REQUIREMENTS FOR SUBGRADE COMPACTION UNDER DRIVES AS DESCRIBED IN SECTION 204.03. THE COST FOR SUBGRADE COMPACTION BENEATH DRIVES SHALL BE INCLUDED IN THE APPROPRIATE UNIT PRICE BID FOR ITEM 203 - EMBANKMENT.

SEEDING AND MULCHING

THE FOLLOWING QUANTITIES ARE PROVIDED TO PROMOTE GROWTH AND CARE OF PERMANENT SEEDED AREAS:

659, SOIL ANALYSIS TEST	2 EACH
659, TOPSOIL	872 CU. YD.
659, INTER-SEEDING	7,841 SQ. YD.
659, COMMERCIAL FERTILIZER	0.71 TON
659, LIME	8.1 ACRES
659, WATER	43 M. GAL.

SEEDING AND MULCHING SHALL BE APPLIED TO ALL AREAS OF EXPOSED SOIL BETWEEN THE RIGHT-OF-WAY LINES, AND WITHIN THE CONSTRUCTION LIMITS FOR AREAS OUTSIDE THE RIGHT-OF-WAY LINES COVERED BY WORK AGREEMENT OR SLOPE EASEMENT. QUANTITY CALCULATIONS FOR SEEDING AND MULCHING ARE BASED ON THESE LIMITS.

DRAINAGE

CROSSINGS AND CONNECTIONS TO EXISTING PIPES AND UTILITIES

WHERE PLANS PROVIDE FOR A PROPOSED CONDUIT TO BE CONNECTED TO, OR CROSS OVER OR UNDER AN EXISTING SEWER OR UNDERGROUND UTILITY, THE CONTRACTOR SHALL LOCATE THE EXISTING PIPES OR UTILITIES BOTH AS TO LINE AND GRADE BEFORE STARTING TO LAY THE PROPOSED CONDUIT.

IF IT IS DETERMINED THAT THE ELEVATION OF THE EXISTING CONDUIT, OR EXISTING APPURTENANCE TO BE CONNECTED, DIFFERS FROM THE PLAN ELEVATION OR RESULTS IN A CHANGE IN THE PLAN CONDUIT SLOPE, THE ENGINEER SHALL BE NOTIFIED BEFORE STARTING CONSTRUCTION OF ANY PORTION OF THE PROPOSED CONDUIT WHICH WILL BE AFFECTED BY THE VARIANCE IN THE EXISTING ELEVATIONS.

IF IT IS DETERMINED THAT THE PROPOSED CONDUIT WILL INTERSECT AN EXISTING SEWER OR UNDERGROUND UTILITY IF CONSTRUCTED AS SHOWN ON THE PLAN, THE ENGINEER SHALL BE NOTIFIED BEFORE STARTING CONSTRUCTION OF ANY PORTION OF THE PROPOSED CONDUIT WHICH WOULD BE AFFECTED BY THE INTERFERENCE WITH AN EXISTING FACILITY.

PAYMENT FOR ALL THE OPERATIONS DESCRIBED ABOVE SHALL BE INCLUDED IN THE CONTRACT PRICE FOR THE PERTINENT 611 CONDUIT ITEM.



ITEM 202 - PIPE REMOVED, 24" AND UNDER, AS PER PLAN HEADWALL REMOVED, AS PER PLAN


THIS WORK SHALL CONSIST OF REMOVING ENTIRELY AND DISPOSING OF AN ABANDONED 12" STORM PIPE AND TWO CONCRETE HEADWALLS FOUND 18" BELOW EXISTING GROUND CROSSING S.R. 162 AT STA. 903+62±.

PAYMENT IS FULL COMPENSATION FOR ALL WORK INVOLVED IN THE REMOVAL AND DISPOSAL INCLUDING EXCAVATION AND BACKFILL INCIDENTAL TO THEIR REMOVAL.

THE FOLLOWING ESTIMATED QUANTITIES HAVE BEEN PROVIDED IN THE GENERAL SUMMARY FOR THE WORK NOTED ABOVE:

ITEM 202 - PIPE REMOVED, 24" AND UNDER, AS PER PLAN	40 FT
ITEM 202 - HEADWALL REMOVED, AS PER PLAN	2 EACH

P:\Columbus-OH\Projects\Infrastructure\TOH00T18\PE01 - MED-3-9-05\07070-MED-3-9-05\Design\Roadway\Sheets\07070_GN001.dgn Sheet 3/19/2021 8:11:46 AM MBur-ger

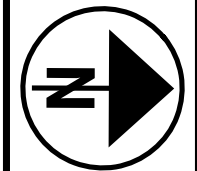

CALCULATED
MJB
CHECKED
PSB








10
HORIZONTAL
SCALE IN FEET

SHEET NO.	CROSS REFERENCES
2 - 3	SCHEMATIC
4 - 8	TYPICALS
23 - 26	PROFILES
33 - 38	CROSS SECTIONS (S.R. 3)
41 - 43	CROSS SECTIONS (S.R. 162)
52 - 53	SPLITTER ISLAND DETAILS
48 - 50	INTERSECTION DETAIL
55	STORM SEWER PROFILES
56	CULVERT DETAILS
59	WATER LINE PROFILE
64	TRAFFIC CONTROL
69	LIGHTING

PLAN SHEET
STA. 475+50.00 TO STA. 480+50.00

MED - 3 - 09 . 04

20
80

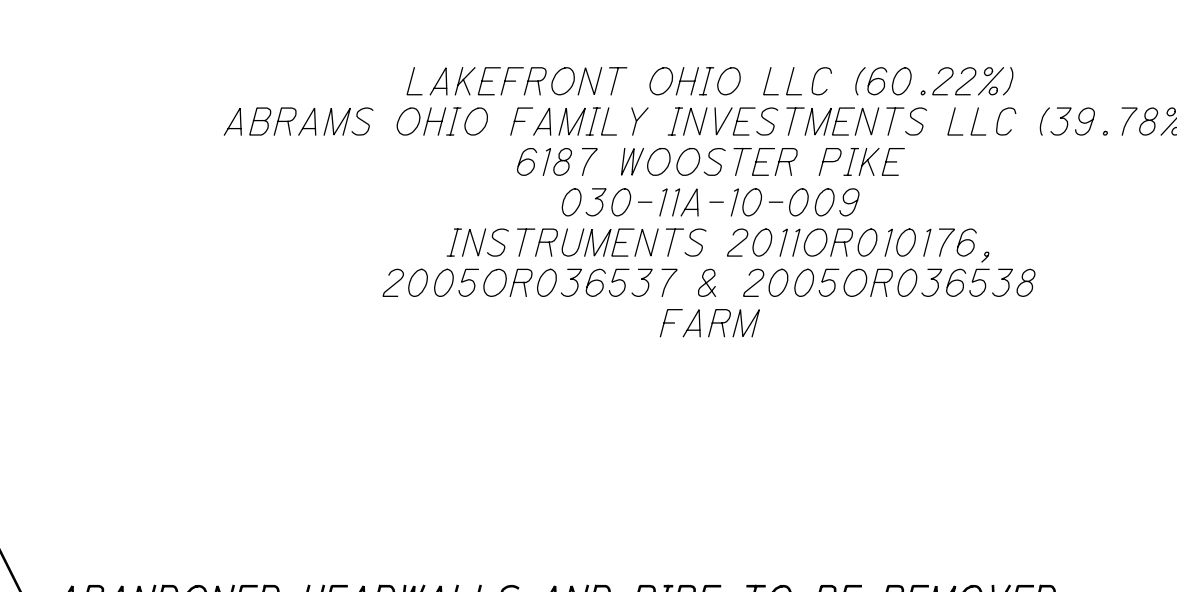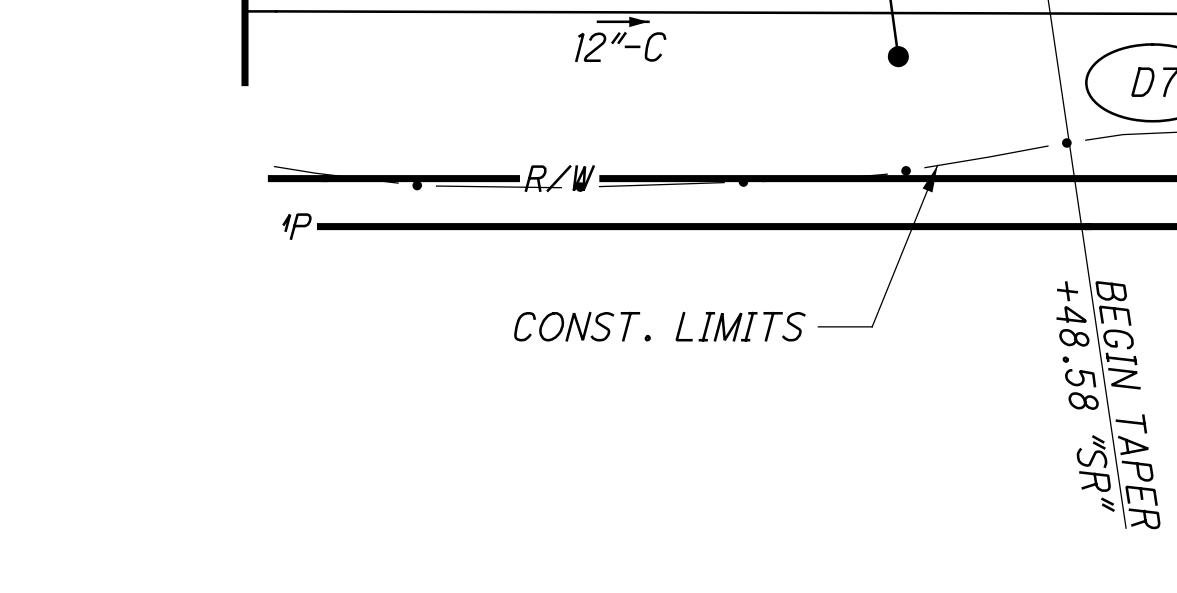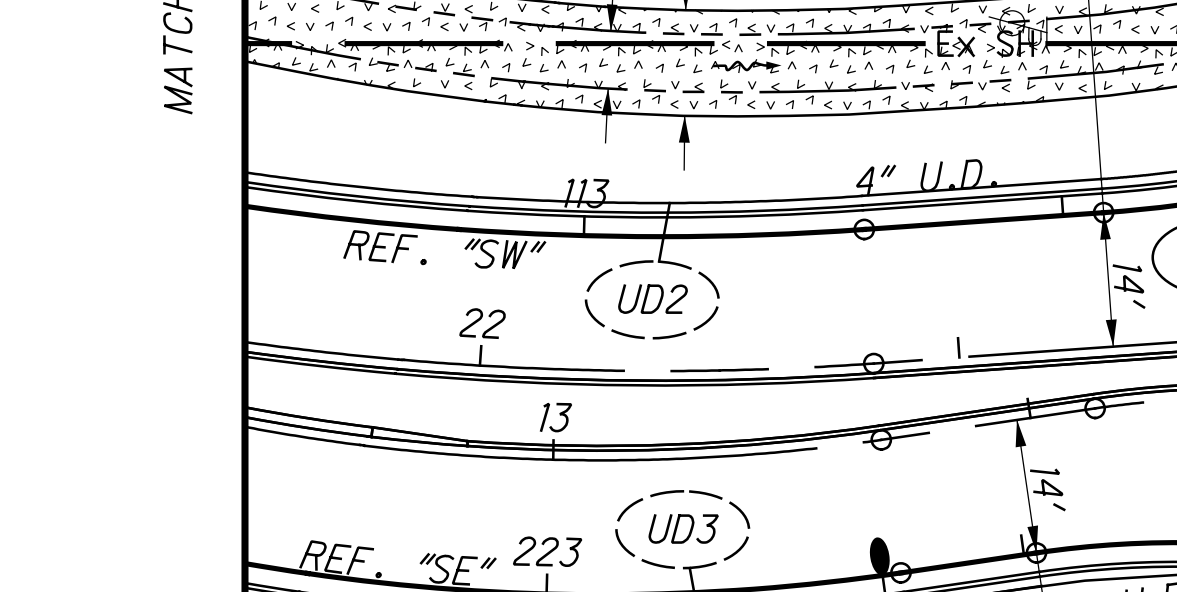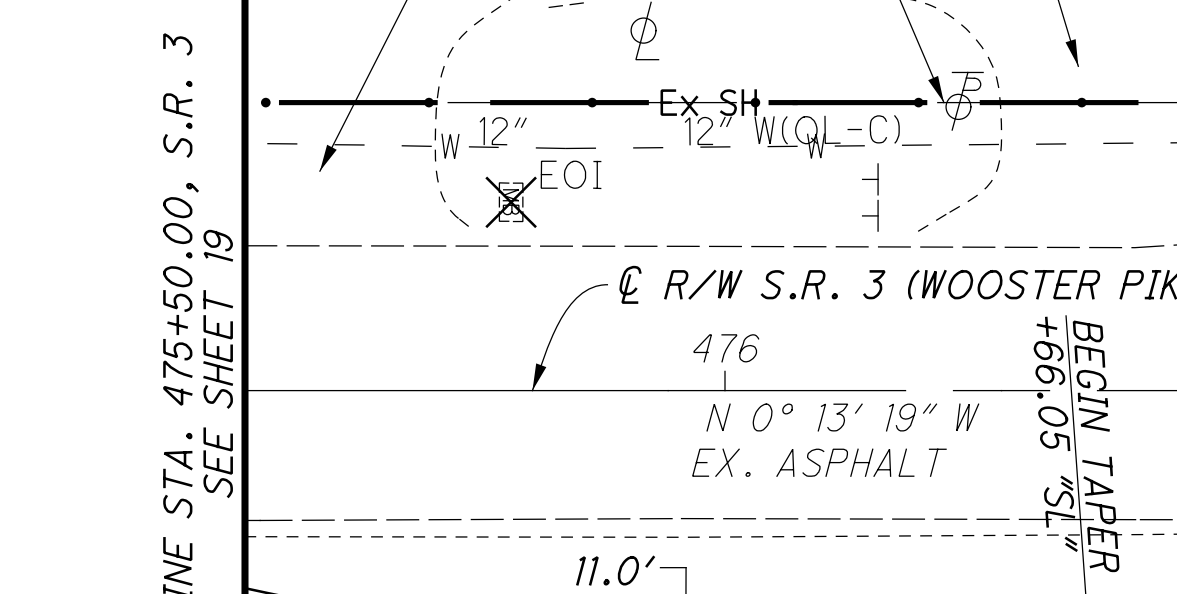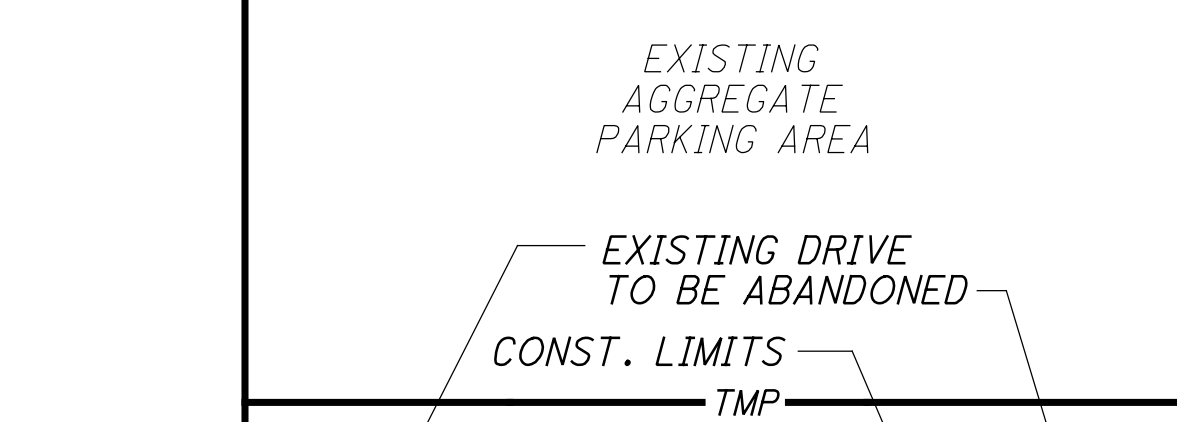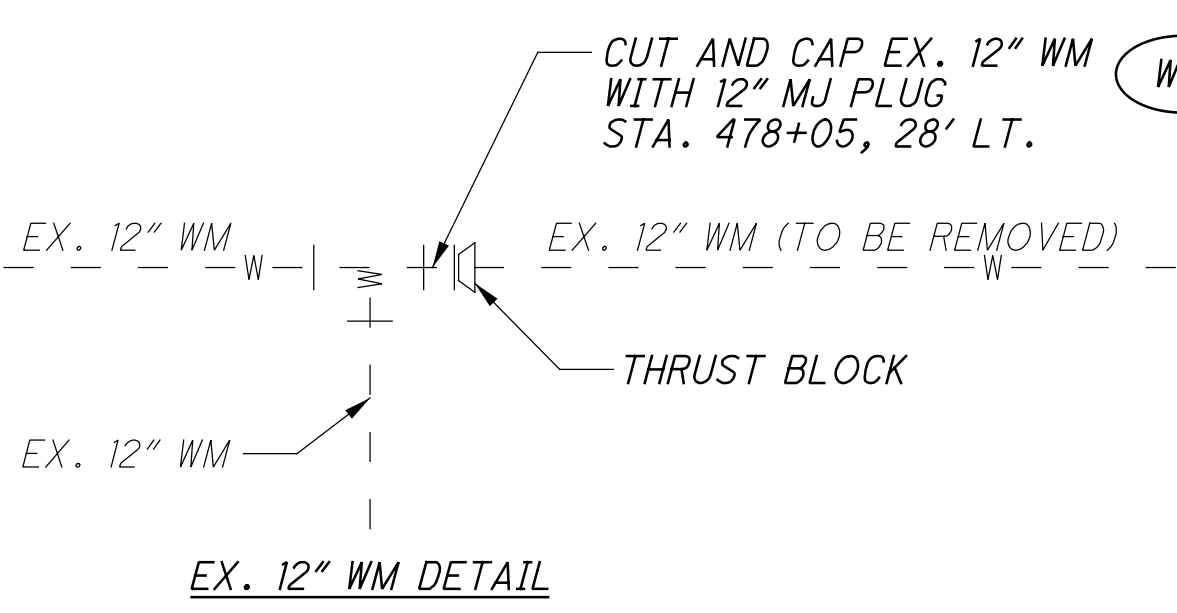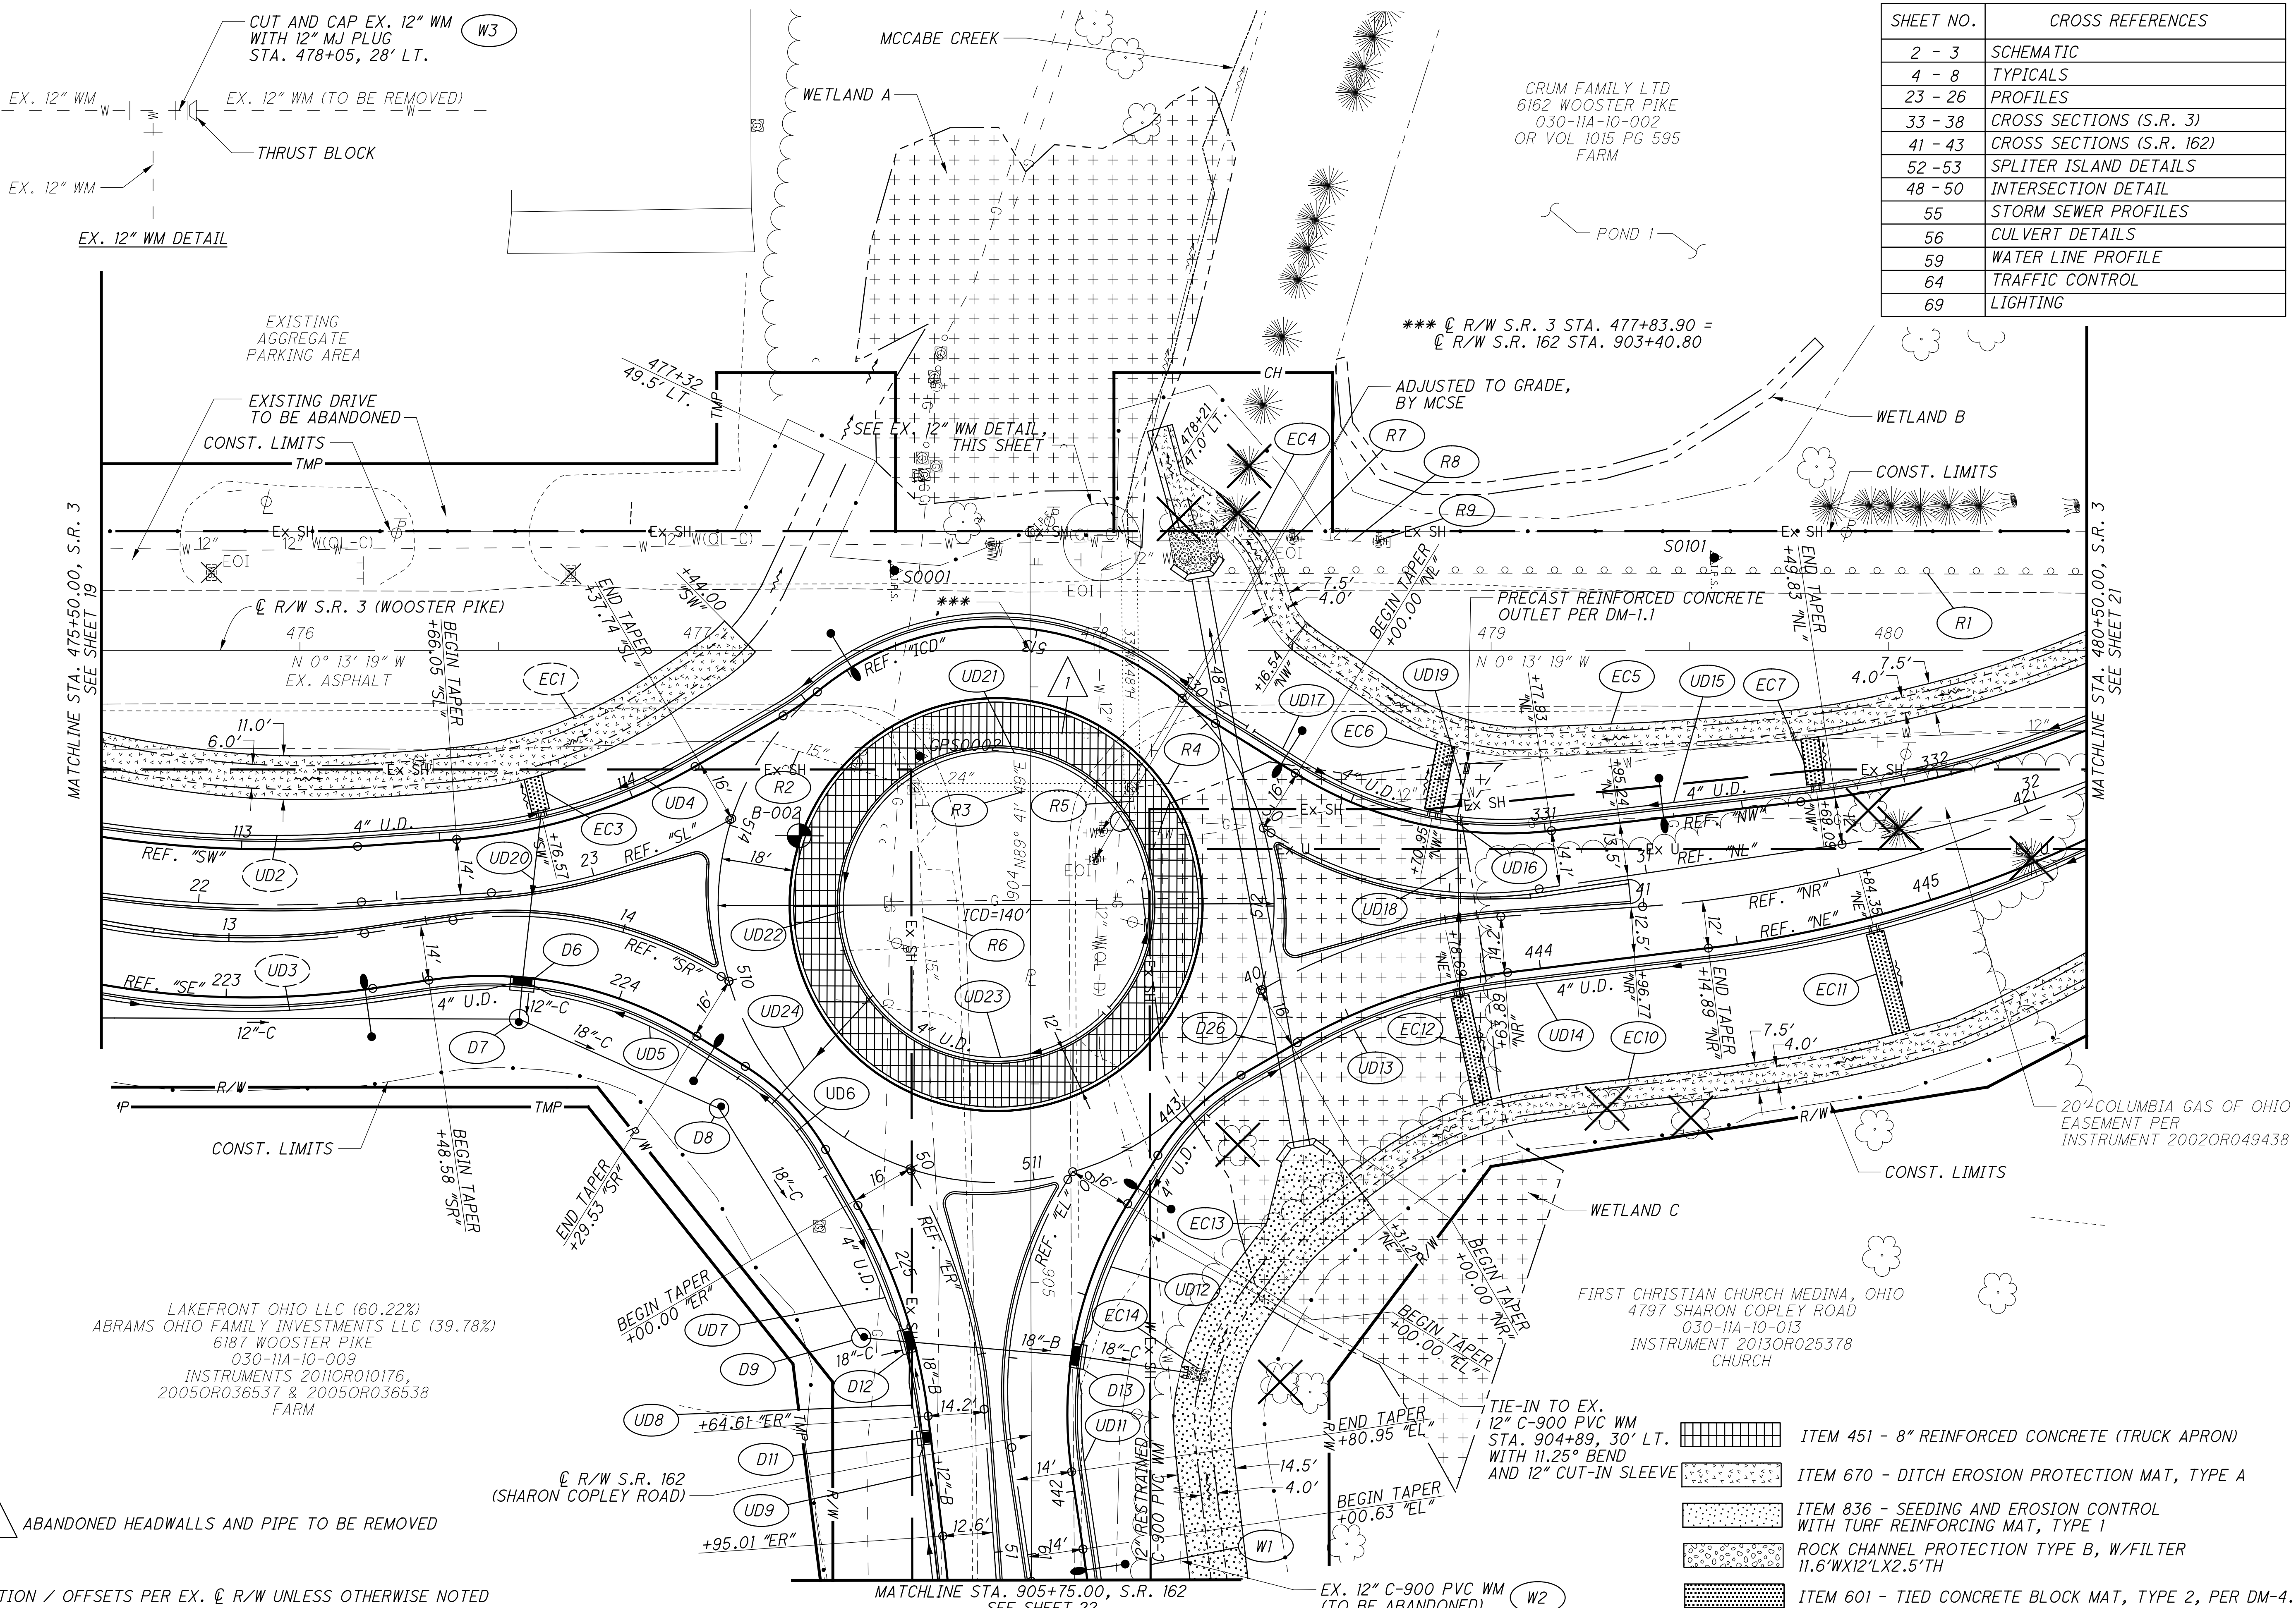


1 ABANDONED HEADWALLS AND PIPE TO BE REMOVED

STATION / OFFSETS PER EX. ϕ R/W UNLESS OTHERWISE NOTED

- ITEM 451 - 8" REINFORCED CONCRETE (TRUCK APRON)
- ITEM 670 - DITCH EROSION PROTECTION MAT, TYPE A
- ITEM 836 - SEEDING AND EROSION CONTROL WITH TURF REINFORCING MAT, TYPE 1
- ROCK CHANNEL PROTECTION TYPE B, W/FILTER 11.6"WX12"LX2.5"TH
- ITEM 601 - TIED CONCRETE BLOCK MAT, TYPE 2, PER DM-4.1

P:\Columbus-OH\Projects\Infrastructure\TOH00118\PE01 - MED-3-9-05\107070_MED-3-9-05\Design\Roadway\Sheets\107070_GP002.dgn Sheet 3/19/2021 8:09:14 AM MBurger


P:\Columbus-OH\Projects\Infrastructure\TOH0018\PE01 - MED-3-9-05\107070_MED-3-9-05\Design\Drainage\Sheets\107070_DC001.dgn Sheet 3/19/2021 7:57:35 AM MBur-ger

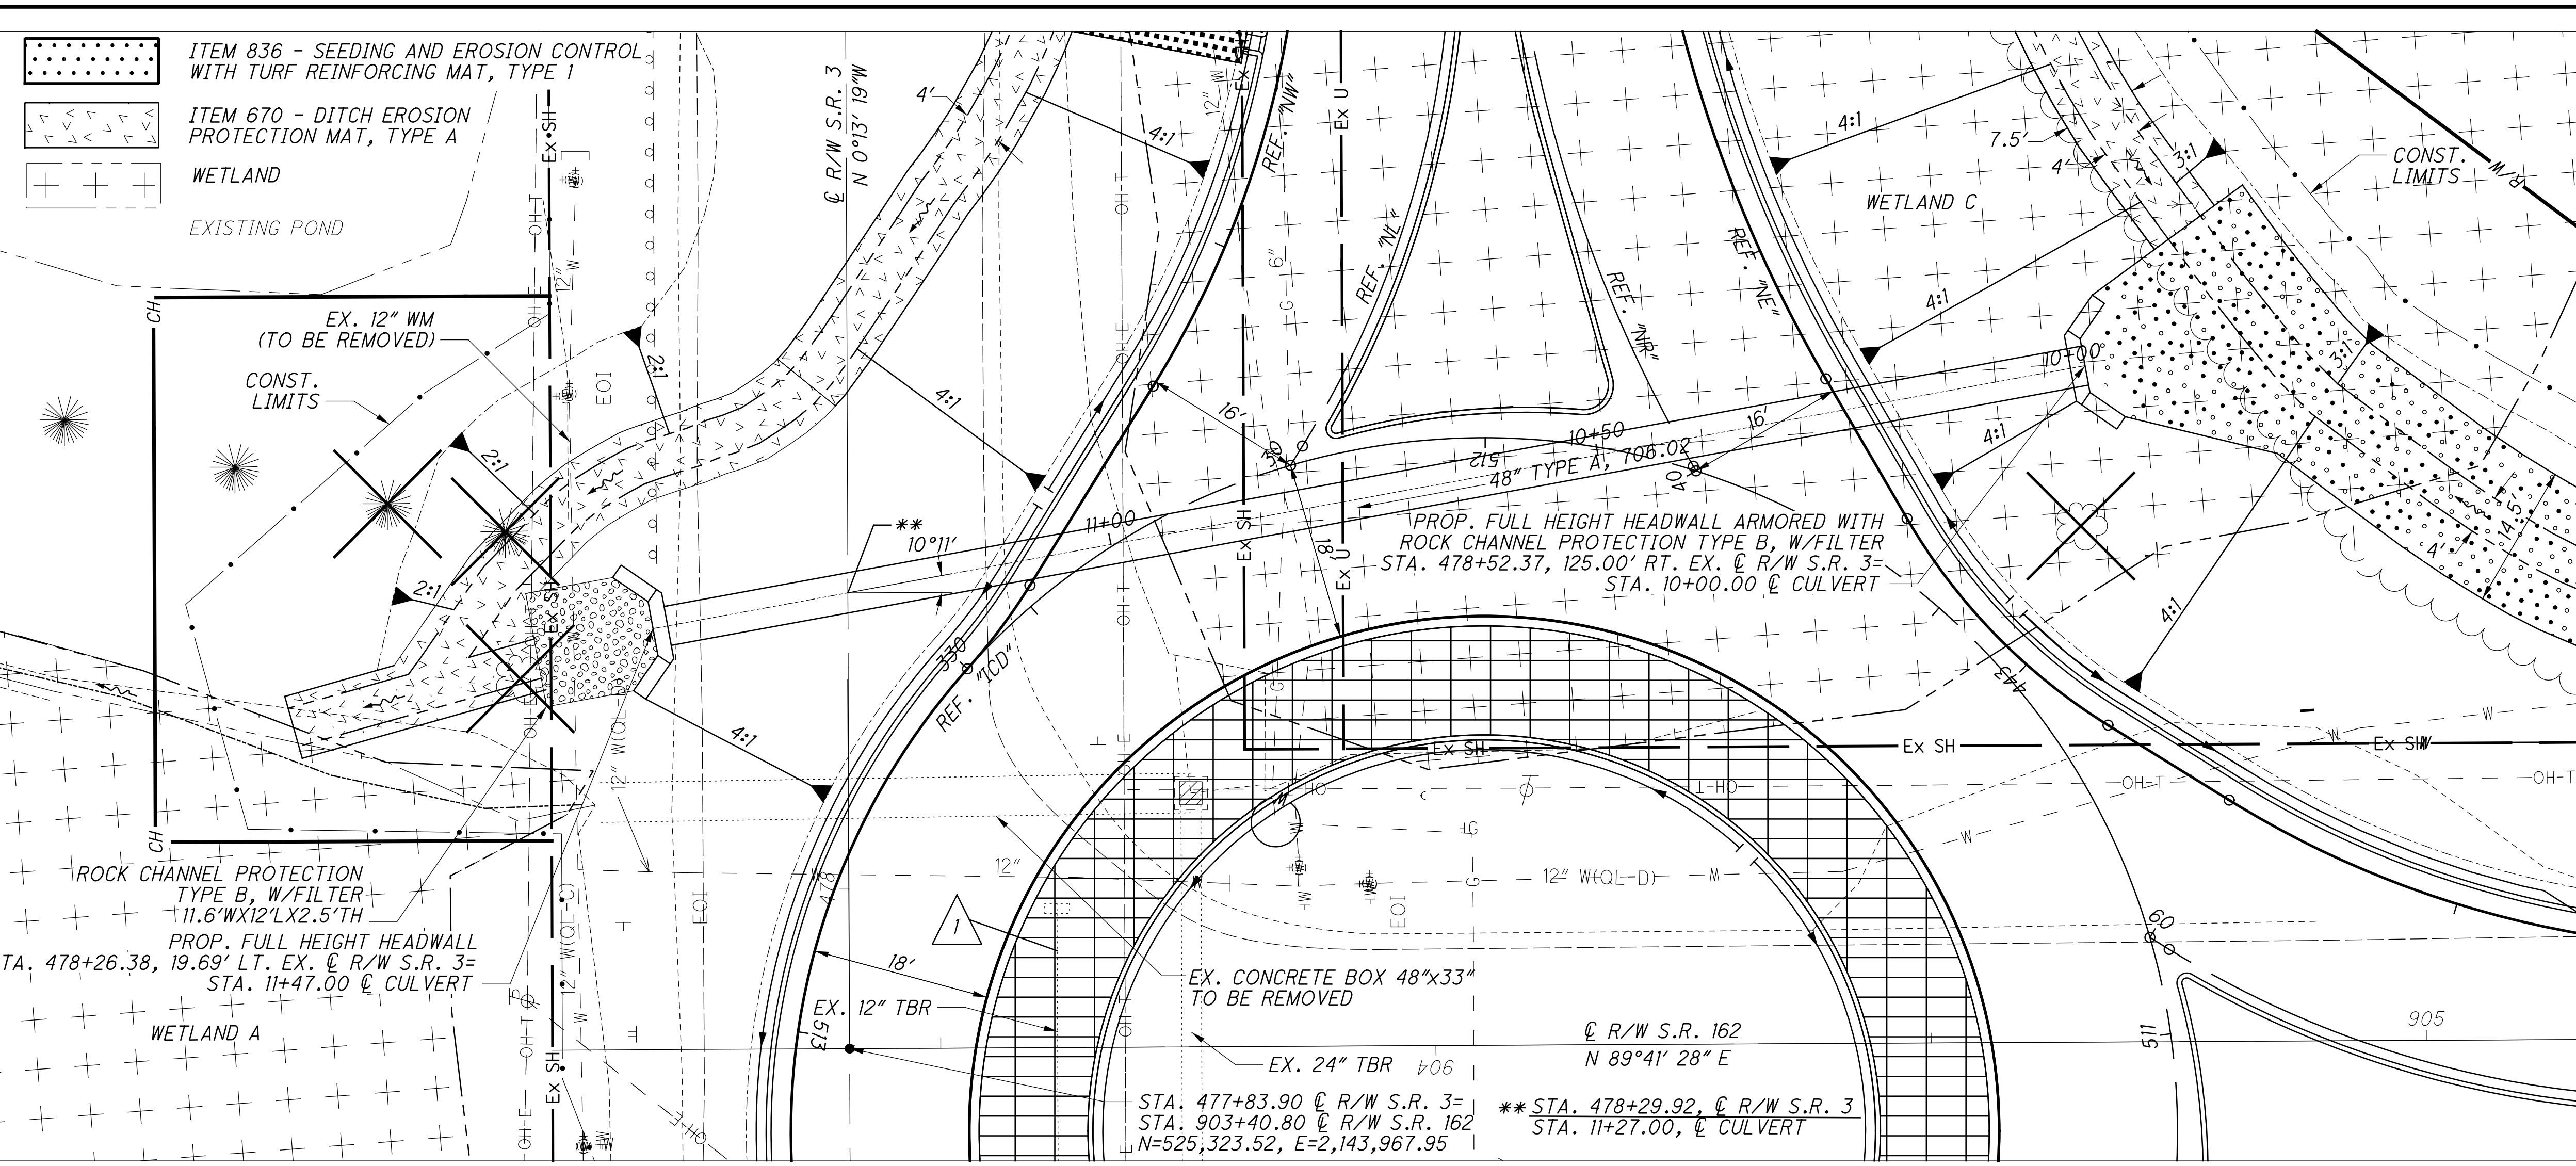

EXISTING STRUCTURE	
TYPE:	CONCRETE BOX
SIZE:	48"x33"
SKEW:	0°37' LEFT FORWARD
LENGTH:	60'
ALIGNMENT:	TANGENT
CFN:	1802120
DATE BUILT:	1941
CONDITION:	FAIR


PROPOSED STRUCTURE	
TYPE:	A
SIZE:	48"
SKEW:	10°11' RIGHT FORWARD
LENGTH:	147'
ALIGNMENT:	TANGENT

HYDRAULIC DESIGN DATA	
DRAINAGE AREA =	89.8 ACRES
Q ₂₅ =	77.5 CFS
Q ₁₀₀ =	95.0 CFS
HW ₂₅ =	1188.5
HW ₁₀₀ =	1189.3
V ₂₅ =	9.20 FPS
V ₁₀₀ =	9.61 FPS
DESIGN SERVICE LIFE:	75 YRS
pH:	7.6
ABRASION LEVEL:	1
CFN:	1978351

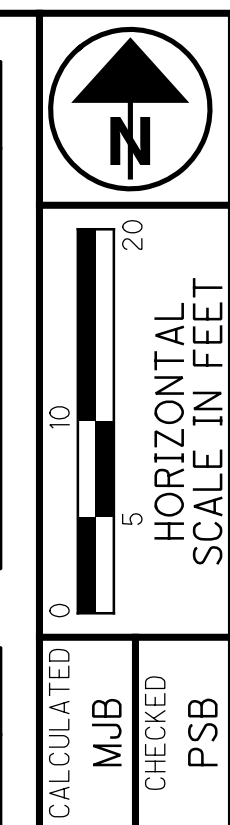

CULVERT DETAIL - S.R. 3
STA. 478 + 29.92

1 ABANDONED HEADWALLS AND PIPE TO BE REMOVED

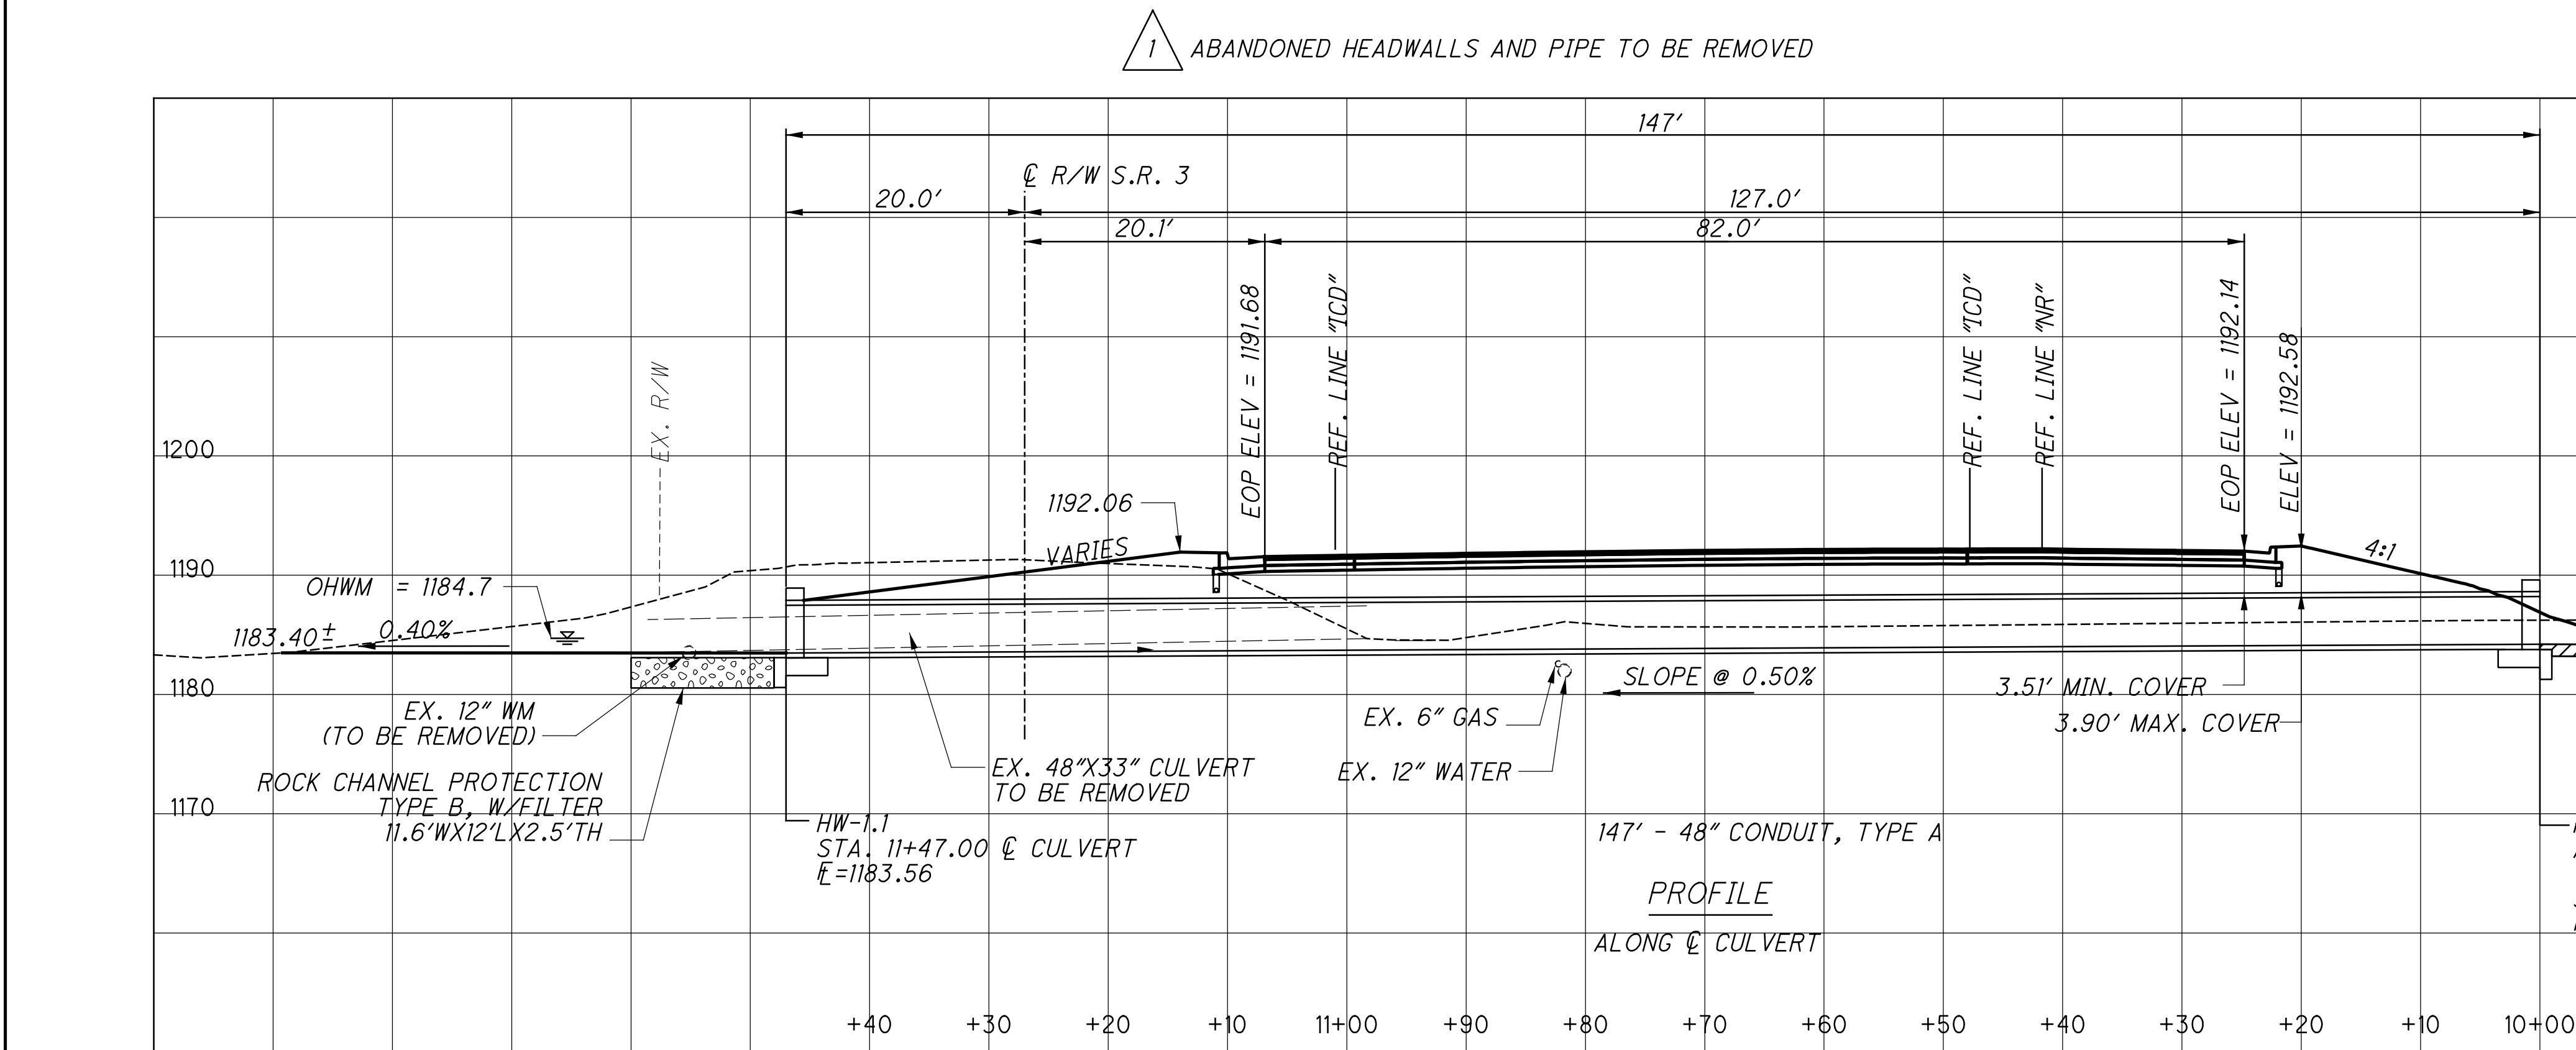

ESTIMATED QUANTITIES CARRIED TO GENERAL SUMMARY			
ITEM	QUANTITY	UNIT	DESCRIPTION
611	147	FT	48" CONDUIT, TYPE A, 706.02 OR 707.33, 60" 707.04 (0.109) GALVANIZED
202	60	FT	PIPE REMOVED, OVER 24"
601	18	CY	ROCK CHANNEL PROTECTION, TYPE B W/FILTER
602	17.2	CY	CONCRETE MASONRY

MED - 3 - 09 . 04
56
80