



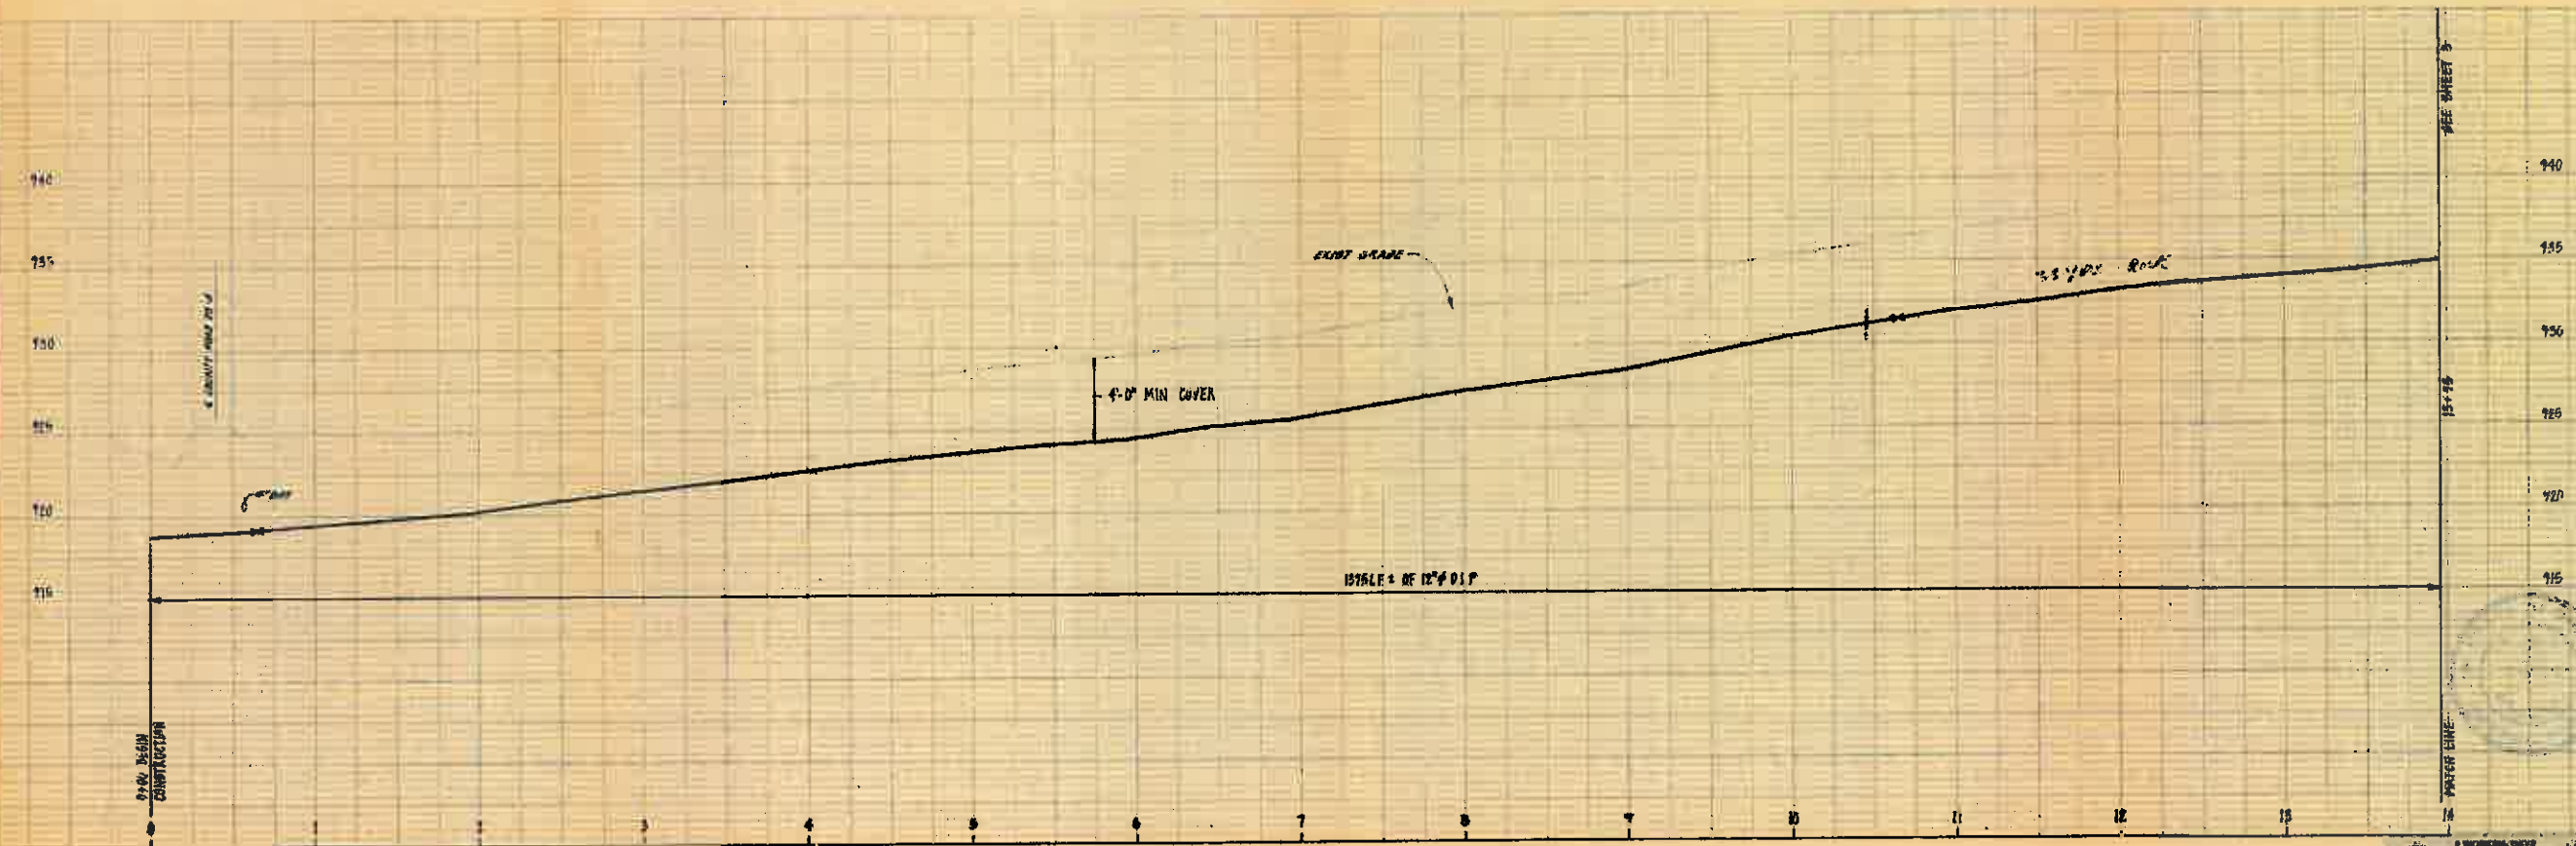

COPY

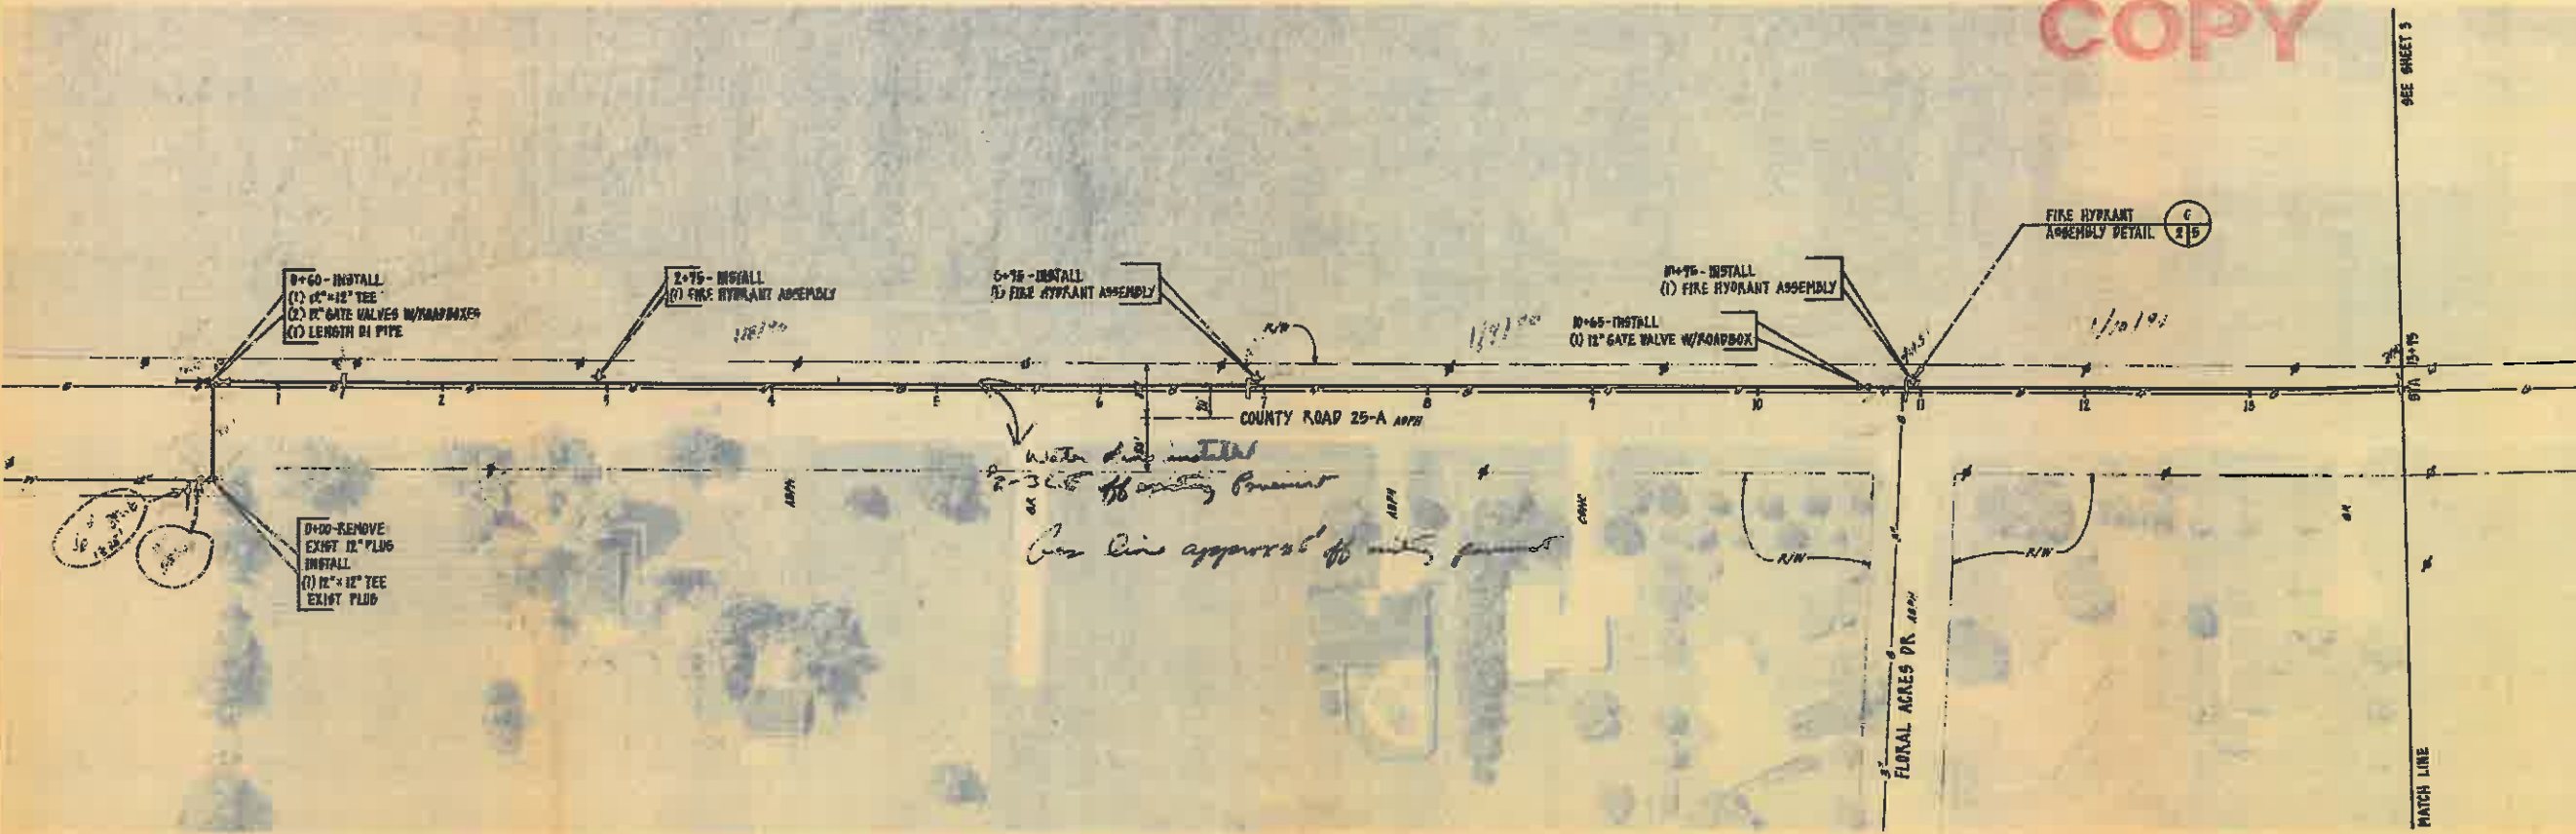

Revisions	

Designed by: V.D.	Checked by: P.K.H.	Date: 10-07	Approved by: P.K.H.	Date: 10-07
Drawn by: S.H.L.				



PLAN & PROFILE

COUNTY ROAD 25-A WATER LINE EXTENSION



Scale
1" = 50' HORIZ.
1" = 5' VERT.

Sheet
2 of 5

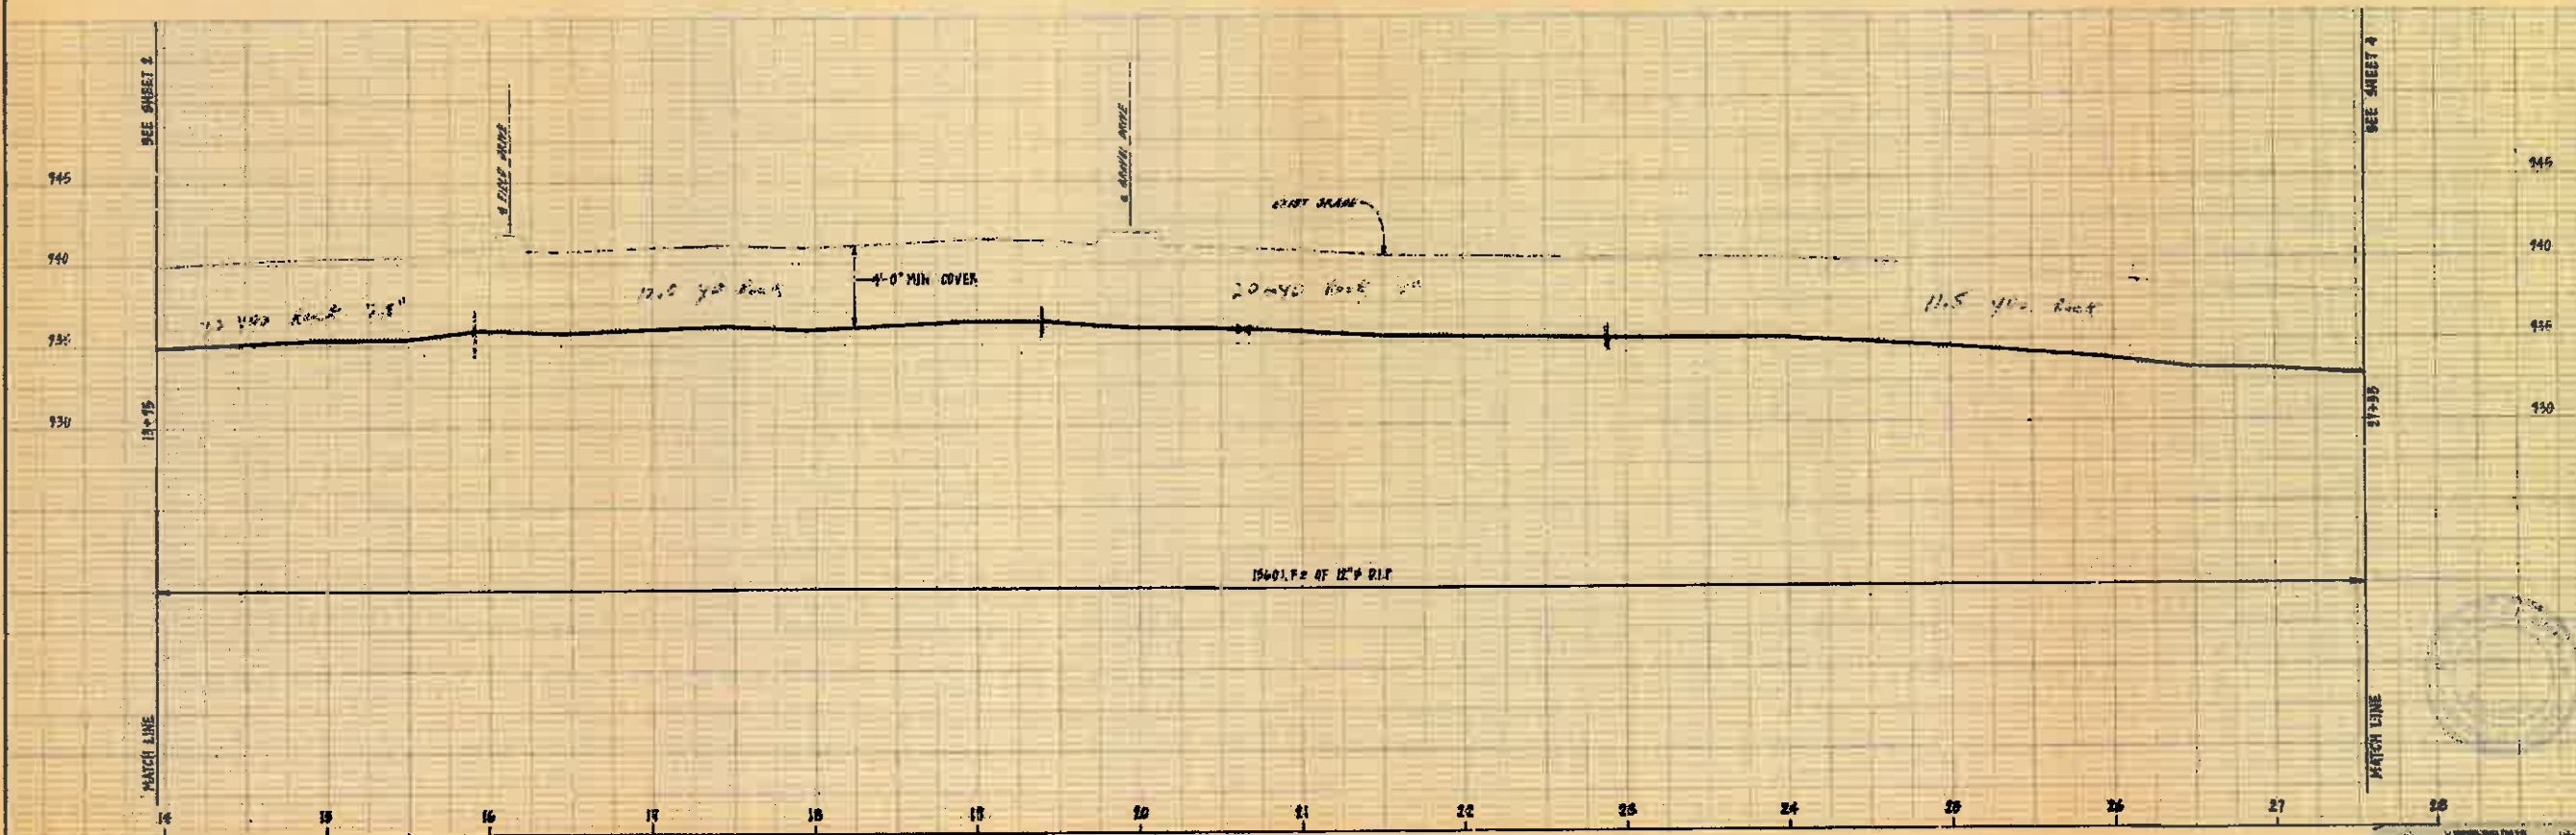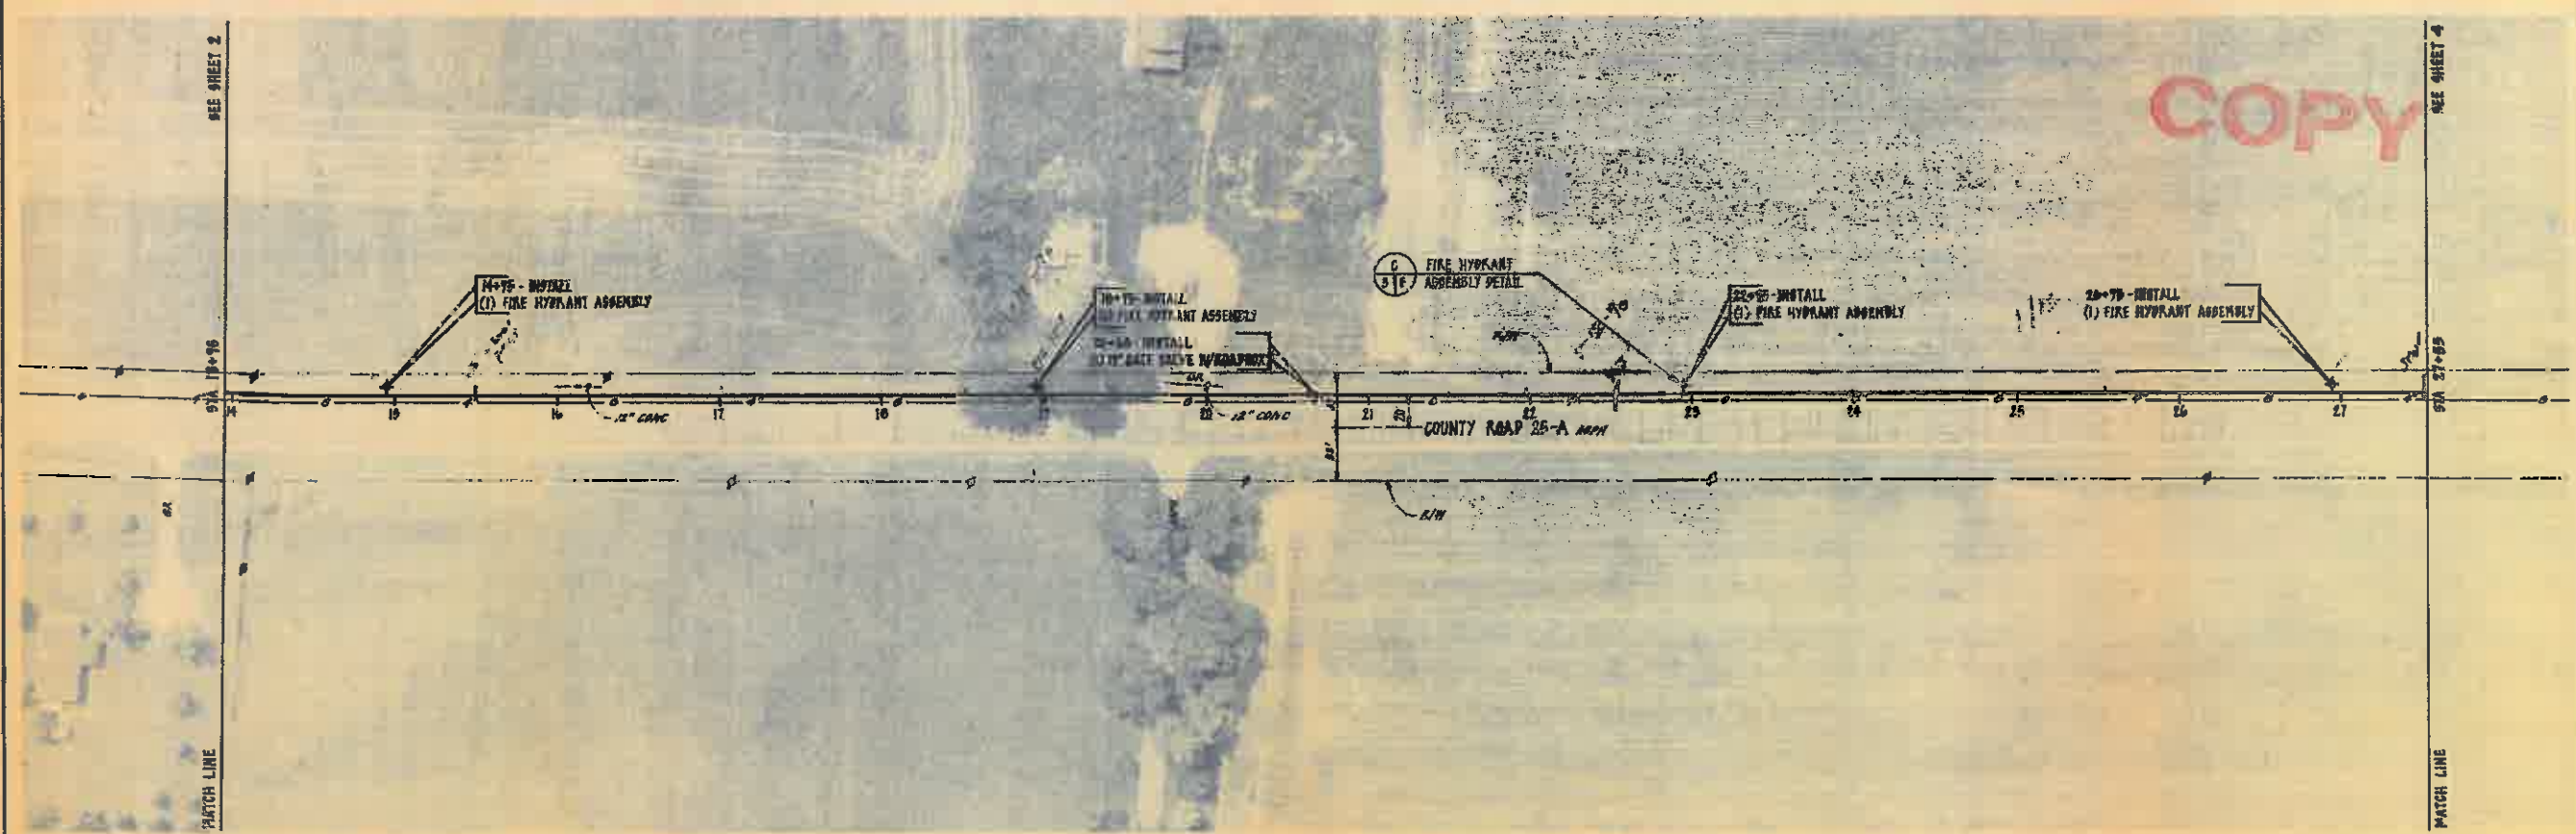

COPY

Revisions	

Designed by: V.L.D.	Date: 10-87	Checked by: K.K.H.	Date: 11-87
Drawn by: J. Abney	Date: 11-87	Approved by: K.K.H.	Date: 10-87

PLAN & PROFILE

COUNTY ROAD 25-A WATER LINE EXTENSION

CITY OF TIPP CITY, OHIO





Scale
1" = 50' HORIZ.
1" = 5' VERT.

Sheet
3 of 5



Revisions	

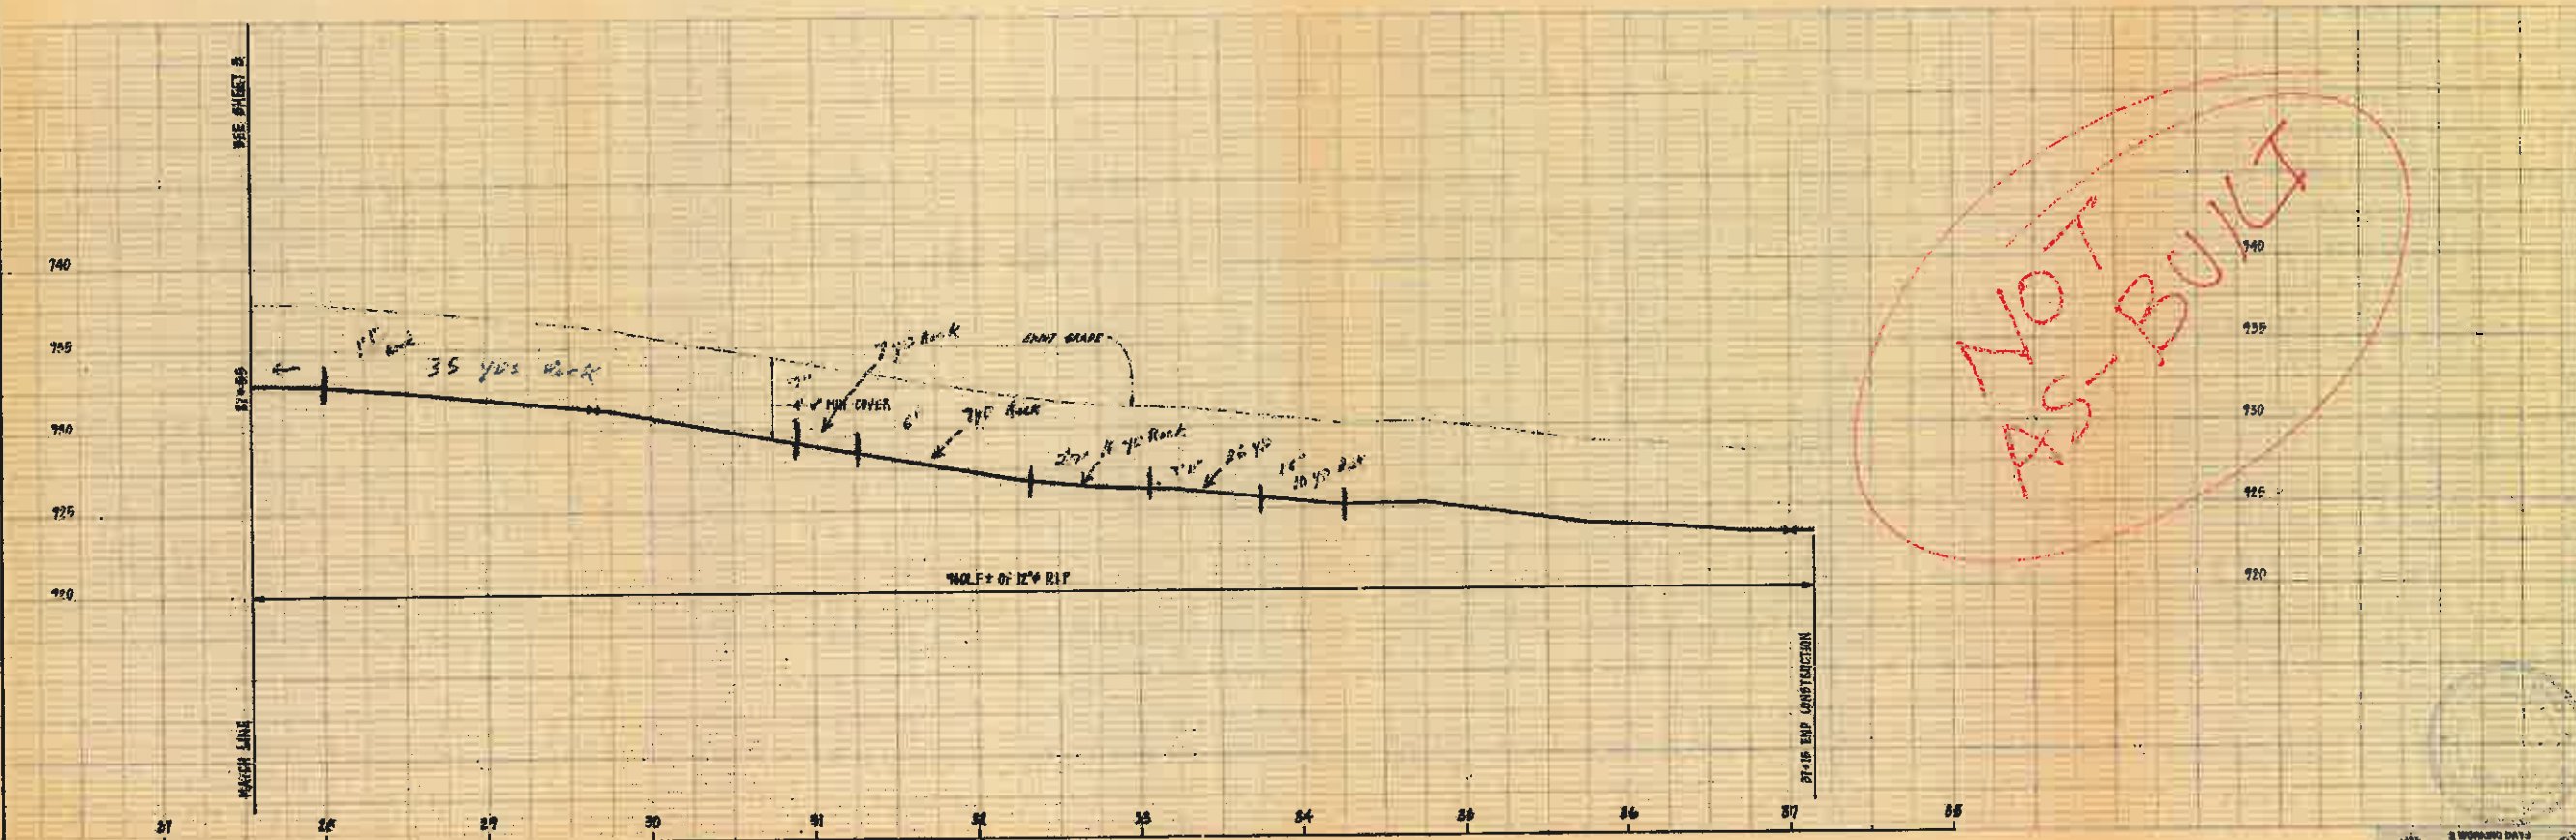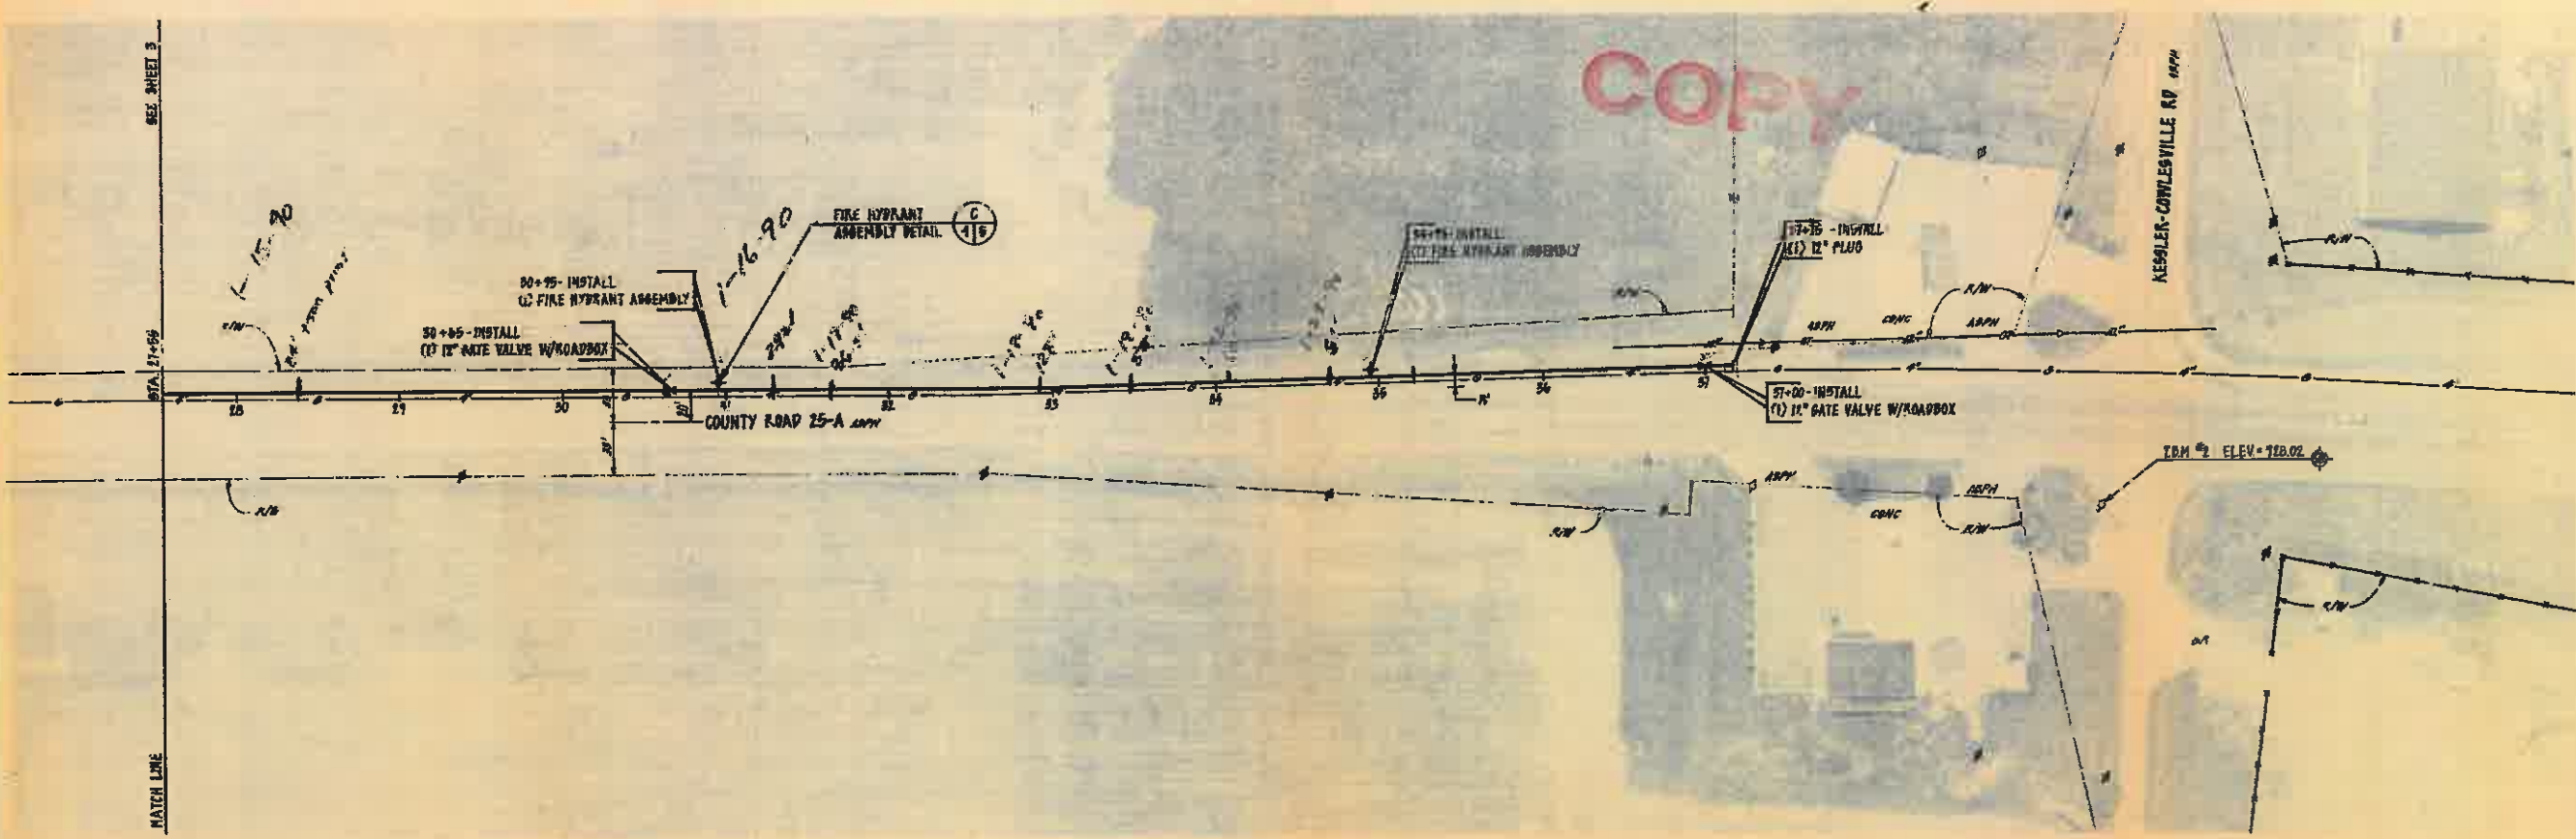

Designed by:	Date:	Checked by:	Date:
Drawn by:	Date:	Approved by:	Date:

PLAN & PROFILE

COUNTY ROAD 25-A WATER LINE EXTENSION

CITY OF TIPP CITY, OHIO



Scale
1" = 50' HORIZ.
1" = 5' VERT.

Sheet
4 of 5