


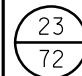



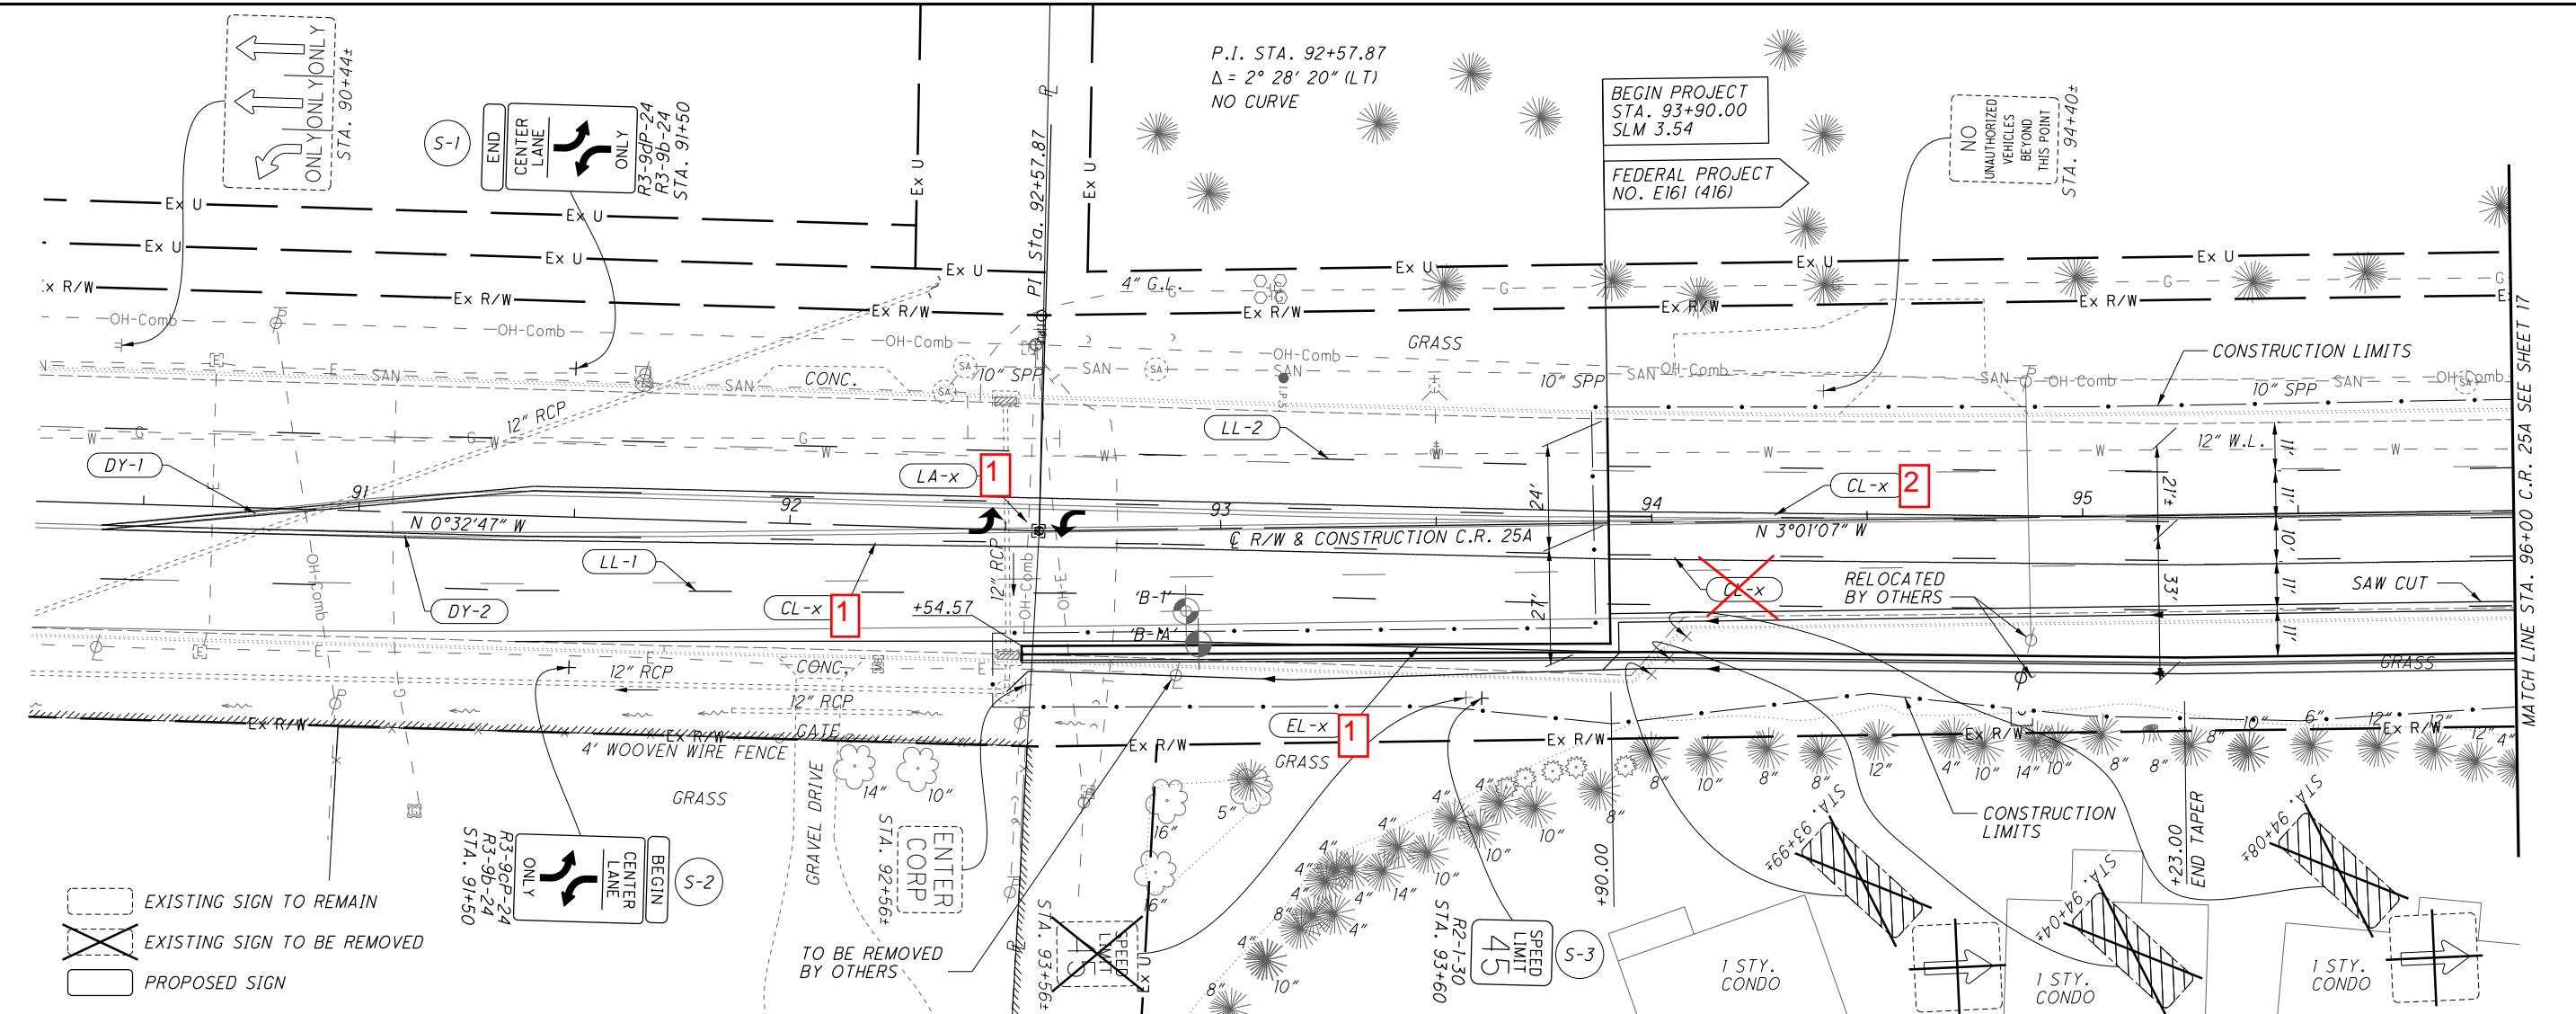


P:\ACTC\TR\0001_MIA-CR25A\103159_Sheets\Design\roadway\Sheets\103159_GP001.dgn Sheet 2/12/2020 2:07:26 PM bpendery

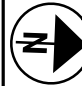





 CALCULATED BAA CHECKED TWG
PLAN AND PROFILE - C.R. 25A
STA. 90+25 TO STA. 96+00
MIA - C.R. 25A - 3.54

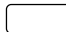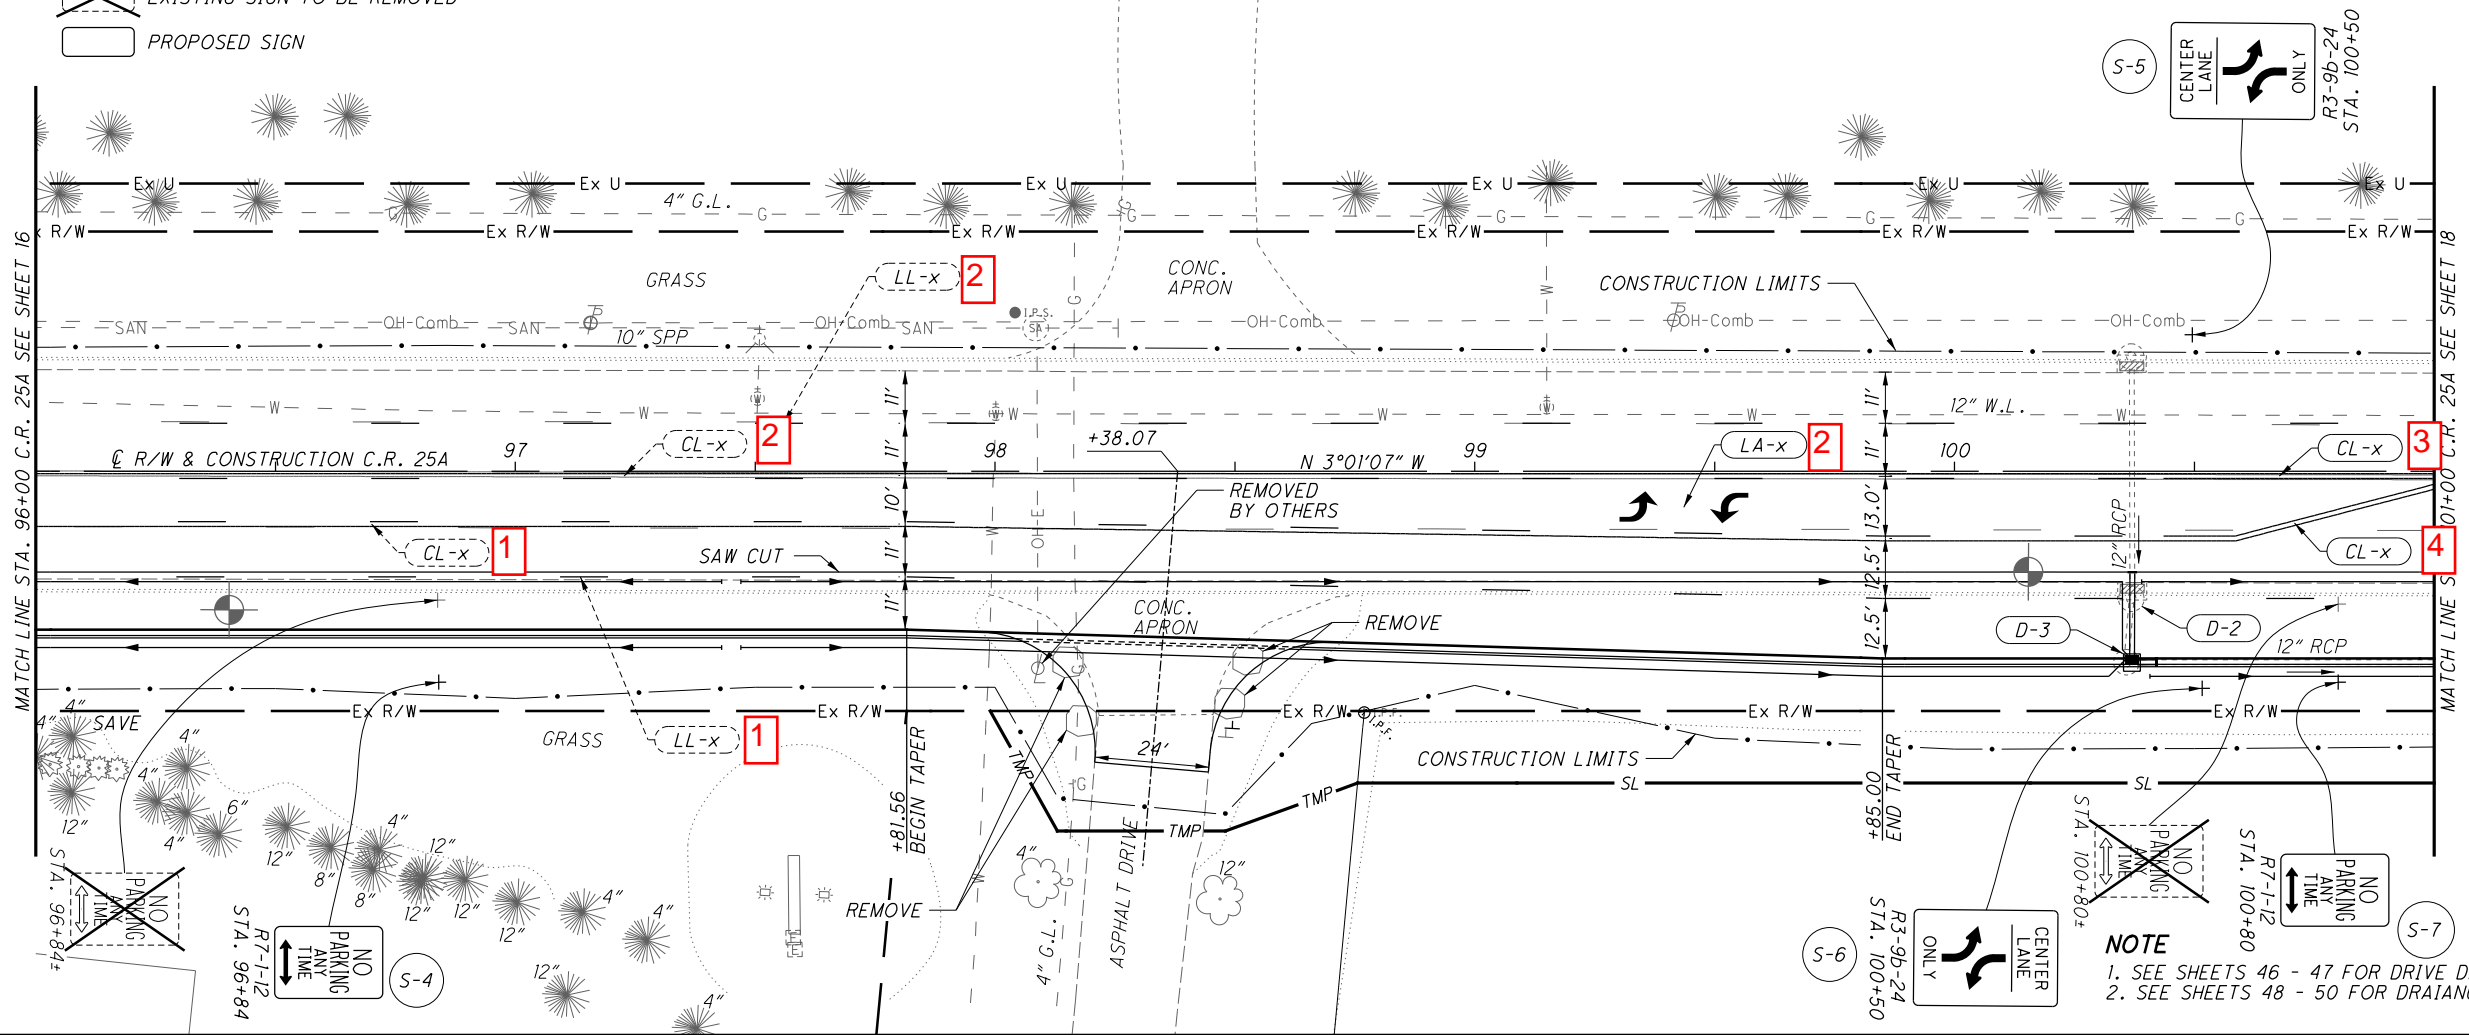

 EXISTING SIGN TO REMAIN
 EXISTING SIGN TO BE REMOVED
 PROPOSED SIGN

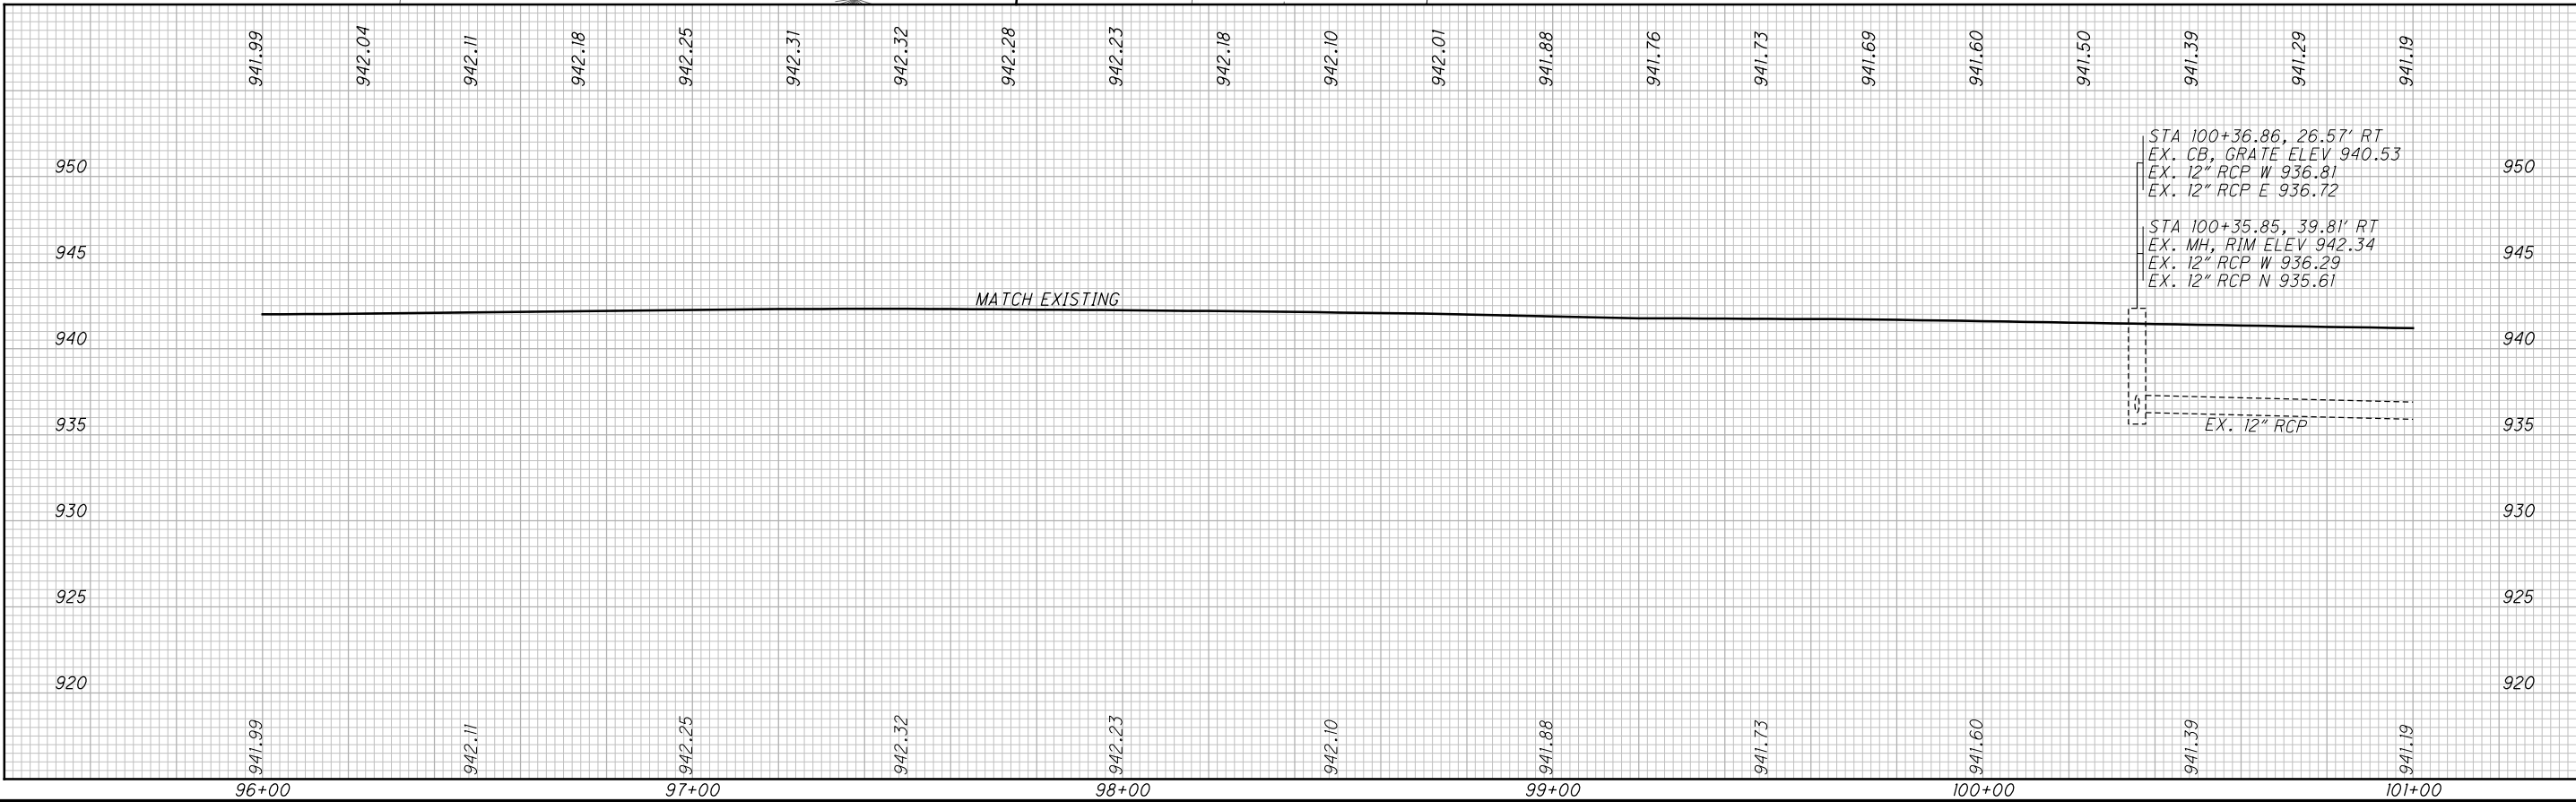

NOTE
 1. SEE SHEETS 46 - 47 FOR DRIVE DETAILS.
 2. SEE SHEETS 48 - 50 FOR DRAINAGE INFORMATION.







10 HORIZONTAL SCALE IN FEET

CALCULATED	BAA	CHECKED	TWG
------------	-----	---------	-----


PLAN AND PROFILE - C.R. 25A

STA. 96+00 TO STA. 101+00


MIA - C.R. 25A - 3.54

24 / 72

P:\ACTC\TR\0001_MIA-CR25A\103159_GP003.dgn Sheet 2/12/2020 2:07:27 PM bpendery

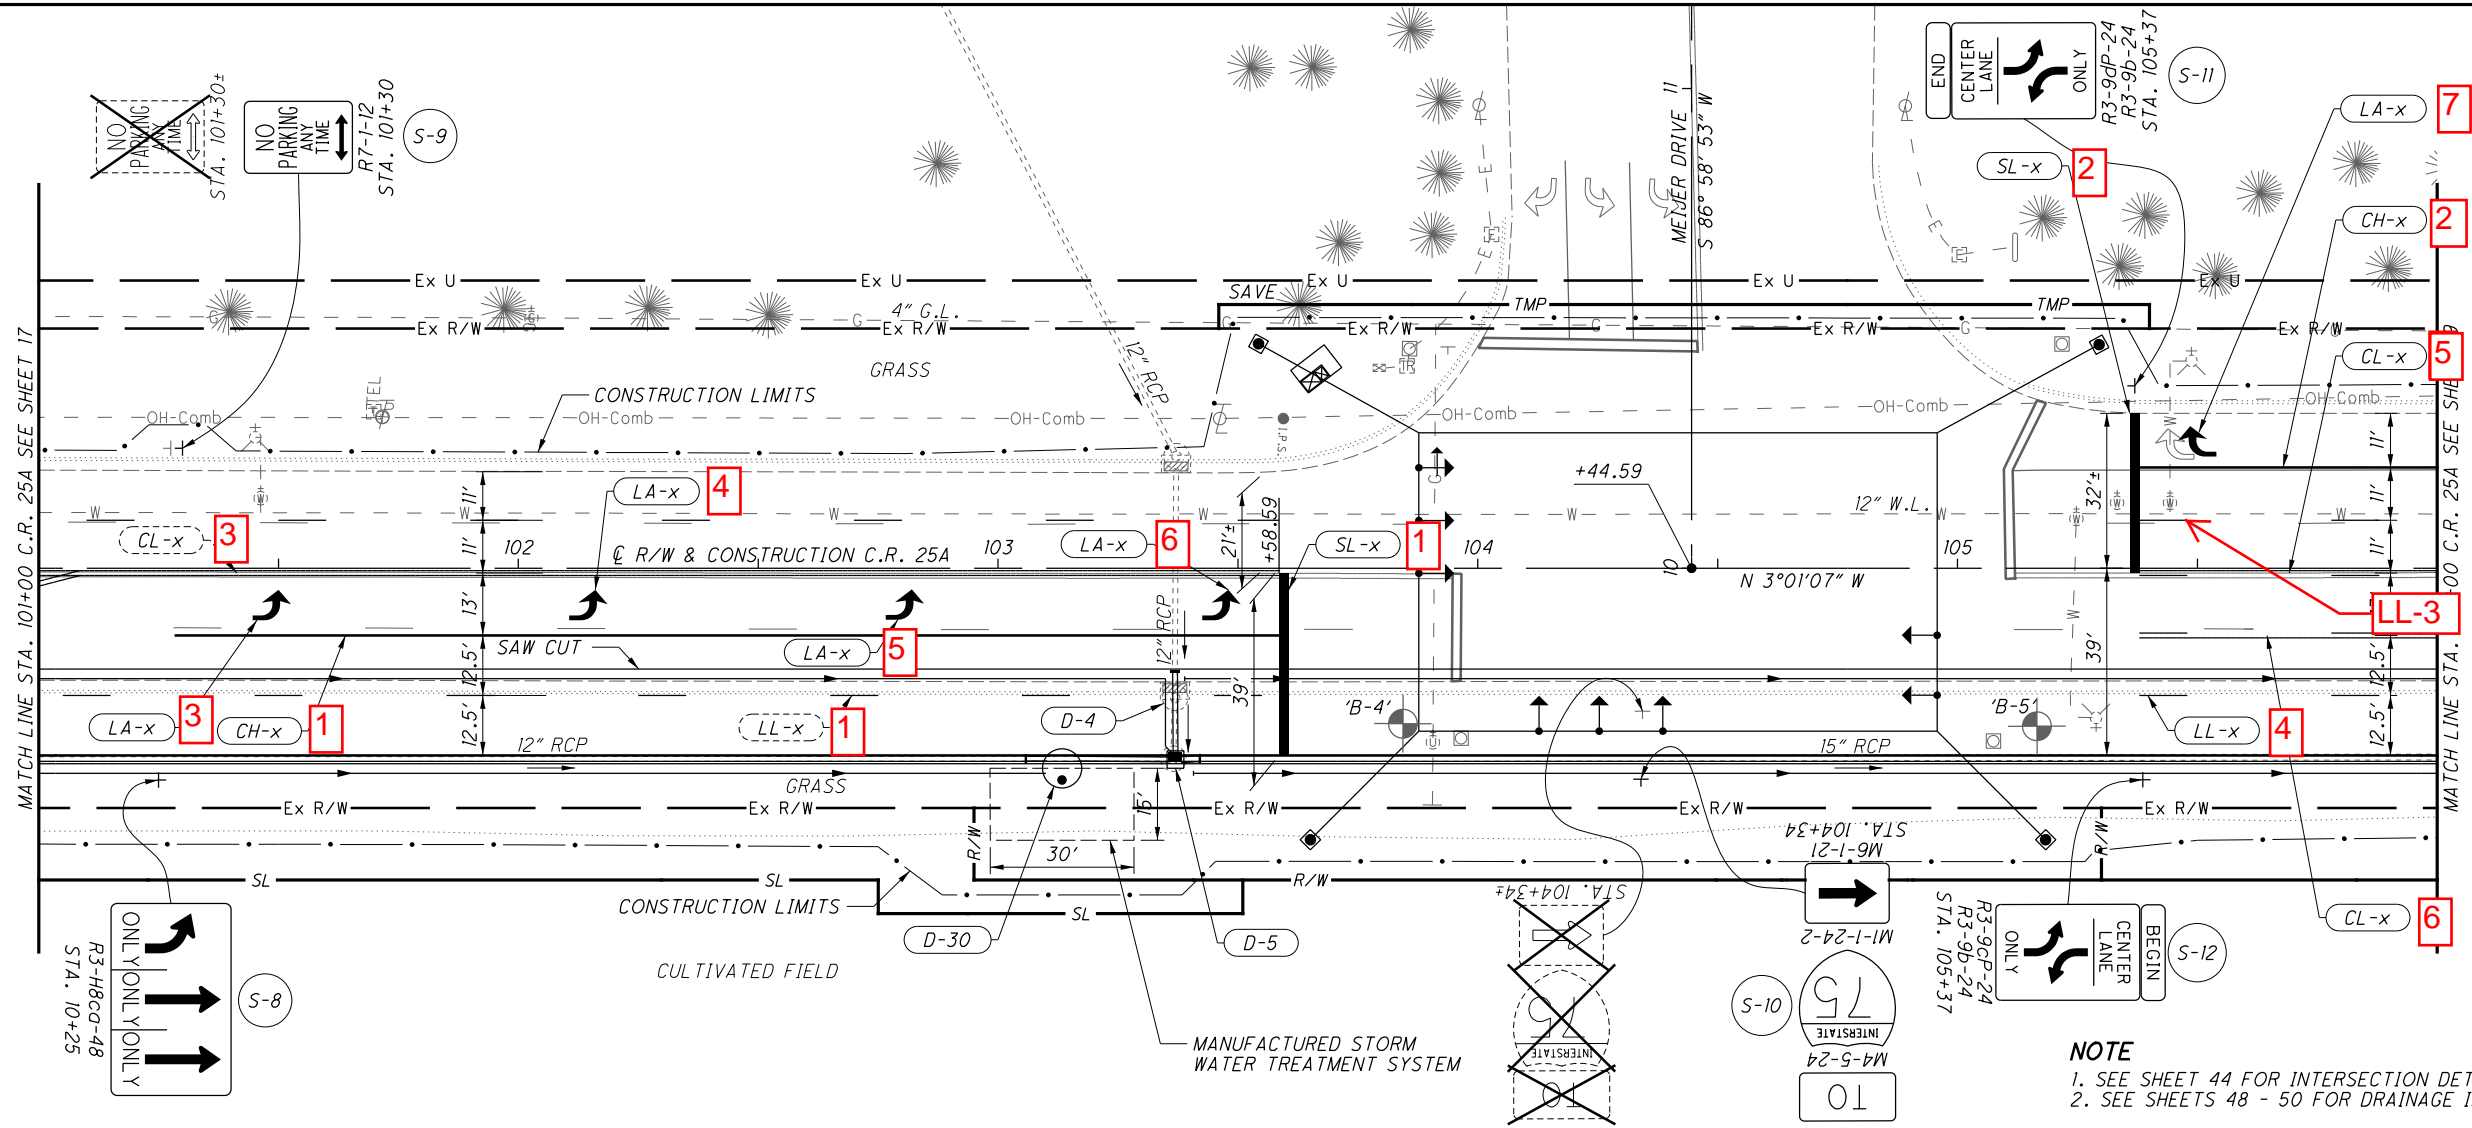


NOTE
 1. SEE SHEET 44 FOR INTERSECTION DETAIL.
 2. SEE SHEETS 48 - 50 FOR DRAINAGE INFORMATION.

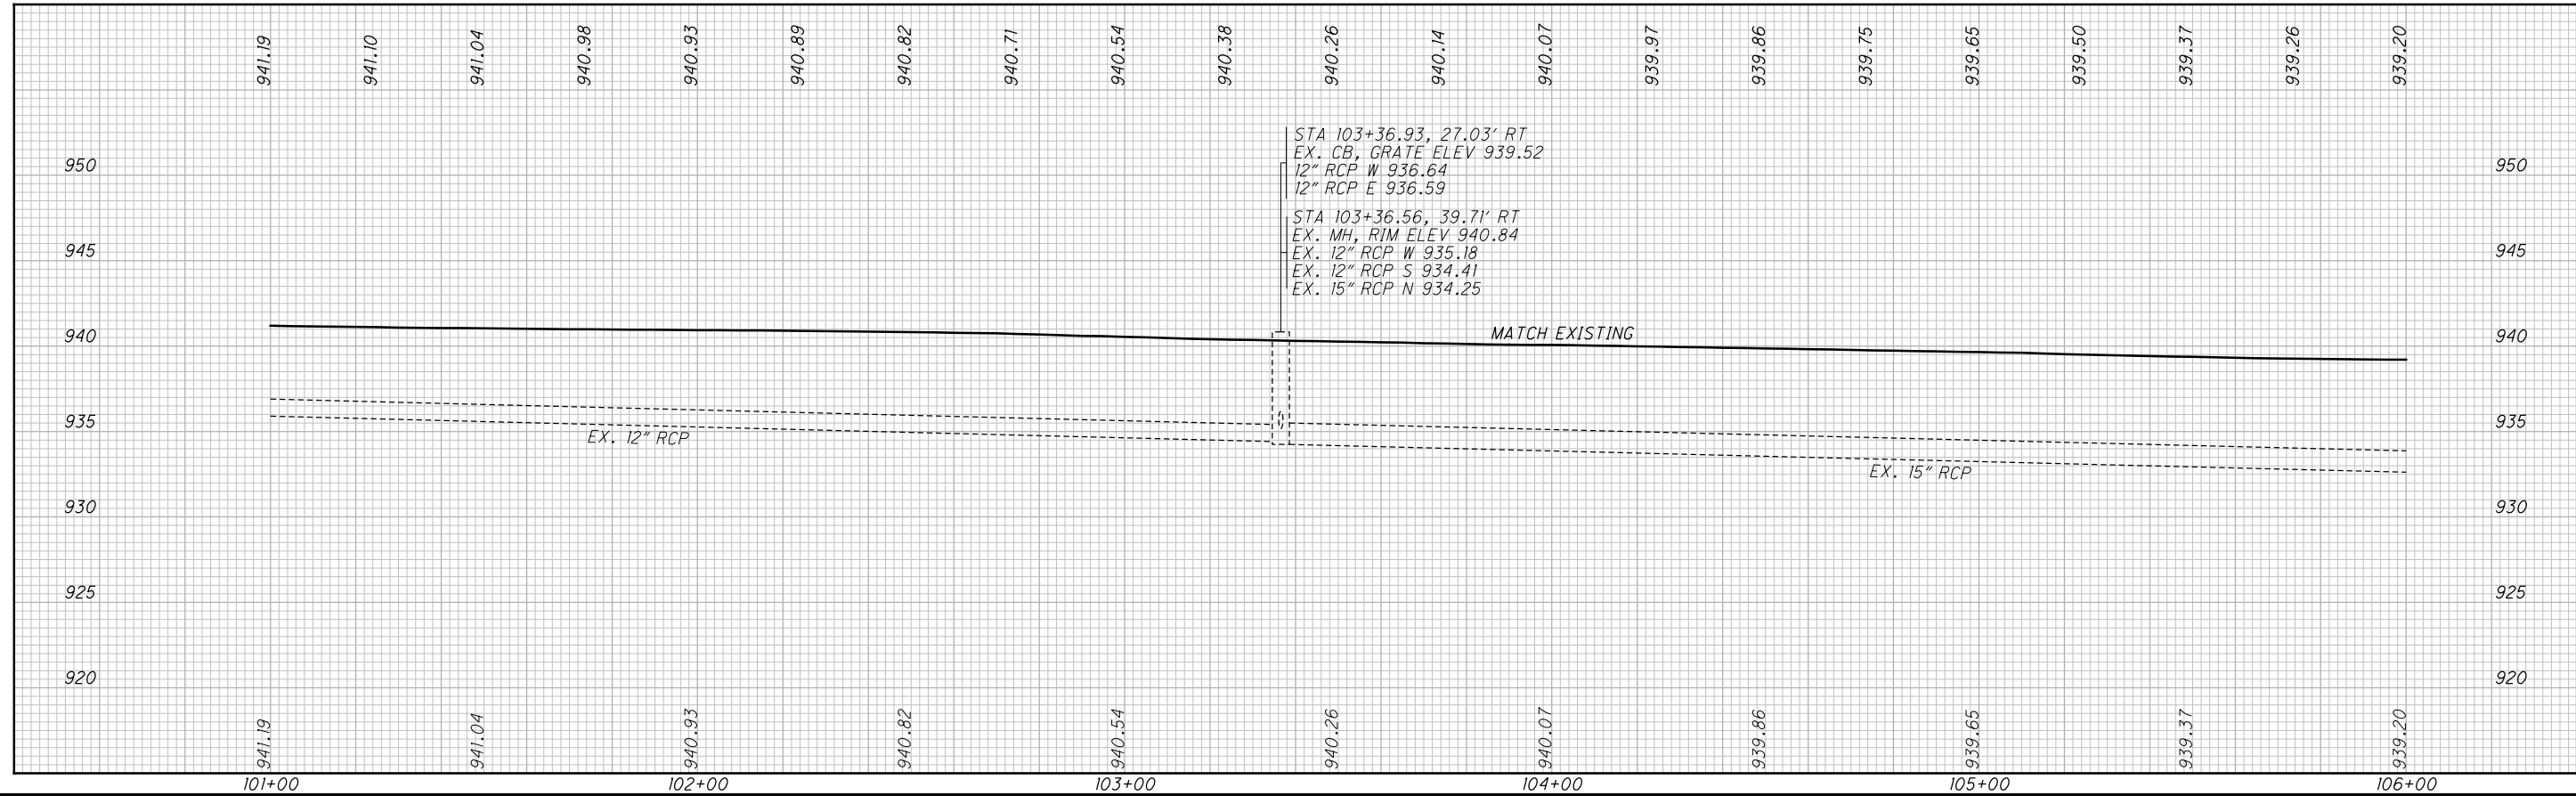

STA 103+36.93, 27.03' RT
 EX. CB, GRATE ELEV 939.52
 12" RCP W 936.64
 12" RCP E 936.59

STA 103+36.56, 39.71' RT
 EX. MH, RIM ELEV 940.84
 EX. 12" RCP W 935.18
 EX. 12" RCP S 934.41
 EX. 15" RCP N 934.25






HORIZONTAL SCALE IN FEET

CALCULATED
BAA
CHECKED
TWG


PLAN AND PROFILE - C.R. 25A
STA. 101+00 TO STA. 106+00

MIA - C.R. 25A - 3.54

25
72

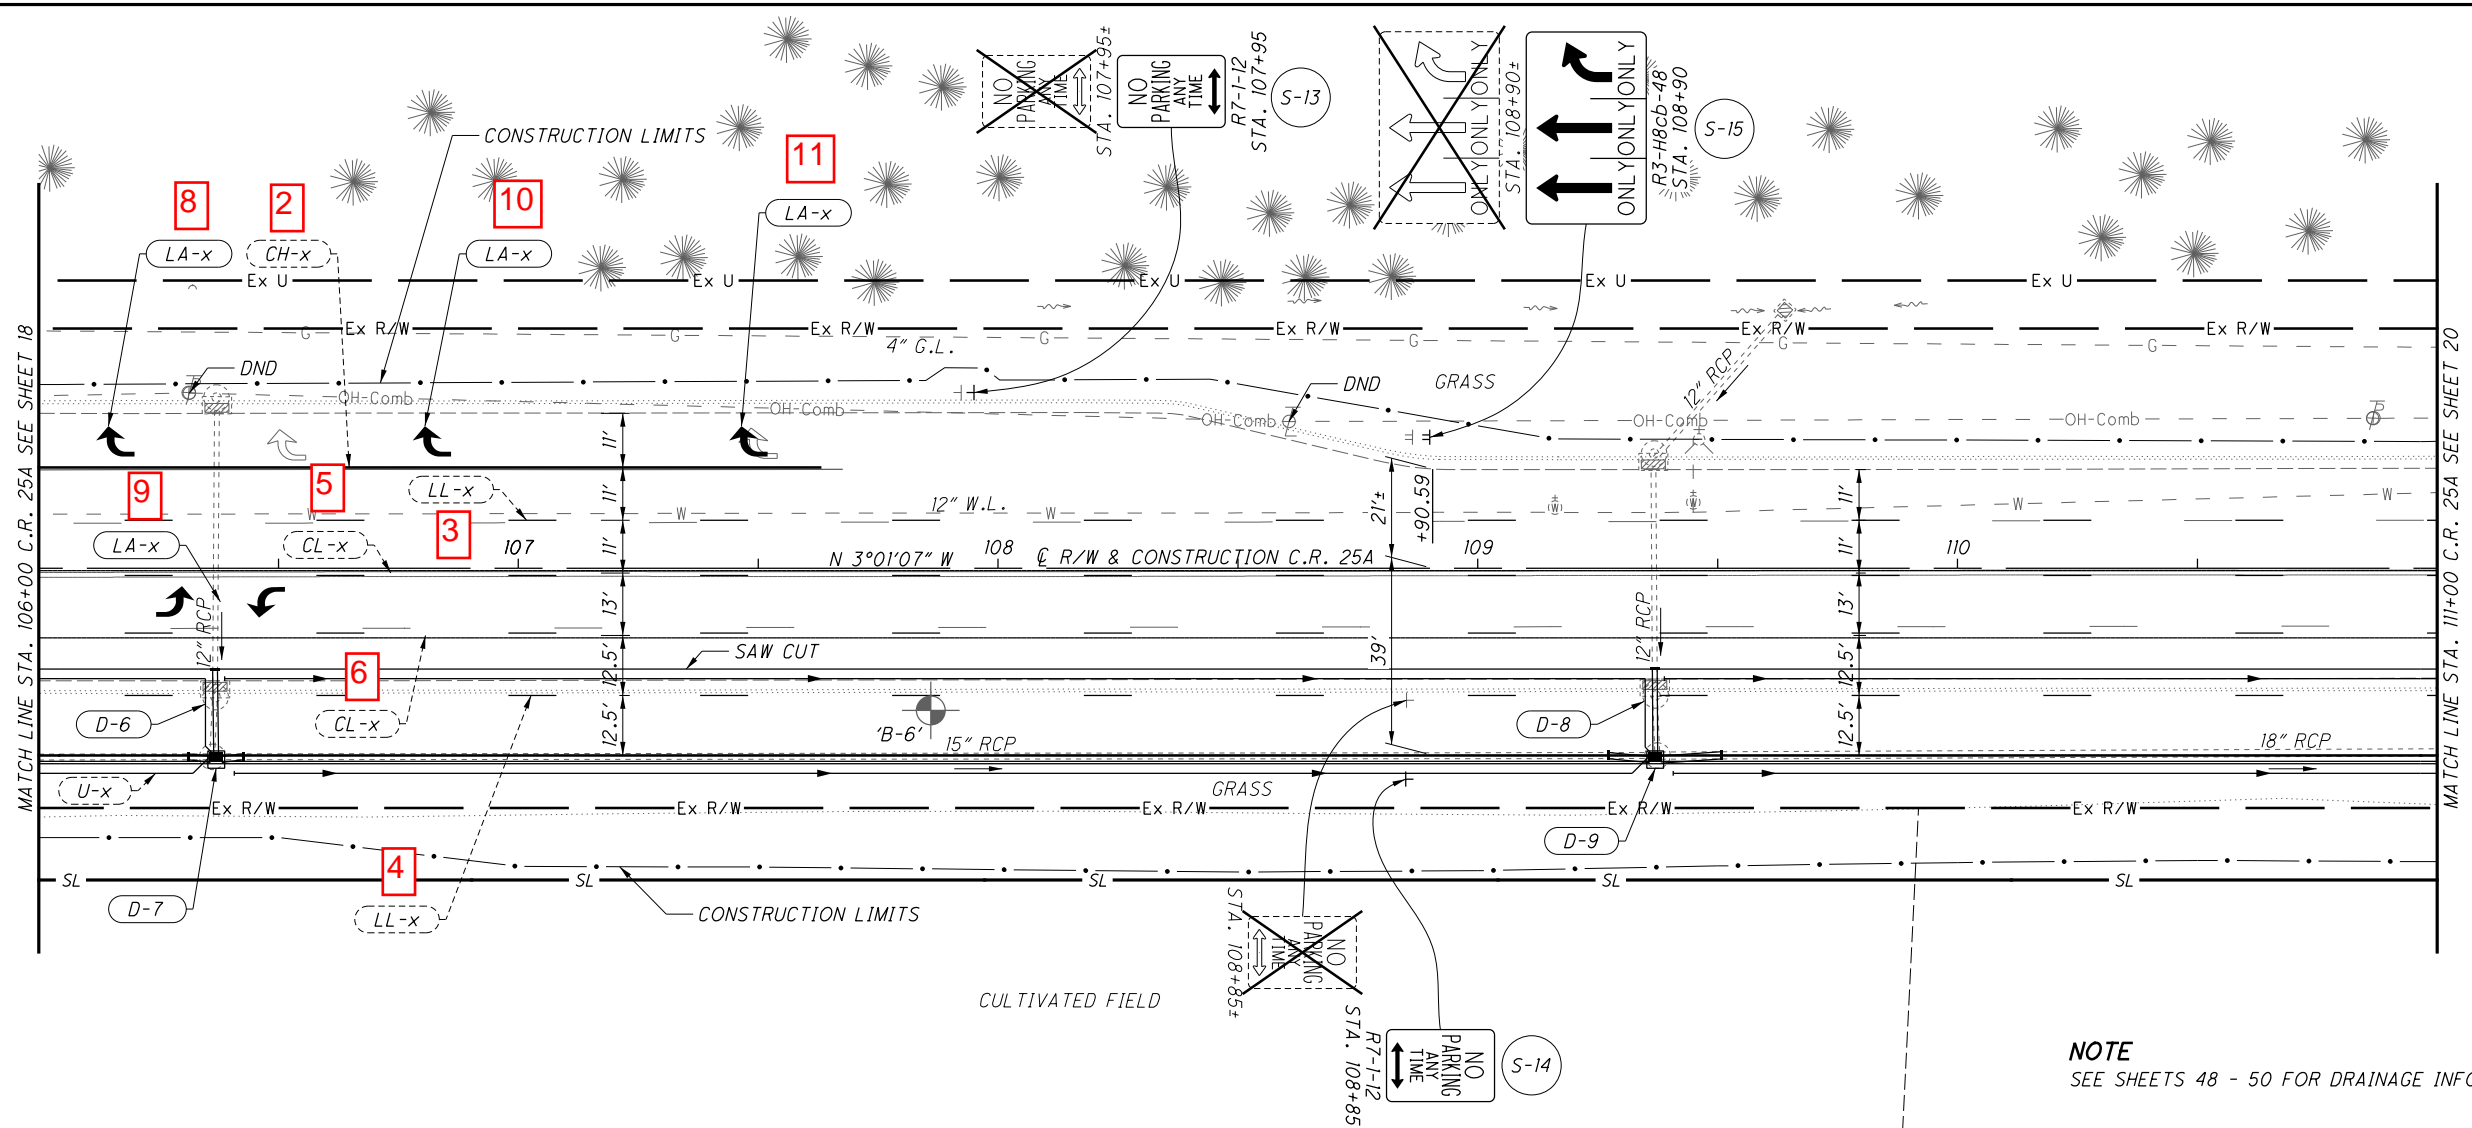


NOTE
SEE SHEETS 48 - 50 FOR DRAINAGE INFORMATION.

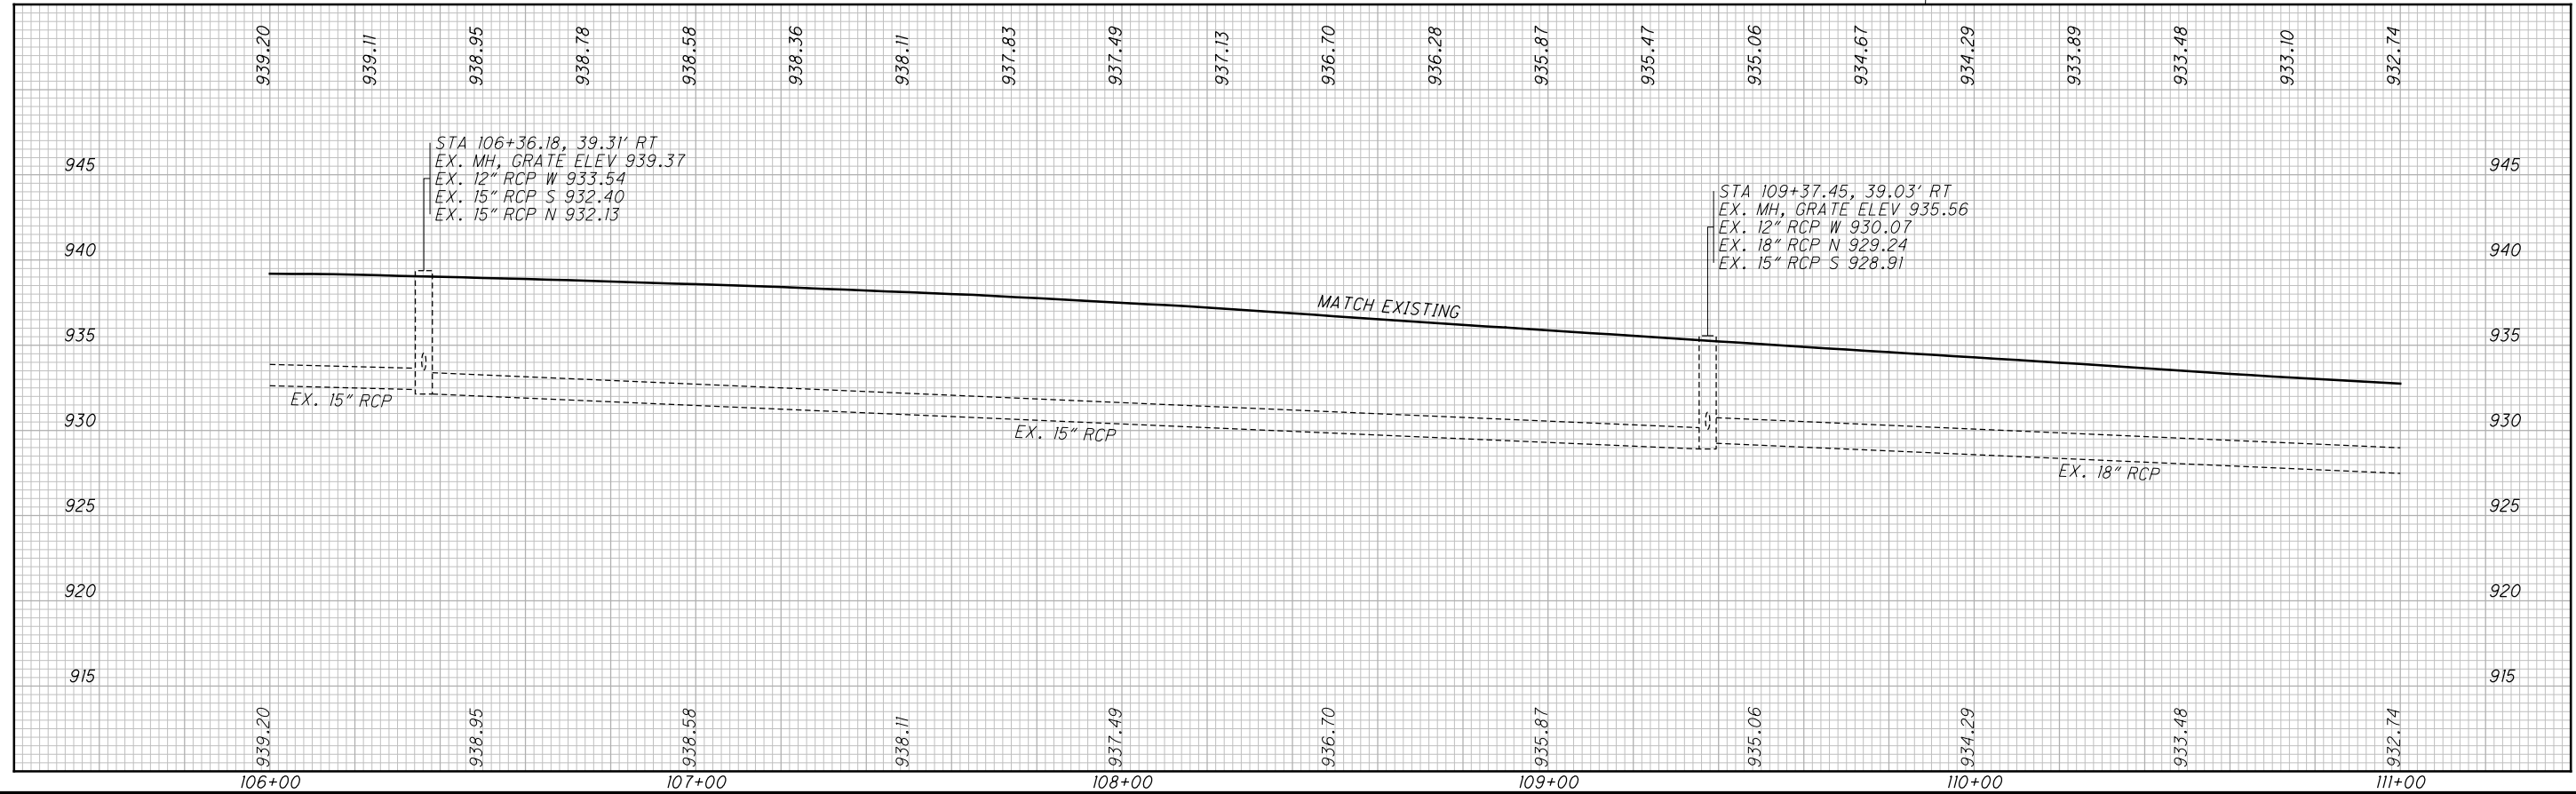

CALCULATED
BAA
CHECKED
TWG

**PLAN AND PROFILE - C.R. 25A
STA. 106+00 TO STA. 111+00**

MIA - C.R. 25A - 3.54

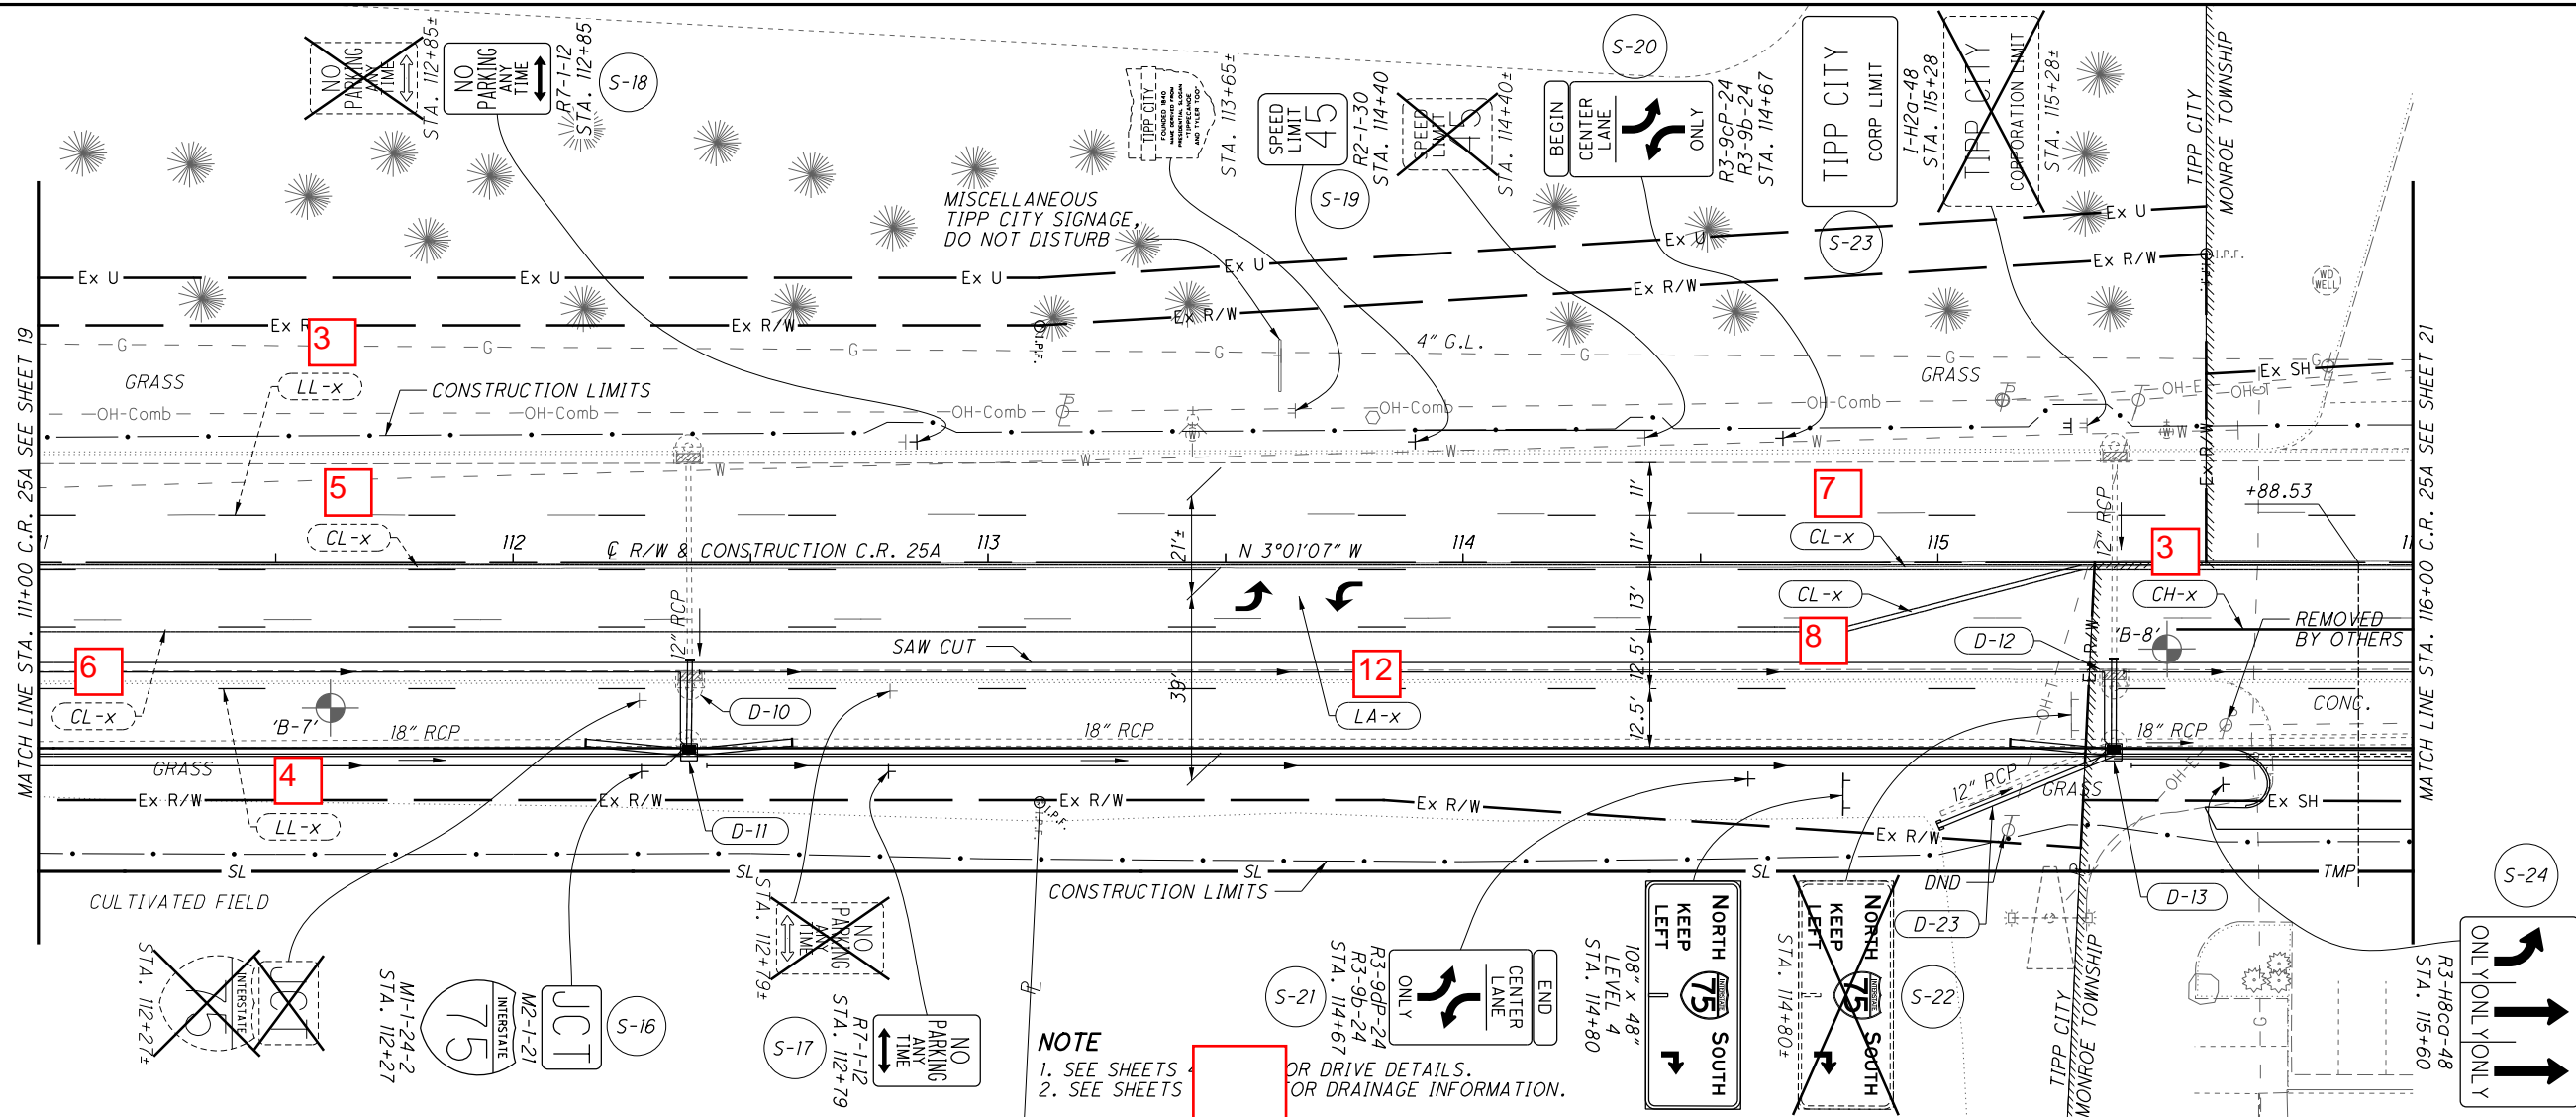

NOTE
 1. SEE SHEETS [] OR DRIVE DETAILS.
 2. SEE SHEETS [] OR DRAINAGE INFORMATION.



PLAN AND PROFILE - C.R. 25A
STA. 111+00 TO STA. 116+00


MIA - C.R. 25A - 3.54

27
72

CALCULATED BAA CHECKED TWG

0 20 40
 10 HORIZONTAL SCALE IN FEET



P:\CTC\TR\001_MIA-CR25A\103159\Design\roadway\Sheets\103159_GP007.dgn Sheet 2/12/2020 2:07:28 PM bpendery

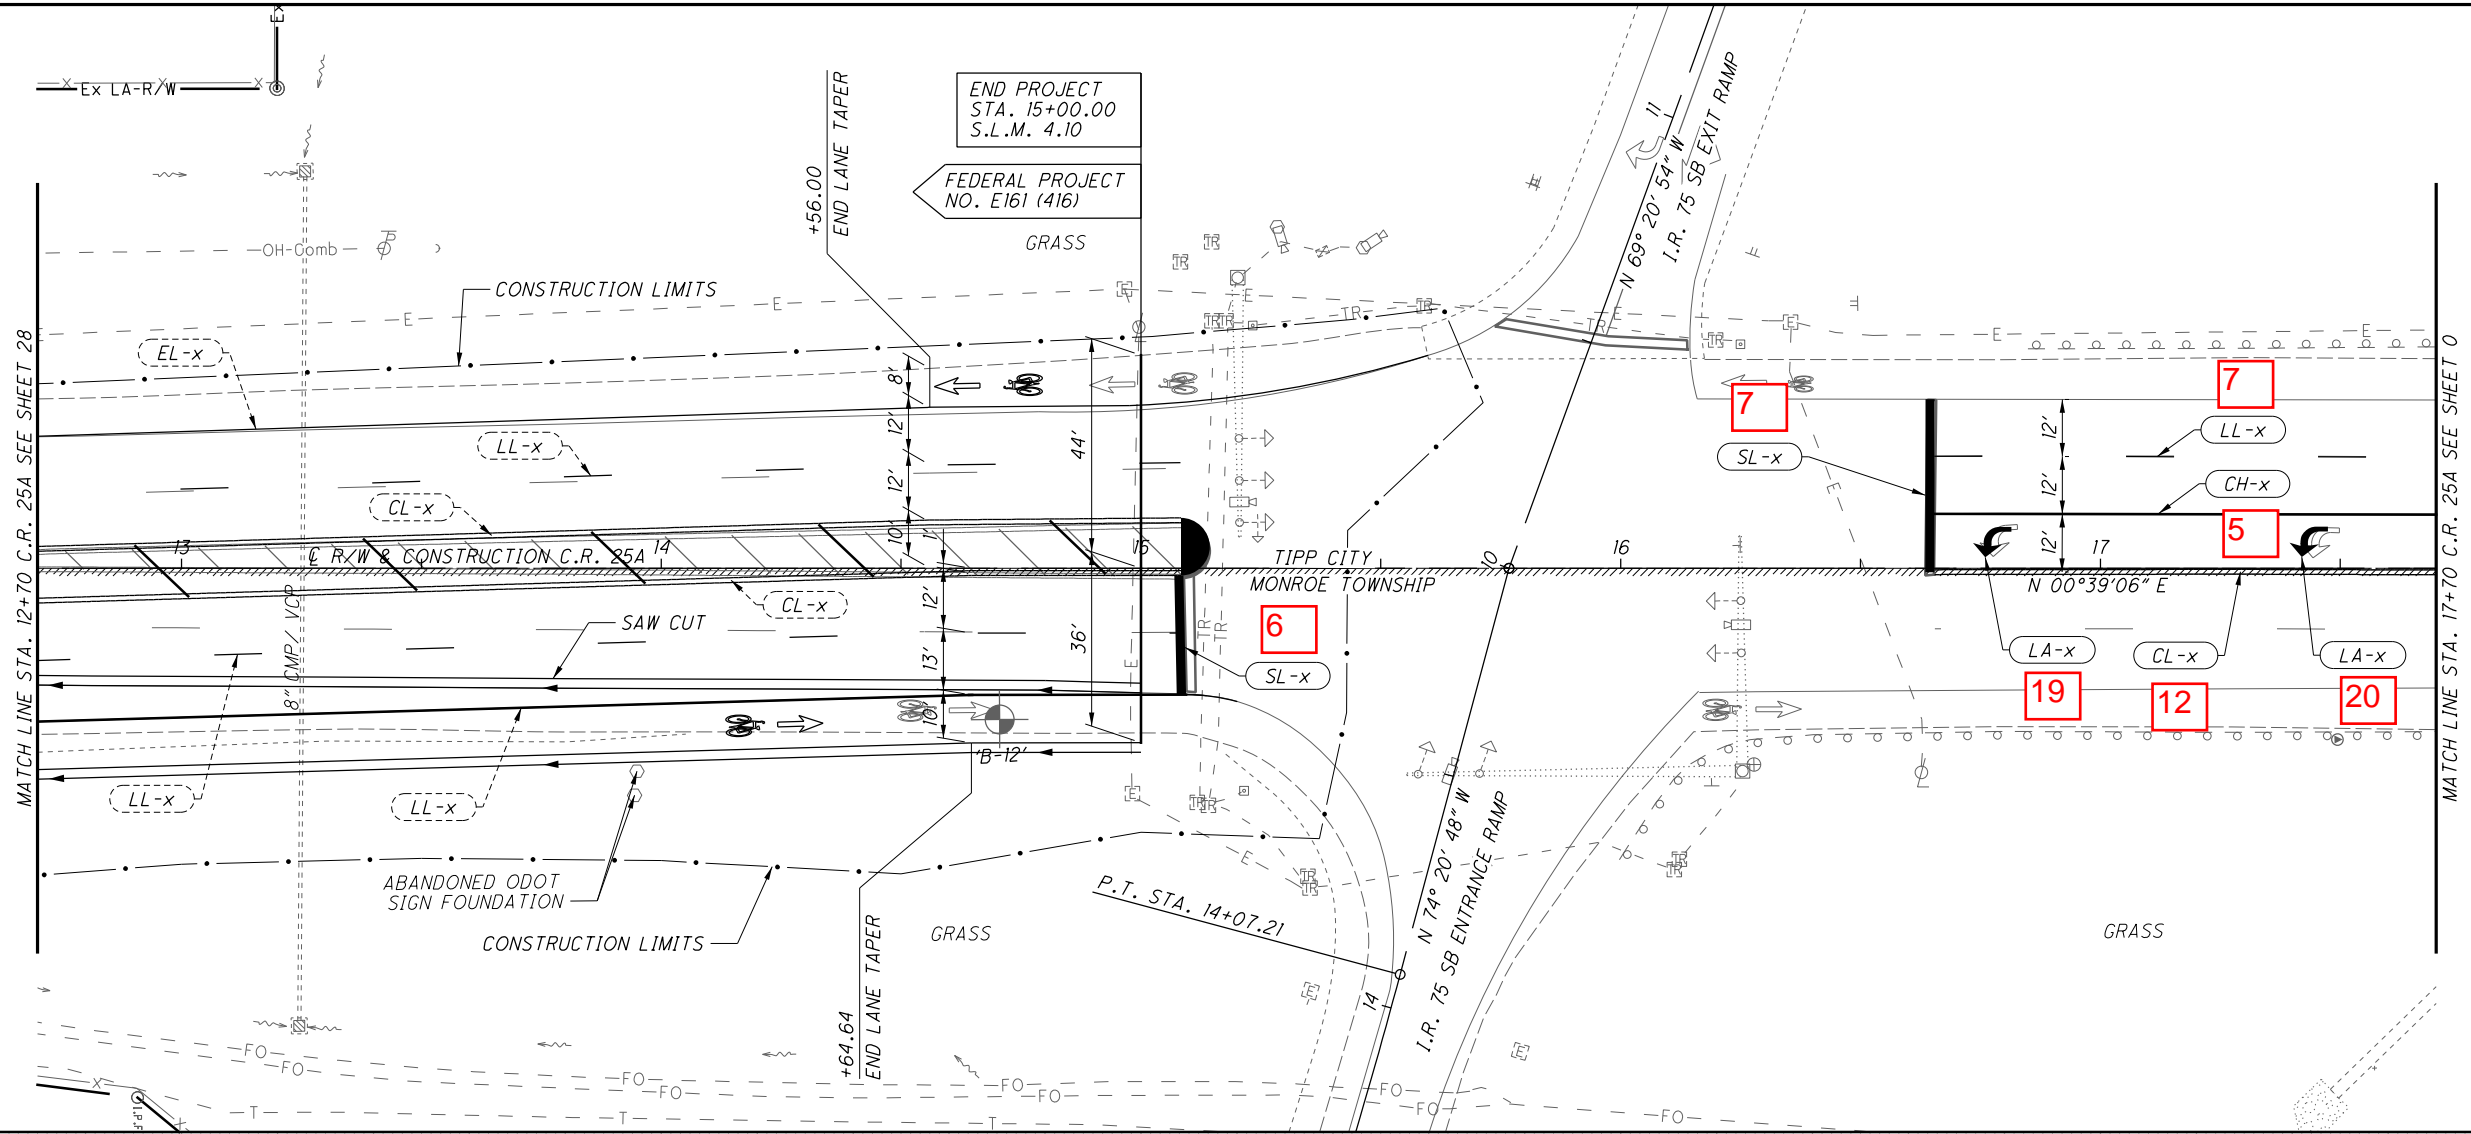

**PLAN AND PROFILE - C.R. 25A
 STA. 12+70 TO STA. 17+70**

MIA - C.R. 25A - 3.54

MATCH LINE STA. 17+70 C.R. 25A SEE SHEET 29

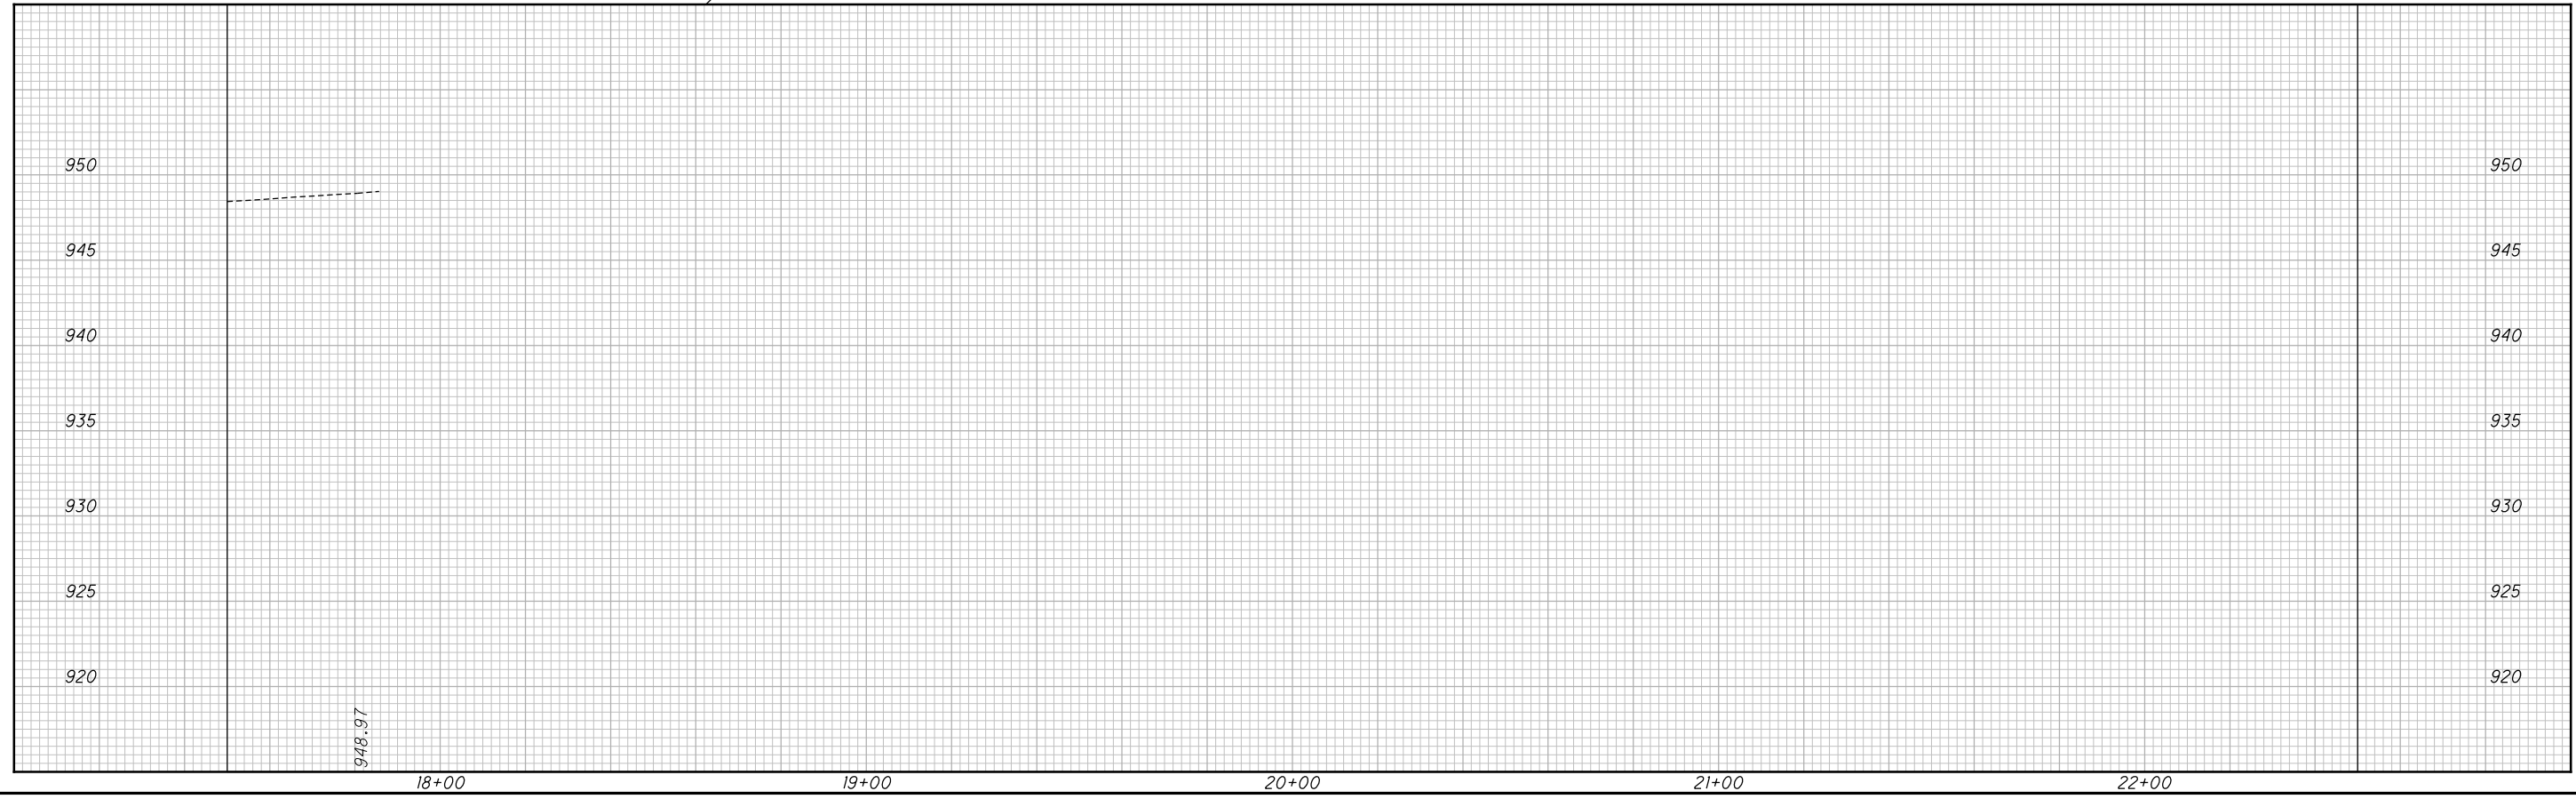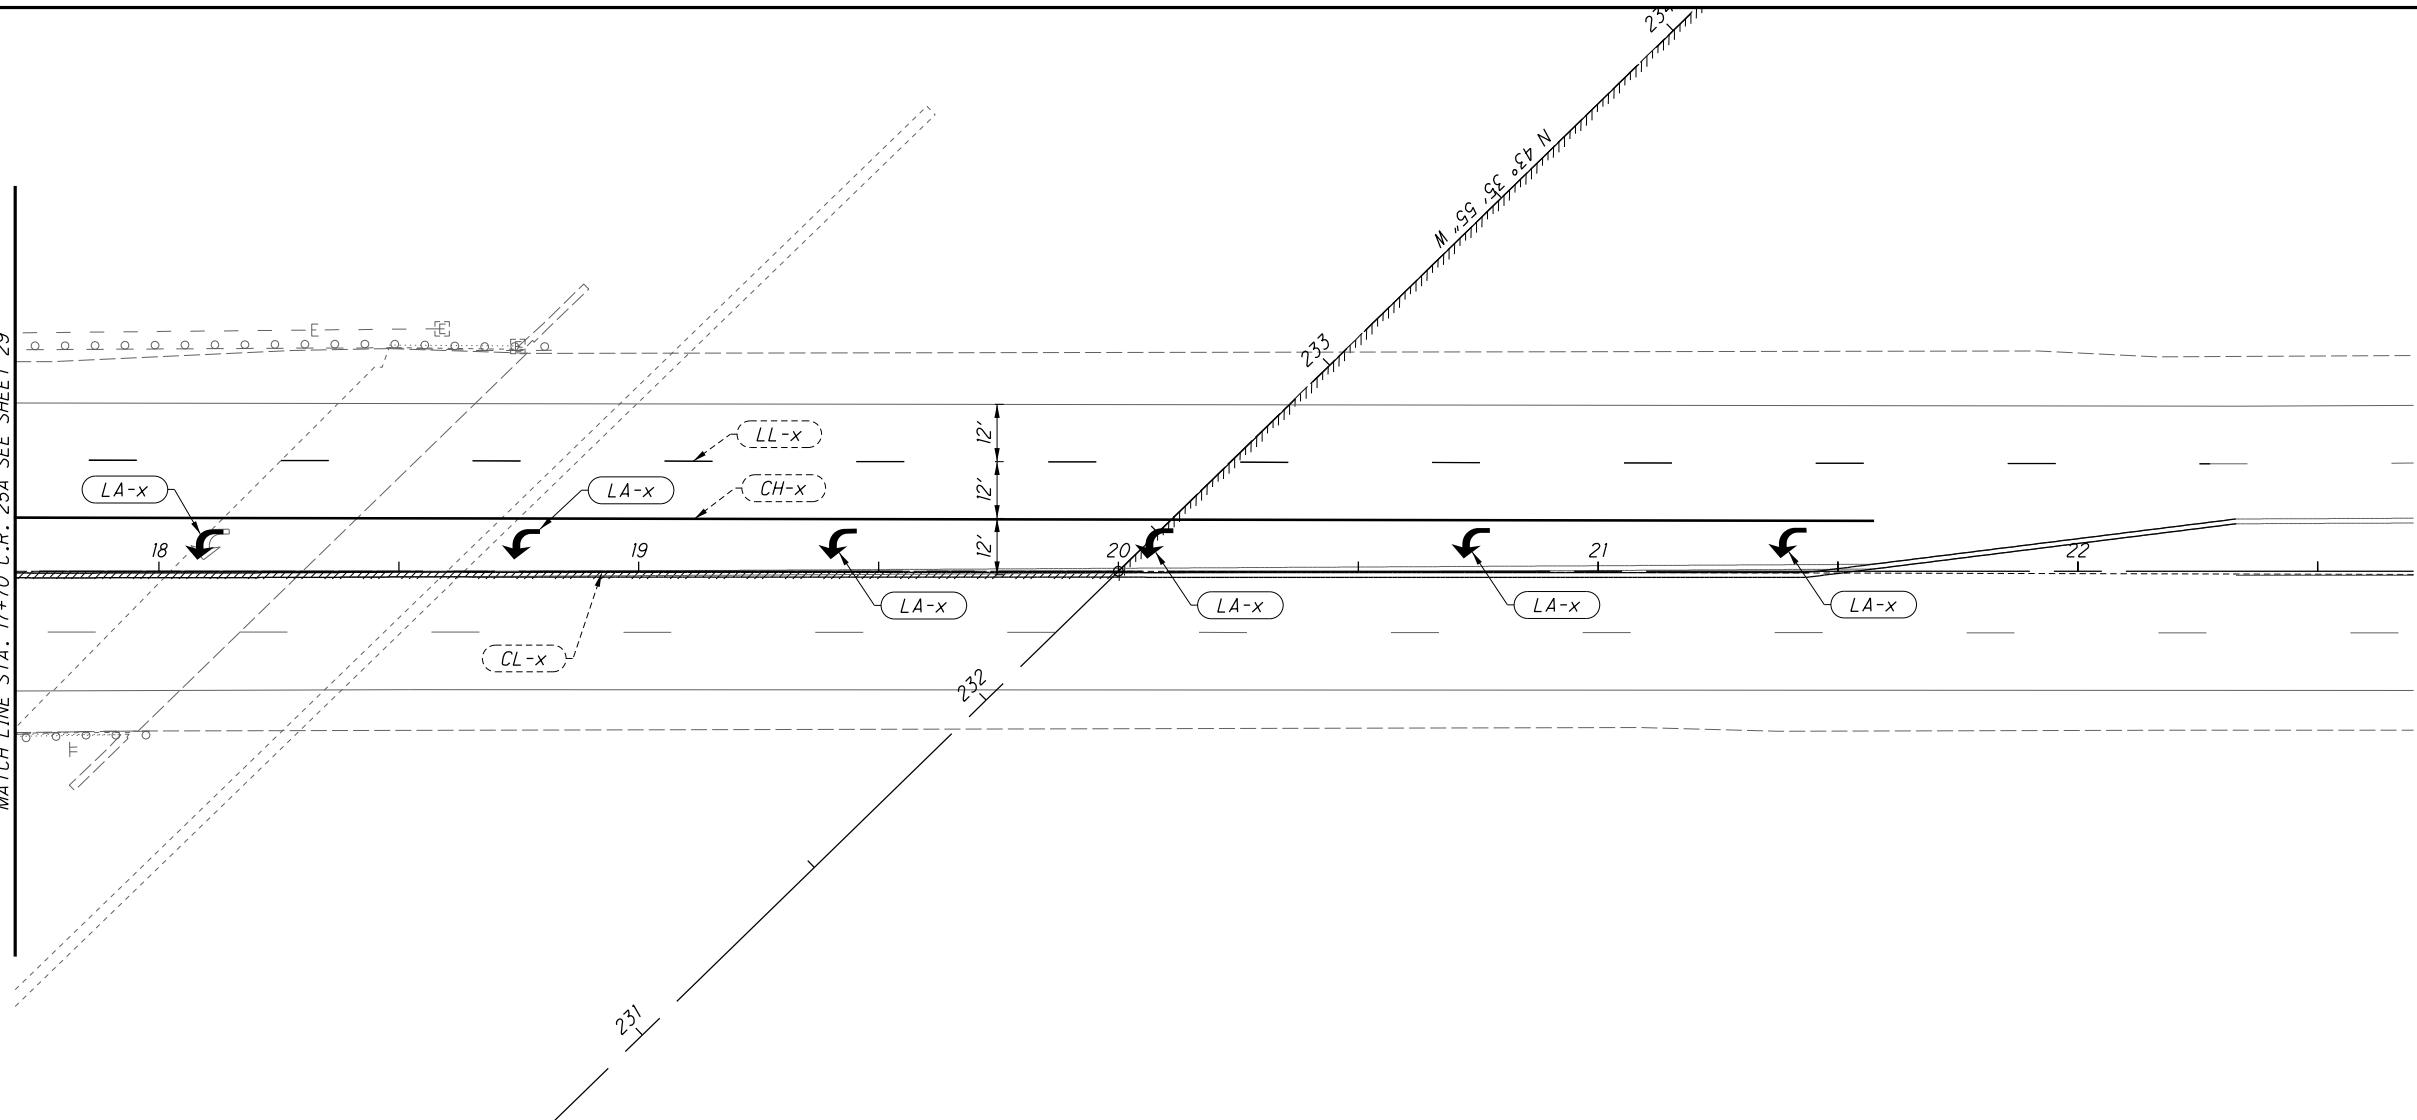

CALCULATED
BAA
CHECKED
TWG

0 20 40
HORIZONTAL
SCALE IN FEET

N

PLAN AND PROFILE - C.R. 25A
STA. 17+70 TO STA. 22+70

MIA - C.R. 25A - 3.54