




LOCATION MAP
LATITUDE: 39° 37' 49" N LONGITUDE: 84° 13' 20" W

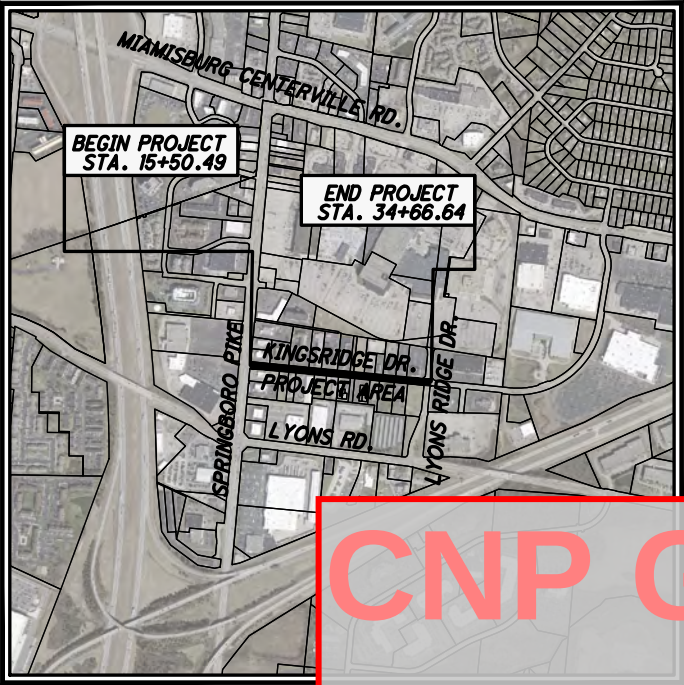

PORTION TO BE IMPROVED -----
STATE & FEDERAL ROUTES -----
OTHER ROADS -----

DESIGN DESIGNATION

CURRENT ADT (2027) ----- 8,900
DESIGN YEAR ADT (2047) ----- 9,800
DESIGN HOURLY VOLUME (2047) ----- 1,000
DIRECTIONAL DISTRIBUTION ----- 0.60
TRUCKS (24 HOUR B&C) ----- 110
DESIGN SPEED ----- 25 MPH
LEGAL SPEED ----- Ex. 40 MPH
PROP. 25 MPH

DESIGN FUNCTIONAL CLASSIFICATION:
LOCAL ROADWAY
NHS PROJECT ----- NO

DESIGN EXCEPTIONS: NONE REQUIRED

ADA DESIGN WAIVERS: NONE REQUIRED

UNDERGROUND UTILITIES

Contact Two Working Days
Before You Dig


Before You Dig

OHIO 811, 8-1-1, or 1-800-362-2764
(Non-members must be called directly)

PLAN PREPARED BY:


ChoiceOne
Engineering

2633 CAMPBELL ROAD • SIDNEY, OHIO 45365 • 937.497.0200
6279 TRI RIDGE BLVD., SUITE 100 • LOVELAND, OHIO 45140 • 513.239.8554

www.CHOICEONEENGINEERING.com

STATE OF OHIO
DEPARTMENT OF TRANSPORTATION

MOT-KINGSRIDGE DRIVE

MIAMI TOWNSHIP

FEDERAL PROJECT NO.
E231(012)

RAILROAD INVOLVEMENT
NONE

PROJECT DESCRIPTION

THIS PROJECT CONSISTS OF REDUCING THE ROADWAY WIDTH OF KINGSRIDGE DRIVE FROM SPRINGBORO PIKE (SR 741) TO LYONS RIDGE DRIVE AND THE CONSTRUCTION OF NEW CURB AND GUTTER, SIDEWALK, ADA COMPLIANT PEDESTRIAN CROSSINGS, MID-BLOCK CROSSINGS, LIGHTING, LANDSCAPING AND MINOR TRAFFIC SIGNAL IMPROVEMENTS.

CNP GAS DISTRIBUTION WORK PLAN

(COMPLETED BY ENTRUST)

Work Plan Completed: 10/01/2026

Based on Plan Set:
Dated: 04/10/2026 Issued: 04/22/2026

ENGINEERS SEAL


FOR ENTIRE PLAN
EXCEPT TRAFFIC
SIGNAL PLAN



SIGNED: _____
DATE: _____

ENGINEERS SEAL

FOR TRAFFIC
SIGNAL PLAN

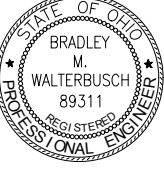


SIGNED: _____
DATE: _____

STAGE 3 - SUBMITTAL
4-10-2026

DATES TO BE UPDATED PRIOR TO FINAL TRACINGS

OHIO DEPARTMENT OF TRANSPORTATION STANDARD CONSTRUCTION DRAWINGS					MONTGOMERY COUNTY STANDARD CONSTRUCTION DRAWINGS		SUPPLEMENTAL SPECIFICATIONS		PROPOSAL NOTES
BP-3.1	XX/XX/XX	TC-41.20	XX/XX/XX	MT-95.60	XX/XX/XX	4-H-1-4	XX/XX/XX	800	XX-XX-XX
BP-4.1	XX/XX/XX	TC-42.20	XX/XX/XX	MT-97.10	XX/XX/XX	CB-2.2	XX/XX/XX	813	XX-XX-XX
BP-5.1	XX/XX/XX	TC-71.10	XX/XX/XX	MT-97.12	XX/XX/XX	MH-1.2	XX/XX/XX	825	XX-XX-XX
BP-7.1	XX/XX/XX	TC-74.10	XX/XX/XX	MT-101.90	XX/XX/XX			832	XX-XX-XX
		TC-83.10	XX/XX/XX	MT-105.10	XX/XX/XX			840	XX-XX-XX
DM-1.1	XX/XX/XX	TC-83.20	XX/XX/XX	MT-110.10	XX/XX/XX			878	XX-XX-XX
DM-4.4	XX/XX/XX	TC-83.30	XX/XX/XX					895	XX-XX-XX
		TC-84.21	XX/XX/XX	HL-10.11	XX/XX/XX			913	XX-XX-XX
		TC-85.10	XX/XX/XX	HL-10.12	XX/XX/XX			916	XX-XX-XX
		TC-85.22	XX/XX/XX	HL-10.13	XX/XX/XX			995	XX-XX-XX
		TC-87.10	XX/XX/XX	HL-20.11	XX/XX/XX			997	XX-XX-XX
				HL-30.11	XX/XX/XX			999	XX-XX-XX
				HL-30.22	XX/XX/XX				
				HL-40.20	XX/XX/XX				
				HL-60.11	XX/XX/XX				
				HL-60.31	XX/XX/XX				


John W. O'Brien
DISTRICT 07 DEPUTY DIRECTOR

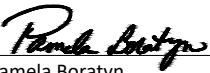
Pamela Boratyn
DIRECTOR, DEPARTMENT OF TRANSPORTATION

TITLE SHEET

DESIGN AGENCY



CHOICE ONE ENGINEERING

DESIGNER

IJW

REVIEWER

AJH 4-10-2026

PROJECT ID

120184

SHEET

P:1

TOTAL



67

- HATCH LEGEND (ALL PLAN SHEETS)
- FULL DEPTH PAVEMENT REPAIR
 - PAVEMENT PLANING AND ASPHALT RESURFACING
 - PAVEMENT PLANING AND ASPHALT RESURFACING (VARIABLE DEPTH)
 - ASPHALT DRIVEWAYS
 - COMMERCIAL CONCRETE DRIVEWAYS
 - CURB RAMP
 - SIDEWALK
 - CRUSHED AGGREGATE SLOPE PROTECTION
 - IMPERVIOUS TO PERVIOUS (REMOVAL/EXCAVATION)




- ABBREVIATION LEGEND (ALL PLAN SHEETS)
- (ATG) - ADJUST TO GRADE
 - (RTG) - RECONSTRUCT TO GRADE
 - (DND) - NO NOT DISTURB
 - (R&R) - REMOVE AND RESET
 - (TBR) - TO BE REMOVED
 - (TBRLO) - TO BE RELOCATED BY OTHERS
 - (ATGBO) - ADJUST TO GRADE BY OTHERS

- SYMBOLS LEGEND (ALL PLAN SHEETS)
- STM MH (ATG)
 - SAN MH (ATG)
 - SAN MH (RTG)
 - CATCHBASIN (ATG)
 - WATER METER PIT (ATG)
 - WATER SERVICE VALVE (ATG)
 - WATER VALVE (ATG)
 - PROP. LIGHT POLE
 - TREE REMOVAL
 - CONST. LIMITS

BENCHMARK. #4 ELEV. 970.56
FIRE HYDRANT AT MARIONS
PIZZA. BOLT TOP FLANGE TIP OF
ARROW. STA. 17+83 LT

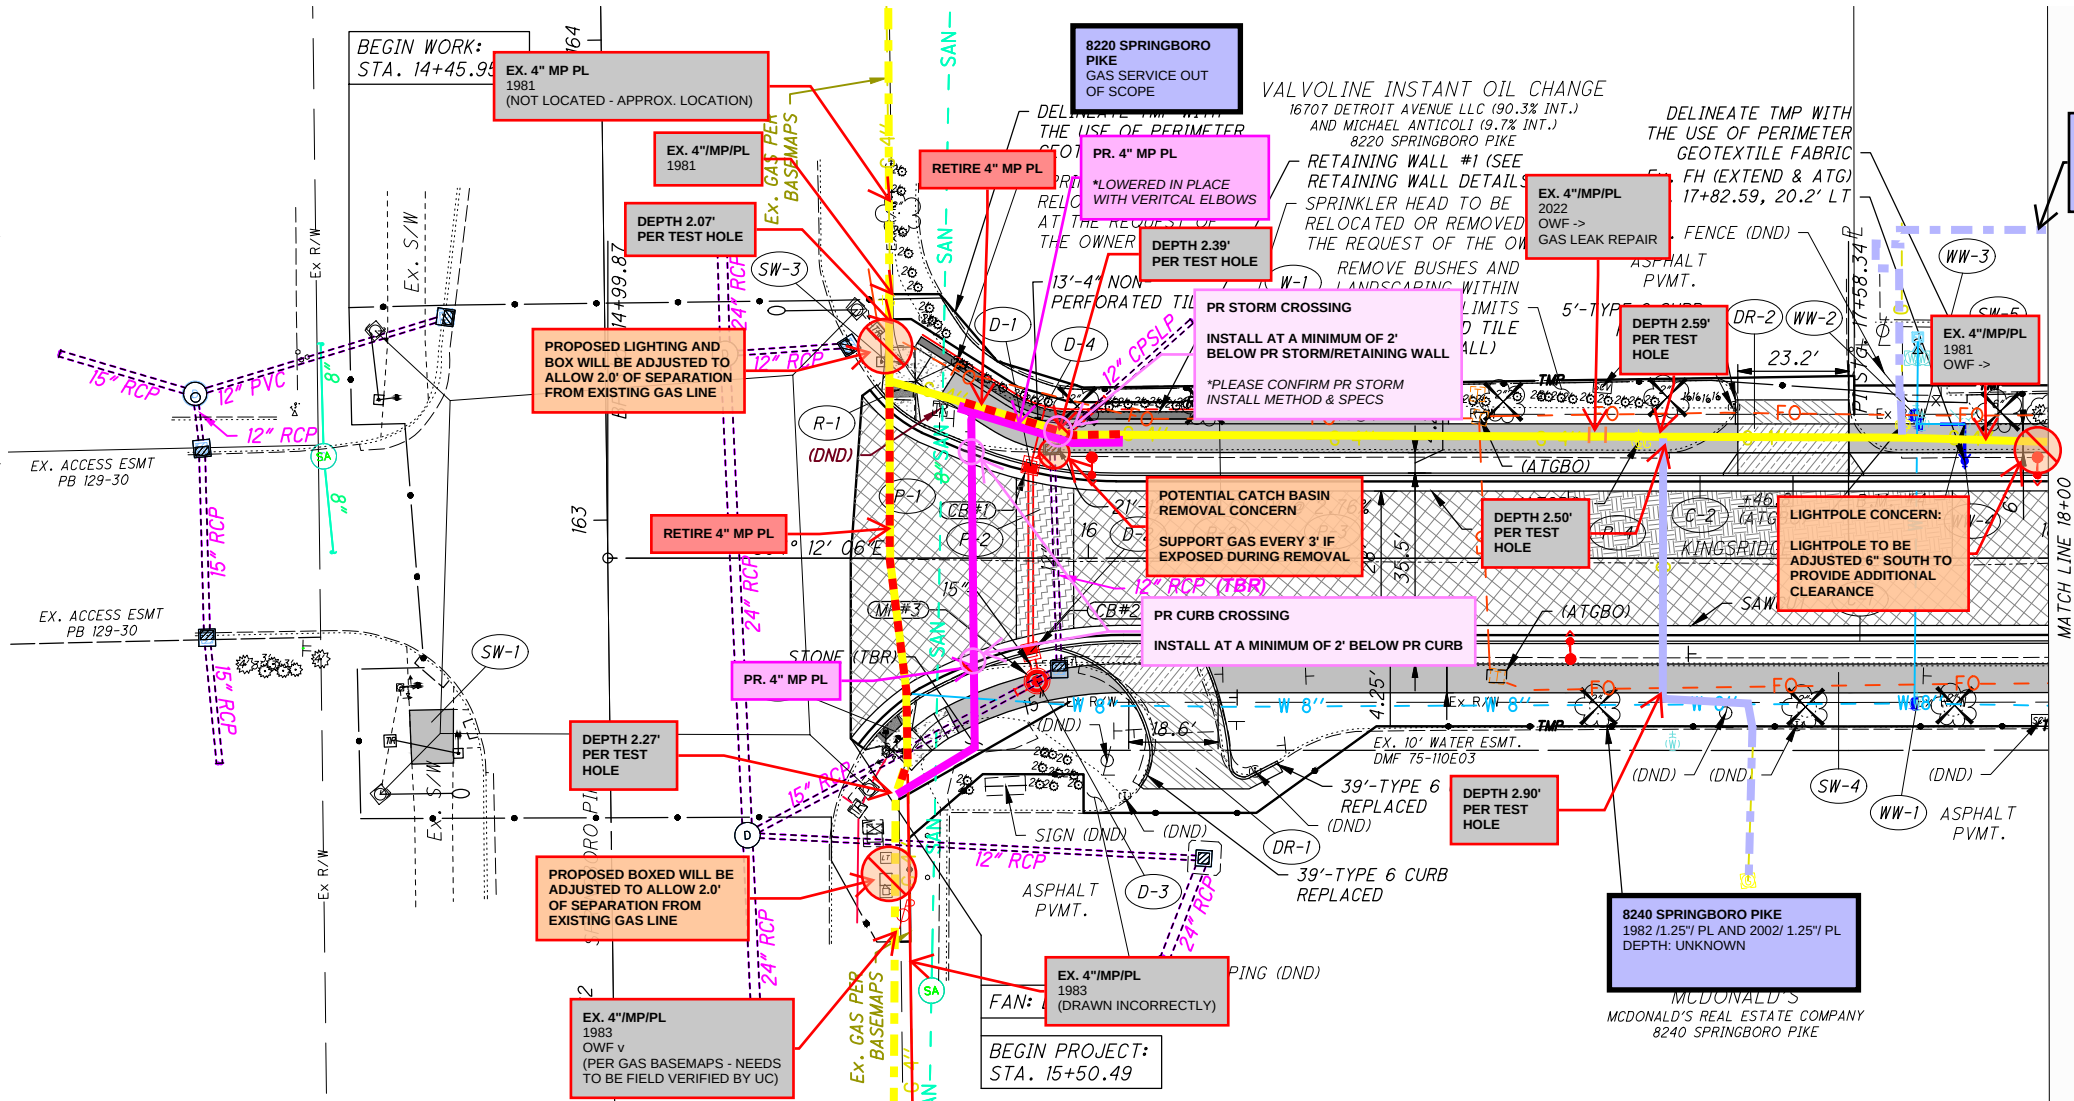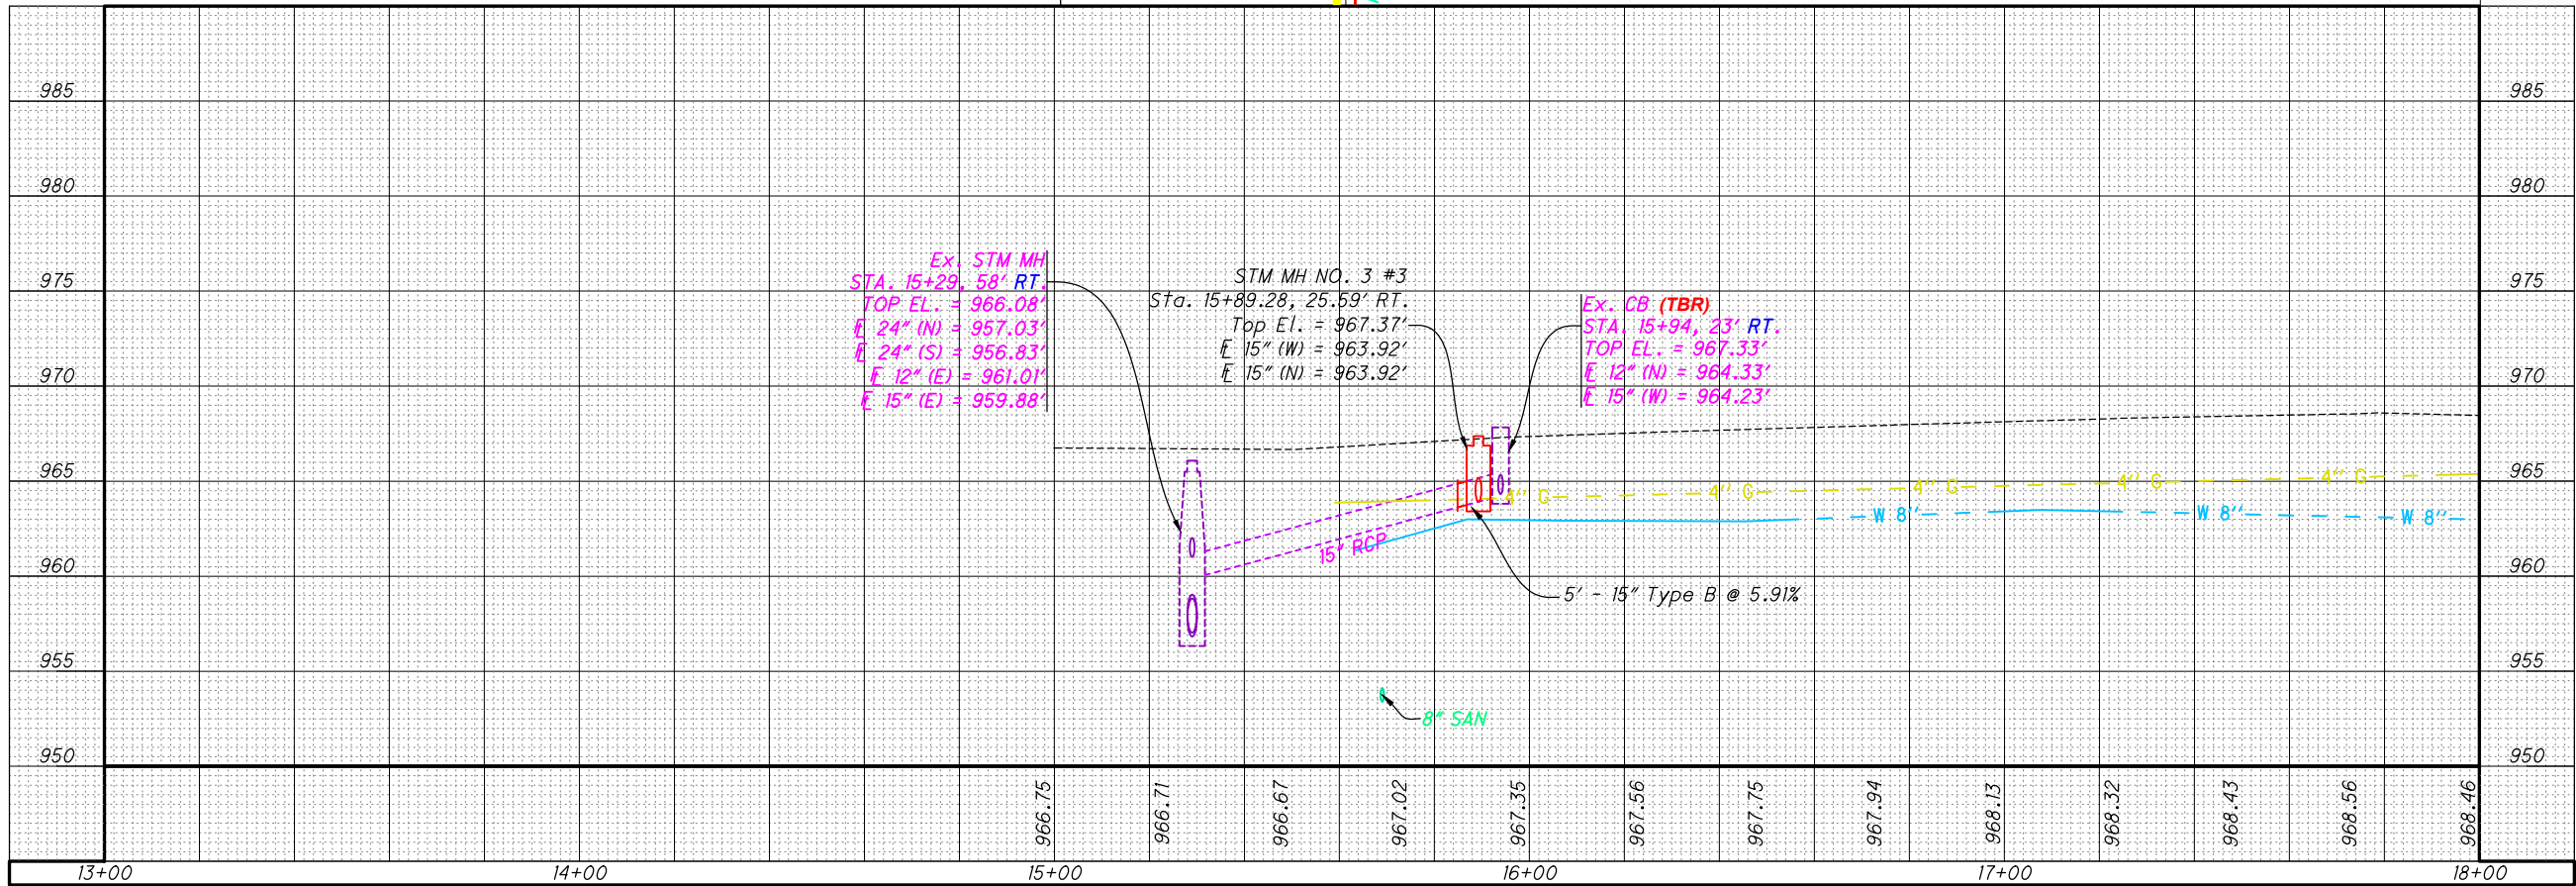

BENCHMARK #3 ELEV. 965.90
FIRE HYDRANT AT THE TOWN
SUITES. BOLT TOP FLANGE TIP
OF ARROW. STA. 20+56 LT

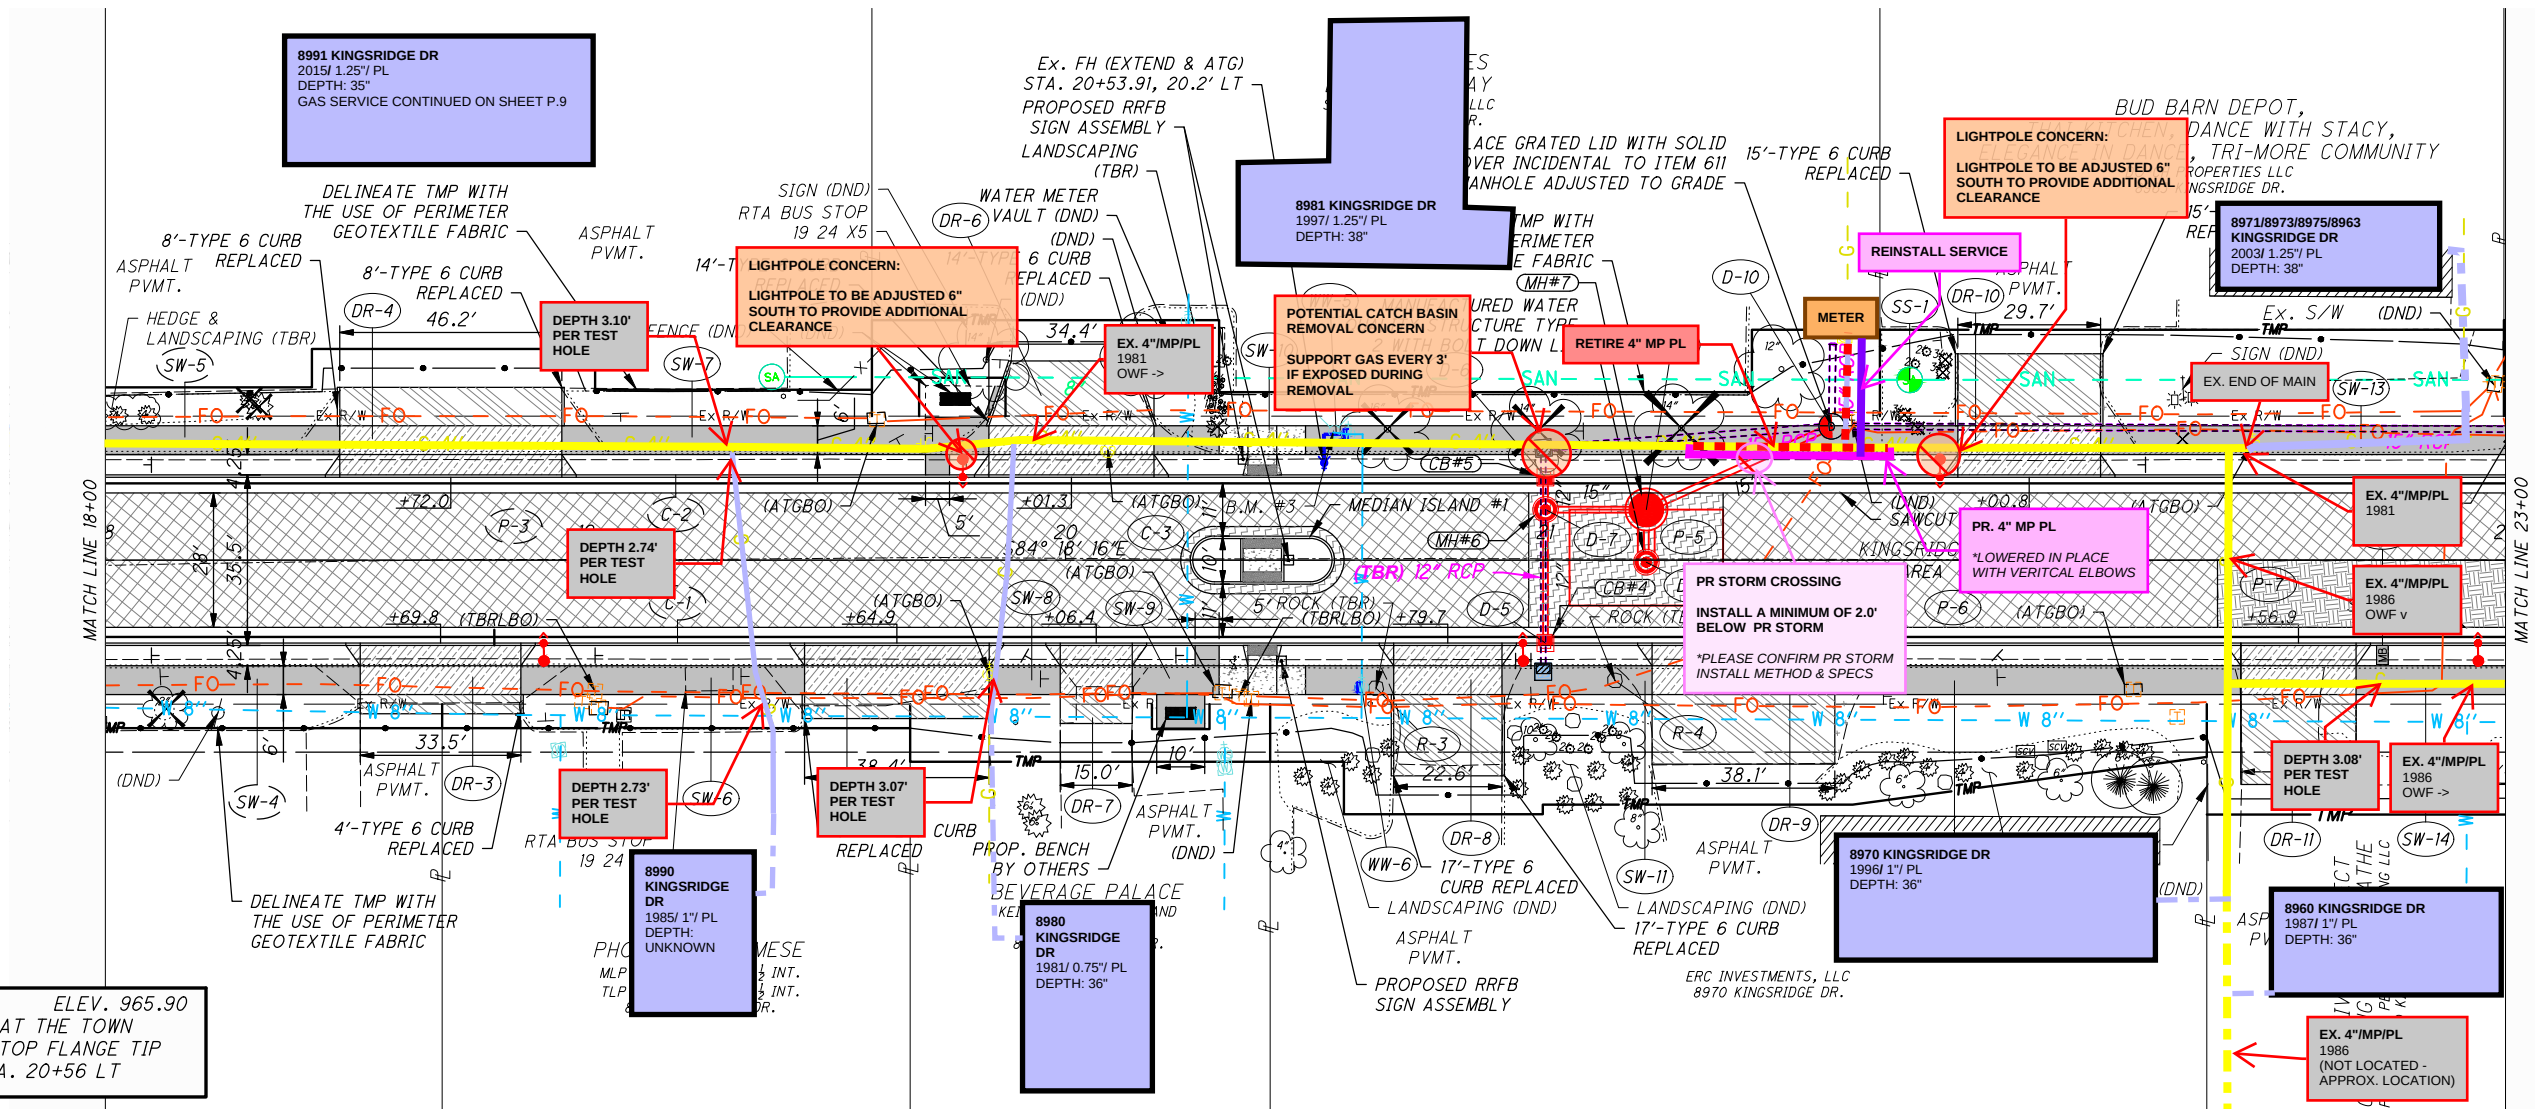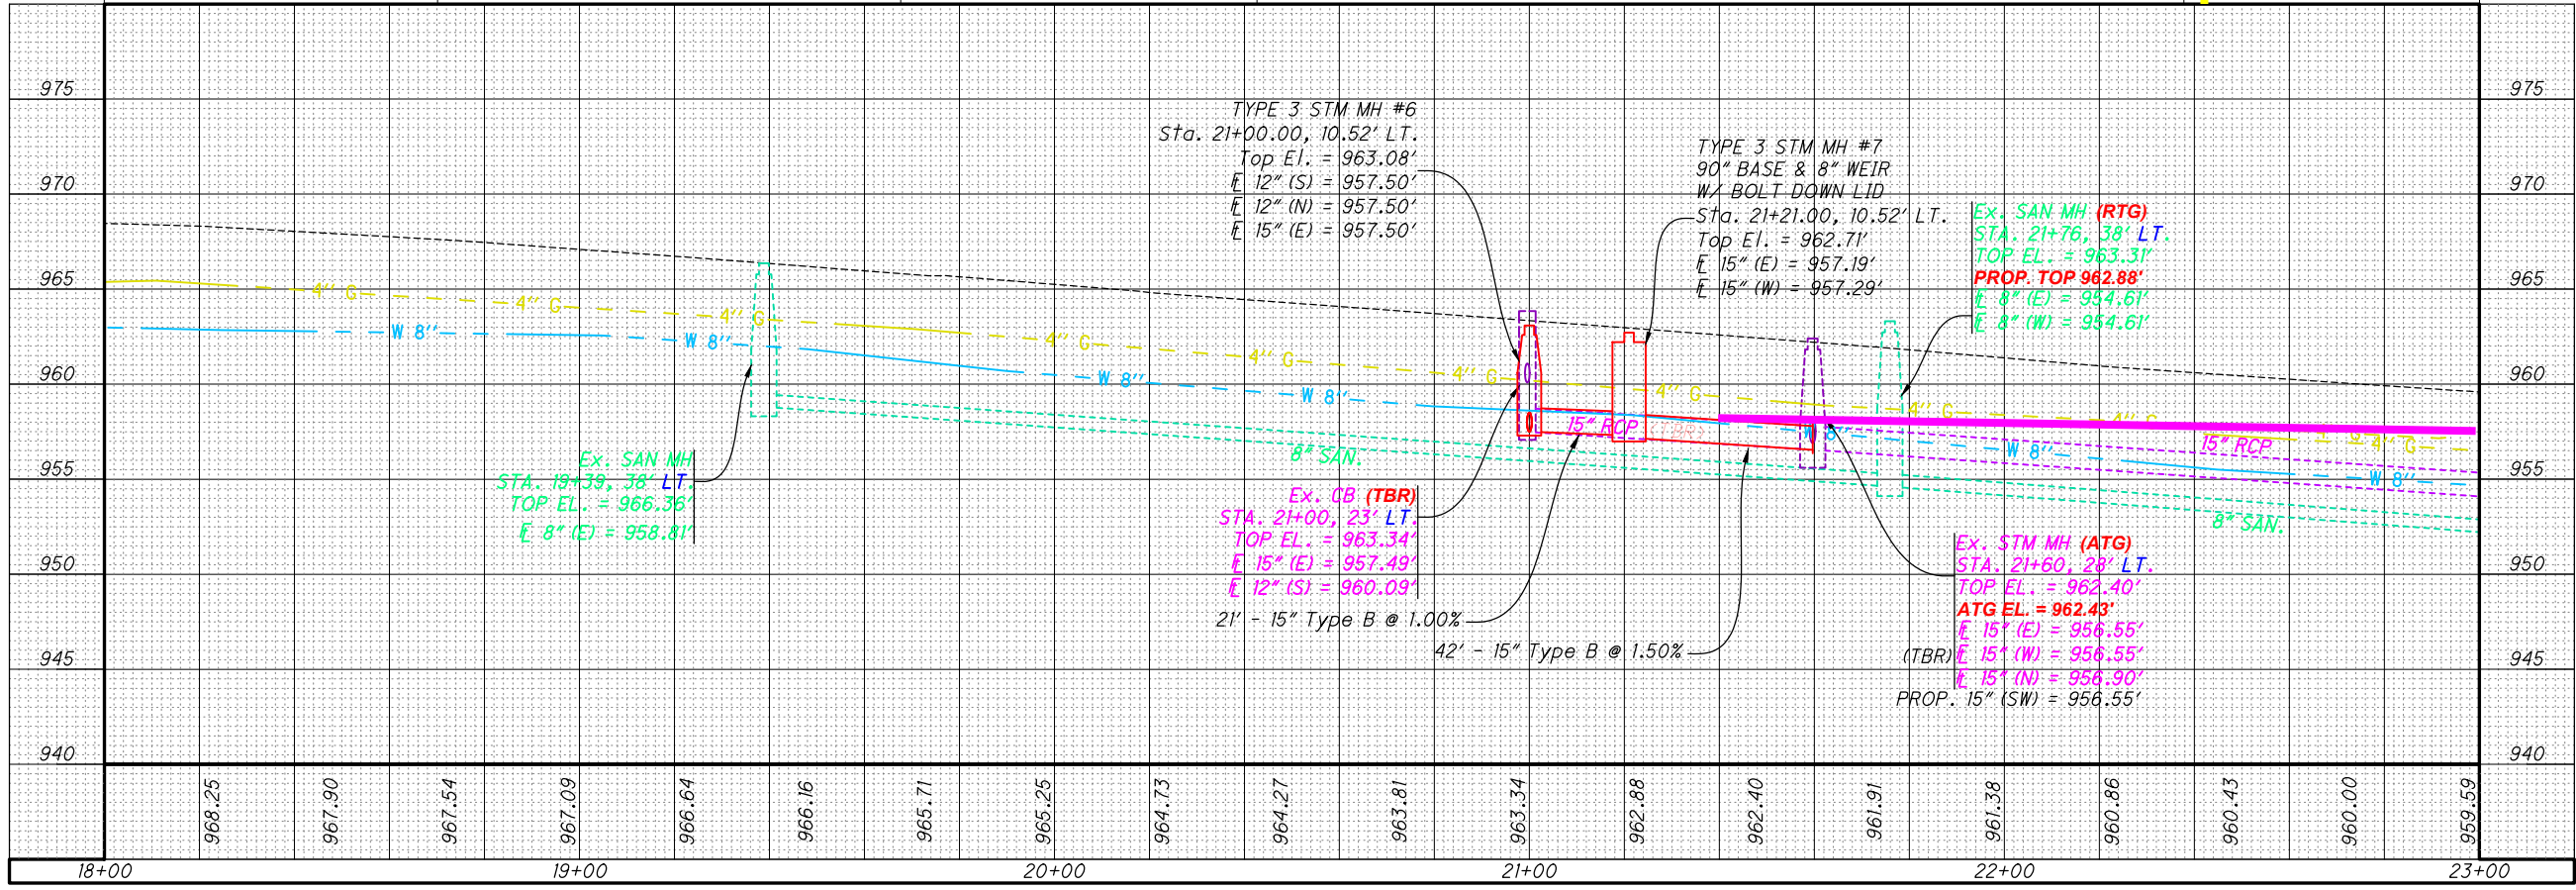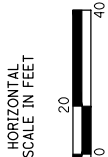

PLAN AND PROFILE - KINGSRIDGE DRIVE
STA. 18+00 TO STA. 23+00

DESIGN AGENCY



CHOICE ONE ENGINEERING

DESIGNER

IJW

REVIEWER

AJH 4-10-2026

PROJECT ID


120184


SHEET

P.23


TOTAL 67




BENCHMARK #2 ELEV. 956.54
FIRE HYDRANT AT ADVANCED
DERMATOLOGY. BOLT TOP FLANGE
TIP OF ARROW. STA. 26+03 RT

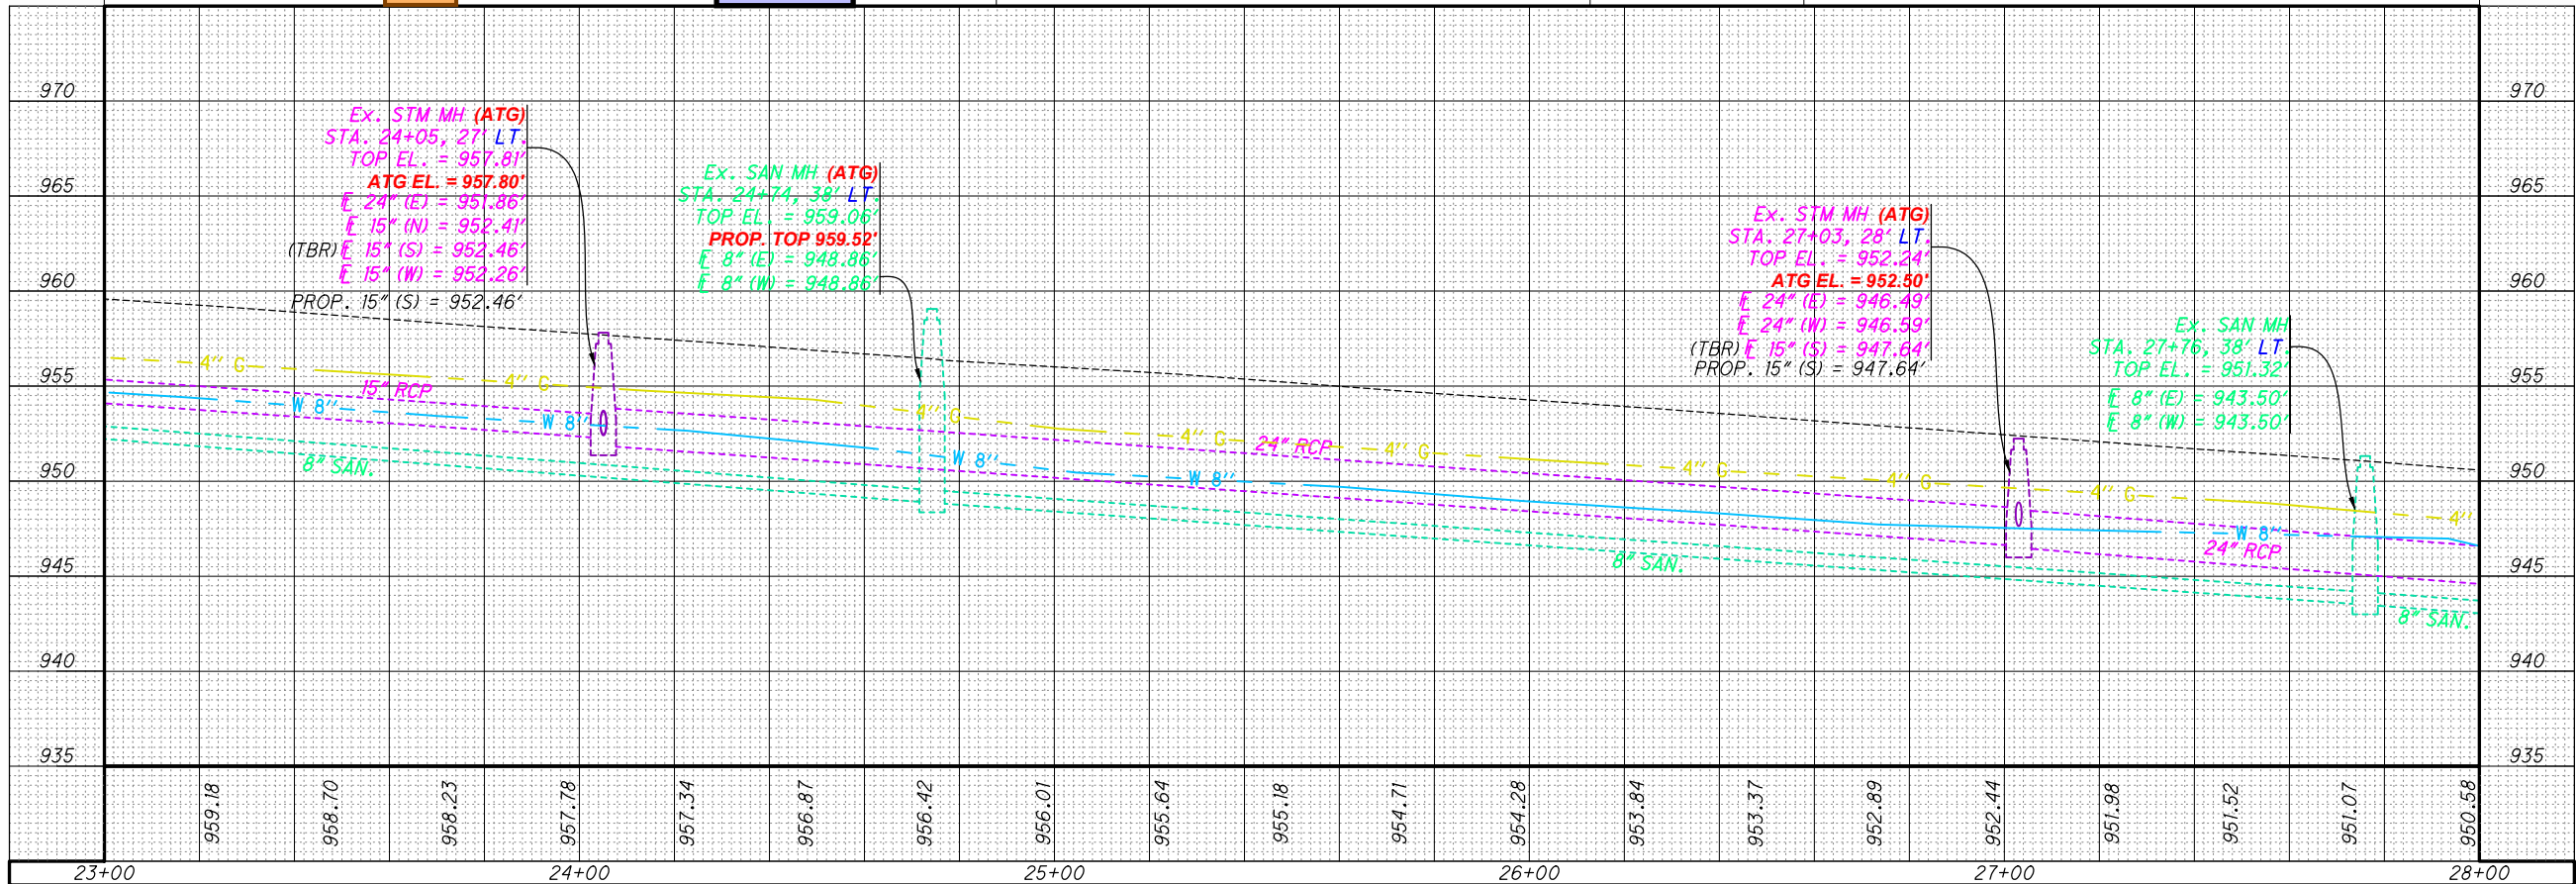

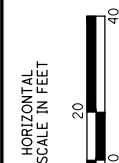

PLAN AND PROFILE - KINGSRIDGE DRIVE
STA. 28+00 TO STA. 33+00

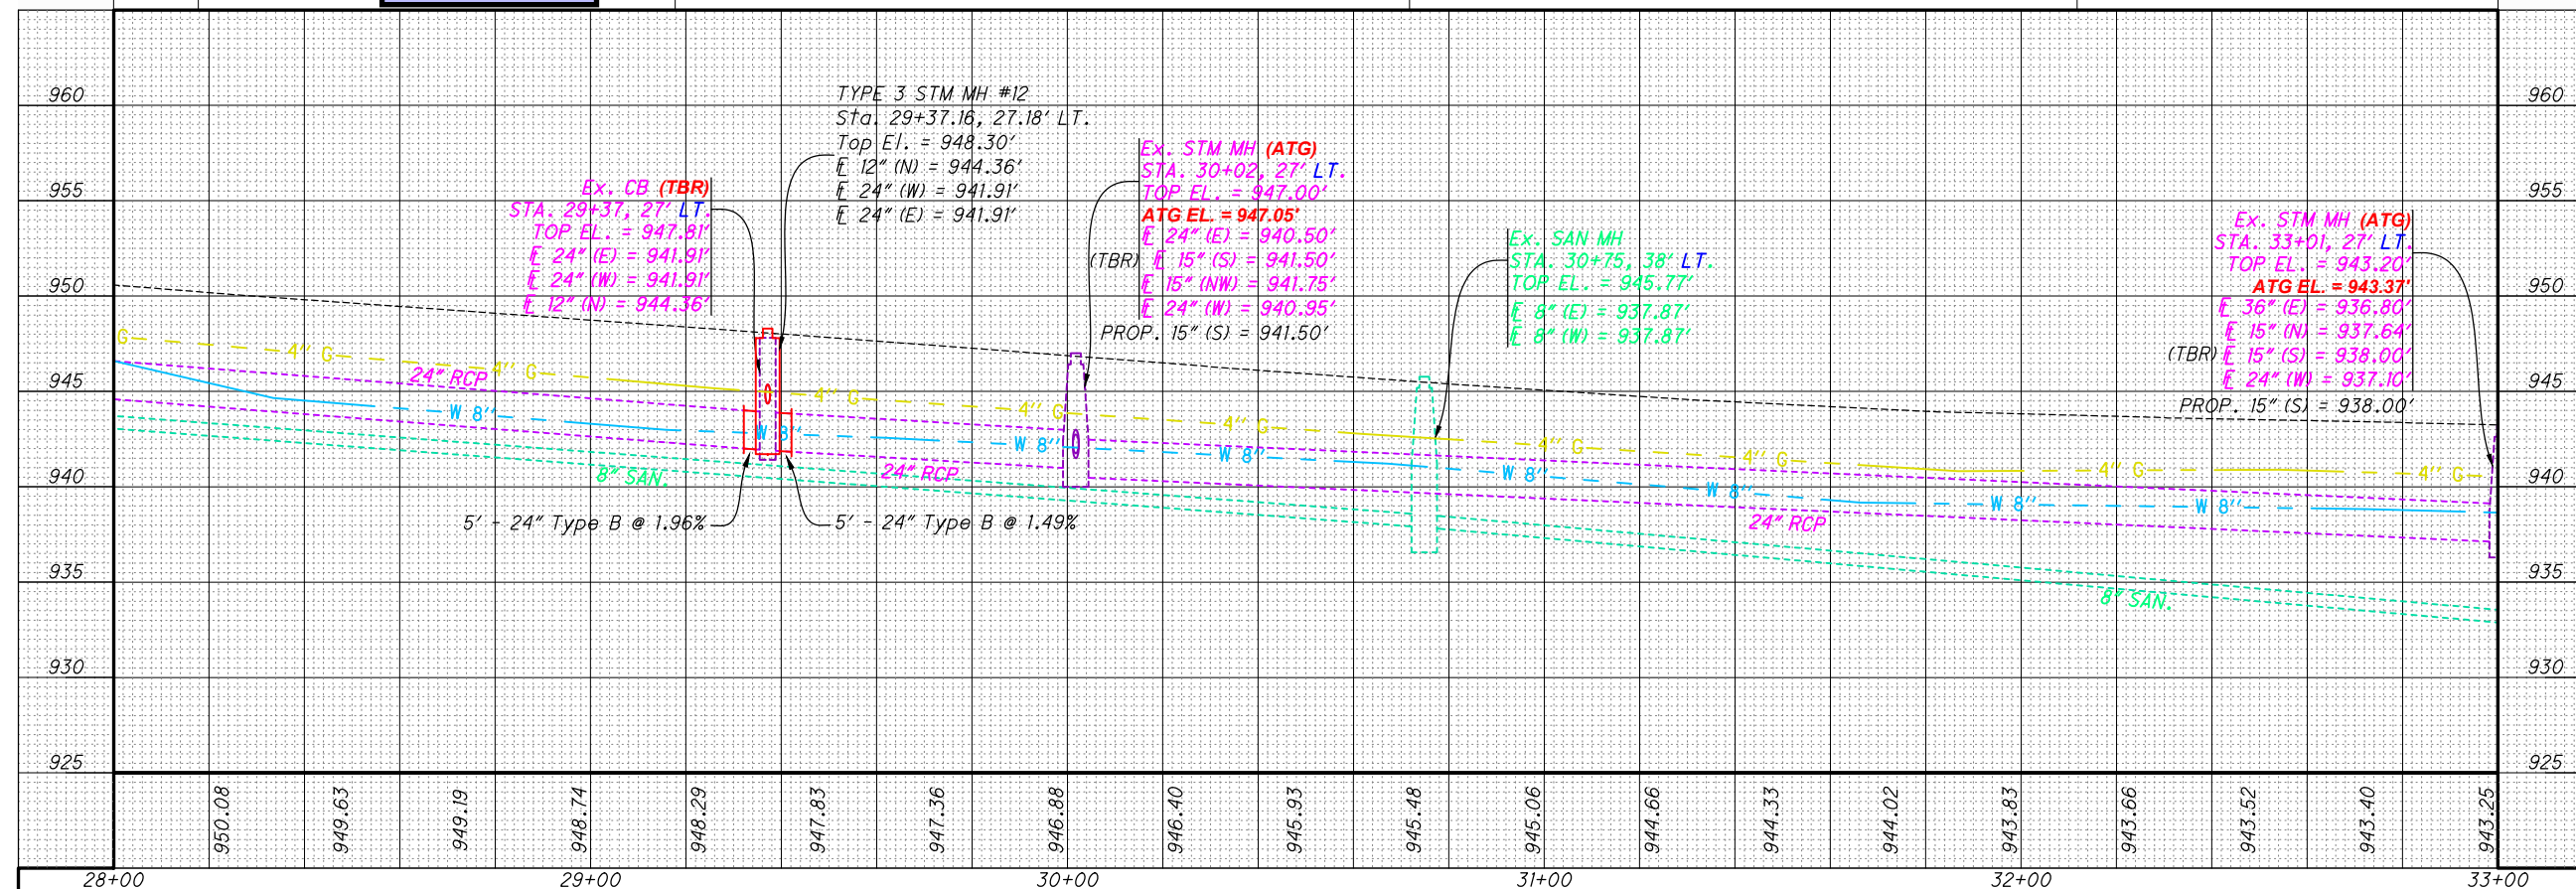

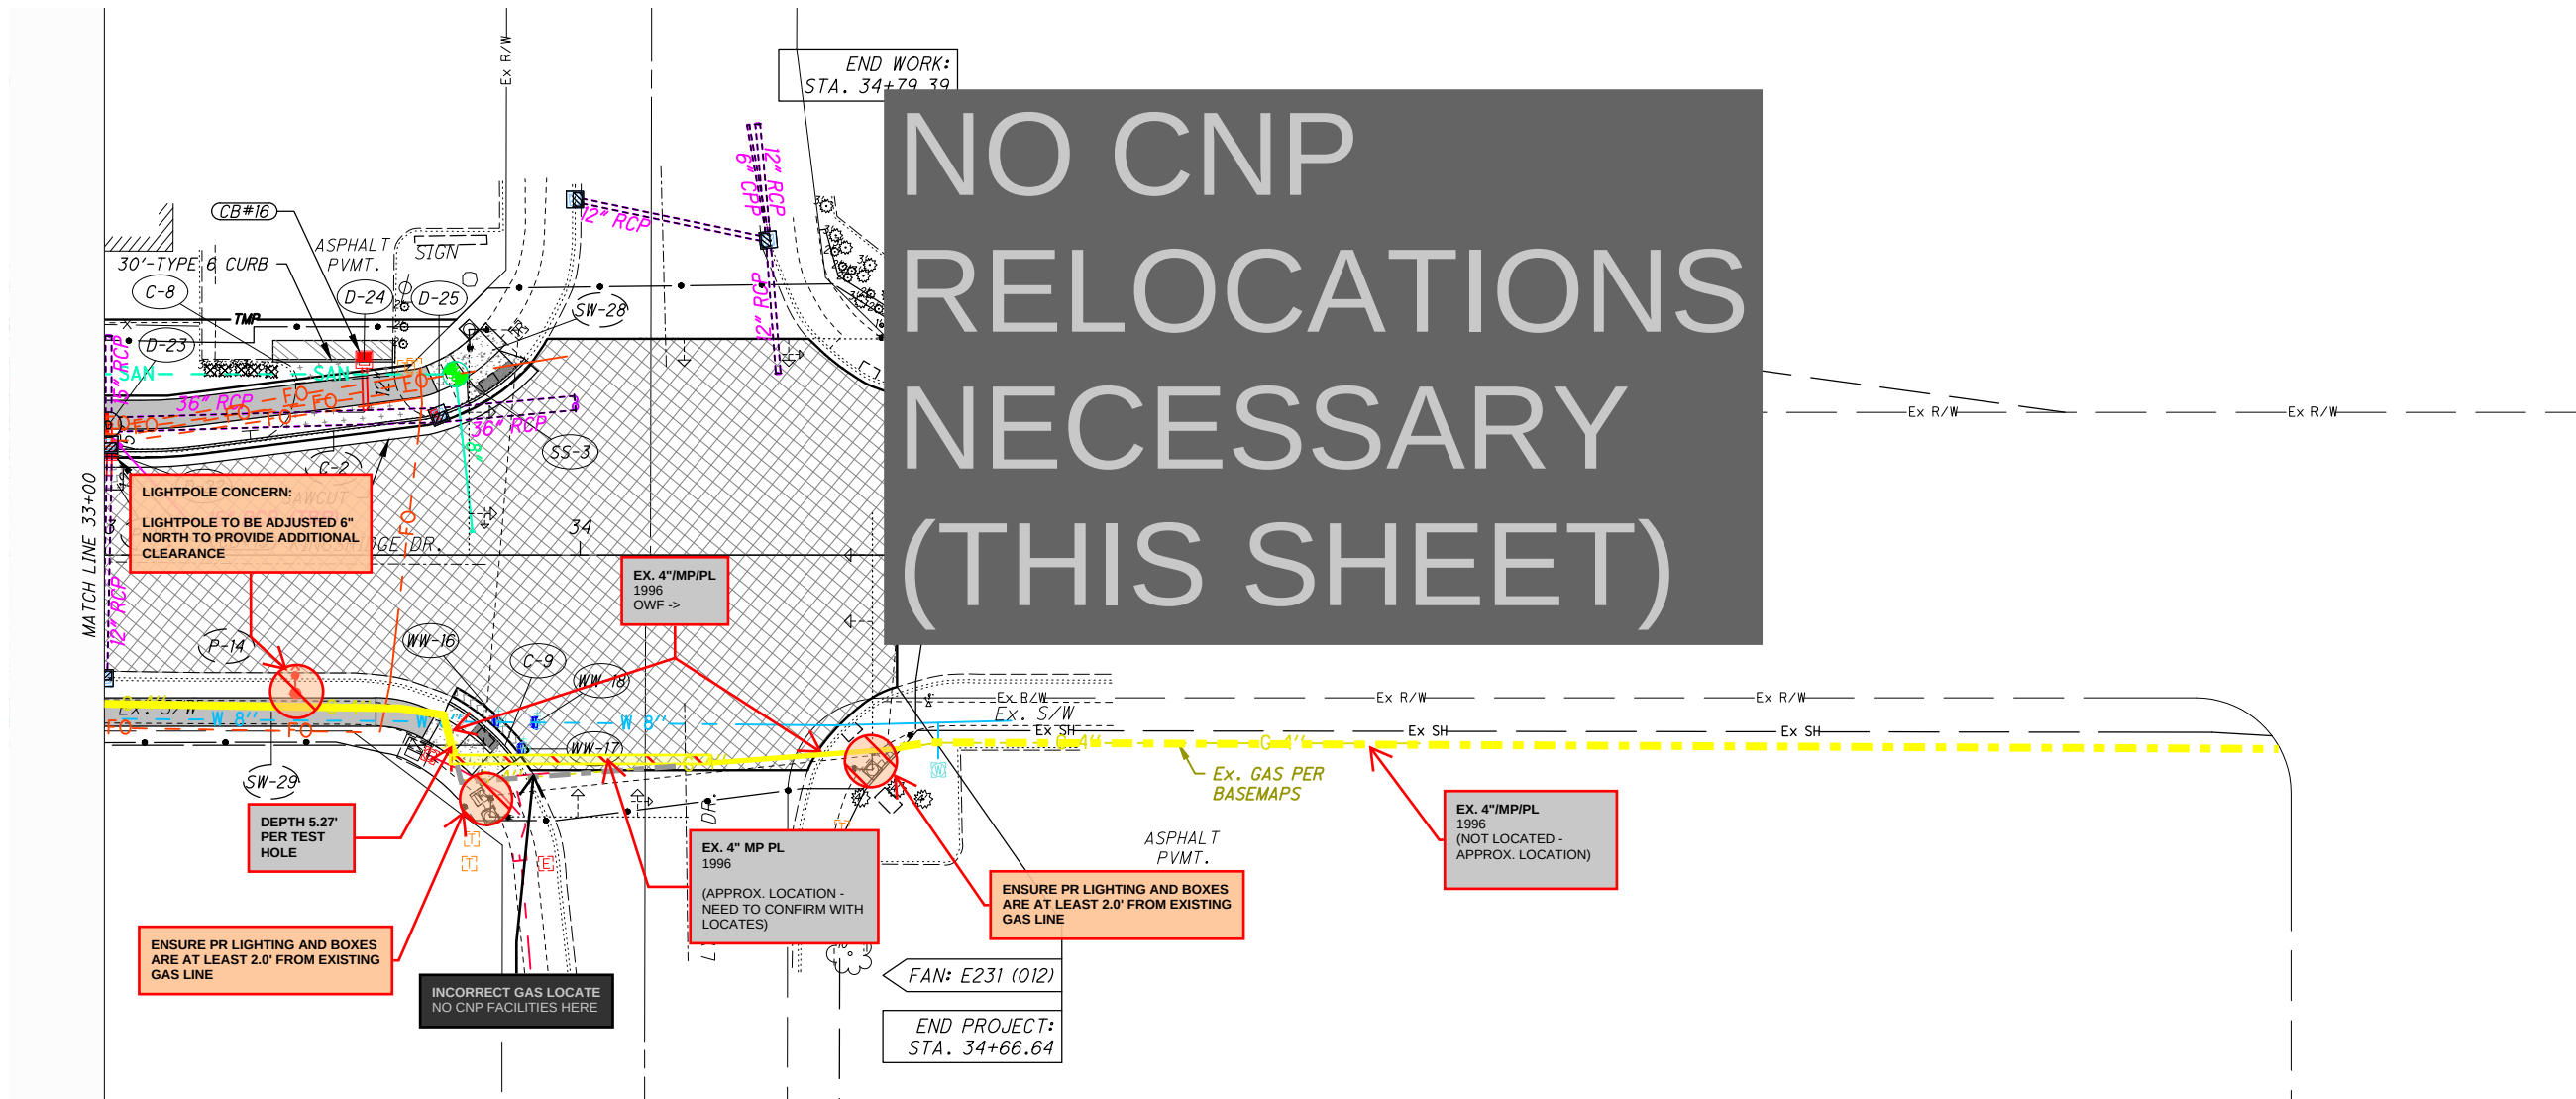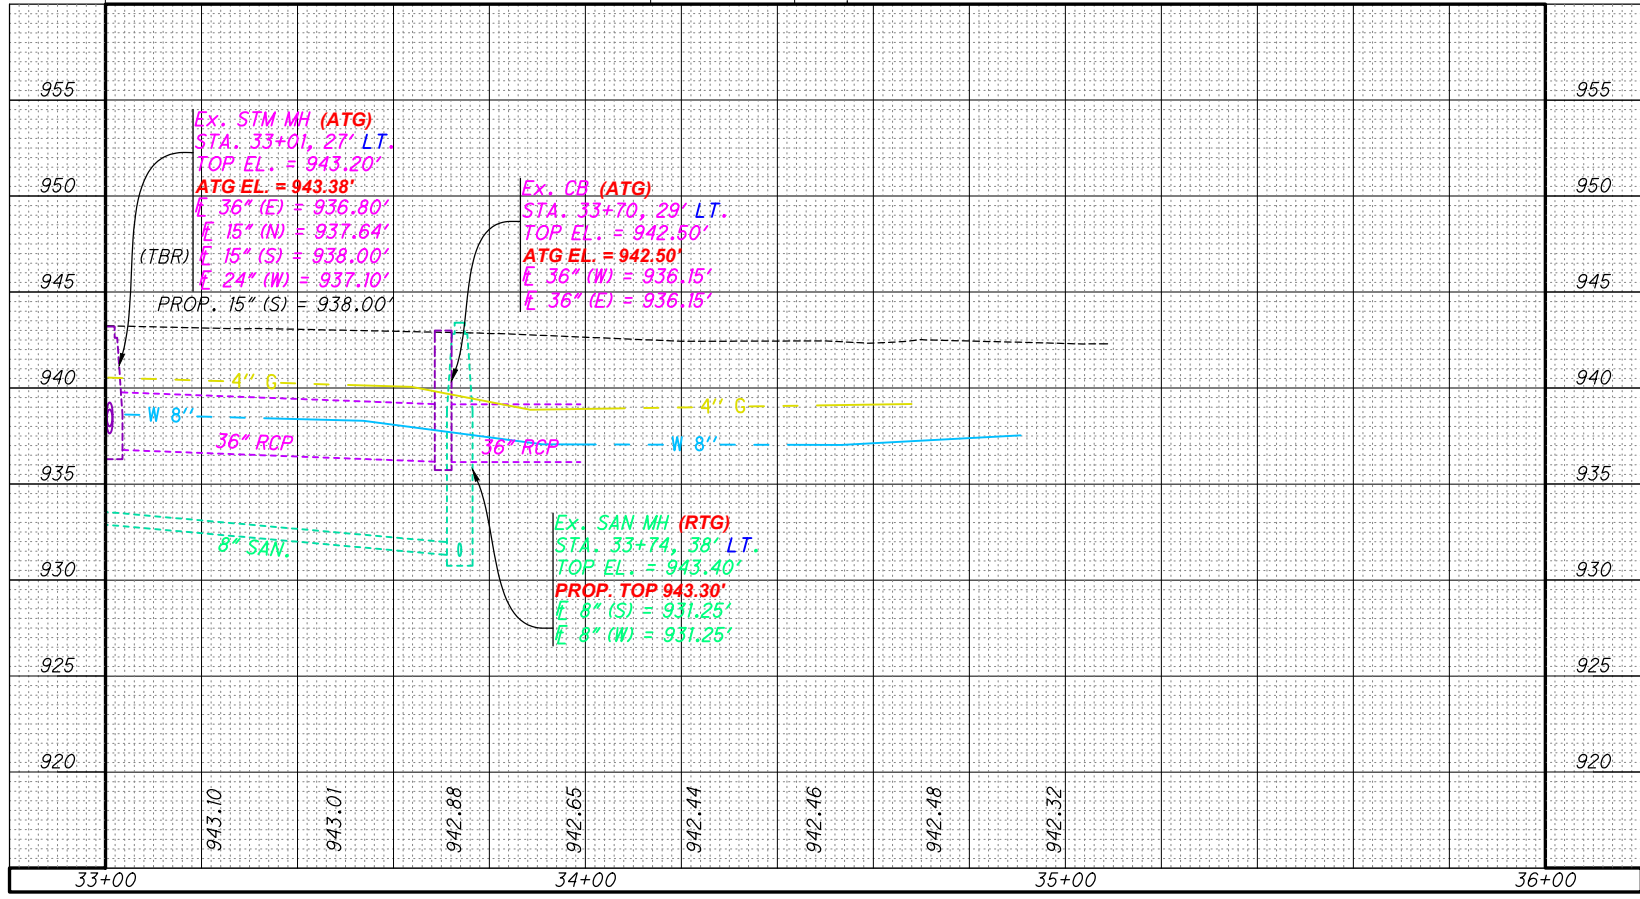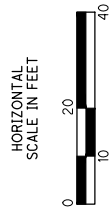

PLAN AND PROFILE - KINGSRIDGE DRIVE
STA. 33+00 TO STA. 36+00

DESIGN AGENCY



CHOICE ONE ENGINEERING

DESIGNER

IJW

REVIEWER

AJH 4-10-2026

PROJECT ID

120184

SHEET

P.26

TOTAL

67