

STATE OF OHIO
DEPARTMENT OF HIGHWAYS
SOMERSET-REDFIELD ROAD
PERRY COUNTY

OCTOBER 1933

NET LENGTH = 28,267 LIN. FT. OR 5.761 MILES

U. S. PUBLIC WORKS
PROJECT NO.

N.R.S. 781
REVISED

FED. RD. DIST. NO.	STATE	U.S.R.W. PROJECT	FISCAL YEAR
10	OHIO	NRS 781	1934



FINAL CONSTRUCTION PLANS PERRY COUNTY

FORCE ACCOUNT

SR-669

The Standard Specification of the State of Ohio, Department of Highways, together with the Supplemental Specifications for National Recovery Highway Funds Projects now in force will govern this improvement.

Construction on this project will be carried on in conformance with memo issued by Bureau of Public Roads under date of September 29th 1933 applicable only to N.R.S. projects.

Approved [Signature]
Date 10/31/33 Resident District Deputy Director

Approved B.H. + [Signature]
Date 11-4-33 Resident Division Deputy Director

Approved [Signature]
Date 12/31/33 Chief Engr. Bureau of Construction

Approved _____
Date _____ Chief Engr. Bureau of Maintenance

Approved [Signature]
Date _____ Chief Engr. & First Ass't. Director

Approved [Signature]
Date _____ Director of Highways


Recommended for Approval _____
Date _____ District Engineer
Bureau of Public Roads

Recommended for Approval _____
Date _____ Chief Engineer
Bureau of Public Roads

Approved _____
Date _____ Chief of Bureau

CONVENTIONAL SIGNS

- State Line
- County Line
- Township Line
- Section Line
- Property Line-notfenced
- Center Line
- City or Village Line
- Fence
- Telephone or Telegraph
- Steam Railroad
- Guard Rail
- Drain Pipe - new
- Drain Pipe - old

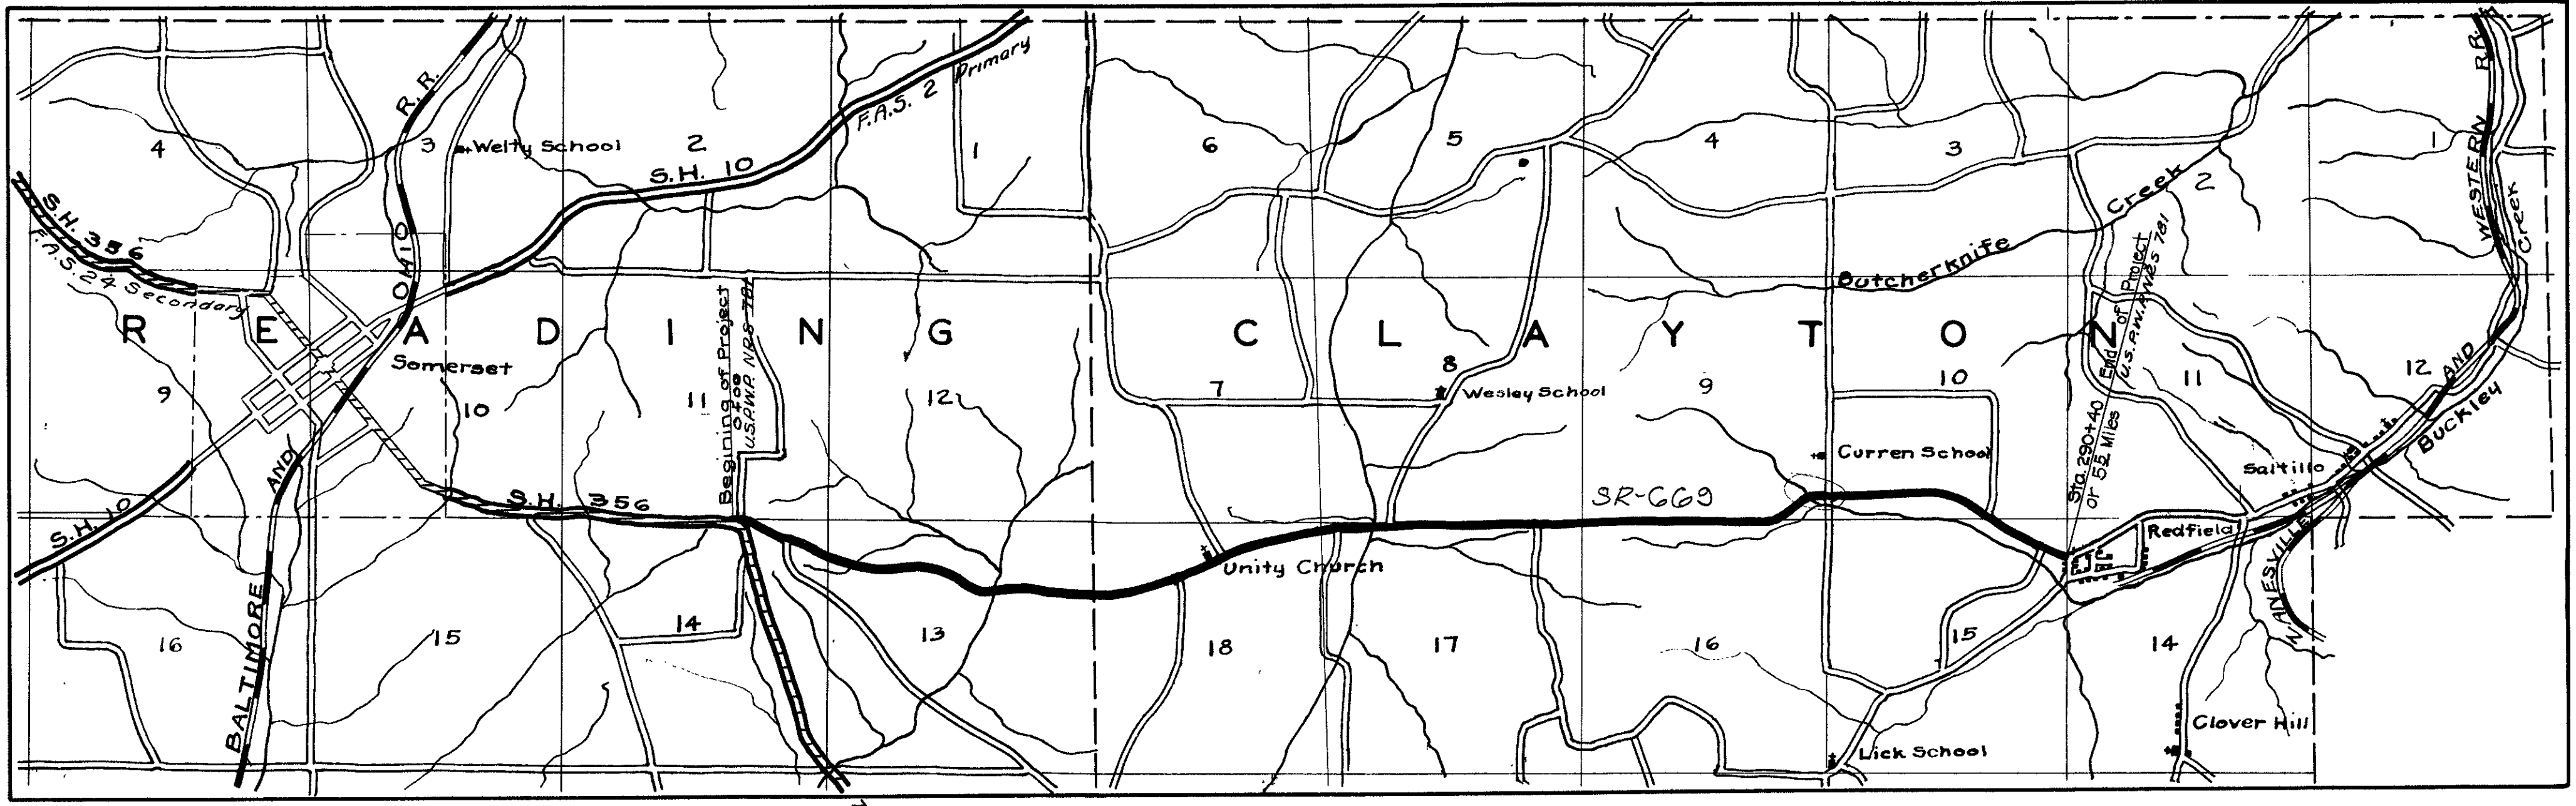

LOCATION PLAN

Scale: 2 inches = 1 mile

- Portion to be improved
- Federal Primary Routes
- Federal Secondary Routes
- County and Township Routes

LINE DATA

Beginning of Project = Sta. 0+00
Ending of Project = Sta. 29+40
Gross length = 29,040 Lin. Ft. or 5.500 Mi.
Deductions
for Structure 3C - Sta. 60+33.5 to 60+76.5 = 43 Lin. Ft.
" " 6C - Sta. 137+32 to 137+62 = 30 " "
Total deductions = 73 " "
Net length = 28,267 " " or 5.761 Mi.

We, the below signed members of the Board of County Commissioners for Perry County, hereby approve these plans and specifications and agree to furnish all right of way on National Recovery Secondary Highway Project # 781 in Reading and Clayton Townships, Perry County. We also agree to maintain the above road after completion of the improvement in a manner satisfactory to the Secretary of Agriculture or his authorized representatives and will make ample provision each year for such maintenance. Done under authority of Sec. 6906 et. seq. G.C. of Ohio.

Chairman

[Signature]
James J. Murray
[Signature]
Edw. S. Arpsain

Attest:

[Signature]
Oct. 25-1933 Clerk
Force Account - N.R.S. 781
Perry Co. - Somerset - Redfield Road
1934

FED. RD. DIST. NO.	STATE	U.S.P.N. PROJECT NO.	FISCAL YEAR
10	OHIO	781	1934

2
3

SOMERSET - REDFIELD ROAD
PERRY COUNTY

