


0 50 ft

$$(32 + 15 \times 18 + 12 + 12 + 14 \times 16 + 34) + (11 \times 18 + 50 + 32 + 15 \times 7) + (37 + 3 \times 16 + 16 \times 4 + 158)$$

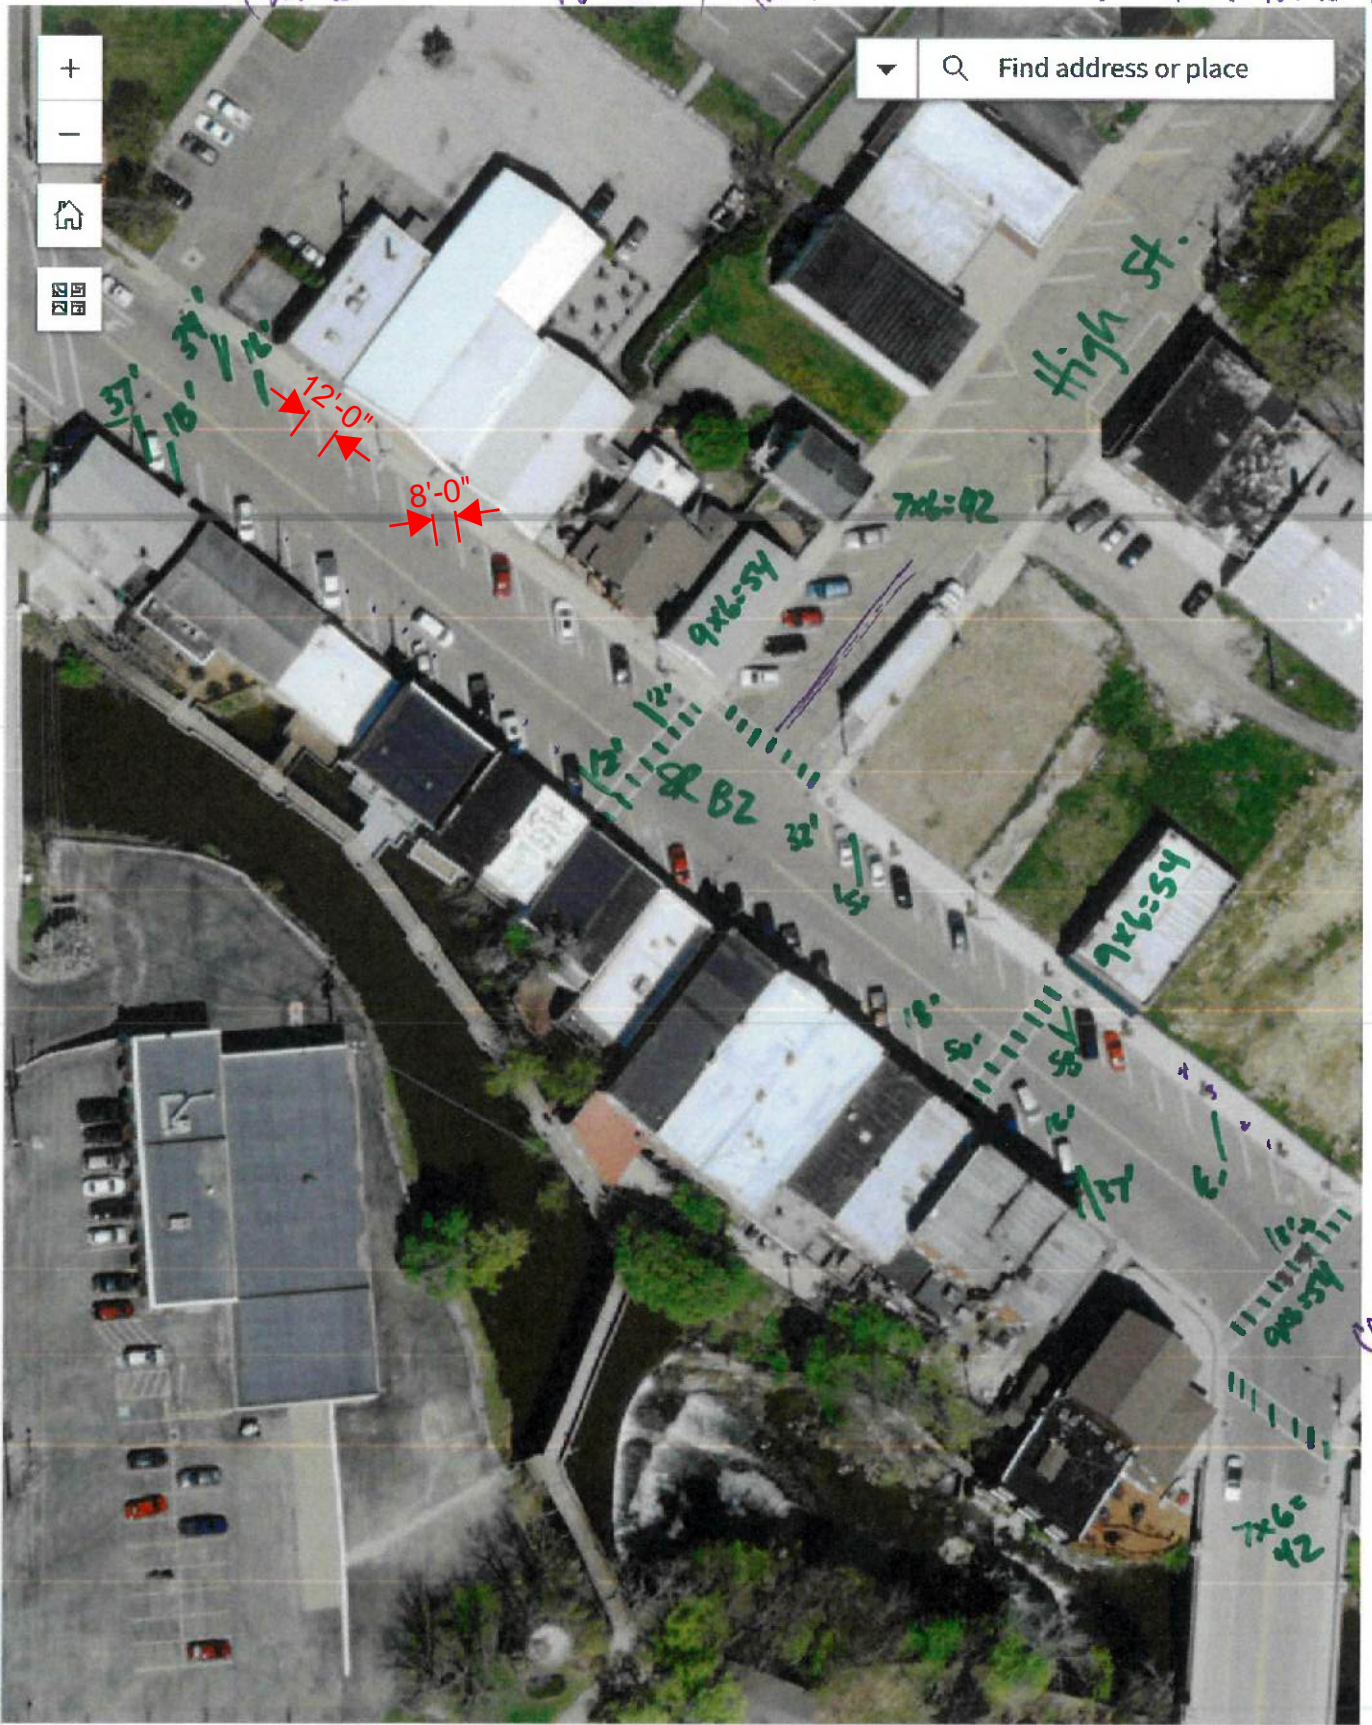

Randy Crites Super Int Garrettsville
 Mayor Rick Patrick 330-687-9637

330-527-2150

0 100 ft



0 50 ft