


I:\ProjectData\PRE\98567\_PRE-127-14.69\Design\Roadway\Sheets\98567\_G001.dgn Sheet 10/9/2020 9:32:59 AM whenson

SHEET NUM.											PART.		ITEM	ITEM EXT	GRAND TOTAL	UNIT	DESCRIPTION	SEE SHEET NO.
3	4	5	8	9	10	11					01/STR/PV	02/S<2/PV						
<b>ROADWAY</b>																		
						1,125					875	250	202	38000	1,125	FT	GUARDRAIL REMOVED	
						14					14		202	42001	14	EACH	ANCHOR ASSEMBLY REMOVED, TYPE A, AS PER PLAN	4
						6					2	4	202	42040	6	EACH	ANCHOR ASSEMBLY REMOVED, TYPE T	
						4					4		202	47000	4	EACH	BRIDGE TERMINAL ASSEMBLY REMOVED	
						184					184		517	75600	184	FT	DEEP BEAM BRIDGE RETROFIT RAILING	
						875					625	250	606	15100	875	FT	GUARDRAIL, TYPE MGS WITH LONG POSTS	
						14					14		606	26150	14	EACH	ANCHOR ASSEMBLY, MGS TYPE E, NCHRP 350 OR MASH 2016	
						6					2	4	606	26550	6	EACH	ANCHOR ASSEMBLY, MGS TYPE T	
						4					4		606	35141	4	EACH	BRIDGE TERMINAL ASSEMBLY, TYPE 4, AS PER PLAN	4
<b>PAVEMENT</b>																		
			17								15.5	1.5	209	72050	17	MILE	PREPARING SUBGRADE FOR SHOULDER PAVING	
250											220	30	253	02000	250	CY	PAVEMENT REPAIR	
			147,337								134,106	13,231	254	01000	147,337	SY	PAVEMENT PLANING, ASPHALT CONCRETE, 3"	
			31								31		254	01000	31	SY	PAVEMENT PLANING, ASPHALT CONCRETE, 1.25"	
			1,476								1,343	133	254	01600	1,476	SY	PATCHING PLANED SURFACE	
			22,106								20,121	1,985	407	20000	22,106	GAL	NON-TRACKING TACK COAT	
			5,294								4,818	476	441	50000	5,294	CY	ASPHALT CONCRETE SURFACE COURSE, TYPE 1, (448), PG64-22	
			7,163								6,519	644	441	50300	7,163	CY	ASPHALT CONCRETE INTERMEDIATE COURSE, TYPE 2, (448)	
			9,068								8,310	758	441	00100	9,068	CY	ANTI-SEGREGATION EQUIPMENT	
4											4		611	99654	4	EACH	MANHOLE ADJUSTED TO GRADE	
			502								457	45	617	10100	502	CY	COMPACTED AGGREGATE	
			10								9	1	617	25000	10	MGAL	WATER	
			17								15.5	1.5	618	41000	17	MILE	RUMBLE STRIPES, EDGE LINE (ASPHALT CONCRETE)	
			2								1.5	0.5	618	43000	2	MILE	RUMBLE STRIPES, CENTER LINE (ASPHALT CONCRETE)	
<b>TRAFFIC CONTROL</b>																		
604											604		621	00100	604	EACH	RPM	
604											604		621	54000	604	EACH	RAISED PAVEMENT MARKER REMOVED	
						21					16	5	626	00110	21	EACH	BARRIER REFLECTOR, TYPE 2, BIDIRECTIONAL	
						78					78		630	03100	78	FT	GROUND MOUNTED SUPPORT, NO. 3 POST	
						34.75					34.75		630	80100	34.75	SF	SIGN, FLAT SHEET	
						4					4		630	84900	4	EACH	REMOVAL OF GROUND MOUNTED SIGN AND DISPOSAL	
						1					1		630	86002	1	EACH	REMOVAL OF GROUND MOUNTED POST SUPPORT AND DISPOSAL	
162											162		642	30000	162	FT	REMOVAL OF PAVEMENT MARKING	
4											4		642	30020	4	EACH	REMOVAL OF PAVEMENT MARKING	
0.14											0.14		642	30030	0.14	MILE	REMOVAL OF PAVEMENT MARKING	
						224					224		644	00404	224	FT	CHANNELIZING LINE, 12"	
						47					47		644	00500	47	FT	STOP LINE	
						301					301		644	00700	301	FT	TRANSVERSE/DIAGONAL LINE	
						1.42					1.42		646	10010	1.42	MILE	EDGE LINE, 6"	
						0.98					0.98		646	10110	0.98	MILE	LANE LINE, 6"	
						1.11					1.11		646	10200	1.11	MILE	CENTER LINE	
						1,405					1,405		646	10310	1,405	FT	CHANNELIZING LINE, 12"	
						1,161					1,161		646	10600	1,161	FT	TRANSVERSE/DIAGONAL LINE	
						228					228		646	10800	228	SF	ISLAND MARKING	
						11					11		646	20300	11	EACH	LANE ARROW	
						18.17					16.76	1.41	648	00104	18.17	MILE	EDGE LINE, 6"	
						8.52					7.77	0.75	648	00300	8.52	MILE	CENTER LINE	
<b>STRUCTURE REPAIR (6802680)</b>																		
	37.56										37.56		846	00110	37.56	CF	POLYMER MODIFIED ASPHALT EXPANSION JOINT SYSTEM	
<b>MAINTENANCE OF TRAFFIC</b>																		
		0.98									0.98		614	20110	0.98	MILE	WORK ZONE LANE LINE, CLASS I, 6", 642 PAINT	
		9.63									8.88	0.75	614	21100	9.63	MILE	WORK ZONE CENTER LINE, CLASS I, 642 PAINT	
		19.59									18.18	1.41	614	22110	19.59	MILE	WORK ZONE EDGE LINE, CLASS I, 6", 642 PAINT	
		1,629									1,629		614	23210	1,629	FT	WORK ZONE CHANNELIZING LINE, CLASS I, 12", 642 PAINT	

GENERAL SUMMARY

PRE-US 127-14.69

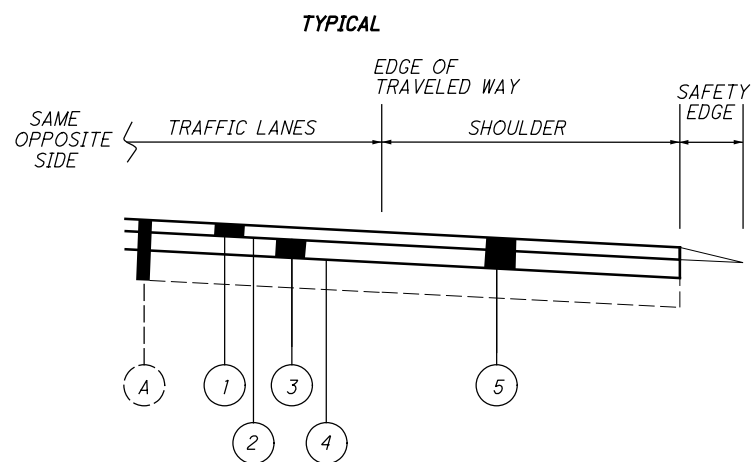

- A EXISTING ASPHALT CONCRETE PAVEMENT
- 1 ITEM 441 - 1.25" ASPHALT CONCRETE SURFACE COURSE, TYPE 1 (448), PG 64-22
- 2 ITEM 407 - NON-TRACKING TACK COAT
- 3 ITEM 441 - 1.75" ASPHALT CONCRETE INTERMEDIATE COURSE, TYPE 2 (448)
- 4 ITEM 407 - NON-TRACKING TACK COAT
- 5 ITEM 254 - 3.00" PAVEMENT PLANING, ASPHALT CONCRETE

I:\ProjectData\PRE\98567\_PRE-127-14.69\Design\Roadway\Sheets\98567.dgn Sheet 7/16/2020 3:05:35 PM scottiere

PLAN SPLIT	COUNTY-ROUTE	LOG POINT (MILE)		LENGTH		PAVEMENT AREA (MICRO-STATION GENERATED AREA)	PAVEMENT AREA, NO SHOULDERS (MICRO-STATION GENERATED AREA)	PAVEMENT AREA	PAVEMENT AREA (NO SHOULDERS FOR ANTI-SEGRIGATION)	209 PREPARING SUBGRADE FOR SHOULDER PAVING	254 PAVEMENT PLANING ASPHALT CONCRETE				407 NON TRACKING TACK COAT @ 0.06 GAL/SQ YD	407 NON TRACKING TACK COAT @ 0.09 GAL/SQ YD	441 ASPHALT CONCRETE SURFACE COURSE, TYPE 1, (448), PG 64-22				441 ASPHALT CONCRETE INTERMEDIATE COURSE, TYPE 2 (448)		617 ANTI-SEGREGATION EQUIPMENT		617 COMPACTED AGGREGATE TYPE A, 3" MIN. DEPTH	WATER @ 20 GAL/CU YD	618 RUMBLE STRIPES, EDGE LINE (ASPHALT CONCRETE)	618 RUMBLE STRIPES, CENTER LINE (ASPHALT CONCRETE)	NOTES					
		FROM	TO	MILES	FT						SQ FT	SQ FT	SQ YD	SQ YD			MILES	INCHES	SQ YD	INCHES	SQ YD	SQ YD	INCHES	CU YD						CU YD	INCHES	CU YD	INCHES	CU YD
02/SK2/PV	PRE-127	14.71	15.46	0.75	3960	119078	81791	13231	9088	1.50	3.00	13230.9		133	793.9	1190.8	1.25	459.4	15.9	1.75	643.2	3.00	757.3	45.2	0.90	1.50	0.49	CENTER LINE RUMBLE STRIPES FROM SLM 14.91 to 15.41						
01/STR/PV	PRE-127	15.46	19.03	3.57	18850	560685	416064	62298	46229	7.14	3.00	62298.3		623	3737.9	5606.9	1.25	2163.1	75.6	1.75	3028.4	3.00	3852.4	215.3	4.31	7.14	0.80	CENTER LINE RUMBLE STRIPES FROM SLM 15.96 to 16.74						
01/STR/PV	PRE-127	17.17	17.19	0.02	106	277	246	31	27			1.25	30.8	1	1.8	2.8	1.25	1.1				1.25	0.9					ASPHALT BRIDGE						
01/STR/PV	PRE-127	19.72	23.73	4.01	21173	646270	481356	71808	53484	8.02	3.00	71807.8		719	4308.5	6462.7	1.25	2493.3	84.9	1.75	3490.7	3.00	4457.0	241.9	4.84	8.02	0.33	CENTER LINE RUMBLE STRIPES FROM SLM 19.76 to 20.08						
										17		147337		31	1476	22106		5294		7163		9068	502	10	17.00	2.00								
TOTALS CARRIED TO GENERAL SUMMARY																																		