

STATE OF OHIO
DEPARTMENT OF TRANSPORTATION

RIC-SMOOTH-FY2021

CITY OF SHELBY
VILLAGE OF PLYMOUTH
FRANKLIN TOWNSHIP
JACKSON TOWNSHIP
PLYMOUTH TOWNSHIP
RICHLAND COUNTY

PROJECT DESCRIPTION

THIS PROJECT INVOLVES THE RESURFACING OF S.R. 61 AND S.R. 96 IN RICHLAND COUNTY WITH PLANING AND SMOOTH SEAL. THE PROJECT ALSO INCLUDES PAVEMENT REPAIRS, PAVEMENT MARKINGS, AND MINOR STRUCTURE MAINTENANCE CONSISTING OF CONCRETE DECK PATCHING AND RAILING UPGRADES.

EARTH DISTURBED AREAS

PROJECT EARTH DISTURBED AREA: N/A ACRES (MAINTENANCE PROJECT)
ESTIMATED CONTRACTOR EARTH DISTURBED AREA: N/A ACRES (MAINTENANCE PROJECT)
NOTICE OF INTENT EARTH DISTURBED AREA: N/A ACRES (MAINTENANCE PROJECT)


2019 SPECIFICATIONS

THE STANDARD SPECIFICATIONS OF THE STATE OF OHIO, DEPARTMENT OF TRANSPORTATION, INCLUDING SUPPLEMENTAL SPECIFICATIONS LISTED IN THE PLANS AND CHANGES LISTED IN THE PROPOSAL SHALL GOVERN THIS IMPROVEMENT.

I HEREBY APPROVE THESE PLANS AND DECLARE THAT THE MAKING OF THIS IMPROVEMENT WILL NOT REQUIRE THE CLOSING TO TRAFFIC OF THE HIGHWAY AND THAT PROVISIONS FOR THE MAINTENANCE AND SAFETY OF TRAFFIC WILL BE AS SET FORTH ON THE PLANS AND ESTIMATES.

APPROVED _____
DATE _____ DISTRICT DEPUTY DIRECTOR

APPROVED _____
DATE _____ DIRECTOR DEPARTMENT OF TRANSPORTATION

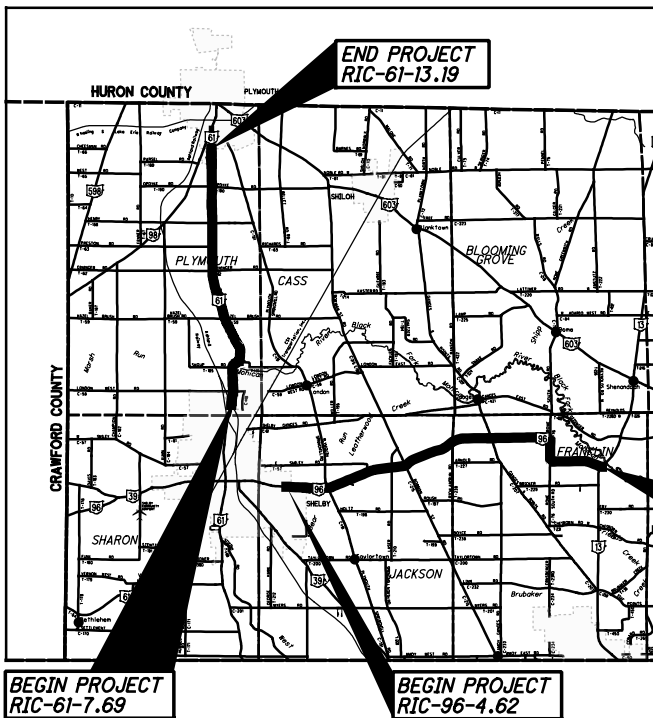

LOCATION MAP

LATITUDE: 40° 52' 56" N LONGITUDE: 82° 39' 44" W



PORTION TO BE IMPROVED	—————
INTERSTATE HIGHWAY	—————
FEDERAL ROUTES	—————
STATE ROUTES	—————
COUNTY & TOWNSHIP ROADS	—————
OTHER ROADS	—————

DESIGN DESIGNATION

SEE SHEET 2

DESIGN EXCEPTIONS

NONE

INDEX OF SHEETS:

TITLE SHEET	1
SCHEMATIC PLAN	2
TYPICAL SECTIONS	3-4
GENERAL NOTES	5-8
GENERAL SUMMARY	9-10
PAVEMENT AND SHOULDER DATA SHEET	11
RAISED PAVEMENT MARKERS	12
AUXILIARY AND LONG LINE MARKINGS	13
STRUCTURE SUMMARY SHEET	14
PAVEMENT DETAILS	15
STRUCTURE DETAILS	
RIC-61-0860	16
RIC-96-0562	17
RIC-96-0760	18
RIC-96-0807	19
RIC-96-1149	20
RIC-96-1182	21

ENGINEERS SEAL:



SIGNED: _____

DATE: _____

STANDARD CONSTRUCTION DRAWINGS						SUPPLEMENTAL SPECIFICATIONS	SPECIAL PROVISIONS
BP-3.1	01/17/20	TC-41.20	10/18/13	DBR-3-11	7/15/11	800-2020 01/17/20	
BP-3.2	1/18/19	TC-42.10	10/18/13			832 10/19/18	
		TC-42.20	10/18/13			897 1/16/15	
MT-96.11	1/17/20	TC-52.10	10/18/13			872 4/17/20	
MT-96.20	7/15/16	TC-52.20	7/20/18			874 4/17/20	
MT-96.26	1/18/19	TC-64.10	1/17/20			875 1/18/19	
MT-97.10	4/19/19	TC-65.10	1/17/14				
MT-97.11	1/20/17	TC-65.11	7/21/17				
MT-99.20	4/19/19	TC-71.10	1/19/18				
MT-101.90	7/21/17						
MT-105.10	1/17/20						

PLANS PREPARED BY:
 OHIO DEPARTMENT OF TRANSPORTATION
DISTRICT THREE ENGINEERING

UNDERGROUND UTILITIES
Contact Two Working Days Before You Dig

OHIO811: 8-1-1, or 1-800-362-2764
(Non-members must be called directly)

FEDERAL PROJECT NO. E170091
PID NO. 101431
CONSTRUCTION PROJECT NO. NONE
RAILROAD INVOLVEMENT NONE
RIC-SMOOTH -FY2021
1/21

