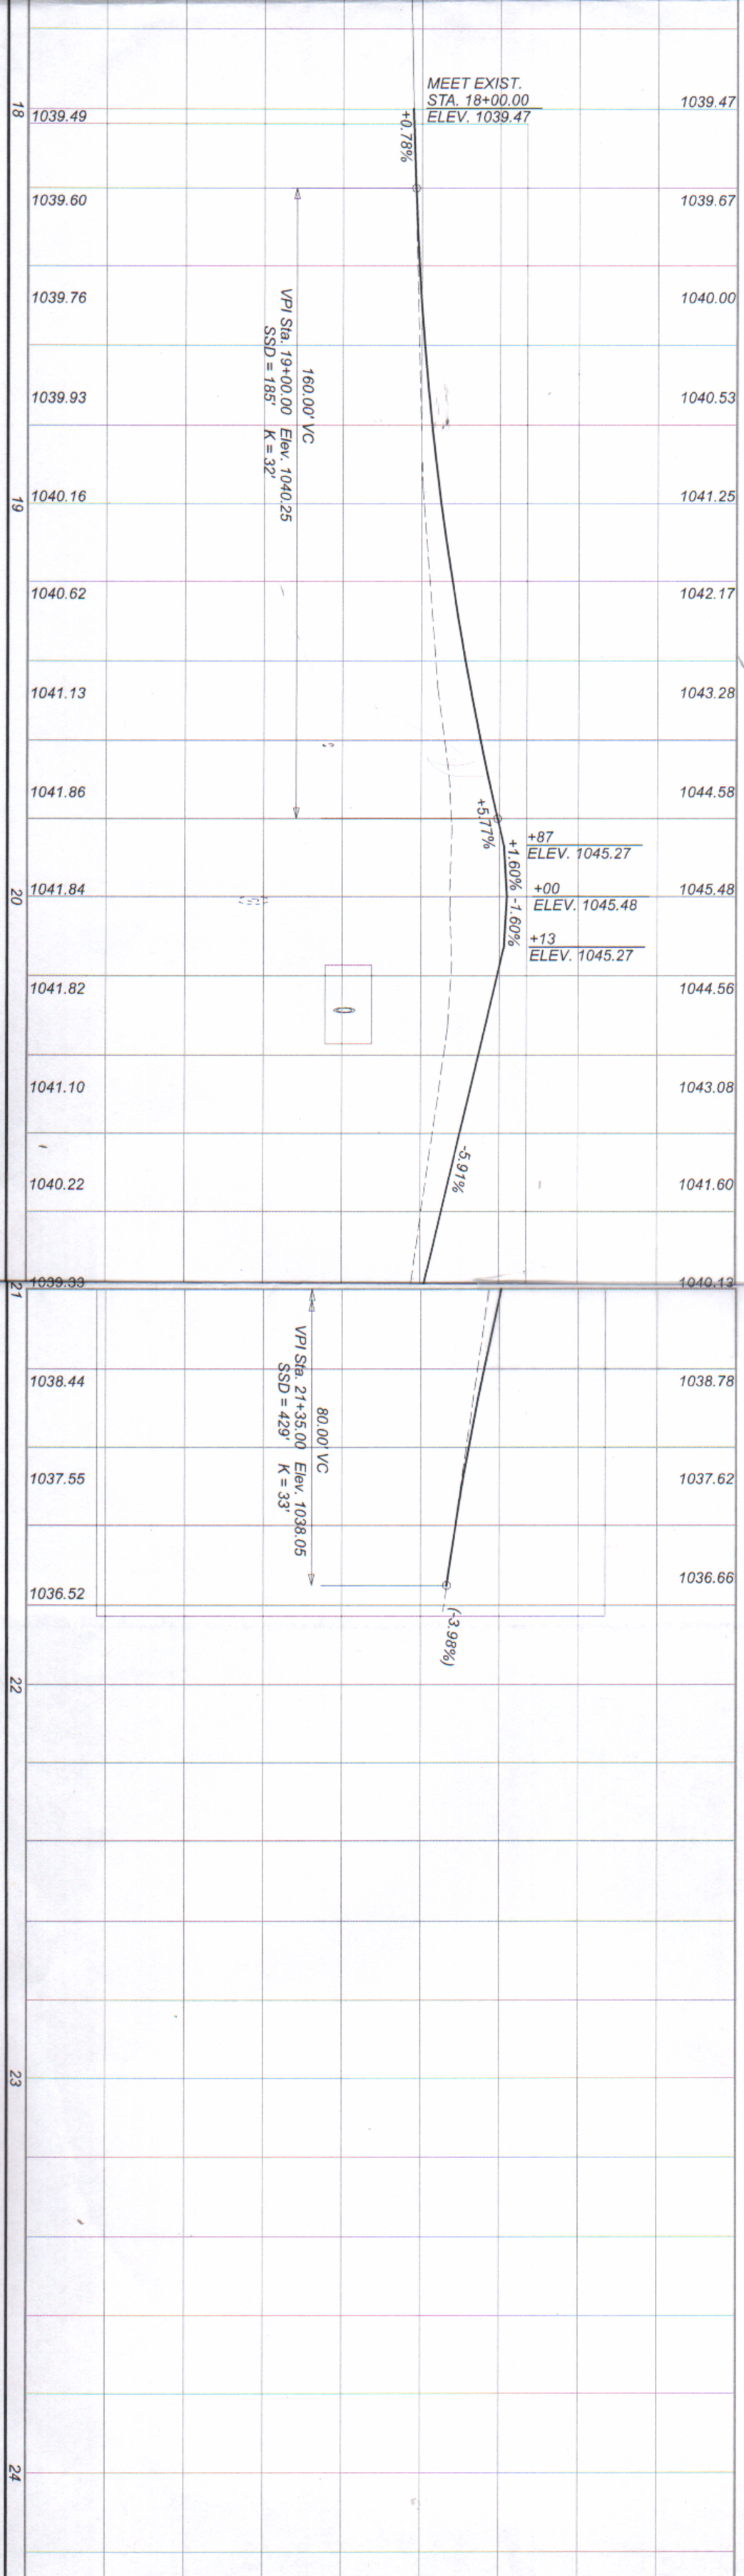
18
19
20
21
22
23
24
MEET EXIST.
STA. 18+00.00
ELEV. 1039.47
1039.49
1039.47
1039.60
1039.67
1039.76
1040.00
1039.93
1040.53
1040.16
1041.25
1040.62
1042.17
1041.13
1043.28
1041.86
1044.58
+0.78%
160.00' VC
VPI Sta. 19+00.00 Elev. 1040.25
SSD = 185' K = 32'
+87
ELEV. 1045.27
+00
ELEV. 1045.48
+13
ELEV. 1045.27
+5.77%
+1.60%
-1.60%
1041.84
1045.48
1041.82
1044.56
1041.10
1043.08
-5.91%
1040.22
1041.60
1039.33
1040.13
1038.44
1038.78
80.00' VC
VPI Sta. 21+35.00 Elev. 1038.05
SSD = 429' K = 33'
1037.55
1037.62
1036.52
1036.66
(-3.98%)

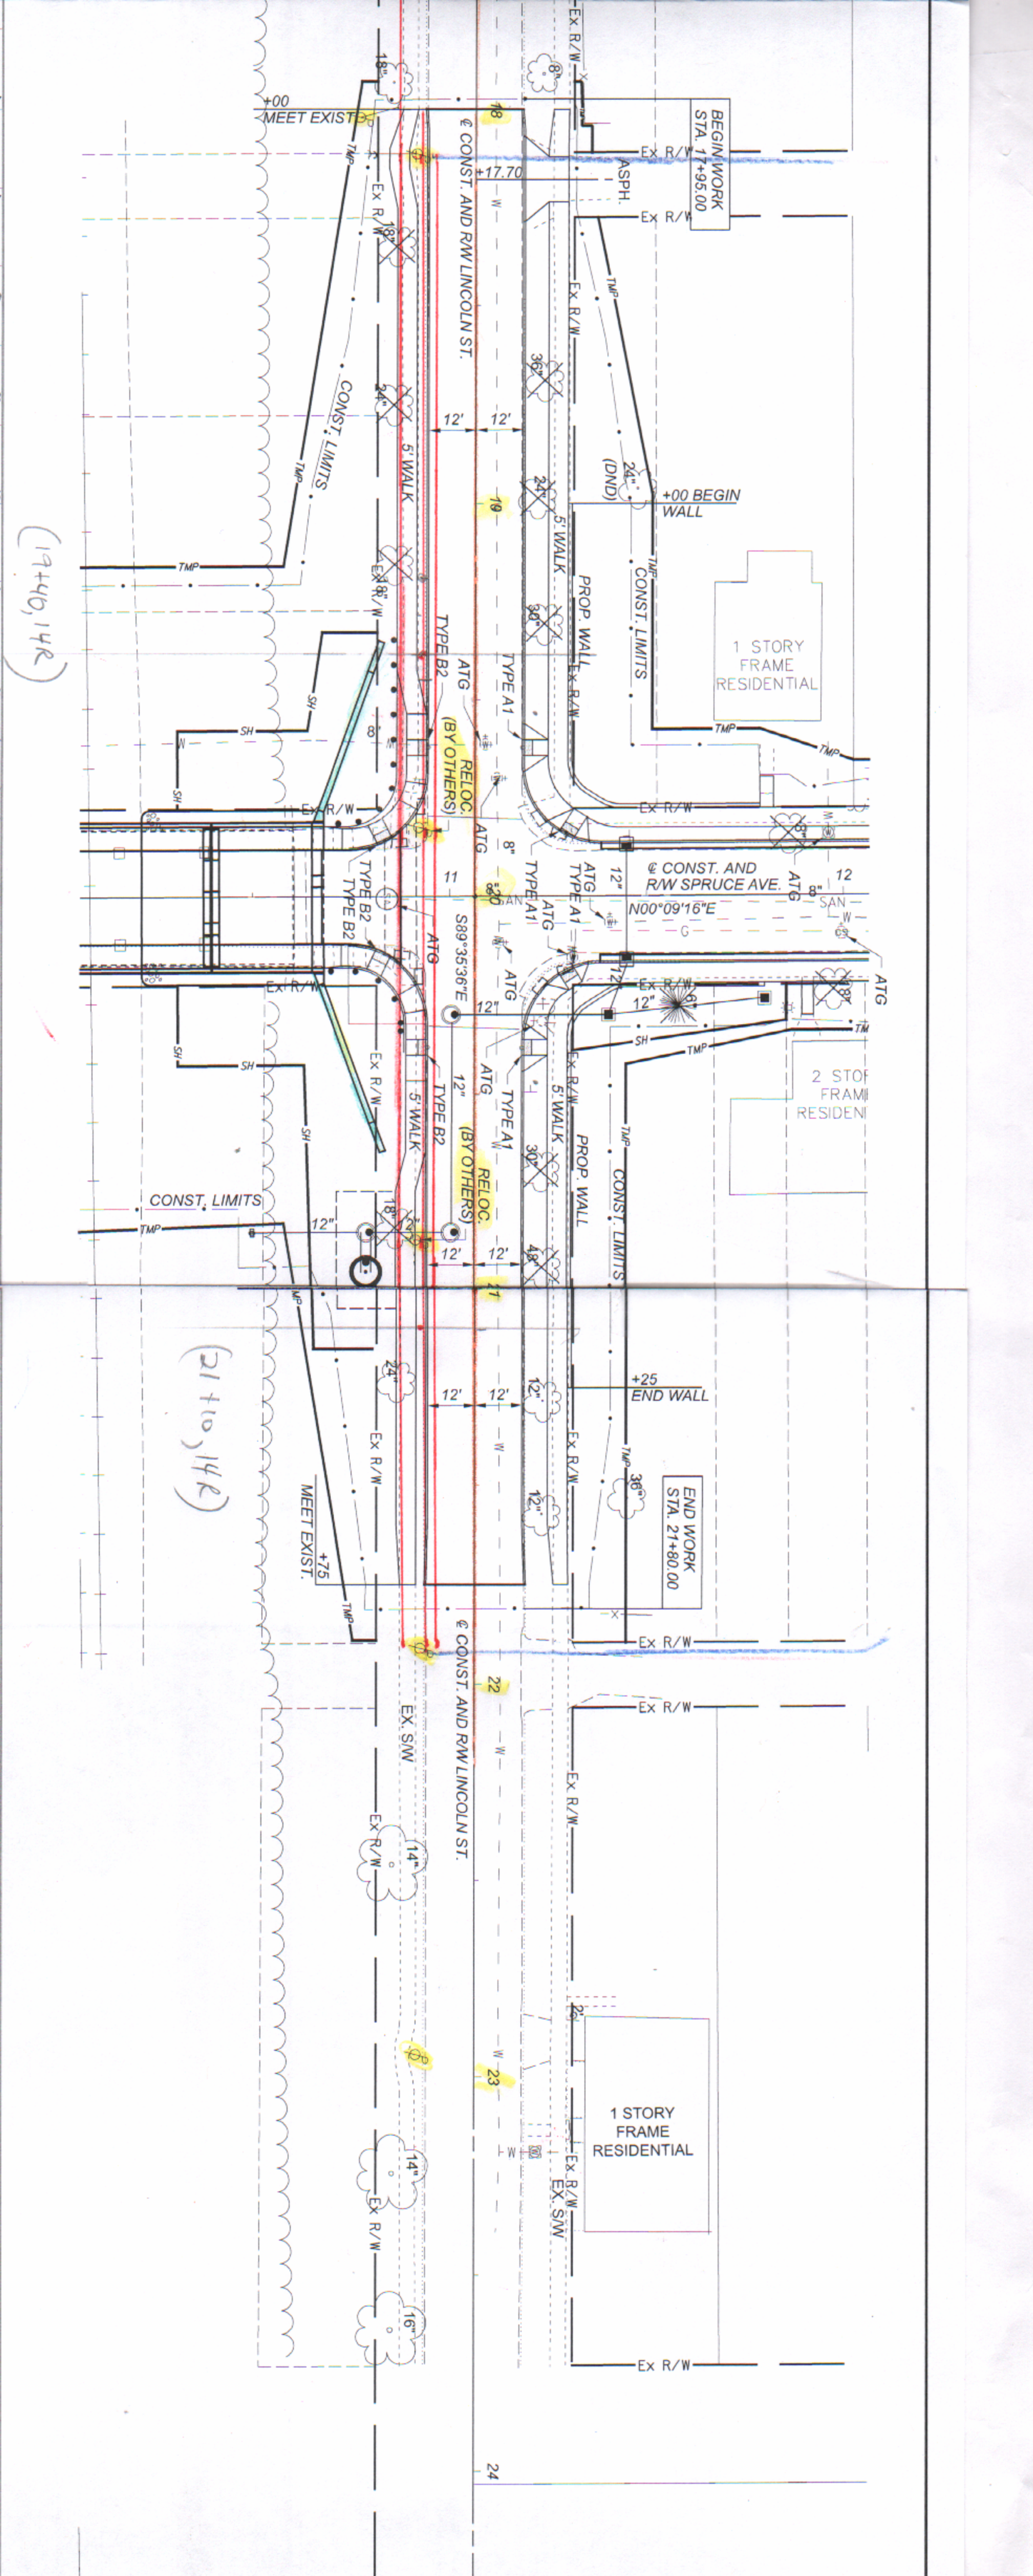
+00
MEET EXIST.
BEGIN WORK
STA. 17+95.00
Ex R/W
ASPH.
℄ CONST. AND R/W LINCOLN ST.
+17.70
CONST. LIMITS
5' WALK
12'
+00 BEGIN
WALL
(DND)
PROP. WALL
1 STORY
FRAME
RESIDENTIAL
TYPE B2
TYPE A1
ATG
RELOC.
(BY OTHERS)
℄ CONST. AND
R/W SPRUCE AVE.
N00°09'16"E
S89°35'36"E
2 STOR
FRAMI
RESIDEN
+25
END WALL
END WORK
STA. 21+80.00
+75
MEET EXIST.
EX. S/W
℄ CONST. AND R/W LINCOLN ST.