



Erik Ganger
Construction Coordinator

2500 Newmark Drive Miamisburg, OH 45342 | (866) 552-3536 | LJBinc.com

O 937.396.8651
M 419.612.7490
E ERIK.GANGER@charter.com

3691 Turner Rd
Dayton, OH 45415

Michael Dunn
Charter Communications
3691 Turner Road
Dayton, Ohio, 45415

Re: Shelby County
SHE-SPRUC-02.27
PID No. 114201

Replacement of Bridge No. SHE-SPRUC-0227 carrying Spruce Avenue over CSX Railroad in the City of Sidney, Ohio. The rehabilitation includes complete bridge replacement, associated approach roadway work on Spruce Avenue and raising the intersections of Lincoln Street to the north and Greenacre Street to the south.

Dear Michael:


Enclosed please find one copy of the Stage 2 (65%) plans, for the above captioned project. **We would like you to review these prints and mark the locations of your facilities on them. This is so we can determine if our proposed project location has any impact on your utility facilities in the area. We would appreciate any of your comments that would help us in the development of this project.** Please complete your review and return the plan with your existing facilities, along with any comments, to us for design consideration by June 30, 2023.

If your facilities are buried, please show the approximate location and depth. If your facilities are aerial show the direction they run from pole to pole, along with the pole numbers, and the offsets from centerline.

Thank you for your cooperation, and if you should have any questions, please give me a call at (937) 259-5192 or e-mail me at dspringer@ljbinc.com.

Respectfully,

STATION/OFFSET TABLE			
P1	11:45, 48	31.50, RT	6
A	18:40, 48	31.50, RT	P1
B	10:40, 89	25.00, LT	H
C	17:43, 00	25.00, LT	J
D	17:43, 00	25.00, LT	J
E	18:40, 10	26.96, LT	K
F	18:40, 08	29.50, LT	

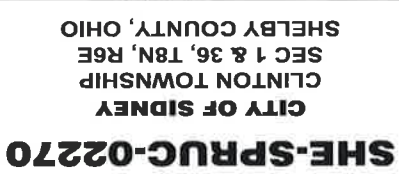

SHELBY COUNTY, OHIO



STA. 17+00 to STA. 22+00

CHOICE ONE ENGINEERING
DESIGN AGENCY

ALL STATIONING IS FROM CENTERLINE OF
RIGHT-OF-WAY UNLESS OTHERWISE NOTED.

CURVE #1
P.I. STA. 6+80.06
Δ = 22° 00' 00" (RT)
DC = 63° 39' 43"
R = 90.00'
L = 17.49'
CH = 34.35'
C.B. = N112°15'9" E

