


Proposed Relocation Plan by AEP STA-30-32.63, PID 117923

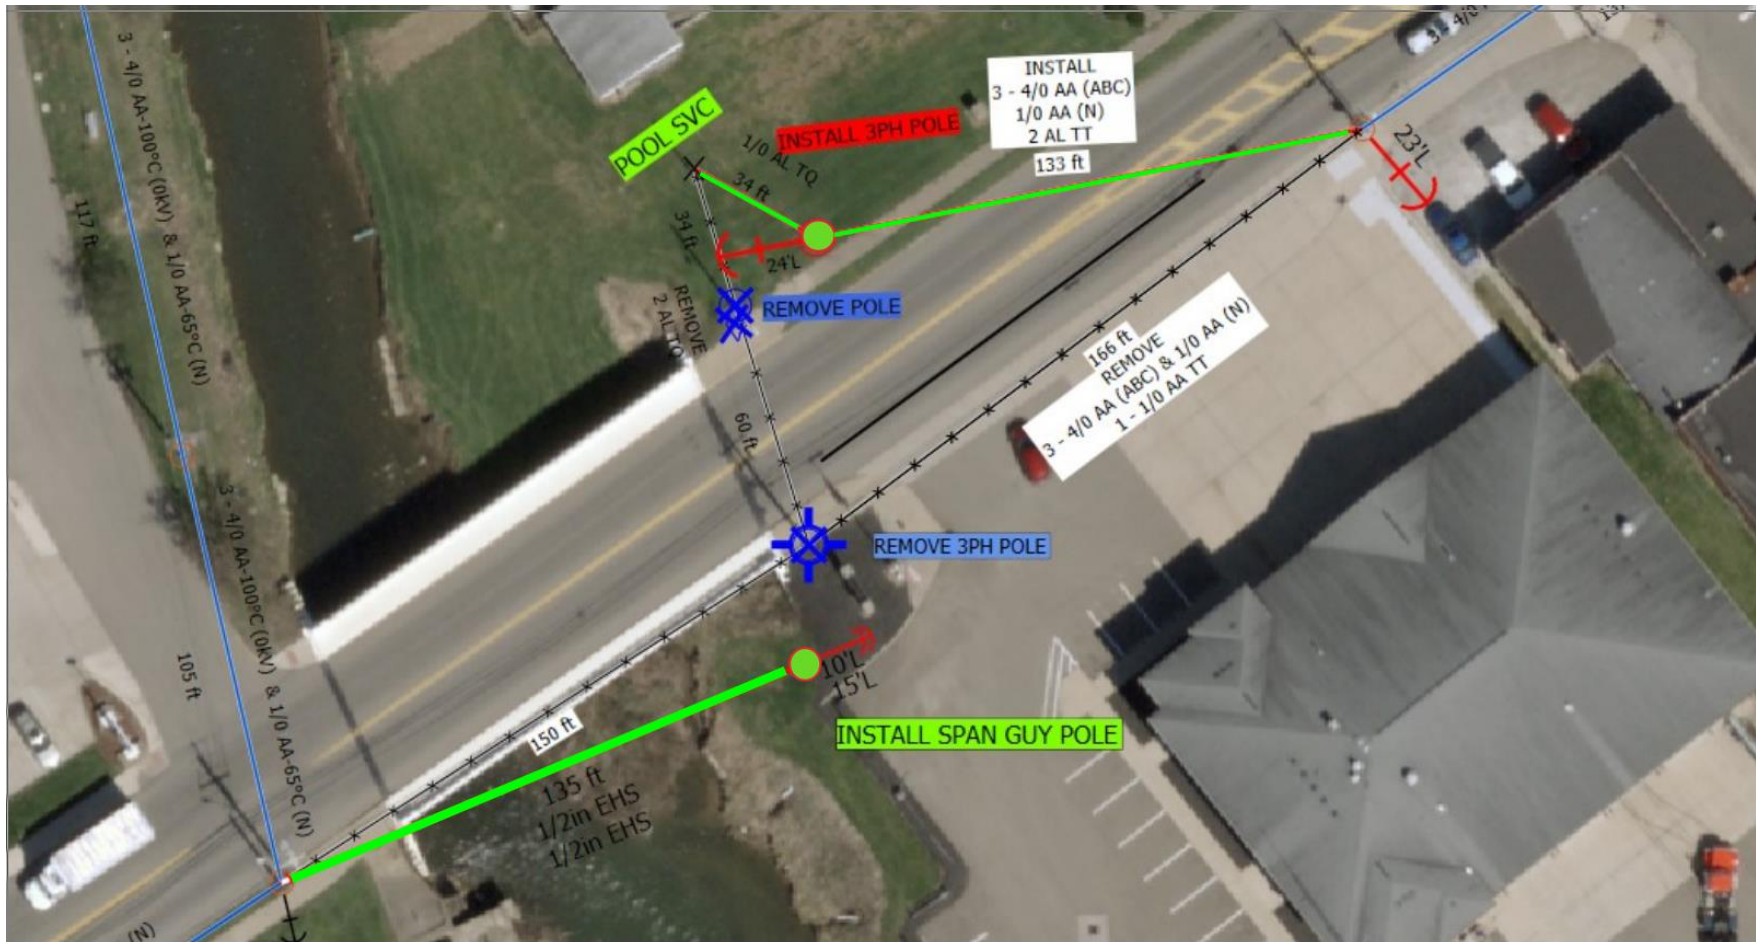

Legend

- Black lines with X's are Existing lines which will be removed
- Red Arrows are down guys wires
- The Green line South of the bridge is a guy wire attached to a new pole with a down guy to balance tension on the existing pole West of the bridge
- The Green line running across Route 30 is a new 3 phase primary
- The Green line North of Route 30 is the service line to the pool