



OHIO DEPARTMENT OF TRANSPORTATION
PLANNING & ENGINEERING DEPARTMENT, DISTRICT 4



Project _____
Desc Bridge Repair Calculations

Calc By CLG Date 2/13/24
Chk By MDA Date 3/22/24
PID/PROJ 113086

SUM-277-2.341 PARTIAL DEPTH PAVEMENT REPAIRS:

Knowns:

1. Scope states to repair area at bridge approach slab termination joint @ a 4" depth.
2. Referring to the existing bridge photos: The repair length is 4 FT +/- by width of roadway.
3. Referring to existing plans, the existing approach width is 67'-0".

Calculation:

$$\left[(4' \times 67') \cdot (2 \text{ sides}) \right] \div 9 \text{ SY} \approx \underline{\underline{60 \text{ SY}}}$$



OHIO DEPARTMENT OF TRANSPORTATION
 PLANNING & ENGINEERING DEPARTMENT, DISTRICT 4



Project _____
 Desc Bridge Repair Calculations

Calc By CLG Date 2/13/24
 Chk By MTA Date 3/22/24
 PID/PROJ 113086


SUM-76-6.474R BACKWALL REPAIR:

Knowns:

1. Repair depth shall be 12" from the top of the backwall at the forward and rear abutments.
2. Repair length is the total length of the abutments.

Calculations:

Abutment Length = $75'-8\frac{1}{4}" = 75.69'$ (forward and rear)

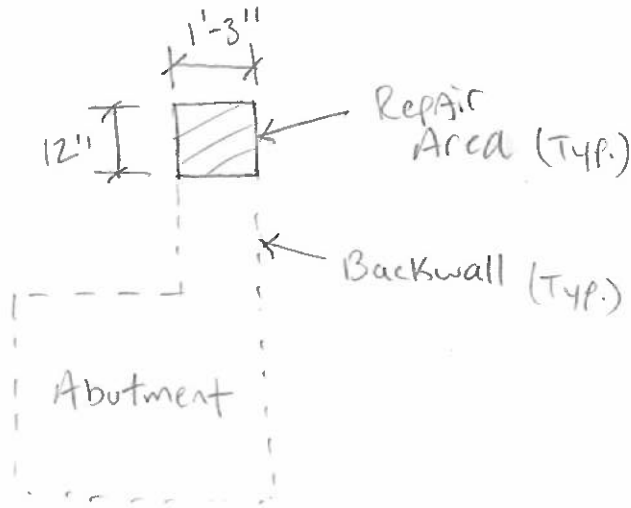

Repair Cross sectional Area =
 $1.25' \times 1' = 1.25 \text{ ft}^2$

Volume of Repair =

$$\frac{1.25 \text{ ft}^2 \times 75.69 \text{ ft}}{27 \text{ CY}} \times 2 \text{ Abutments}$$

= 7 CY



OHIO DEPARTMENT OF TRANSPORTATION
 PLANNING & ENGINEERING DEPARTMENT, DISTRICT 4



Project _____
 Desc Bridge Repair Calculations

Calc By CLG Date 2/13/24
 Chk By MSA Date 3/22/24
 PID/PROJ 1130810


SUM-76-6.843 BACKWALL REPAIR:

Knowns:

1. Repair depth shall be 12" from the top of the backwall at the forward and rear abutments.
2. Repair length is under lanes only (both directions of travel), (total of 7 lanes).

Calculations:

Repair Length along Abutments = $\overset{NB}{\text{~~~~~}} + \overset{SB}{\text{~~~~~}} = 48' + 36' = 84'$

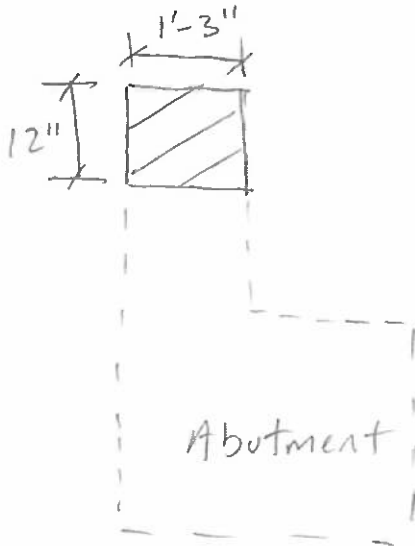

Repair Cross Sectional Area =

$1.25' \times 1' = 1.25 \text{ ft}^2$

Volume of Repair =

$\frac{1.25 \text{ ft}^2 \times 84 \text{ ft}}{27 \text{ cy}} \times 2 \text{ Abutments}$

= 7.78

≈ 8 CY



OHIO DEPARTMENT OF TRANSPORTATION
 PLANNING & ENGINEERING DEPARTMENT, DISTRICT 4



Project _____
 Desc Bridge Repair Calculations

Calc By CLG Date 2/13/24
 Chk By MJA Date 3/22/24
 PID/PROJ 113086


SUM-76-6.999 BACKWALL REPAIR:

Knowns:

1. Repair depth shall be 12" from the top of the backwall at the forward and rear abutments.
2. Repair length is under lanes only (both directions of travel), (total of 7 lanes).

Calculations:

$$\text{Repair Length along Abutments} = \overset{\text{NB}}{48'} + \overset{\text{SB}}{36'} = 84'$$

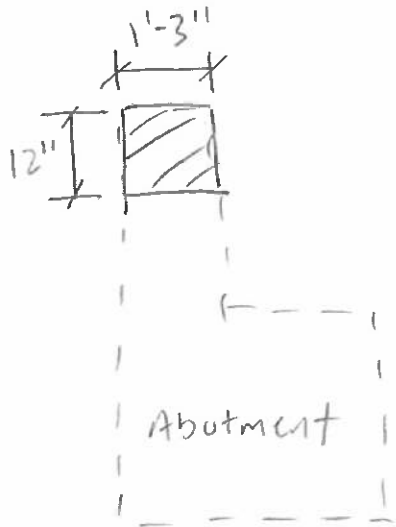

$$\text{Repair Cross Sectional Area} =$$

$$1.25' \times 1' = 1.25 \text{ ft}^2$$

$$\text{Volume of Repair} =$$

$$\frac{1.25 \text{ ft}^2 \times 84'}{\quad \quad \quad} \times 2 \text{ Abutments}$$

$$27 \text{ CY}$$

$$= 7.78$$

$$\approx \underline{\underline{8 \text{ CY}}}$$



OHIO DEPARTMENT OF TRANSPORTATION
 PLANNING & ENGINEERING DEPARTMENT, DISTRICT 4



Project _____
 Desc Bridge Repair Calculations

Calc By CLG Date 2/13/24
 Chk By MTA Date 3/22/24
 PID/PROJ 113086


SUM-76-7.366 BACKWALL REPAIR:

Knowns:

1. Repair depth shall be 12" from the top of the backwall at the forward and rear abutments.
2. Repair length is under lanes only (both directions of travel), (total of 6 lanes).

Calculations:

Repair Length along Abutments = $\overbrace{36' + 36'}^{\text{NB SB}} = 72'$

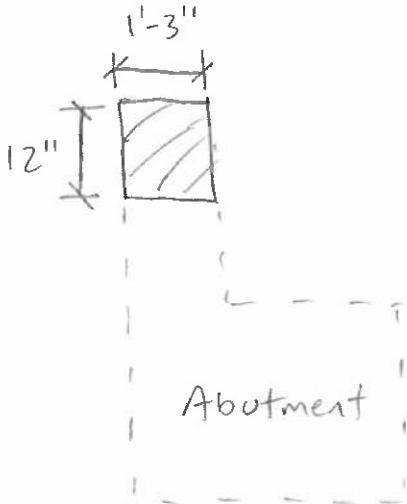

Repair Cross-sectional Area =
 $1.25' \times 1' = 1.25 \text{ ft}^2$

Volume of Repair =
 $\frac{1.25 \text{ ft}^2 \times 72'}{27}$

= 3.33

≈ 4 CY



OHIO DEPARTMENT OF TRANSPORTATION
 PLANNING & ENGINEERING DEPARTMENT, DISTRICT 4



Project _____
 Desc Bridge Repair Calculations

Calc By CLG Date 2/13/24
 Chk By MSA Date 3/27/24
 PID/PROJ 113086


SUM-76-8.237L BACKWALL REPAIR:

Knowns:

1. Repair depth shall be 12" from the top of the backwall at the forward and rear abutments.
2. Repair length is under lanes only.

Calculations:

Repair Length Along Abutments = 50'-0" (3 Lane width Approx.)

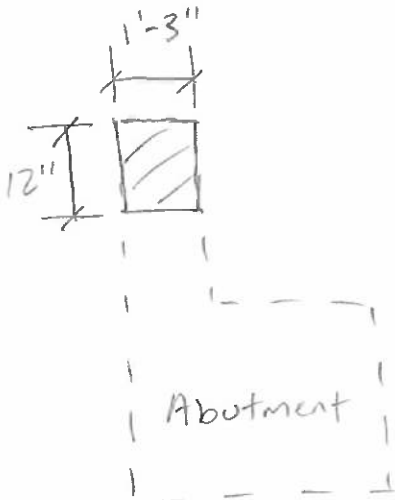

Repair Cross-sectional Area =

$$1.25' \times 1' = 1.25 \text{ ft}^2$$

Volume of Repair =

$$\frac{1.25 \text{ ft}^2 \times 50'}{27} \times 2 \text{ Abutments}$$

$$= 4.63$$

$$= \underline{\underline{5 \text{ CY}}}$$



OHIO DEPARTMENT OF TRANSPORTATION
PLANNING & ENGINEERING DEPARTMENT, DISTRICT 4



Project _____
Desc Bridge Repair Calculations

Calc By CLG Date 2/13/24
Chk By MJA Date 3/22/24
PID/PROJ 113086

SUM-76-5.910 CONCRETE PARAPET REPAIRS:

Calculations:

- See sheet 12/13 of the structure plans.
- Item 511 - Concrete Misc.: Parapet Repair (CY)

DETAIL A

$$\text{Repair Length} = 76' + 172' = 248'$$

$$\text{Repair Volume} = \frac{\left(\frac{12''}{12} \times \frac{8''}{12}\right) \times (248')}{27} = 6.12 \text{ CY} \approx \underline{\underline{7.00 \text{ CY}}}$$

DETAIL B

$$\text{Repair Length} = 61' + 68' = 129'$$

$$\text{Repair Volume} = 12'' \text{ top repair} + 3'' \text{ Perimeter repair}$$

$$= \frac{\left[\left(\frac{12''}{12} \times \frac{8''}{12}\right) + (129')\right]}{27}$$

$$= 3.19$$

$$\approx \underline{\underline{4 \text{ CY}}}$$

- Item 509 - Concrete Reinforcement, Replacement of Concrete Reinforcement

- 2 - #5 bar
- weight per bar = 1.043 lb
- Total Repair Length = 377'

$$1.043 \text{ lb} \times 2 \text{ bar} \times 377 \text{ ft} \approx$$

$$\underline{\underline{787 \text{ lb}}}$$



OHIO DEPARTMENT OF TRANSPORTATION
 PLANNING & ENGINEERING DEPARTMENT, DISTRICT 4



Project _____
 Desc Bridge Repair Calculations

Calc By CLG Date 2/13/24
 Chk By MSA Date 3/22/24
 PID/PROJ 113080

ITEM 844, CONCRETE PATCHING WITH GALVANIC ANODE PROTECTION: ANODE SPACING

Calculations:

Density check = Total surface Area of Bar (ft^2) within a square foot of concrete (regardless of depth).

Sum-76-6.474R

MAX. Spa

Columns of Pier 1 = 0.313 (28 in)

Backwalls = 0.115 (30 in)

Sum-277-0.898

Abutment Face = 0.271 (30 in.)

Rail Top = 0.156 (30 in.)

Sum-277-1.129

Rail Top = 0.156 (30 in.)

Pier Cap = 0.240 (30 in.)


Sum-277-2.341

Pier = 0.337 (28 in)

Sum-277-2.890

MAX. Spa.

Abutment Face = 0.159 (30 in.)

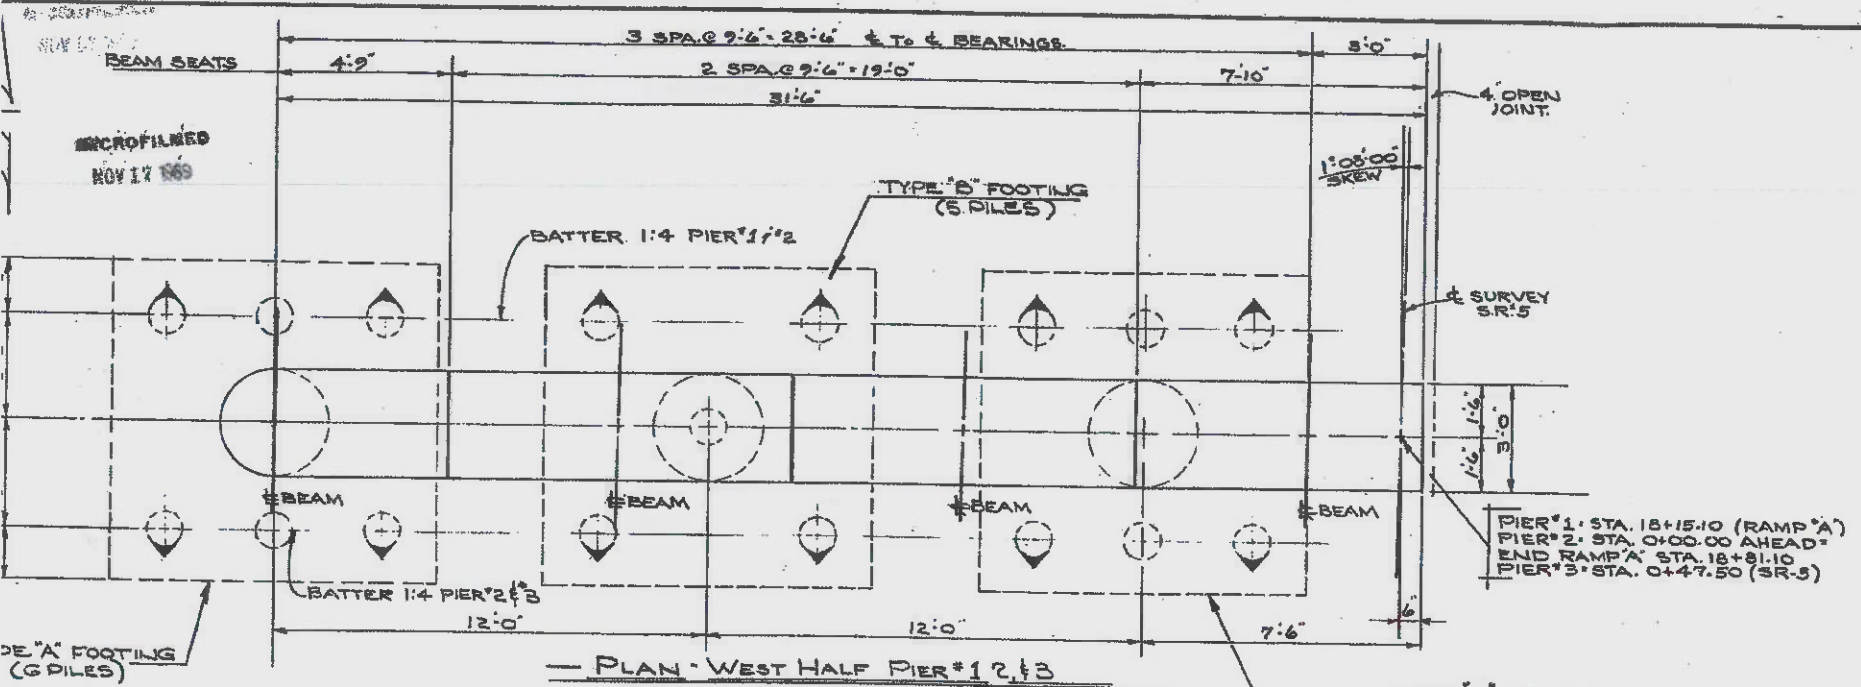

SUM-76-6.474R

FED. RD.	STATE	PROJECT
2	OHIO	



SUM-5-933

ELEVATIONS

	PIER #1	PIER #2	PIER #3
A	990.57	992.31	994.11
B	990.73	992.46	994.2
C	990.88	992.62	994.4
D	990.86	992.60	994.3
E	968.75	970.50	969.5
F	987.07	988.82	990.6

Surface Area of Steel within ft² Box :

- 3-#4 @ 1'-0" ± Length, 0.50" Dia.
 $3 \text{ bar} \times 1'-0" \times \frac{0.50}{12} = 0.125 \text{ ft}^2$
- 2-#9 @ 1'-0" ± Length, 1.128" Dia.
 $2 \text{ bar} \times 1'-0" \times \frac{1.128}{12} = 0.188 \text{ ft}^2$
- $\Sigma \text{ Steel Density} = 0.125 + 0.188 = 0.313 \text{ ft}^2$

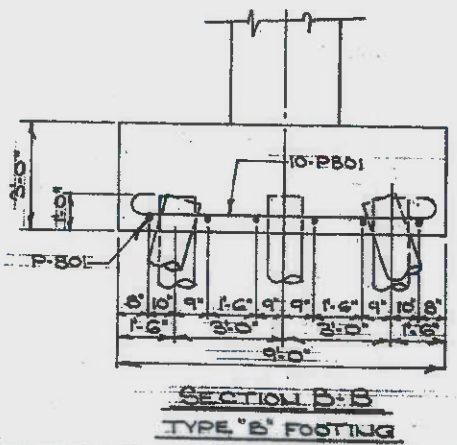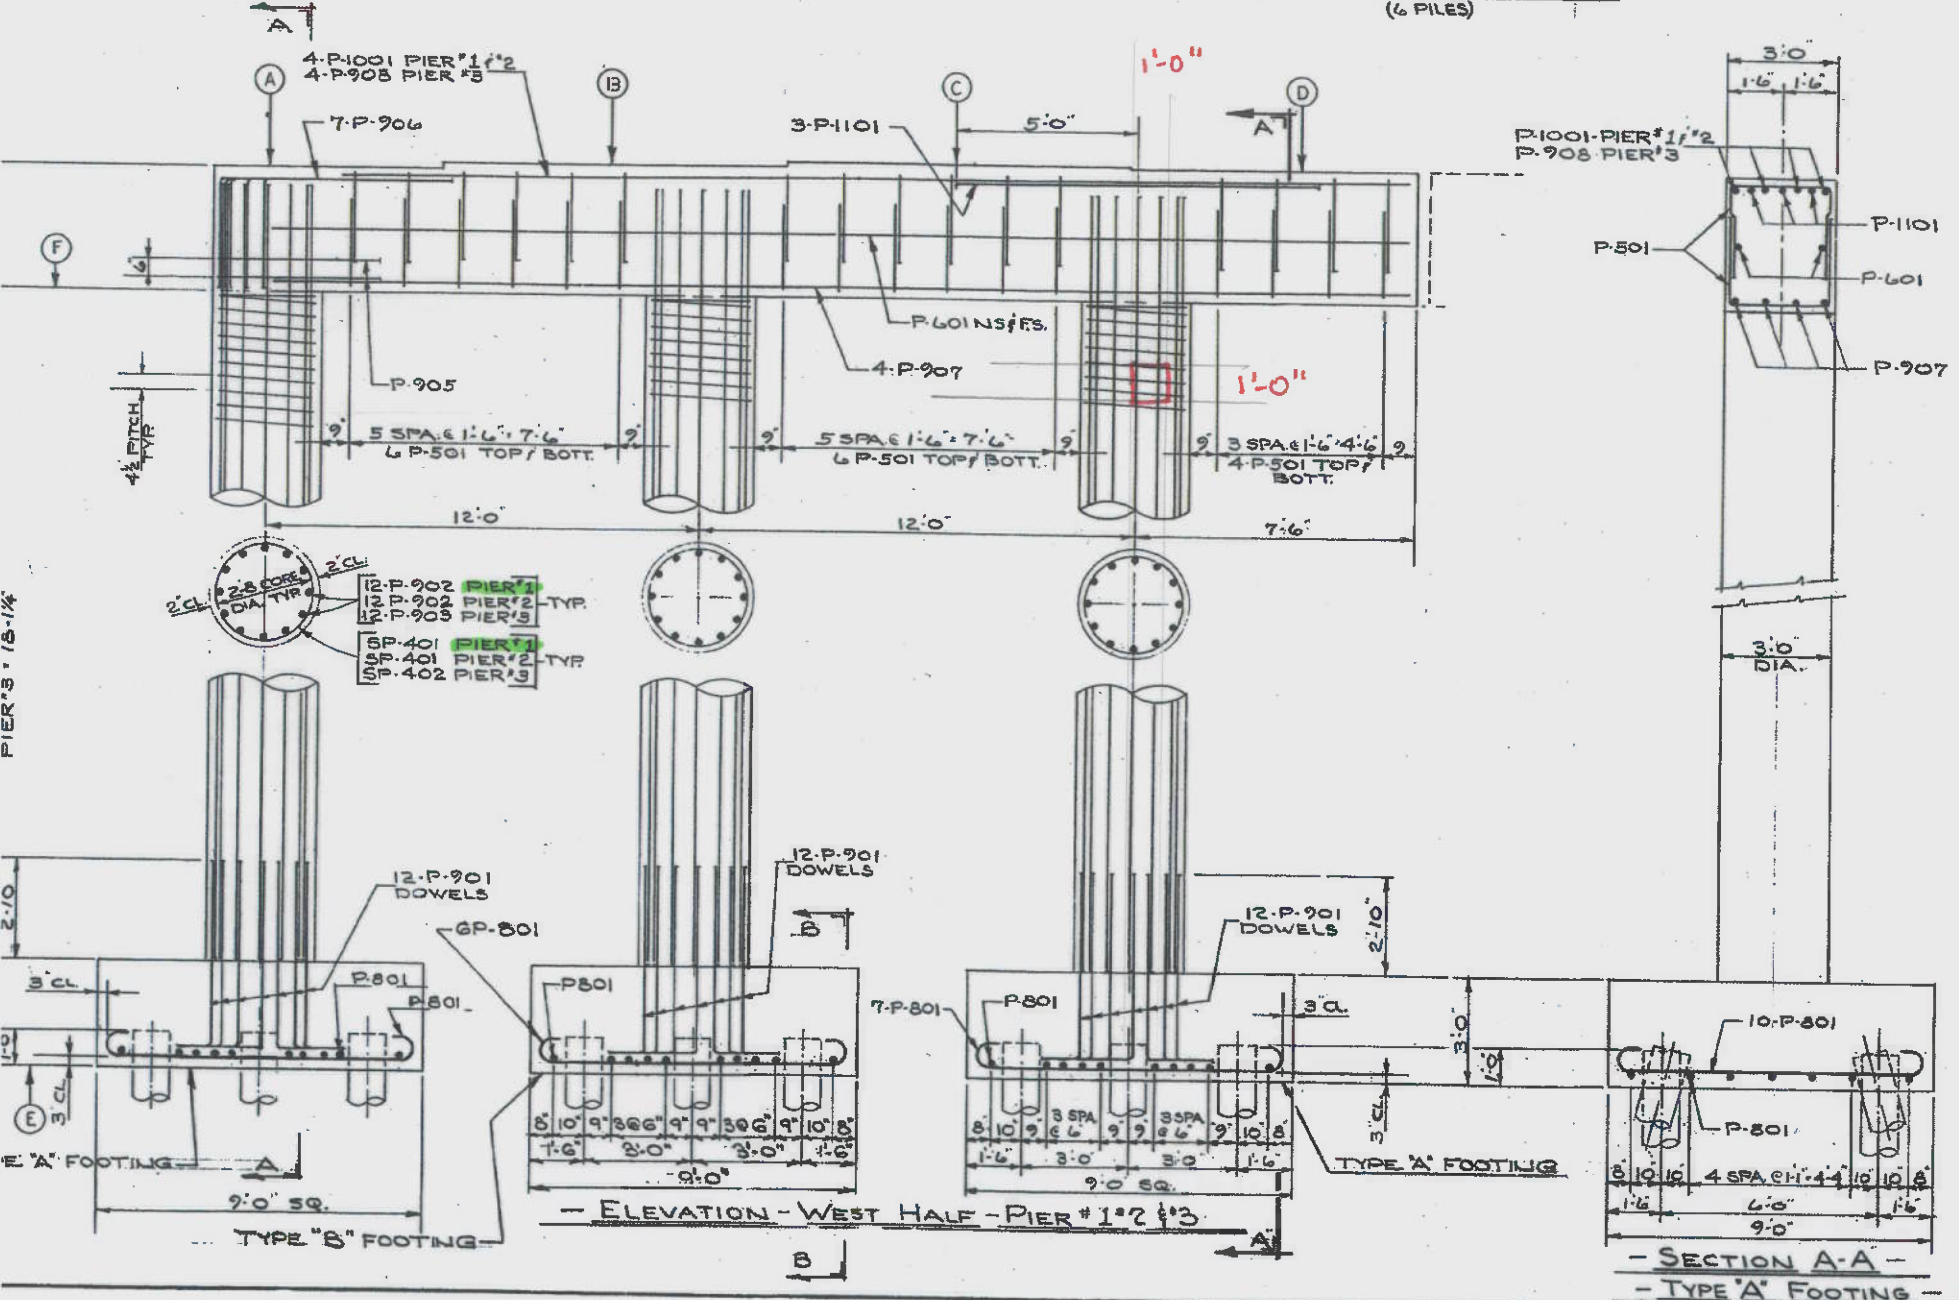

STATE OF OHIO
DEPARTMENT OF HIGHWAYS
BUREAU OF BRIDGES

BEISWENGER & HOCH, Consulting Engineers
AKRON, OHIO

PIER #1, 2 & 3 DETAILS - LEFT STRUCTURE

BRIDGE NO SUM-5-0949
OVER U.S. 224
KENMORE EXPWAY, AKRON EXPWAY, SYSTEM
SUMMIT COUNTY
STA. 17+66.60 TO STA. 0+89.25


DESIGNED	DRAWN	TRACED	CHECKED	REVIEWED	DATE	REVISIONS
ES	JUP		Hbls	RDAF	4/18/63	

TRD. NO.	STATE	PROJECT
1	OHIO	SUM-5-91


Surface Area of steel within ft² Box:

- 1-#6 @ 1'-0" Length, 0.75" Dia.
 $1 \text{ bar} \times 1'-0" \times \frac{0.75}{12} = 0.0625$
- 1-#5 @ 1'-0" Length, 0.625" Dia.
 $1 \text{ bar} \times 1'-0" \times \frac{0.625}{12} = 0.052$

$\Sigma \text{ Steel Den.} = 0.0625 + 0.052 = 0.115$

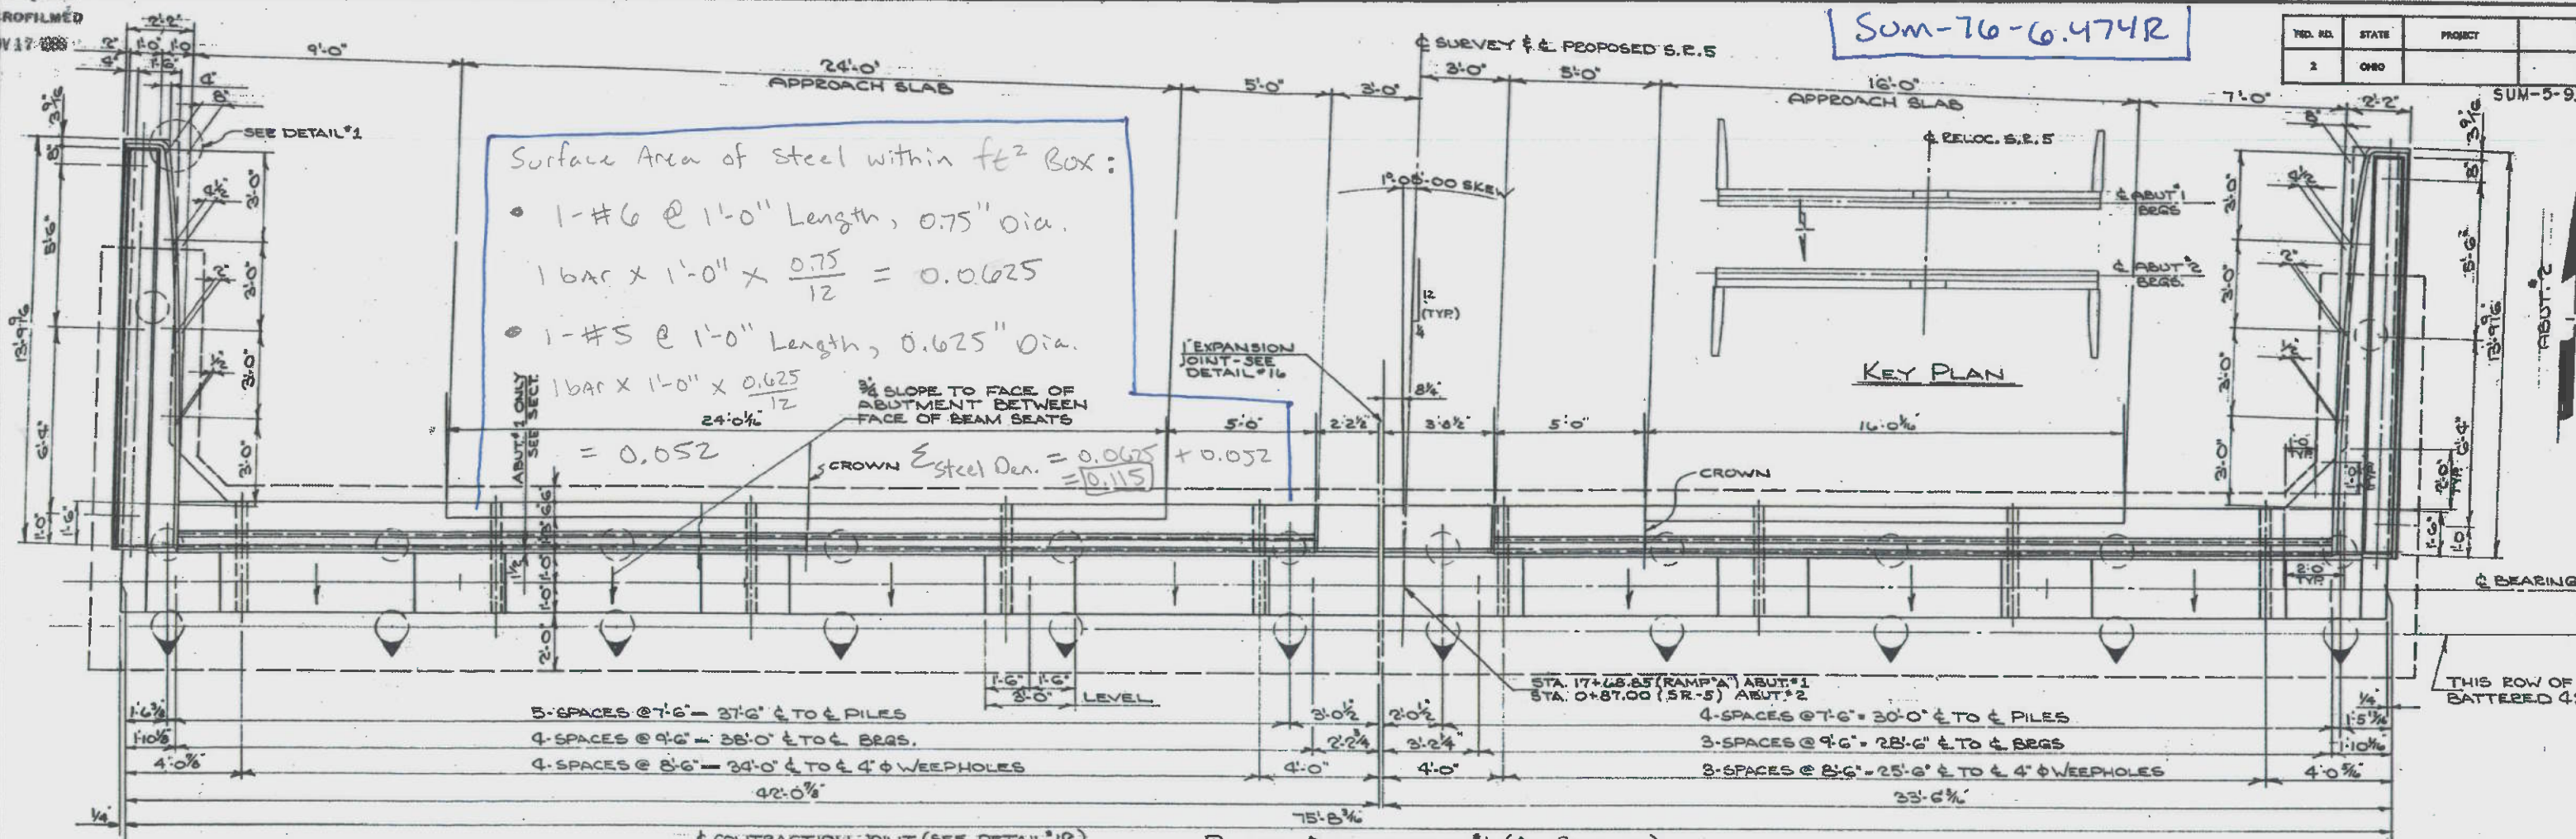

PLAN-ABUTMENT #1 (AS SHOWN)
 PLAN-ABUTMENT #2 (OPP. HAND & AS NOTED)

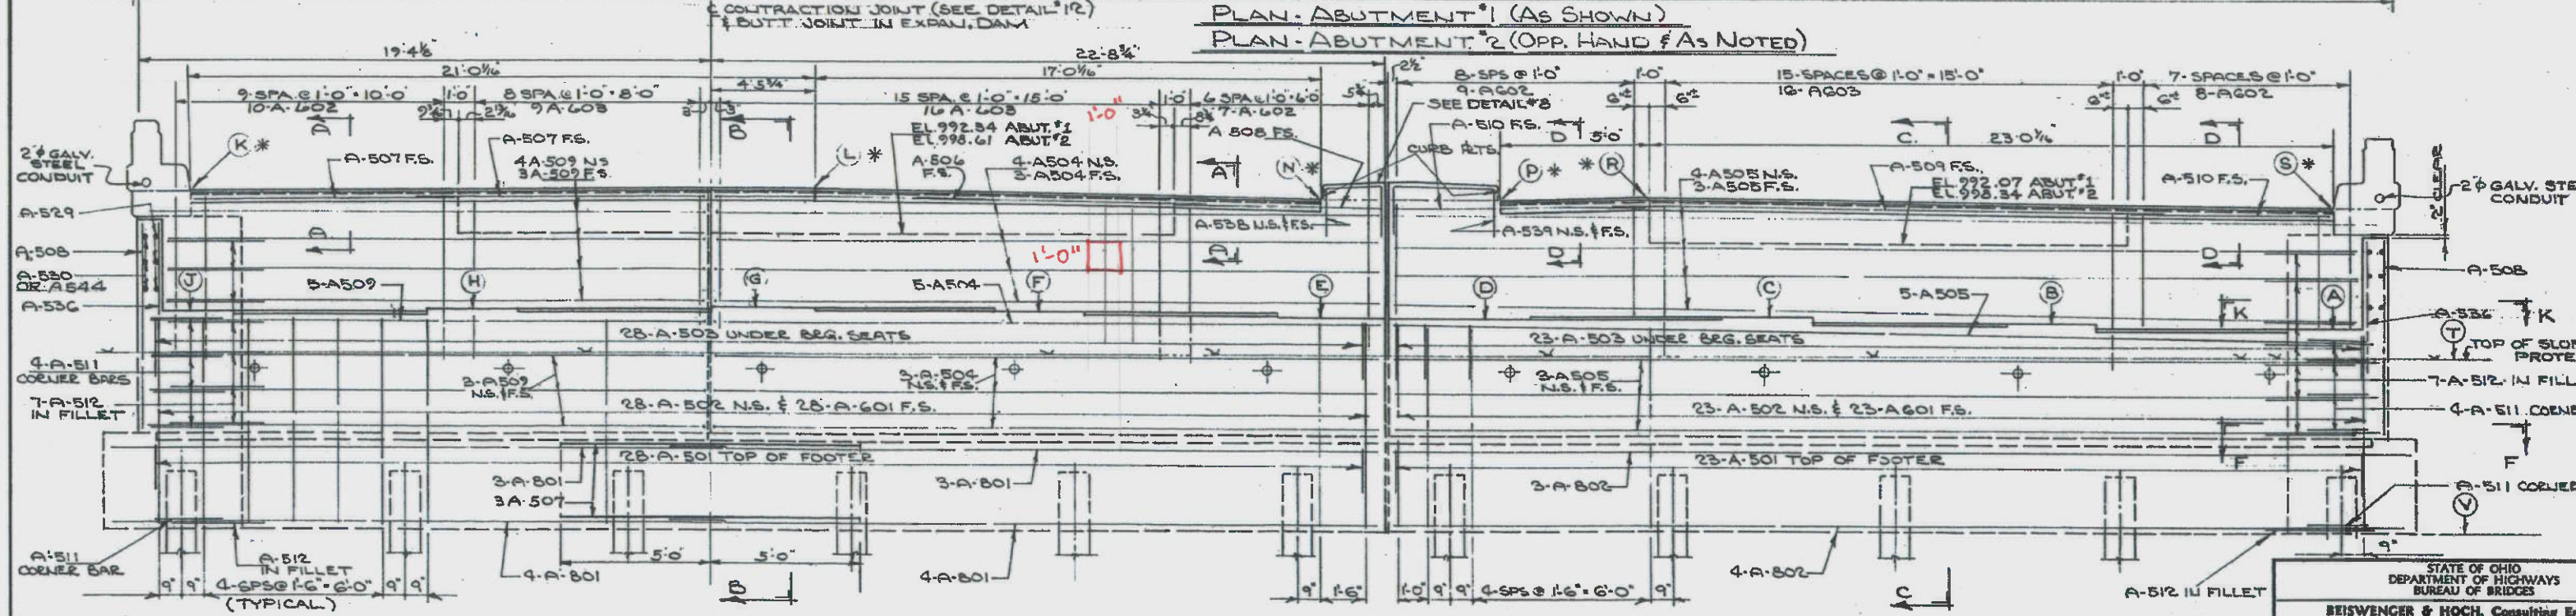


ELEVATION TABLE

	A	B	C	D	E	F	G	H	J	K	L	N	P	R	S	T	V
ABUT #1	989.19	989.35	989.51	989.49	989.50	989.65	989.77	989.72	989.67	992.70	993.81	993.53	993.53	993.60	993.23	988.19	982.17
ABUT #2	995.32	995.46	995.62	995.61	995.62	995.77	995.86	995.72	995.58	999.68	999.99	999.72	999.71	999.79	999.42	994.32	988.30

*ELEVATION GIVEN TO HEEL OF ANGLE.

STATE OF OHIO
 DEPARTMENT OF HIGHWAYS
 BUREAU OF BRIDGES

BEISWENGER & HOCH, Consulting Eng
 AKRON, OHIO


ABUTMENT #1 & 2 DETAIL
 BRIDGE NO. SUM-5-094
 OVER U.S. 224
 KENMORE EXPWAY. AKRON EXPWAY.
 SUMMIT COUNTY
 STA. 17+66.60 TO STA. 0+89.25

DESIGNED: MNC
 DRAWN: lww

Surface Area of Steel within ft² Box :



- 2-#8 bar @ 1'-0", 1.00" dia.
 $2 \text{ bar} \times 1'-0" \times \frac{1}{12} = 0.167$
- 2-#5 bar @ 1'-0", 0.625" dia.
 $2 \text{ bar} \times 1'-0" \times \frac{0.625}{12} = 0.104$

$\Sigma \text{ Steel Density} = 0.167 + 0.104 = 0.271$

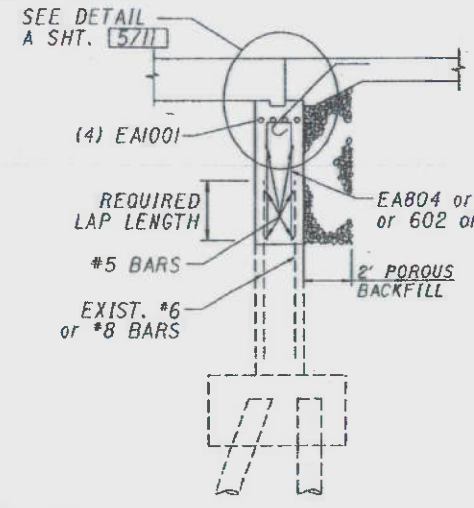

SECTION A-A


SUM-277-0.898

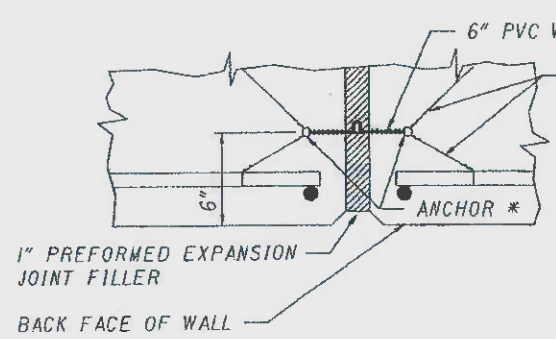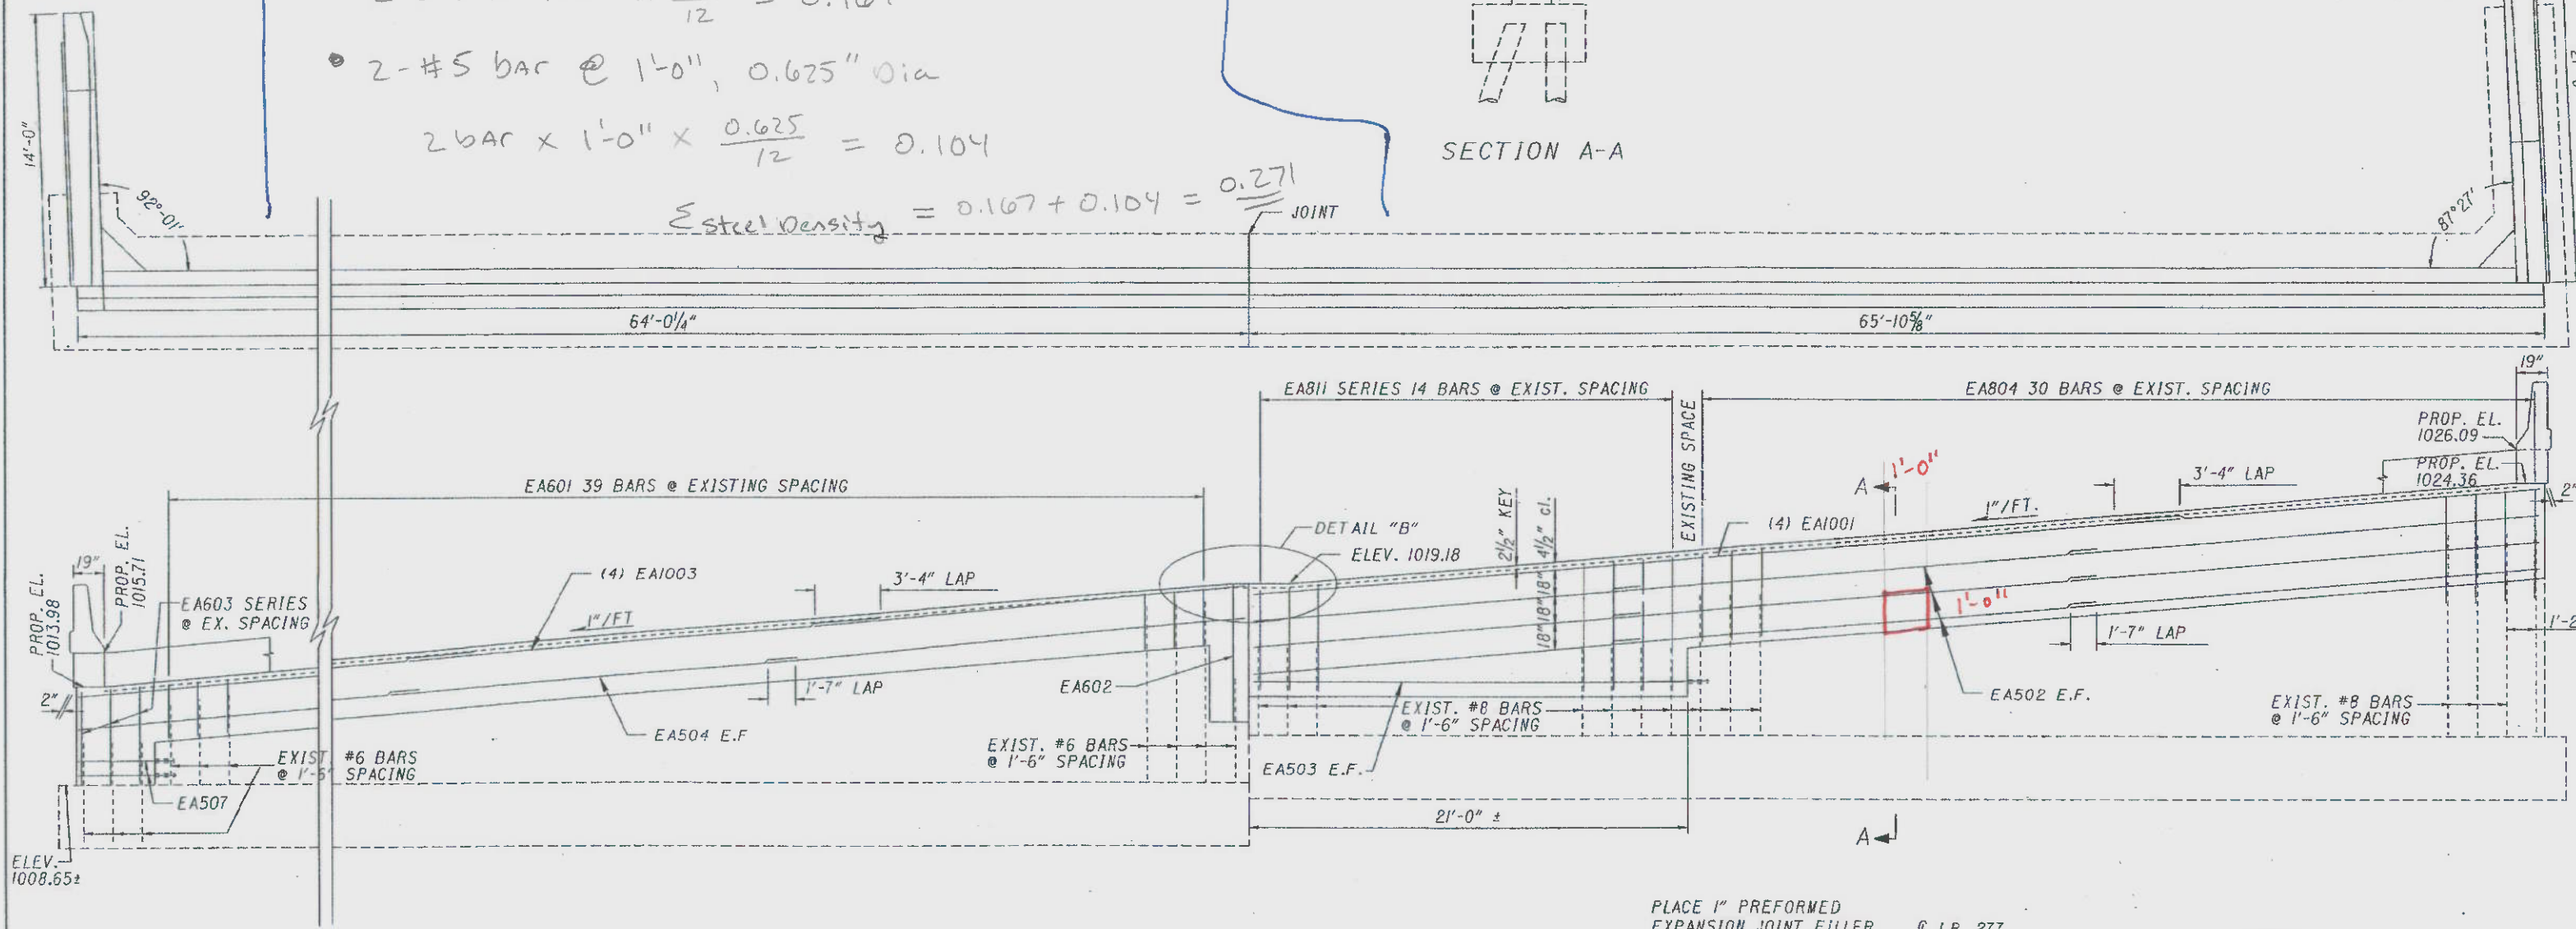


* TIE TO REINF. STEEL (TYP.) No. 16 GAUGE TIE-WIRE (TYP.)

* FOR THE FIRST POUR, THE WATERSTOP SHOULD BE HELD SECURELY IN PLACE BY THE USE OF SPLIT FORMS AND TIE-WIRES. FOR THE SECOND POUR, SECURE THE FREE END OF WATERSTOP IN PROPER POSITION WITH TIE-WIRES. ALTERNATE METHODS, AS APPROVED BY THE ENGINEER, MAY BE USED TO INSURE THE CORRECT POSITIONING OF THE WATERSTOP.

WATERSTOP DETAILS

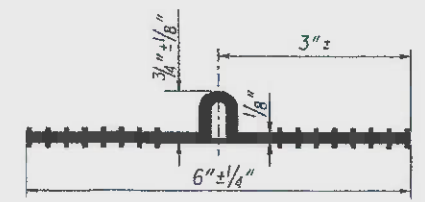

PLACE 1" PREFORMED EXPANSION JOINT FILLER OVER BACKWALLS & PIERS @ I.R. 277

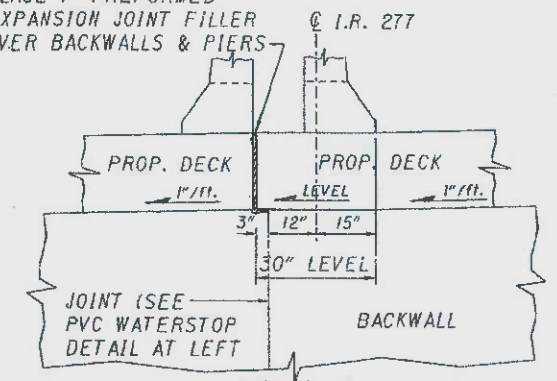

DETAIL B SHOWING CROSS-SLOPE AT JOINT







NOTE:
 ALL DOWEL HOLES ARE 1" IN DEPTH.
 FOR WINGWALL PARAPET SAFETY SHAPE DIMENSIONS SEE SHT. No. 7/11.

STATE OF OHIO DEPARTMENT OF TRANSPORTATION BUREAU OF BRIDGES					
REAR ABUTMENT DETAILS					
BRIDGE NO. SUM-277-0092 OVER A & B.B. RAILROAD					
I-277			SUMMIT COUNTY		
DESIGNED	DRAWN	TRACED	CHECKED	REVIEWED	DATE
ST	RB		KS	GLB	7-13-97


SUM-76-0.898

F.H.W.A. REGION	STATE	PROJECT NO.	FUNDING
5	OHIO		

SUM-277/224/-0.00/6.3

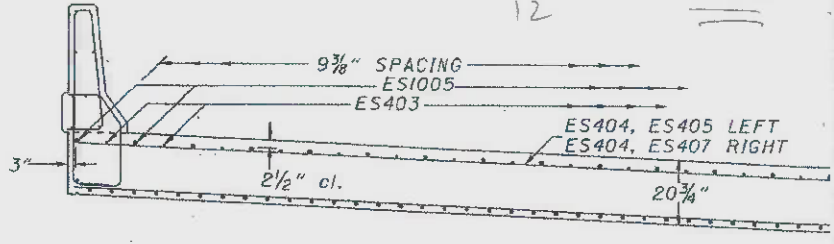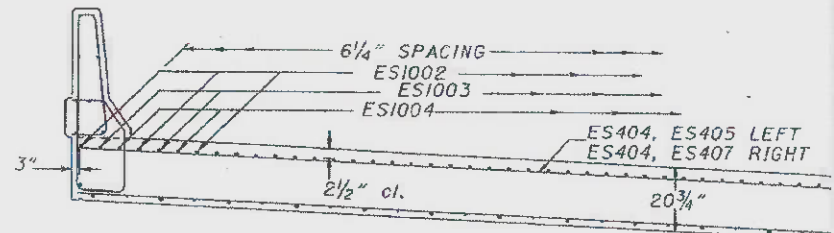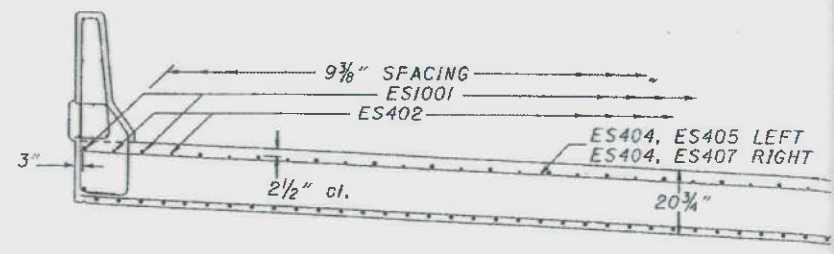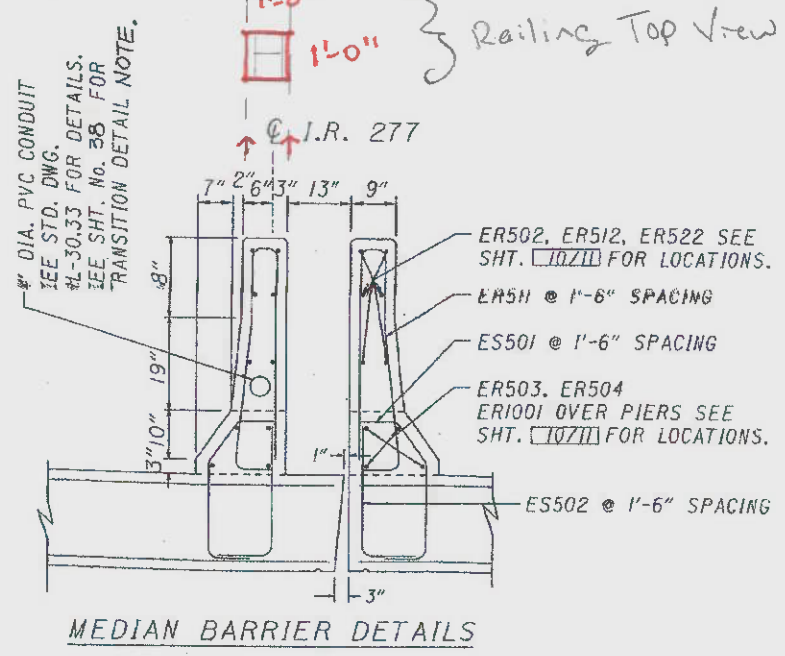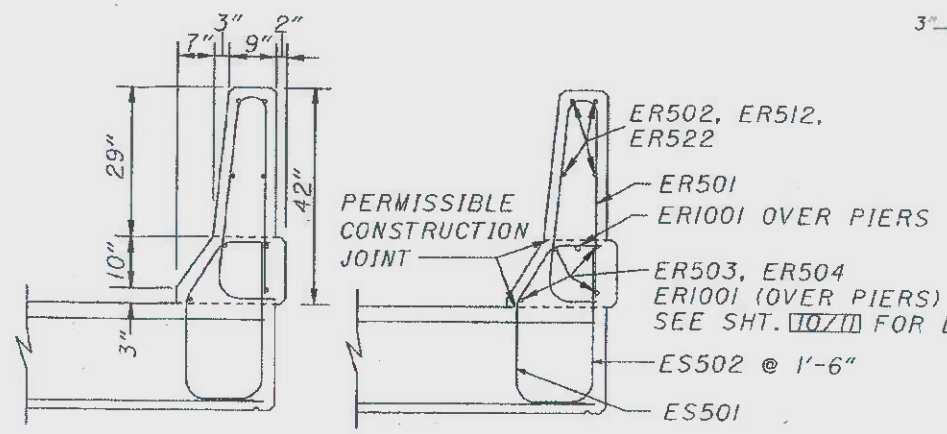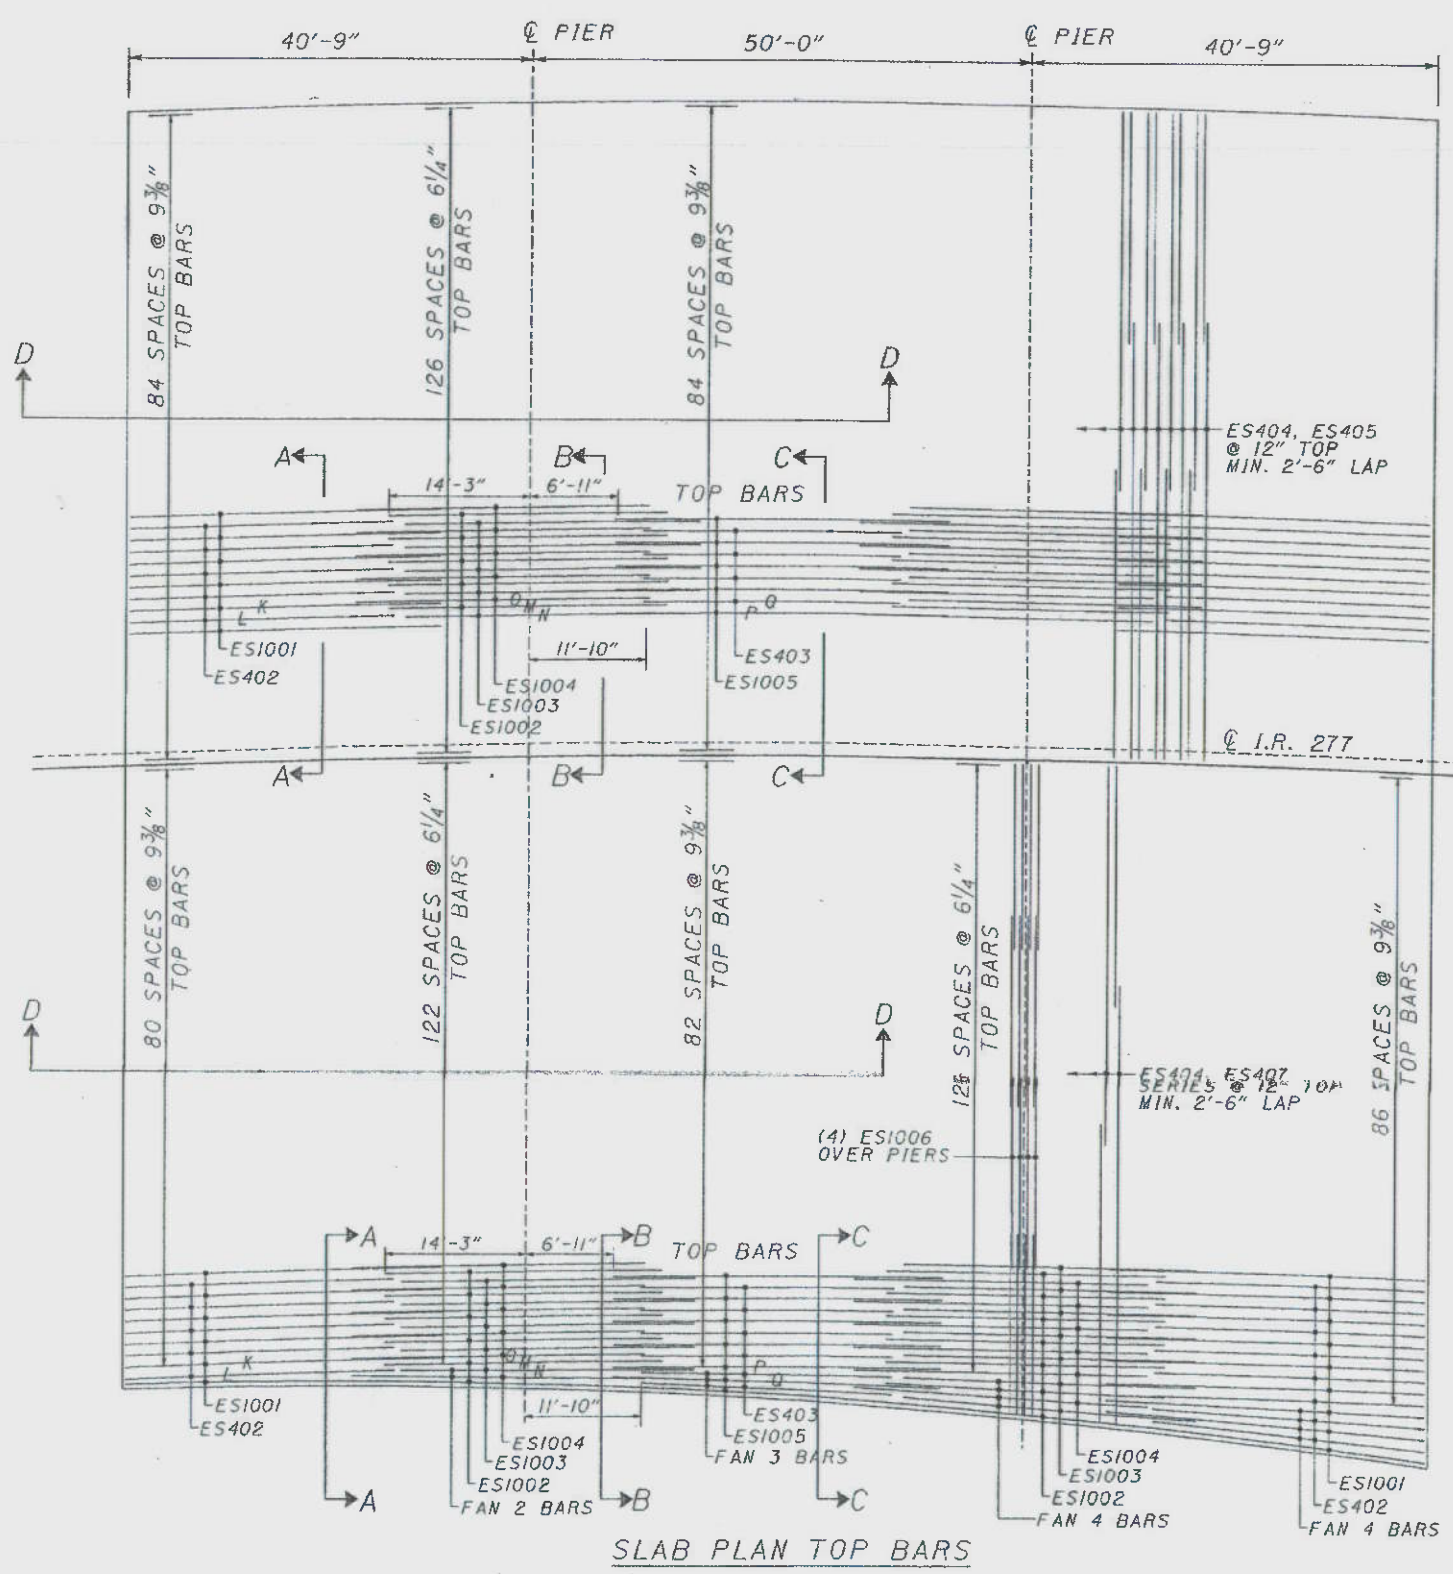

Surface Area of Steel within ft² Box:
 • 3-#5 bar @ 1'-0", 0.625" Dia:
 $3 \text{ bar} \times 1'-0" \times \frac{0.625}{12} = 0.156$

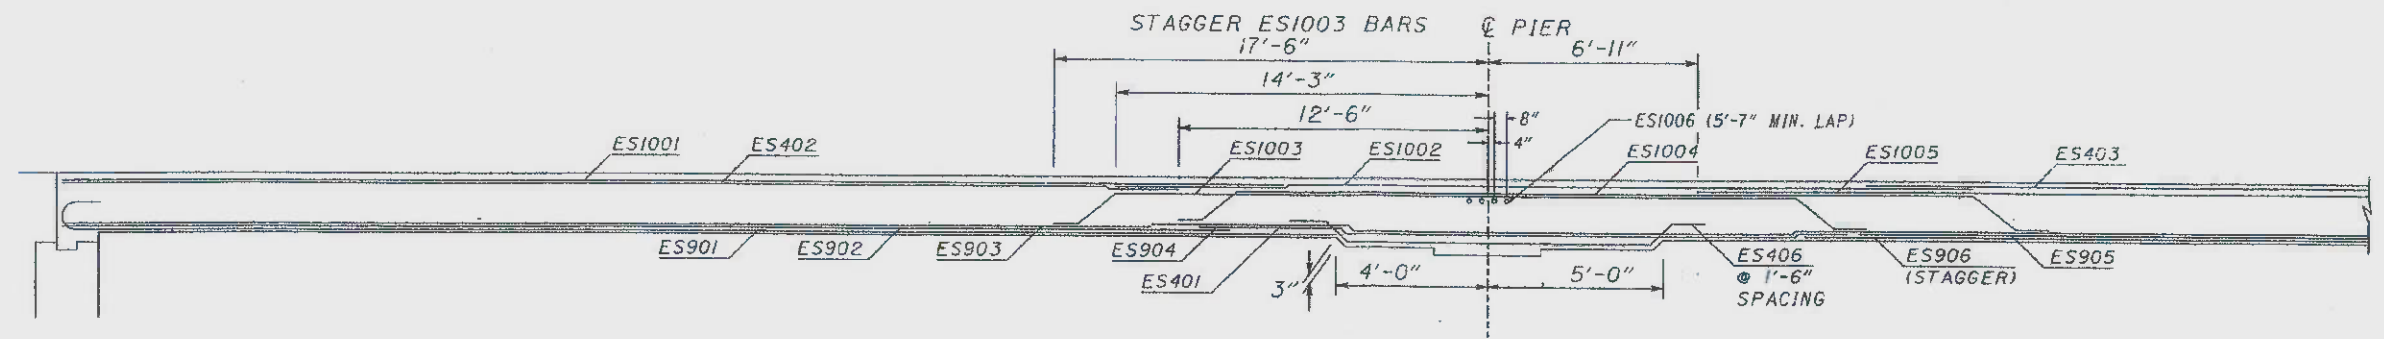


STATE OF OHIO DEPARTMENT OF TRANSPORTATION
SUPERSTRUCTURE
STRUCTURE No. SUM - 2
DESIGNED: DRAMM TRACED: CHECKED: REVIEWED:

MAY 23 1965

SUM-277-1.129


FIG. NO.	STATE	PROJECT
2	OHIO	

SUM-277-046

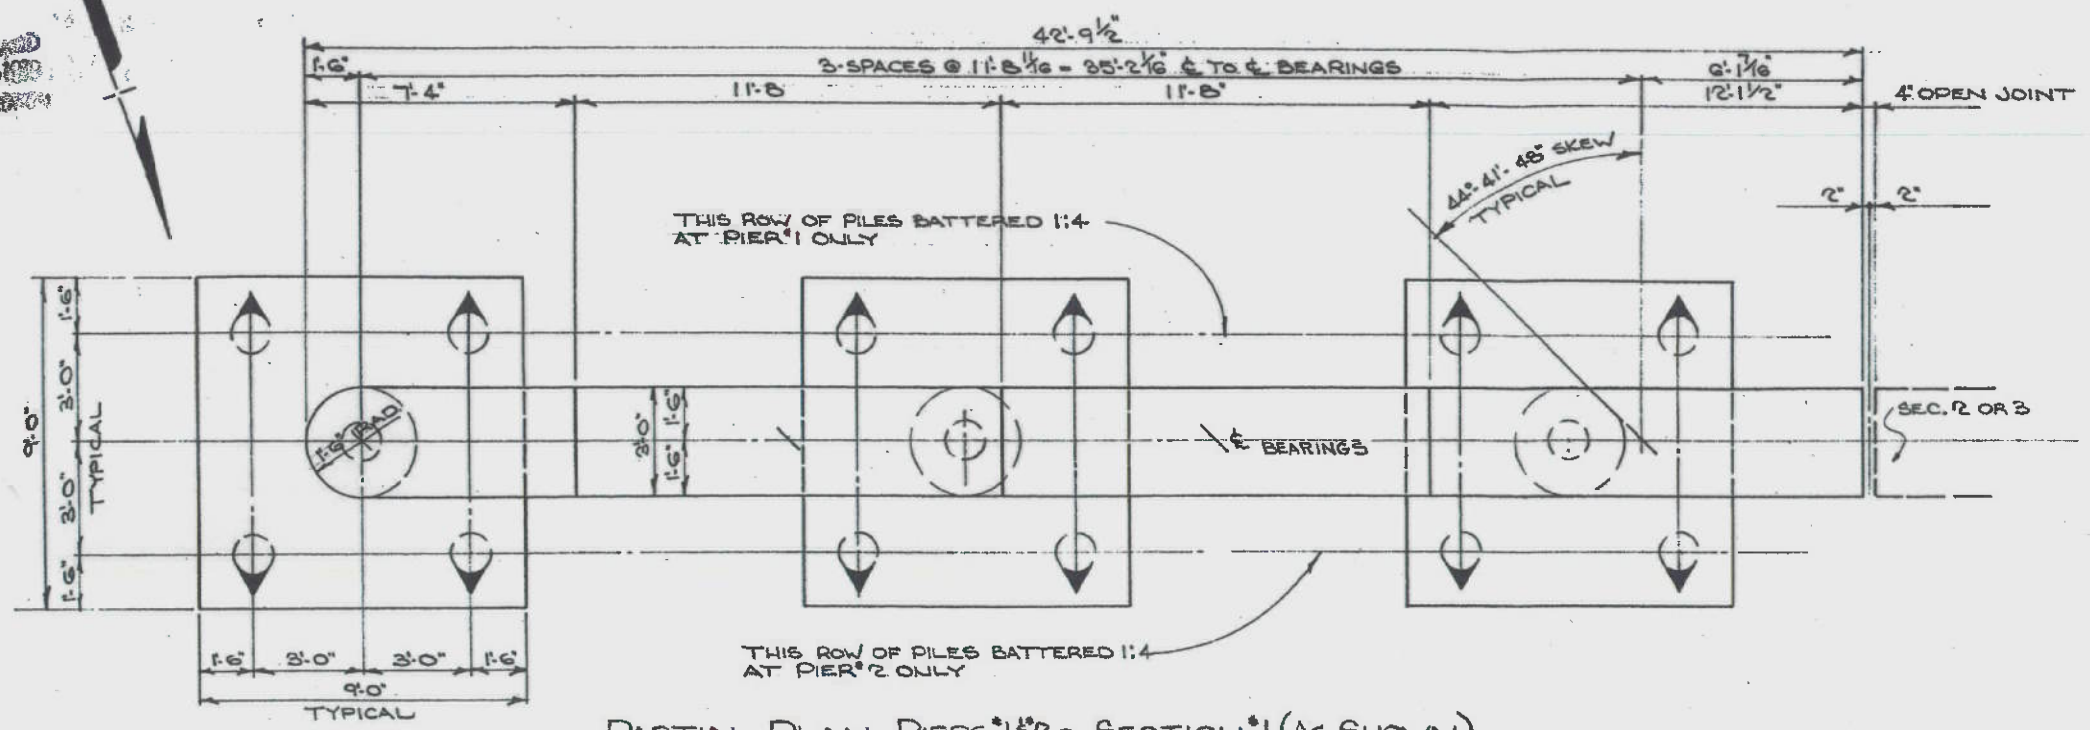


PARTIAL PLAN PIERS #1 & #2 ~ SECTION #1 (AS SHOWN)
 PARTIAL PLAN PIERS #1 & #2 ~ SECTION #4 (OPPOSITE HAND EXCEPT FOR SKEW)


	A	B	C	D	H	K	L
PIER #1 SECTION #1	1012.90	1013.00	1013.10	1013.20	1009.14	990.00	16'-1 5/8"
PIER #1 SECTION #4	1012.64	1012.75	1012.92	1013.07	1009.14	985.50	20'-7 5/8"
PIER #2 SECTION #1	1013.50	1013.63	1013.75	1013.87	1009.66	993.50	13'-1 7/8"
PIER #2 SECTION #4	1013.16	1013.31	1013.49	1013.65	1009.66	987.50	19'-1 7/8"

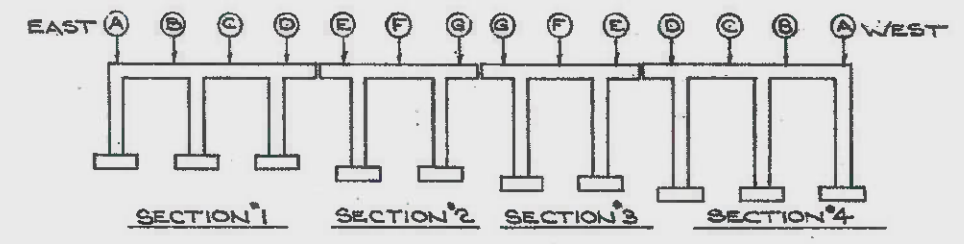

KEY PLAN - PIERS #1 & #2

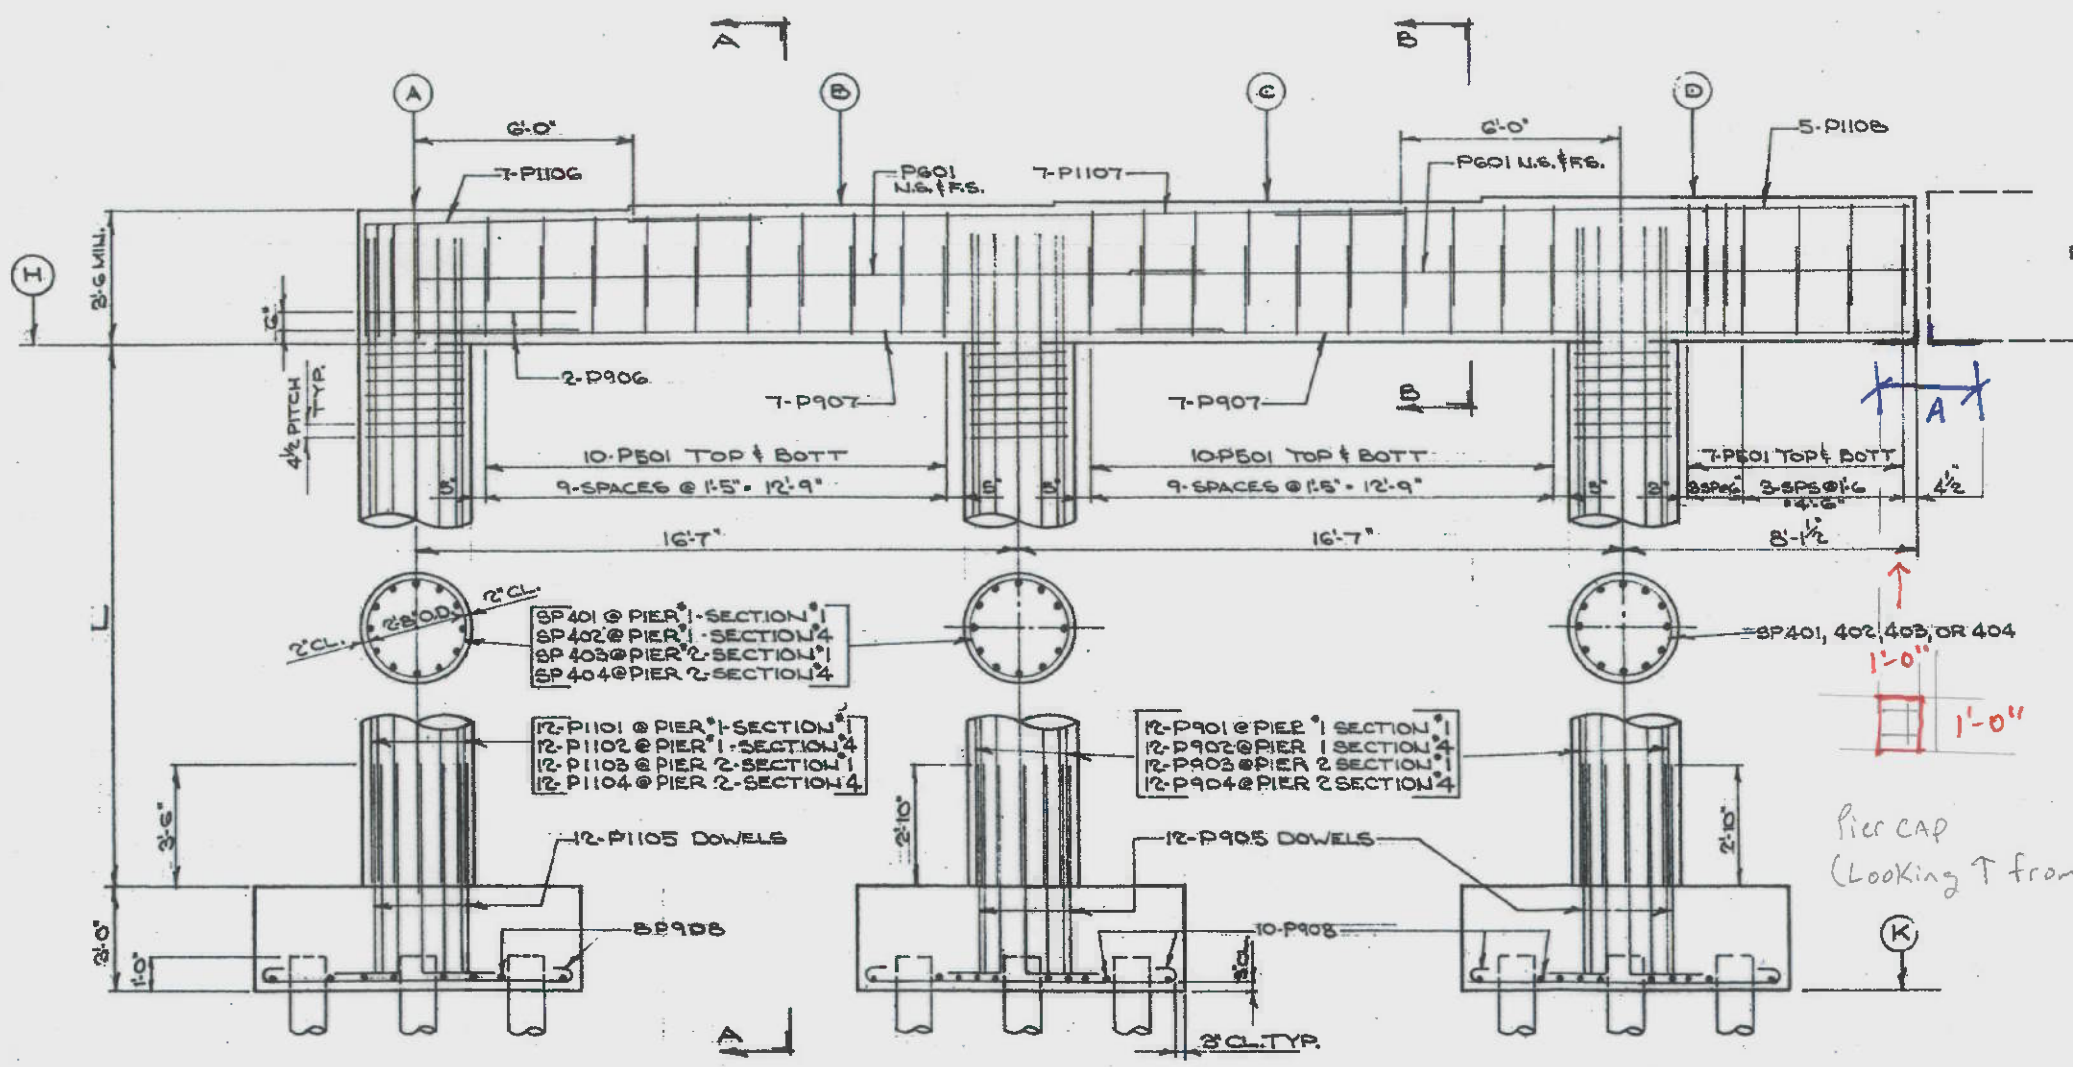


PARTIAL ELEVATION PIERS #1 & #2 ~ SECTION #1 (AS SHOWN)
 PARTIAL ELEVATION PIERS #1 & #2 ~ SECTION #4 (SIMILAR EXCEPT OPPOSITE HAND)

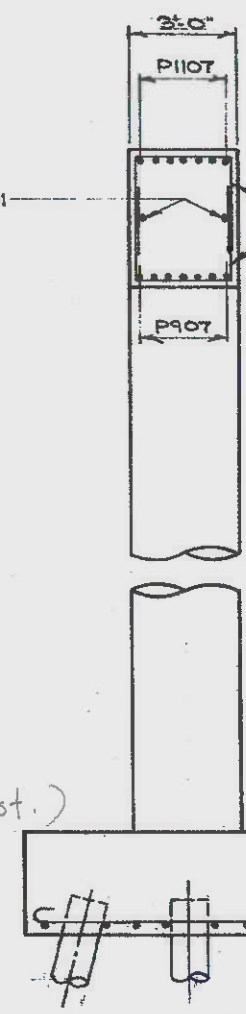

SECTION A-A

A: Repair Area - Bottom of Pier cap.
 Surface Area of steel in ft² Box:
 • 2-#9 bar @ 1'-0", 1.128" dia.
 $2 \text{ BAR} \times 1'-0" \times \frac{1.128}{12} = 0.188$
 • 1-#5 bar
 $1 \times 1'-0" \times \frac{0.625}{12} = 0.052$
 $\Sigma = 0.188 + 0.052 = 0.24$

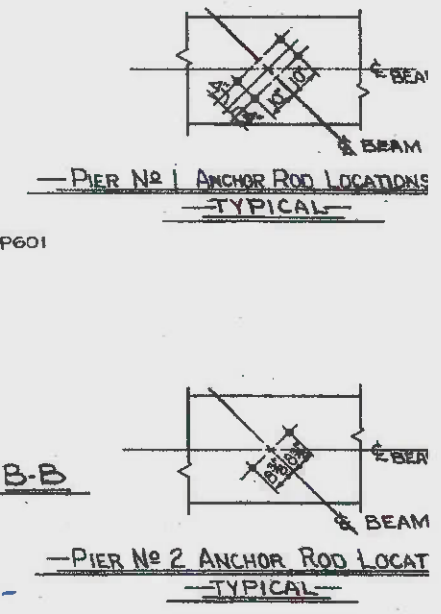


STATE OF OHIO DEPARTMENT OF HIGHWAYS BUREAU OF BRIDGES			
BEISWENGER, HOCH & ARNOLD Consulting Engineers			
PIERS #1 & #2 DETAILS BRIDGE # SUM-277-0259 OVER WATERLOO ROAD			
I-277	SUMMIT CT	STA 119+91.47 TO STA 122+11.8	
DESIGNED J.P.	DRAWN J.W.W.	CHECKED C.C.A.	REVIEWED R.D.N. 3-18-65

MAY 21 1964

SUM-277-2.890

FED. RD.	STATE	PROJECT
2	OHIO	

SUM-277-0.46

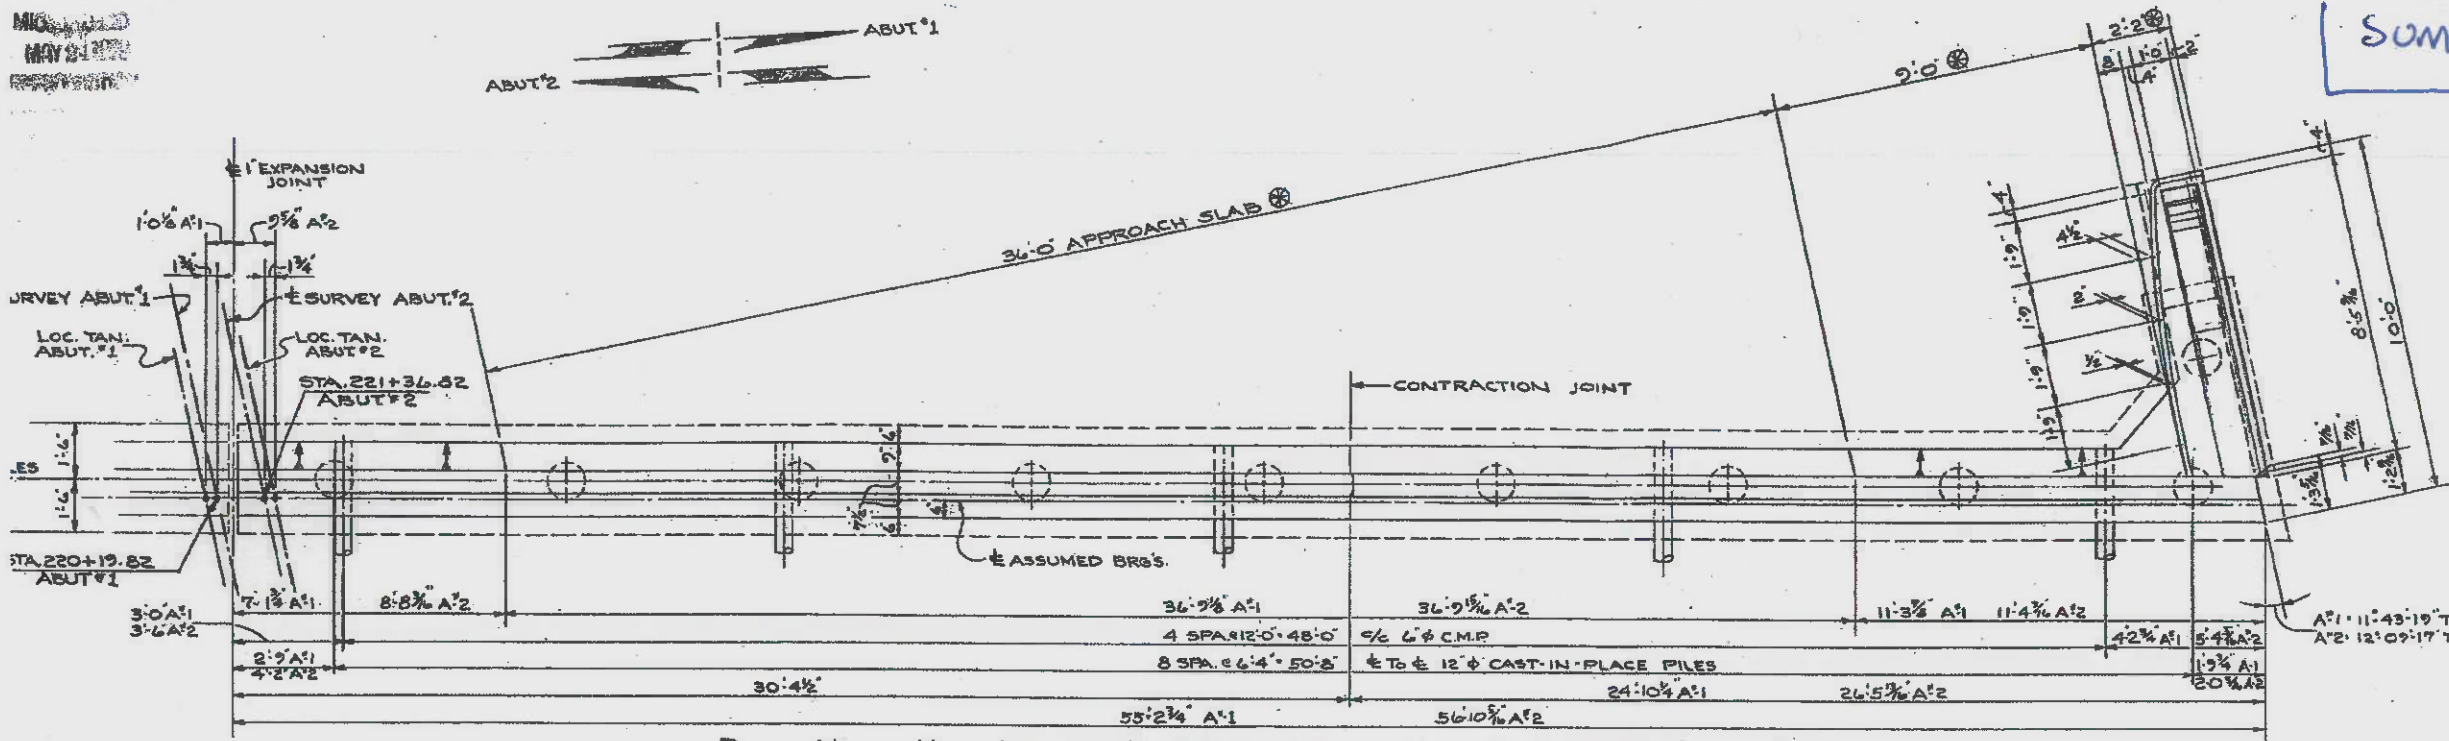


- PLAN - NORTH HALF ABUTMENT #1 SHOWN - SOUTH HALF ABUTMENT #2 SIMILAR EXCEPT AS NOTED. -


Surface Area of Steel within ft² Box

- 1-#10 Bar @ 1'-0" Length, 1.27" dia
 $1 \text{ Bar} \times 1'-0" \times \frac{1.27}{12} = 0.106$
- 1-#5 bar @ 1'-0" Length, 0.625" dia
 $1 \text{ Bar} \times 1'-0" \times \frac{0.625}{12} = 0.053$


Σ Steel density = 0.106 + 0.053 = 0.159

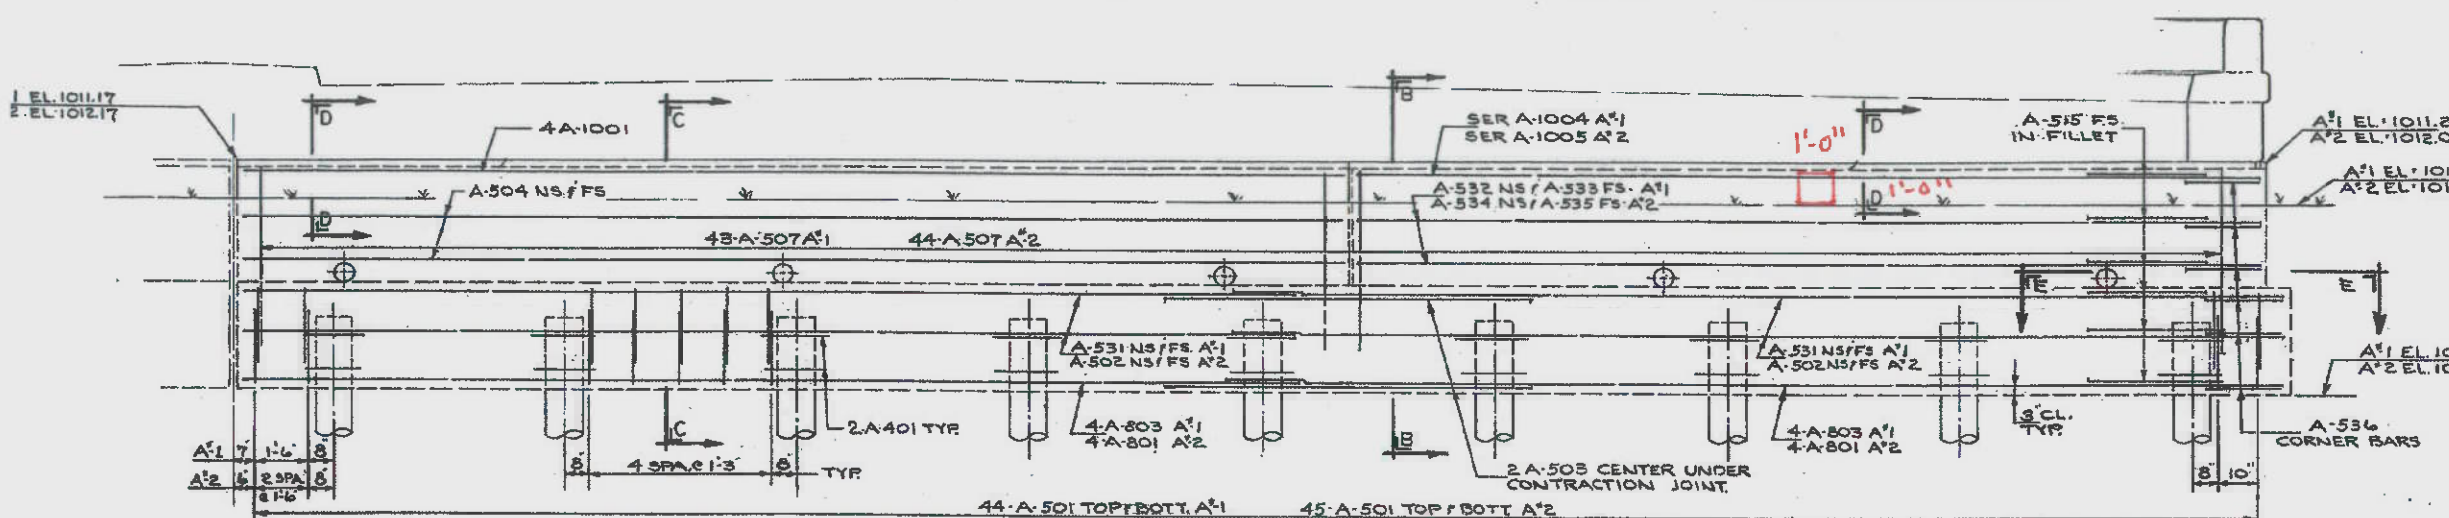


- ELEVATION - NORTH HALF ABUTMENT #1 SHOWN - SOUTH HALF ABUTMENT #2 SIMILAR EXCEPT AS NOTED. -

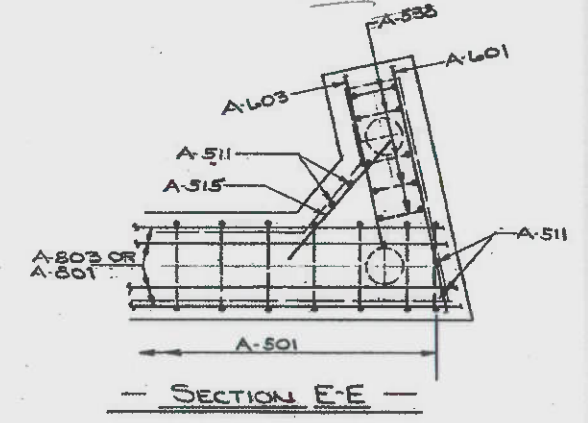


- SECTION E-E -

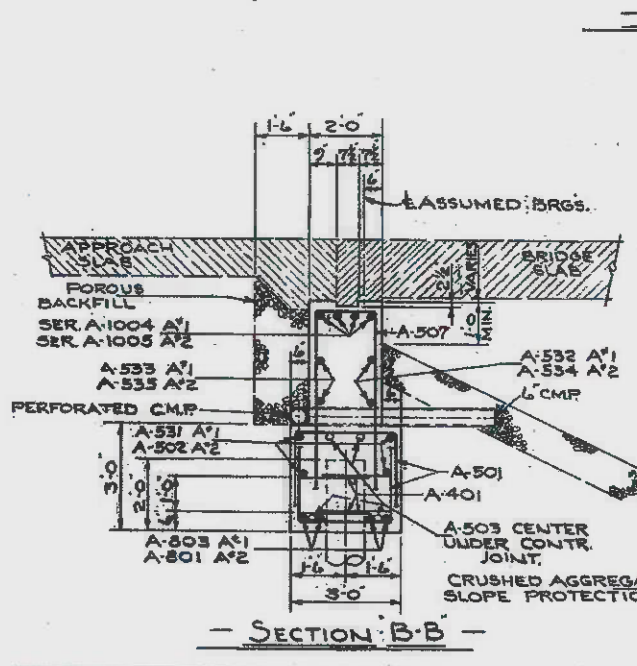


- SECTION B-B -

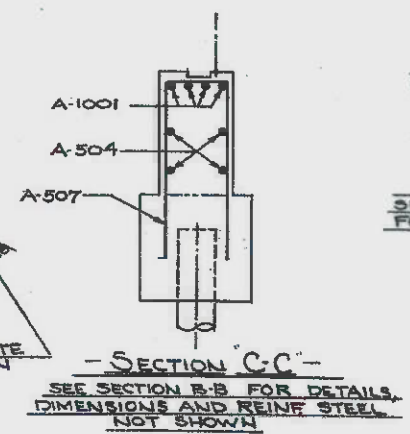


- SECTION C-C -
SEE SECTION B-B FOR DETAILS, DIMENSIONS AND REINF. STEEL NOT SHOWN

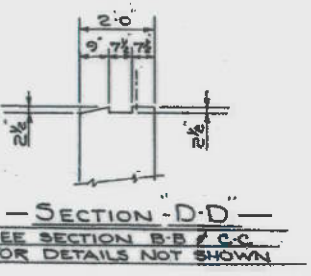

- SECTION D-D -
SEE SECTION B-B / C-C FOR DETAILS NOT SHOWN

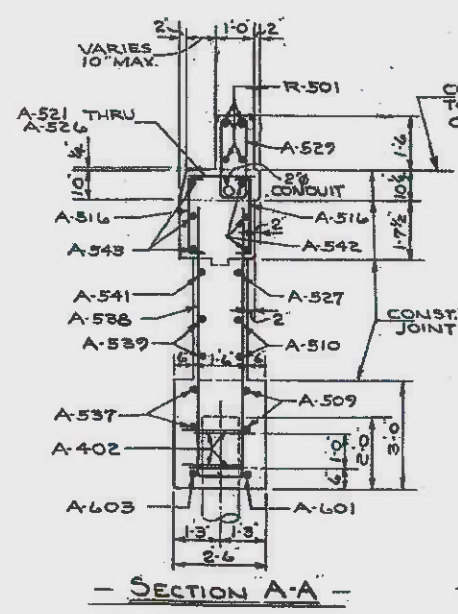

- SECTION A-A -

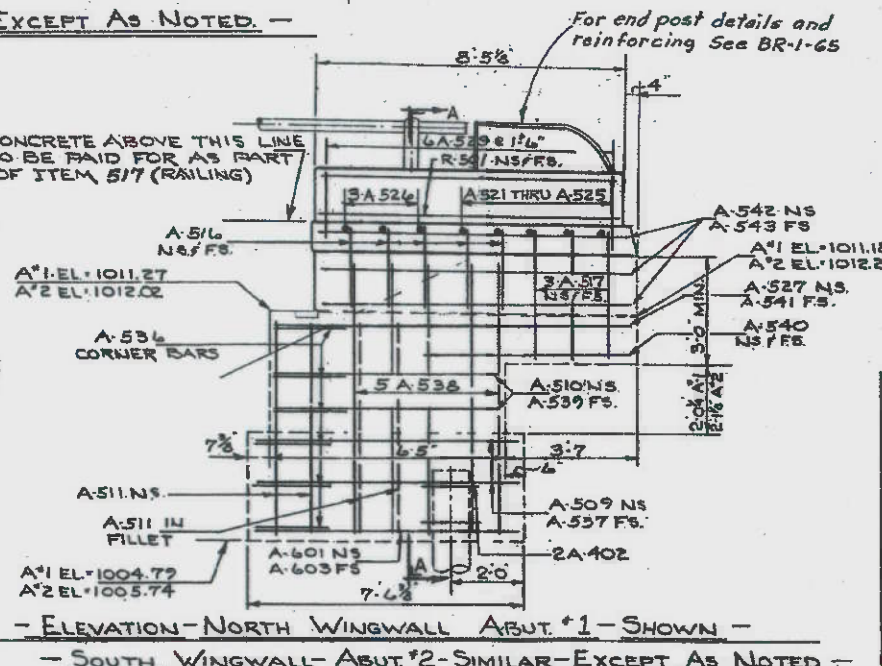

- ELEVATION - NORTH WINGWALL ABUT #1 - SHOWN -
- SOUTH WINGWALL - ABUT #2 - SIMILAR EXCEPT AS NOTED -

POROUS BACKFILL SHALL EXTEND UPWARD TO THE APPROACH SLAB AND TO THE SURFACE OF THE SHOULDERS AND OUTWARD TO WINGWALLS. EXCAVATION THEREFORE, IN EXCEPT OF THAT REQUIRED FOR CONSTRUCTION OF THE ABUTMENTS, SHALL BE CONSIDERED AS PAID FOR IN BID PRICE PER CU. YD. PAID FOR POROUS BACKFILL.

⊗ DENOTES RADIAL DIMENSION

STATE OF OHIO DEPARTMENT OF HIGHWAYS BUREAU OF BRIDGES				
BEISWENGER, HOCH & ARNOLD Consulting Engineers				
ABUTMENT DETAILS BRIDGE NO. SUM.-277-0071 OVER GLENMOUNT AVE. I-277 SUMMIT COL STA. 220+19.05 TO STA. 221+37.5				
DESIGNED R.D.H.	DRAWN J.P.	TRACED	CHECKED R.D.H.	REVIEWED DATE



MAY 21 1966

SUM-277-2.341

FED. RD.	STATE	PROJECT
2	OHIO	


SUM 277-0.46

THIS ROW OF PILES BATTERED 1:4 AT PIERS 1 & 2

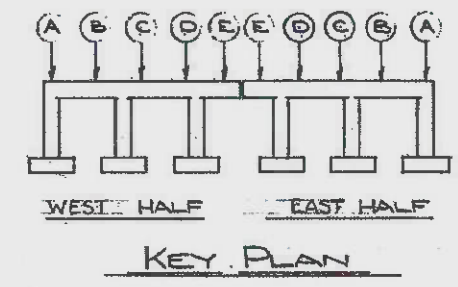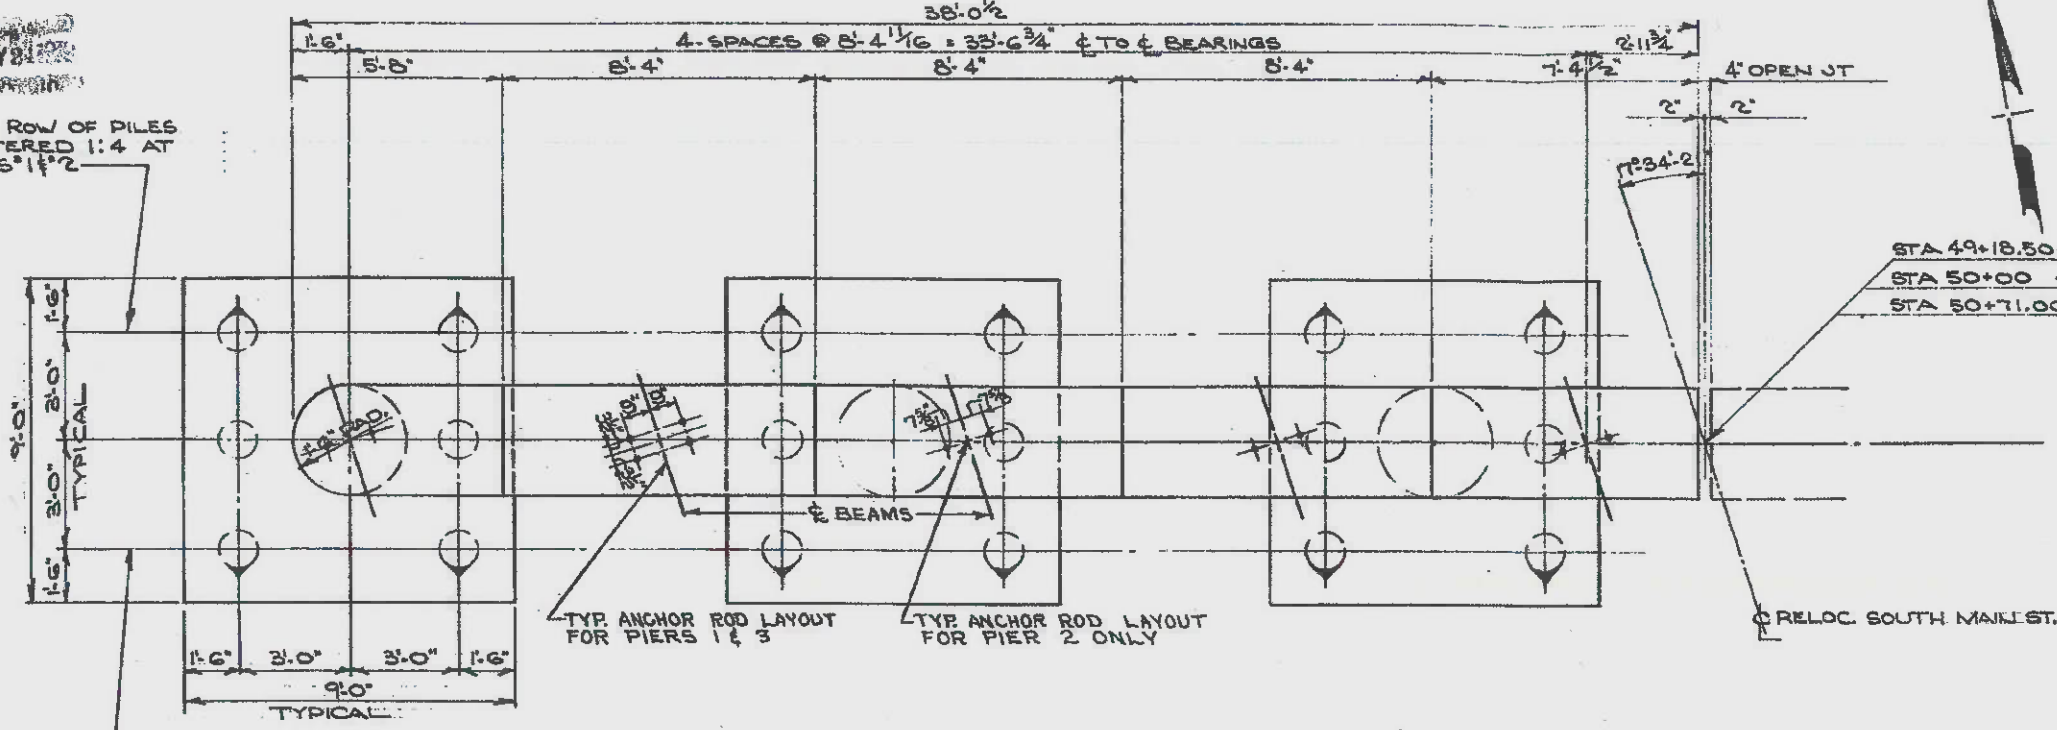


ELEVATION TABLE								
	A	B	C	D	E	F	G	H
PIER #1 WEST HALF	1008.68	1008.83	1008.98	1009.13	1009.27	1005.18	986.00	16'-2"
PIER #1 EAST HALF	1008.88	1008.98	1009.08	1009.19	1009.29	1005.18	986.00	16'-2"
PIER #2 WEST HALF	1007.65	1007.80	1007.95	1008.10	1008.25	1004.15	986.75	14'-4"
PIER #2 EAST HALF	1007.85	1007.96	1008.06	1008.16	1008.27	1004.15	986.75	14'-4"
PIER #3 WEST HALF	1006.99	1007.15	1007.32	1007.49	1007.66	1003.49	984.25	16'-2"
PIER #3 EAST HALF	1007.35	1007.44	1007.52	1007.60	1007.69	1003.49	984.25	16'-2"

PARTIAL PLAN PIERS 1, 2, & 3 - WEST HALF (AS SHOWN)
 PARTIAL PLAN PIERS 1, 2, & 3 - EAST HALF (OPPOSITE HAND EXCEPT FOR SKEW)

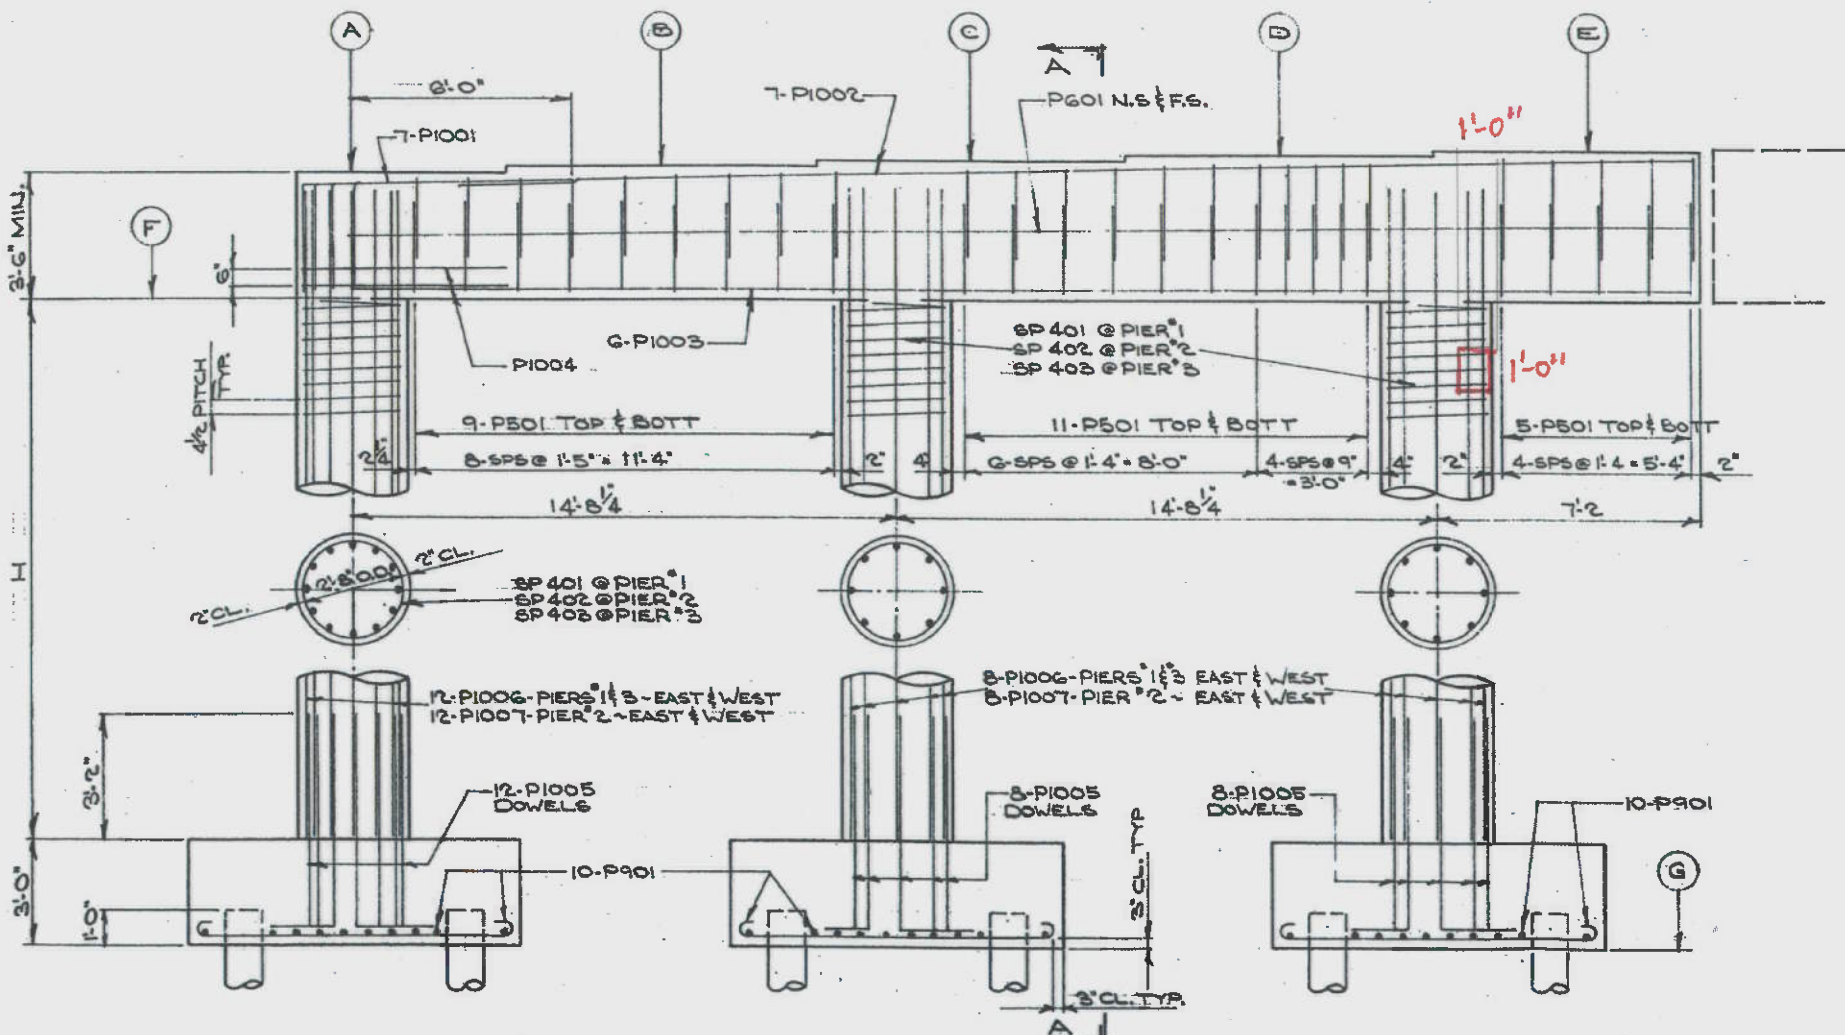

PARTIAL ELEVATION PIERS 1, 2, & 3 - WEST HALF (AS SHOWN)
 PARTIAL ELEVATION PIERS 1, 2, & 3 - EAST HALF (OPPOSITE HAND)

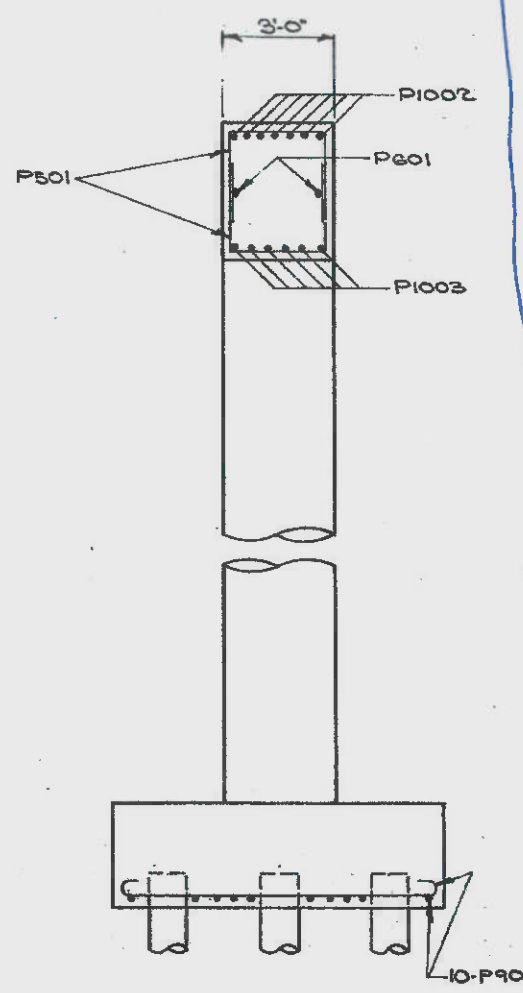

SECTION 'A-A'

Surface Area of steel within ft² Box:

- 3-#4 bar @ 1'-0" Length, 0.50" dia
 $3 \text{ bar} \times 1'-0" \times \frac{0.50}{12} = 0.125$
- 2-#10 bar @ 1'-0" Length, 1.27" dia
 $2 \text{ bar} \times 1'-0" \times \frac{1.27}{12} = 0.212$

$\Sigma \text{ steel density} = 0.125 + 0.212 = 0.337$

STATE OF OHIO
 DEPARTMENT OF HIGHWAYS
 BUREAU OF BRIDGES

BEISWENGER, HOCH & ARNO
 Consulting Engineers

PIERS 1, 2 & 3
 BRIDGE NO SUM-277-0131
 UNDER RELOC. SOUTH MAIN
 I-277 SUMMI
 STA 189+66.35

DESIGNED	DRAWN	TRACED	CHECKED	REVIEWED
JFP	JWW		CS	EDH



OHIO DEPARTMENT OF TRANSPORTATION
PLANNING & ENGINEERING DEPARTMENT, DISTRICT 4



Project _____
Desc Bridge Repair Calculations

Calc By CLB Date 2/13/24
Chk By MJA Date 3/22/24
PID/PROJ 113086

ITEM 844, CONCRETE PATCHING WITH GALVANIC ANODE PROTECTION: ANODE SPACING



SUM-76-5.910

Knowns:

1. Patch area will be on right parapet.
2. Repair length is 248' (Detail A in the plans) and 129' (Detail B in the plans).
3. For detail A repair, assume patching 25% of the total surface area.
3. For detail B repair, assume patching 100% of the total surface area.

* Estimated percentage of surface area that will need patching.

Calculation:

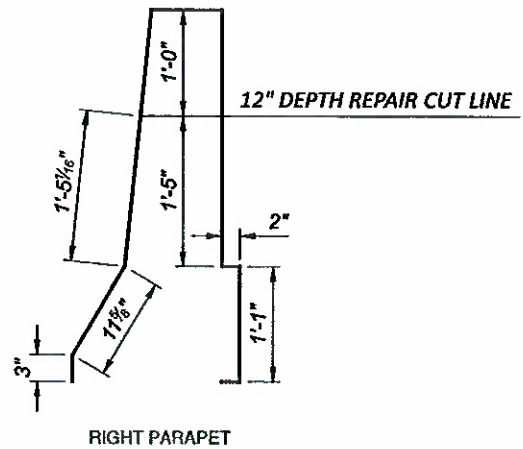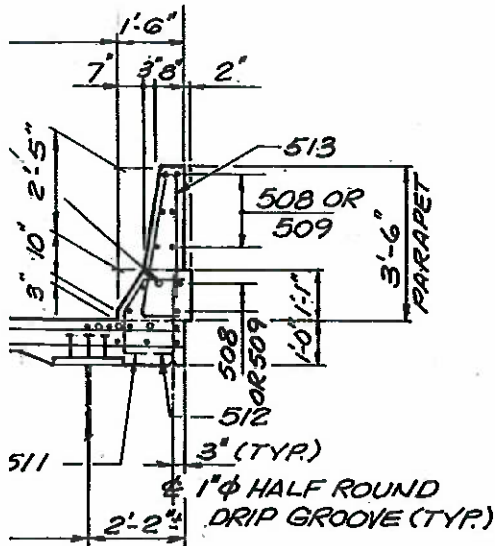

Right parapet perimeter below cut line = $3'' + (11\frac{5}{8}'') + (1'-5\frac{1}{16}'') + (1'-5'') + (2'') + (1'-1'')$
= 5.03 ft.

Detail A Surface Area = $248' \times 5.31' = 1,316.88 \text{ SF} \times (0.25)^* \approx 330 \text{ SF}$

Detail B surface Area = $129' \times 5.31' = 684.99 \text{ SF} \times (1.00)^* \approx 685 \text{ SF}$

$\Sigma = 1,015 \text{ SF}$

=> give a little more quantity,
bump to an even 1,020 SF

Project _____
Desc Bridge Repair Calculations

Calc By CLB Date 3/6/24
Chk By MSA Date 3/22/24
PID/PROJ 113086

**ITEM 509, CONCRETE REINFORCEMENT, REPLACEMENT OF EXISTING CONCRETE REINFORCEMENT
USED ON STRUCTURE SUM-76-5.790 FOR THE TYPE C SLEEPER SLAB REPAIR**

Calculations:

The repair length $\approx 4'-0''$ for Item 526 - Approach Slabs, Misc.:
Type C sleeper slab Repair.

\Rightarrow Total of 4-#5 straight bars may need replaced at
 $4'-0'' \pm$. Add additional $2'-0''$ contingency length.

$$\begin{aligned}\Rightarrow \text{Weight of Steel} &= (4 \text{ bar}) \times (6 \text{ ft}) \times (1.043 \text{ lb/ft}) \\ &\approx \underline{\underline{25 \text{ lb}}}\end{aligned}$$