LATERALS	STA. AT END	
	DEPTH	
	LENGTH	
PERMIT NUMBER		
DATE	YR.	
	DAY	
	MO.	
CONNECTION INSTALLED BY		
PROPERTY OWNER		
JUNCTION AND SIZE		
SEWER STATION		

HOR. SCALE 1" = 100' VERT. SCALE 1" = 5'

RECORD OF 8" A.C. WATER LINE EXT. HUB-SHARON RD. SEWERS AND CONNECTIONS

BEGINNING AT STA. 46 + 75 ENDING AT STA. 70 + 00

CONSTRUCTED BY CITY OF HUBBARD DATE 1972

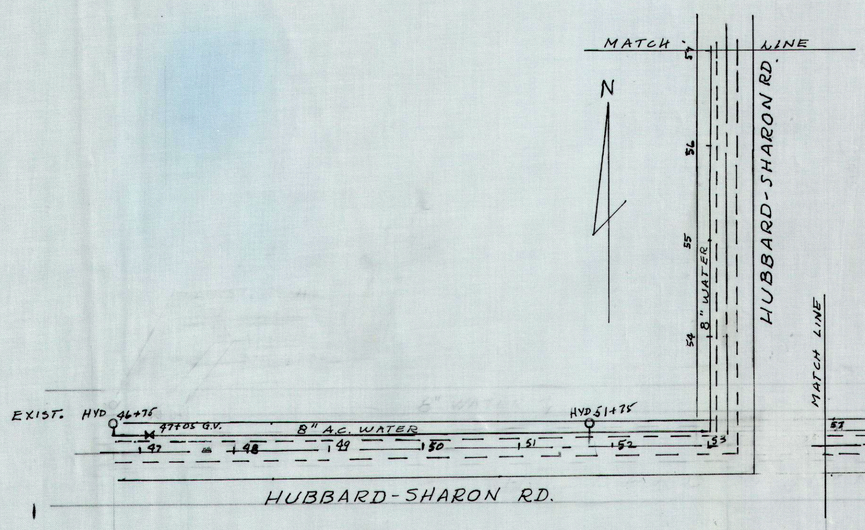

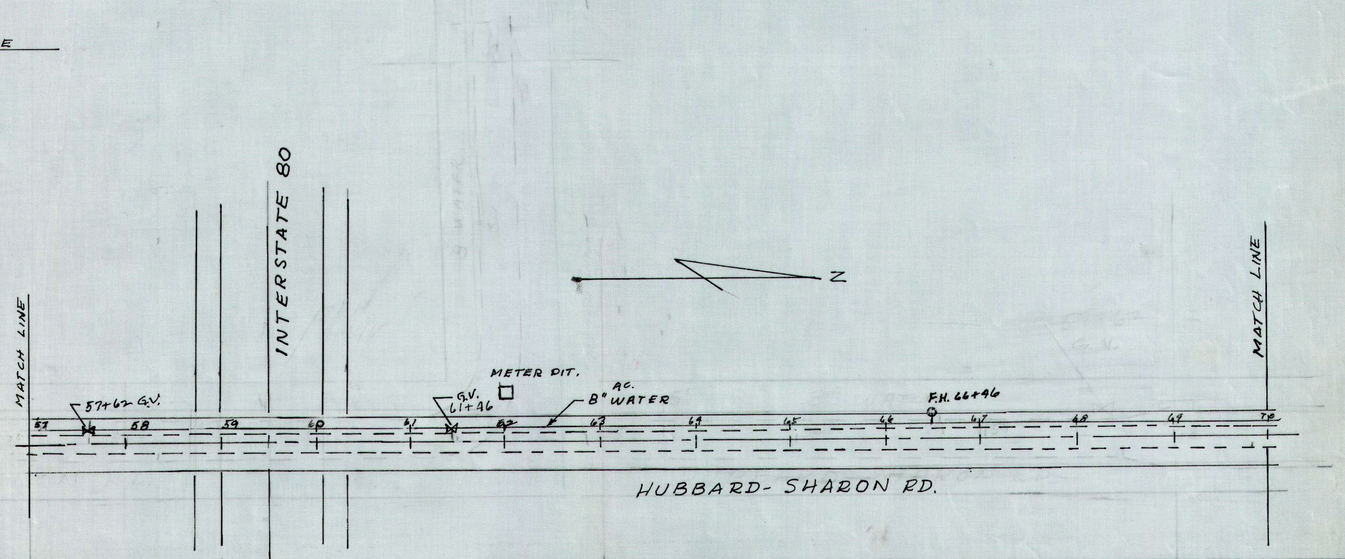

STATIONS AND ELEVATIONS