SEEDING END WIDTH	SEEDING SQ. YDS.	END AREA CUT	END AREA FILL	VOLUME CUT	VOLUME FILL
				2.92	0
		9.44	0		
				12.91	0
		4.50	0		
				4.17	0.10
		0	0.11		
				0.13	0.10
		0.14	0		
				0.30	0.17
		0.18	0.18		
25 20 15 10 5 0 5 10 15 20 25				20.43	0.37

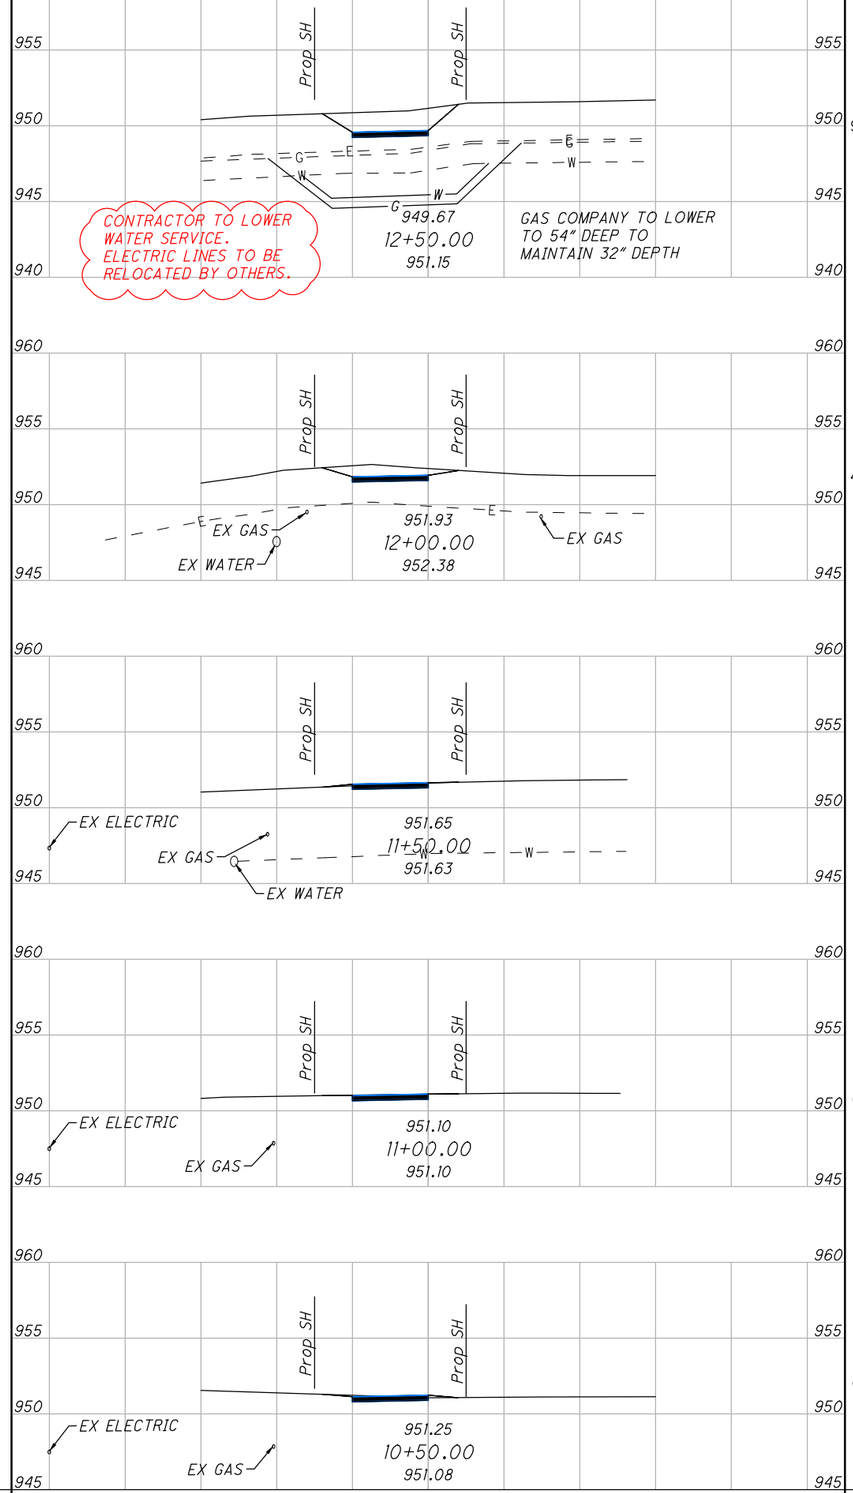

CROSS SECTION SHEET NO.	203 EXCAVATION CU YD	203 EMBANKMENT CU YD
10	3.00	1.84
11	8.52	2.87
12	22.50	0.38
CARRIED TO GEN SUMMARY	34.02	5.09

SEEDING END WIDTH	SEEDING SQ. YDS.	END AREA CUT	END AREA FILL	VOLUME CUT	VOLUME FILL
		3.70	0.02		
				1.54	0.01
		2.60	0		
				0.53	0
		3.07	0		
		3.70	0		
25 20 15 10 5 0 5 10 15 20 25				2.07	0.01

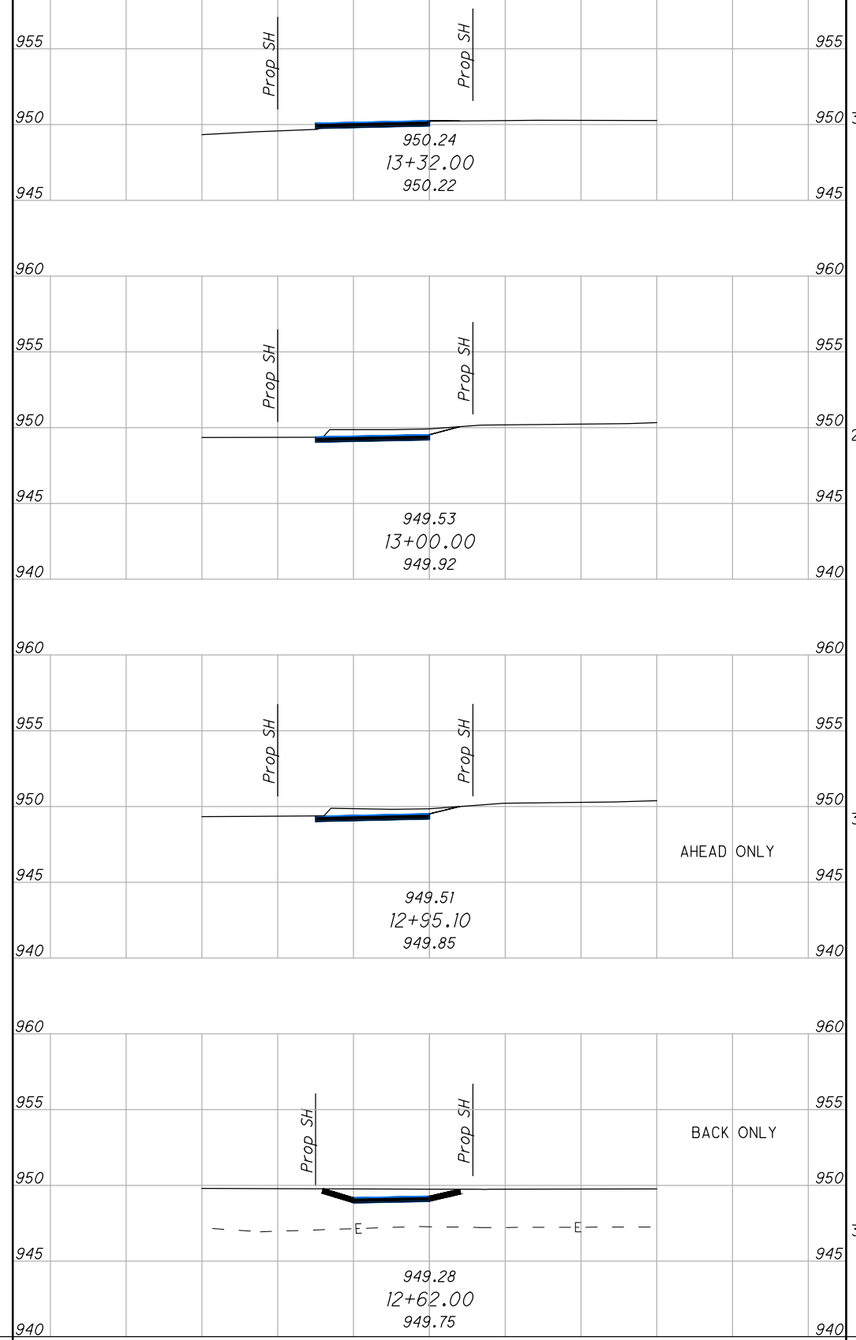

CALCULATED NK T
CHECKED BMM

CROSS SECTIONS
STA 10+50 TO STA 13+00

UNI-RICHWOOD
SRTS SIDEWALKS

12
16

P:\219851.01\Production\CD's\CROSS SECTIONS.dwg 04-Feb-21 8:19 AM