

**ITEM 204 - SUBGRADE COMPACTION AND PROOF ROLLING**

CONSTRUCT THE SUBGRADE AS FOLLOWS AND IN THE FOLLOWING SEQUENCE:

- SHAPE THE SUBGRADE TO WITHIN 0.2 FEET OF THE PLAN SUBGRADE ELEVATION.
- EXCAVATE AND REPLACE UNSUITABLE SUBGRADE BEFORE PROOF ROLLING. THE EXCAVATION LIMITS ARE SHOWN AND LABELED ON THE CROSS SECTIONS AS UNSUITABLE SUBGRADE. UNSUITABLE SUBGRADE INCLUDES UNSUITABLE SOIL (A-4B, A-2-5, A-5, A-7-5, AND SOIL WITH A LIQUID LIMIT GREATER THAN 65) AND ANY COAL, SHALE, OR ROCK WHICH NEEDS TO BE REMOVED ACCORDING TO 204.05.
- COMPACT THE SUBGRADE ACCORDING TO 204.03.
- APPROXIMATE LIMITS FOR EXCAVATION OF UNSTABLE SUBGRADE ARE SHOWN AND LABELED ON THE CROSS SECTIONS AS UNSTABLE SUBGRADE. THE ENGINEER WILL IDENTIFY THE ACTUAL LIMITS OF EXCAVATION FOR UNSTABLE SUBGRADE BASED ON THE PROOF ROLLING RESULTS AND VISUAL OBSERVATIONS.

IF THERE IS UNSUITABLE SUBGRADE IN A SHALLOW FILL LOCATION, EXCAVATE AND REPLACE THE UNSUITABLE SUBGRADE BEFORE CONSTRUCTING THE SHALLOW FILL AND SHAPING THE SUBGRADE.

PROOF ROLL THE COMPACTED SUBGRADE ACCORDING TO 204.06.

- EXCAVATE UNSTABLE SUBGRADE AS DIRECTED BY THE ENGINEER AND STABILIZE BY REPLACING WITH THE SPECIFIED MATERIALS ACCORDING TO 204.07. EXCAVATIONS WILL EXTEND 18 INCHES BEYOND THE EDGE OF THE SURFACE OF THE PAVEMENT, PAVED SHOULDERS, OR PAVED MEDIANS.
- PROOF ROLL THE STABILIZED AREAS ACCORDING TO 204.06 TO VERIFY STABILITY.
- FINE GRADE THE SUBGRADE TO THE SPECIFIED GRADE.

THE QUANTITIES FOR EXCAVATING THE UNSUITABLE SUBGRADE AND UNSTABLE SUBGRADE ARE BOTH PAID UNDER ITEM 204 EXCAVATION OF SUBGRADE.

**CONTRACTION AND/OR EXPANSION JOINTS**

ALTHOUGH SPECIFIC LOCATIONS OF CERTAIN CONTRACTION AND EXPANSION JOINTS HAVE BEEN DETAILED ON THIS PLAN, NO WAIVER OF THE SPECIFICATIONS IS INTENDED. IN ALL CASES, THE PROVISION OF EXPANSION JOINTS AT ALL MAJOR STRUCTURES INCLUDING THE MAXIMUM SPACING BETWEEN CONTRACTION JOINTS IS IN ACCORDANCE WITH STANDARD CONSTRUCTION DRAWING BP-2.2 AND THE SPECIFICATIONS.

**ITEM 872 - VOID REDUCING ASPHALT MEMBRANE**

THIS WORK CONSISTS OF FURNISHING AND INSTALLING VOID REDUCING ASPHALT MEMBRANE (VRAM) MATERIAL DURING CONSTRUCTION OF COLD LONGITUDINAL CONSTRUCTION JOINTS IN ASPHALT CONCRETE SURFACE COURSES IN ACCORDANCE WITH SUPPLEMENTAL SPECIFICATION 872. THE FOLLOWING ESTIMATED QUANTITY IS INCLUDED IN THE GENERAL SUMMARY TO COMPLETE THIS WORK:

ITEM 872 - VOID REDUCING ASPHALT MEMBRANE 35,000 FT.

**ITEM 606 - ANCHOR ASSEMBLY, MGS TYPE E (MASH2016)**

THIS ITEM SHALL CONSIST OF FURNISHING AND INSTALLING ANY OF THE GUARDRAIL END TERMINALS FOR TYPE MGS GUARDRAIL AS LISTED ON ROADWAY ENGINEERING'S WEB PAGE UNDER ROADSIDE SAFETY DEVICES FOR APPROVED GUARDRAIL END TREATMENTS. INSTALLATION SHALL BE AT THE LOCATIONS SPECIFIED IN THE PLANS, IN ACCORDANCE WITH THE MANUFACTURER'S SPECIFICATIONS.

THE FACE OF THE TYPE E IMPACT HEAD SHALL BE COVERED WITH A SHEET OF TYPE G REFLECTIVE SHEETING, PER CMS 730.19.

REFER TO THE MANUFACTURER'S INSTRUCTIONS REGARDING THE INSTALLATION OF, AND THE GRADING AROUND THE FOUNDATION TUBES AND GROUND STRUT. THE TOP OF ANY FOUNDATION TUBE SHOULD BE LESS THAN 4 INCHES ABOVE THE GROUND. THE PLACEMENT OF THE FOUNDATION TUBES SHOULD BE AN APPROPRIATE DEPTH BELOW THE LEVEL LINE IN ORDER TO MAINTAIN THE FINISHED GUARDRAIL HEIGHT OF 31 INCHES FROM THE EDGE OF THE SHOULDER.

ON-SITE GRADING IS REQUIRED IF THE TOP OF THE FOUNDATION TUBES OR TOP OF THE GROUND STRUT DOES PROJECT MORE THAN 4 INCHES ABOVE THE GROUND LINE.

PAYMENT FOR THE ABOVE WORK SHALL BE MADE AT THE UNIT PRICE BID FOR ITEM 606, ANCHOR ASSEMBLY, MGS TYPE E, EACH, AND SHALL INCLUDE ALL LABOR, TOOLS, EQUIPMENT AND MATERIALS NECESSARY TO CONSTRUCT A COMPLETE AND FUNCTIONAL ANCHOR ASSEMBLY SYSTEM, INCLUDING ALL RELATED TRANSITIONS, REFLECTIVE SHEETING, HARDWARE, GRADING, EMBANKMENT AND EXCAVATION NOT SEPARATELY SPECIFIED, AS REQUIRED BY THE MANUFACTURER.

**ANTI-SEGREGATION**

PROVIDE ANTI-SEGREGATION EQUIPMENT FOR ALL COURSES OF UNIFORM THICKNESS IN ACCORDANCE WITH CMS 401.12.

**ITEM 442 - ASPHALT CONCRETE SURFACE COURSE, 12.5MM, TYPE A (446), AS PER PLAN**

JOINT CORING IN ACCORDANCE WITH 446.04 IS NOT REQUIRED FOR COLD LONGITUDINAL JOINTS PLACED OVER VOID REDUCING ASPHALT MEMBRANE (VRAM). CONSTRUCT COLD LONGITUDINAL JOINTS OVER VRAM USING THE SAME TECHNIQUES, EQUIPMENT, AND ROLLER PATTERNS USED ON THE REST OF THE MAT. OBTAIN 10 MAT CORES FOR EACH LOT OF MATERIAL IN ACCORDANCE WITH 446.04. PAY FACTORS FOR EACH LOT OF MATERIAL WILL BE DETERMINED ACCORDING TO TABLE 446.04-2.

**CONNECTION BETWEEN EXISTING AND PROPOSED GUARDRAIL**

WHEN IT IS NECESSARY TO SPLICE PROPOSED GUARDRAIL TO EXISTING GUARDRAIL, ONLY THE EXISTING GUARDRAIL SHALL BE CUT, DRILLED, OR PUNCHED. THE CONNECTION SHALL BE MADE USING A W-BEAM, BEAM SPLICE AS SHOWN IN AASHTO M 180-12, EXCEPT THE BEAM WASHERS ARE NOT TO BE USED. PAYMENT SHALL BE INCLUDED IN THE CONTRACT PRICE FOR THE RESPECTIVE GUARDRAIL ITEMS.

**CABLE BARRIER ANCHOR ASSEMBLY**

ALL CABLE BARRIER ANCHOR ASSEMBLIES SHALL MATCH THE EXISTING CABLE BARRIER SYSTEM.

**ITEM 606 - CABLE GUARDRAIL**

THIS ITEM SHALL CONSIST OF FURNISHING AND INSTALLING ANY ONE OF THE HIGH TENSION FOUR CABLE GUARDRAIL SYSTEMS AS LISTED ON THE OFFICE OF ROADWAY ENGINEERING'S WEB PAGE. PAYMENT FOR THE ABOVE WORK SHALL BE MADE AT THE UNIT PRICE BID FOR ITEM 606, CABLE BARRIER WITH CONCRETE LINE POST FOUNDATION, AND ITEM 606 CABLE BARRIER, ANCHOR ASSEMBLY AND SHALL INCLUDE ALL LABOR, TOOLS, EQUIPMENT AND MATERIALS NECESSARY TO CONSTRUCT A COMPLETE AND FUNCTIONAL HIGH TENSION CABLE GUARDRAIL SYSTEM NOT SEPARATELY SPECIFIED, AS REQUIRED BY THE MANUFACTURER. THE LENGTH OF THE TENSIONED CABLE NECESSARY TO INSTALL A FUNCTIONAL ANCHOR SYSTEM SHALL BE INCLUDED IN ITEM 606, CABLE BARRIER WITH CONCRETE LINE POST FOUNDATION.

INSTALLATION SHALL BE AT THE LOCATIONS SPECIFIED IN THE PLANS, IN ACCORDANCE WITH THE MANUFACTURER'S SPECIFICATIONS.

SYSTEMS SHALL HAVE A MAXIMUM DEFLECTION OF 8 FEET AND THE MAXIMUM LONGITUDINAL DISTANCE BETWEEN POSTS SHALL BE 15 FEET.

INSTALLATION WILL BE A FOUR CABLE HIGH TENSION SYSTEM INSTALLED IN SOCKETED POSTS FOUNDATION WITH A FOUR FOOT WIDE "NO MOW STRIP".

DELINEATE THE CABLE BARRIER USING TYPE 6 BARRIER REFLECTORS PER ITEM 626 OR USING FLEXIBLE POSTS PER ITEM 620 AS CALLED FOR IN THE PLANS OR DIRECTED BY THE ENGINEER.

ANCHOR TERMINAL STRUTS SHALL BE COVERED COMPLETELY ON BOTH SIDES WITH YELLOW TYPE J, ASTM D 4956 TYPE XI REFLECTIVE SHEETING, PER CMS 730.193.

TRANSITIONS TO W-BEAM GUARDRAIL ARE NOT ALLOWED.

REFER TO MANUFACTURER FOR MAXIMUM OFFSET FROM BREAK POINT.

TORPEDO OR BULLET SPLICES ARE NOT ALLOWED. ALL CABLE SPLICES SHALL BE A SWAGED OR OPEN BODY DESIGN THAT ALLOWS FOR ANNUAL INSPECTION BETWEEN THE WEDGE AND STRANDS OF CABLE.

POSTS ARE SET IN SOCKETED CONCRETE FOUNDATIONS AND SHALL NOT BE PERMANENTLY INSTALLED UNTIL THEIR RESPECTIVE RUNS OF TENSIONED CABLE GUARDRAIL ARE READY FOR FINAL CONNECTION TO THE END TERMINAL ASSEMBLY. THE CONTRACTOR SHALL REPLACE ANY POSTS DAMAGED DURING INSTALLATION AS DETERMINED BY THE ENGINEER AT NO ADDITIONAL COST TO THE STATE.

**CEMENT STABILIZED SUBGRADE**

THE ROADWAY SUBGRADE SHALL BE CEMENT STABILIZED AS DESIGNATED IN THE TYPICAL SECTIONS. ALL CEMENT STABILIZATION SHALL BE 14 INCHES DEEP AND SHALL BE CONSTRUCTED PER THE REQUIREMENTS STATED IN C&MS SPECIFICATION ITEM 206. FOR ESTIMATING CEMENT, A SPREAD RATE OF FIVE PERCENT PER A SOIL DRY UNIT WEIGHT OF 115 POUNDS PER CUBIC FOOT WAS USED.

THE FOLLOWING ESTIMATED QUANTITIES ARE INCLUDED IN THE GENERAL SUMMARY TO COMPLETE THE WORK NOTED ABOVE:

ITEM 206 - CEMENT	2955 TON
ITEM 206 - CURING COAT	97800 SY
ITEM 206 - TEST ROLLING	50 HOURS
ITEM 206 - MIXTURE DESIGN FOR CHEMICALLY STABILIZED SOIL	1 LUMP

**ITEM 254 - PAVEMENT PLANING, ASPHALT CONCRETE: S.R. 33 AND S.R. 161**

THE CONTRACTOR SHALL BE TOTALLY RESPONSIBLE FOR ANY AND ALL DAMAGE TO THE CONTRACTORS EQUIPMENT THAT MAY RESULT FROM THE PLANING OPERATION, INCLUDING DAMAGE CAUSED BY CASTINGS AND LOOP DETECTORS. THE DEPTH OF PLANING CLOSE TO THE CASTINGS SHALL BE AS DIRECTED; TO ACHIEVE A SMOOTH RIDING FINISHED PAVEMENT. GREAT CARE SHALL BE TAKEN TO PREVENT THE REMOVAL OF THE EXISTING PAVEMENT CROSS-SLOPE (CROWN) DURING THE PLANING OPERATIONS.

ALL PLANED PAVEMENT SHALL BE PLANED AND RESURFACED AS INDICATED ON THE TYPICAL SECTIONS WITHIN THE SAME WORK PERIOD. FAILURE TO MEET THIS REQUIREMENT WILL SUBJECT THE CONTRACTOR TO A DISINCENTIVE OF \$XXXX/DAY FOR EACH DAY THE PLANED SURFACE IS NOT RESURFACED.

**CROSSINGS AND CONNECTIONS TO EXISTING PIPES AND UTILITIES**

WHERE PLANS PROVIDE FOR A PROPOSED CONDUIT TO BE CONNECTED TO, OR CROSS OVER OR UNDER AN EXISTING SEWER OR UNDERGROUND UTILITY, THE CONTRACTOR SHALL LOCATE THE EXISTING PIPES OR UTILITIES BOTH AS TO LINE AND GRADE BEFORE STARTING TO LAY THE PROPOSED CONDUIT.

IF IT IS DETERMINED THAT THE ELEVATION OF THE EXISTING CONDUIT, OR EXISTING APPURTENANCE TO BE CONNECTED, DIFFERS FROM THE PLAN ELEVATION OR RESULTS IN A CHANGE IN THE PLAN CONDUIT SLOPE, THE ENGINEER SHALL BE NOTIFIED BEFORE STARTING CONSTRUCTION OF ANY PORTION OF THE PROPOSED CONDUIT WHICH WILL BE AFFECTED BY THE VARIANCE IN THE EXISTING ELEVATIONS.

IF IT IS DETERMINED THAT THE PROPOSED CONDUIT WILL INTERSECT AN EXISTING SEWER OR UNDERGROUND UTILITY IF CONSTRUCTED AS SHOWN ON THE PLAN, THE ENGINEER SHALL BE NOTIFIED BEFORE STARTING CONSTRUCTION OF ANY PORTION OF THE PROPOSED CONDUIT WHICH WOULD BE AFFECTED BY THE INTERFERENCE WITH AN EXISTING FACILITY.

PAYMENT FOR ALL THE OPERATIONS DESCRIBED ABOVE SHALL BE INCLUDED IN THE CONTRACT PRICE FOR THE PERTINENT 611 CONDUIT ITEM.

**U.S. 33 SUPERELEVATION**

THE WORK PROPOSED BY THIS PROJECT DOES NOT ALTER THE EXISTING SUPERELEVATION ALONG U.S. 33. FOR THE RESURFACING OF THE SUPERELEVATED SECTIONS, MATCH THE EXISTING CROSS SLOPE.

**ITEM 670 - SLOPE EROSION PROTECTION**

ITEM 670, SLOPE EROSION PROTECTION SHALL BE PROVIDED ON SLOPES STEEPER THAN 3:1. THE QUANTITY BELOW HAS BEEN CARRIED TO THE GENERAL SUMMARY FOR THIS WORK.

ITEM 670 - SLOPE EROSION PROTECTION 18,500 SY

**ITEM 601 - 6" CONCRETE SLOPE PROTECTION, APP**

6" CONCRETE SLOPE PROTECTION, SHALL BE CONSTRUCTED IN ACCORDANCE WITH ITEM 601, EXCEPT THE BLOCK GRID PATTERN SHALL BE SPACED AS SHOWN ON SHEET 35

NO.	DESCRIPTION	REV. BY	DATE
B <td>ADDED NOTE <td>ENR <td>2-28-2022</td> </td></td>	ADDED NOTE <td>ENR <td>2-28-2022</td> </td>	ENR <td>2-28-2022</td>	2-28-2022

P:\PR41806\Fra\80748\Roadway\sheets\80748GN001.dgn

CALCULATED  
KOD  
CHECKED  
MAH

GENERAL NOTES

UNI - 33 - 24.87

**PIPE CONNECTIONS TO CORRUGATED METAL STRUCTURES**

CONNECTIONS OF PROPOSED LONGITUDINAL DRAINAGE TO CORRUGATED METAL STRUCTURES SHALL BE MADE BY MEANS OF A SHOP FABRICATED OR FIELD WELDED STUB ON THE STRUCTURE. THE STUB SHALL MEET THE REQUIREMENTS OF 707 AND HAVE A MINIMUM LENGTH OF 2 FEET AND A MINIMUM WALL THICKNESS OF 0.064 INCHES.

THE LOCATION AND ELEVATION OF THE STUB ARE TO BE CONSIDERED APPROXIMATE AND MAY BE ADJUSTED BY THE ENGINEER TO AVOID CUTTING THROUGH JOINTS IN THE STRUCTURE.

THE FIELD WELDED JOINT, IF USED, SHALL BE THOROUGHLY CLEANED AND REGALVANIZED OR OTHERWISE SUITABLY REPAIRED. WELDING SHALL MEET THE REQUIREMENTS OF 513.21.

A MASONRY COLLAR, AS PER STANDARD DRAWING DM-1.1, WILL BE REQUIRED TO CONNECT THE LONGITUDINAL DRAINAGE TO THE STUB, WHEN PIPE OTHER THAN CORRUGATED METAL IS PROVIDED FOR THE LONGITUDINAL DRAINAGE.

PAYMENT FOR CUTTING INTO THE STRUCTURE AND PROVIDING THE CONNECTION DESCRIBED, SHALL BE INCLUDED IN THE CONTRACT PRICE FOR ITEM 611 OR 522.

**FARM DRAINS**

ALL FARM DRAINS, WHICH ARE ENCOUNTERED DURING CONSTRUCTION, SHALL BE PROVIDED WITH UNOBSTRUCTED OUTLETS. EXISTING COLLECTORS WHICH ARE LOCATED BELOW THE ROADWAY DITCH ELEVATIONS, AND WHICH CROSS THE ROADWAY, SHALL BE REPLACED WITHIN THE (RIGHT OF WAY) (CONSTRUCTION) LIMITS BY ITEM 611 CONDUIT, TYPE B, ONE COMMERCIAL SIZE LARGER THAN THE EXISTING CONDUIT.

EXISTING COLLECTORS AND ISOLATED FARM DRAINS, WHICH ARE ENCOUNTERED ABOVE THE ELEVATION OF ROADWAY DITCHES, SHALL BE OUTLETTED INTO THE ROADWAY DITCH BY 611 TYPE F CONDUIT. THE OPTIMUM OUTLET ELEVATION SHALL BE ONE FOOT ABOVE THE FLOWLINE ELEVATION OF THE DITCH. LATERAL FIELD TILES WHICH CROSS THE ROADWAY SHALL BE INTERCEPTED BY 611, TYPE E CONDUIT, AND CARRIED IN A LONGITUDINAL DIRECTION TO AN ADEQUATE OUTLET OR ROADWAY CROSSING.

THE LOCATION, TYPE, SIZE AND GRADE OF REPLACEMENTS SHALL BE DETERMINED BY THE ENGINEER AND PAYMENT SHALL BE MADE ON FINAL MEASUREMENTS.

EROSION CONTROL PADS SHALL BE PROVIDED AT THE OUTLET END OF ALL FARM DRAINS AS PER STANDARD CONSTRUCTION DRAWING DM-1.1, EXCEPT WHEN THEY OUTLET INTO A DRAINAGE STRUCTURE. PAYMENT FOR THE EROSION CONTROL PADS AND ANY NECESSARY BENDS OR BRANCHES SHALL BE INCLUDED FOR PAYMENT IN THE PERTINENT CONDUIT ITEMS.

THE FOLLOWING ESTIMATED QUANTITIES HAVE BEEN INCLUDED IN THE GENERAL SUMMARY FOR THE WORK NOTED ABOVE:

- 611 6" CONDUIT, TYPE B 500 FT.
- 611 6" CONDUIT, TYPE F 500 FT.
- 611 12" CONDUIT, TYPE C 500 FT.
- 601 ROCK CHANNEL PROTECTION TYPE C WITH FILTER 10 CU. YD.

NO.	DESCRIPTION	REV. BY	DATE
A	UPDATE NOTES	ENR	2-3-2022
B	UPDATE NOTES	ENR	2-28-2022

**REVIEW OF DRAINAGE FACILITIES**

BEFORE ANY WORK IS STARTED ON THE PROJECT AND AGAIN BEFORE FINAL ACCEPTANCE BY THE STATE, REPRESENTATIVES OF THE STATE AND THE CONTRACTOR, ALONG WITH LOCAL REPRESENTATIVES, SHALL MAKE AN INSPECTION OF ALL EXISTING SEWERS WHICH ARE TO REMAIN IN SERVICE AND WHICH MAY BE AFFECTED BY THE WORK. THE CONDITION OF THE EXISTING CONDUITS AND THEIR APPURTENANCE SHALL BE DETERMINED FROM FIELD OBSERVATIONS. RECORDS OF THE INSPECTION SHALL BE KEPT IN WRITING BY THE STATE.

ALL NEW CONDUITS, INLETS, CATCH BASINS, AND MANHOLES CONSTRUCTED AS A PART OF THE PROJECT SHALL BE FREE OF ALL FOREIGN MATTER AND IN A CLEAN CONDITION BEFORE THE PROJECT WILL BE ACCEPTED BY THE STATE.

ALL EXISTING SEWERS INSPECTED INITIALLY BY THE ABOVE MENTIONED PARTIES SHALL BE MAINTAINED AND LEFT IN A CONDITION REASONABLY COMPARABLE TO THAT DETERMINED BY THE ORIGINAL INSPECTION. ANY CHANGE IN THE CONDITION RESULTING FROM THE CONTRACTOR'S OPERATIONS SHALL BE CORRECTED BY THE CONTRACTOR TO THE SATISFACTION OF THE ENGINEER.

PAYMENT FOR ALL OPERATIONS DESCRIBED ABOVE SHALL BE INCLUDED IN THE CONTRACT PRICE FOR THE PERTINENT 611 CONDUIT ITEMS.

**MANHOLES, CATCH BASINS AND INLETS REMOVED OR ABANDONED**

ALL CASTINGS SHALL BE CAREFULLY REMOVED AND STORED WITHIN THE RIGHT OF WAY FOR SALVAGE BY (STATE) (CITY) (VILLAGE) (COUNTY) FORCES.

PAYMENT FOR ALL OF THE ABOVE SHALL BE INCLUDED IN THE CONTRACT PRICE FOR THE PERTINENT 202 ITEM.

**EXISTING SUBSURFACE DRAINAGE**

PROVIDE UNOBSTRUCTED OUTLETS FOR ALL EXISTING UNDERDRAINS OR AGGREGATE DRAINS ENCOUNTERED DURING CONSTRUCTION.

PROVIDE AN OUTLET PER STANDARD CONSTRUCTION DRAWING DM-1.1 FOR ALL UNDERDRAINS THAT OUTLET TO A SLOPE. UNDERDRAINS THAT CAN BE CONNECTED TO THE NEW OR EXISTING UNDERDRAINS AT THE END OF THE PROJECT LIMITS AS WELL AS ALL NECESSARY BENDS OR BRANCHES REQUIRED FOR CONNECTION ARE INCLUDED IN THE BASIS OF PAYMENT FOR UNCLASSIFIED PIPE UNDERDRAINS.

THE FOLLOWING ESTIMATED QUANTITIES HAVE BEEN INCLUDED IN THE GENERAL SUMMARY FOR THE WORK NOTED ABOVE:

- 601, TIED CONCRETE BLOCK MAT, TYPE 1 10 SQ. YD.
- 605, BASE PIPE UNDERDRAINS 500 FT.
- 605, SHALLOW PIPE UNDERDRAINS 500 FT
- 611, 6" CONDUIT, TYPE F 100 FT.
- 611, PRECAST REINFORCED CONCRETE OUTLET 5 EACH

**ITEM 202 PAVEMENT REMOVED, AS PER PLAN**

THIS WORK IS FOR REMOVAL AND DISPOSAL OF CONCRETE AND ASPHALT PAVEMENT. ALL OTHER RIGID REMOVAL (CURBS, WALKS, MEDIANS, ETC.) WILL BE PAID UNDER THE APPROPRIATE ITEM.

**PIPE AND UTILITIES WITHIN SUBGRADE STABILIZATION**

ALL PIPES AND UTILITIES THAT MAY INTERFERE WITH THE SUBGRADE STABILIZATION PROCESS (LOCATED 16" OR LESS BELOW THE SUBGRADE SHALL BE FLAGGED BEFORE THE STABILIZATION PROCESS BEGINS TO ALERT THOSE INVOLVED TO BE CAUTIOUS IT THOSE AREAS.

THE FOLLOWING IS A LIST OF LOCATIONS WHERE INTERFERENCE IS ANTICIPATED. THIS LIST IS NOT INTENDED TO BE ALL INCLUSIVE, IT IS THE CONTRACTORS RESPONSIBILITY TO VERIFY EACH CROSSING PRIOR TO STABILIZING.

STORM SEWERS AND CULVERTS AT STATIONS: 51+50, 65+73, 69+31, 72+39, 401+25, 608+00, 708+00, 805+00, 918+50, 3055+43, 3071+39 AT&T FIBER OPTIC STATIONS: 64+00 TO 70+00

PAYMENT FOR THIS ITEM SHALL BE INCLUDED IN THE PRICE BID FOR ITEM 206, CEMENT STABILIZED SUBGRADE.

**UNDERDRAINS IN SUBGRADE STABILIZATION**

WHEN AN EXISTING UNDERDRAIN IS FOUND TO BE WITHIN THE LIMITS OF THE SUBGRADE STABILIZATION, IT SHALL BE REMOVED AND REPLACED. THE NEW UNDERDRAIN SHALL PLACED SO THAT THE CROWN OF THE UNDERDRAIN IS AT THE BOTTOM OF THE SUBGRADE STABILIZATION. THE NEW UNDERDRAIN SHALL BE CONNECT TO THE ADJOINING UNDERDRAINS AS LONG AS THERE IS POSITIVE SLOPE. IF THERE IS NOT POSITIVE SLOPE A NEW UNDERDRAIN OUTLET SHOULD BE ESTABLISHED.

THE FOLLOWING ESTIMATED QUANTITIES HAVE BEEN INCLUDED IN THE GENERAL SUMMARY FOR USE AS APPROVED BY THE ENGINEER FOR REMOVING AND REPLACING UNDERDRAINS:

- 601, TIED CONCRETE BLOCK MAT, TYPE 1 10 SQ YD
- 605, BASE PIPE UNDERDRAINS 500 FT
- 605, SHALLOW PIPE UNDERDRAIN 500 FT
- 611, CONDUIT, TYPE F 100 FT
- 611, PRECAST REINFORCED CONCRETE OUTLET 5 EACH

**ITEM 602 CONCRETE MASONRY, AS PER PLAN**

THE OUTLETS OF ALL NEW STORM SEWER AND CULVERT PIPE LOCATED WITHIN THE DUBLIN CORPORATION LIMITS, WHERE CALLED OUT IN THE PLANS, SHALL HAVE A PREFABRICATED FLARED END SECTION. FLARED END SECTIONS 24 AND LARGER SHALL BE PRECAST CONCRETE AS MANUFACTURED BY FORTERRA PIPE AND PRECAST, OR APPROVED EQUAL. THIS WORK SHALL INCLUDE ALL LABOR, MATERIALS, EQUIPMENT, AND INCIDENTALS REQUIRED TO INSTALL THE HEADWALL (FLARED END SECTION), COMPLETE AND ACCEPTED.

**EXISTING UNDERDRAINS**

EXISTING UNDERDRAINS ALONG U.S. 33 SHALL REMAIN IN USE, EXCEPT WITHIN THE FOLLOWING LIMITS WHERE THEY SHALL BE ABANDONED OR REMOVED:

- U.S. 33 EB STA. 2008+56.35 TO STA. 2043+71.69
- U.S. 33 WB STA. 3000+62.62 TO STA. 3043+71.69

WHERE EXISTING UNDERDRAINS ARE TO REMAIN IN USE ADJACENT TO SAW CUTTING AND FULL- DEPTH PAVEMENT WIDENING, THE CONTRACTOR IS TO ENSURE THAT THE EXISTING AGGREGATE BASE CONTINUES TO DRAIN TO THE EXISTING UNDERDRAIN. NO SUBGRADE STEP SHALL BE CONSTRUCTED, BLOCKING SUBGRADE DRAINAGE. ANY ADDITIONAL COSTS FOR THIS SHALL BE INCIDENTAL TO THE CONSTRUCTION OF ITEM 304, AGGREGATE BASE.

**EXTENDED RETENTION BASIN**

THIS PLAN UTILIZES EXTENDED RETENTION BASIN(S) FOR POST CONSTRUCTION STORM WATER TREATMENT. RETENTION BASINS MAY BE USED AS SEDIMENT CONTROL DEVICES DURING CONSTRUCTION. FOLLOWING STABILIZATION OF THE TRIBUTARY AREA, FINAL GRADING OF THE RETENTION BASIN MUST MATCH THE PLANS. THE RETENTION BASIN OUTLET STRUCTURE FOR CONSTRUCTION SEDIMENT CONTROL MUST BE REMOVED AND THE OUTLET STRUCTURE MUST BE MADE TO MATCH THE DESIGN SHOWN IN THE PLANS.

**ITEM 611 - MANHOLE RECONSTRUCTED TO GRADE, AS PER PLAN**

THIS ITEM SHALL MEET ALL THE REQUIREMENTS OF ITEM 611, MANHOLE RECONSTRUCTED TO GRADE, AS PER PLAN EXCEPT AS MODIFIED BY THIS NOTE. THE INTENT OF THIS ITEM IS TO ADJUST THE CASTING DOWN TO THE PLAN ELEVATION. THE CHANGE IN ELEVATION IS OUTSIDE THAT ALLOWABLE TO ADJUST TO GRADE. THE CONTRACTOR SHALL REMOVE EXISTING RISER SECTIONS OF THE MANHOLE FAR ENOUGH DOWN SO IT CAN ADJUSTED TO THE PLAN ELEVATION. THE NEW PORTION OF THE MANHOLE SHALL COMPLY WITH CITY OF DUBLIN STANDARD DETAIL SA-01.

PAYMENT FOR THIS ITEM SHALL BE MADE AT THE CONTRACT UNIT PRICE BID FOR EACH MANHOLE RECONSTRUCTED TO GRADE, AS PER PLAN AND SHALL BE FULL COMPENSATION FOR ALL MATERIALS, LABOR, EQUIPMENT AND INCIDENTALS NECESSARY TO COMPETE THIS ITEM.

**ENVIRONMENTAL COMMITMENT NOTES**

THE CONTRACTOR WILL INSTALL TEMPORARY SILT FENCING ALONG THE BOUNDARY OF WETLAND 1 BETWEEN STA. 911+00 TO STA. 915+00 TO PREVENT THE EQUIPMENT FROM ENTERING THE AREA AND IMPLEMENT BEST MANAGEMENT PRACTICES (BMP) FOR EROSION AND SEDIMENT CONTROL TO PREVENT STORMWATER RUN-OFF FROM ENTERING THE WETLAND.

**ENDANGERED BAT HABITAT REMOVAL**

THIS PROJECT IS LOCATED WITHIN THE KNOWN HABITAT RANGES OF THE FEDERALLY LISTED AND PROTECTED INDIANA BAT, AND NORTHERN LONG-EARED BAT. NO TREES SHALL BE REMOVED UNDER THIS PROJECT FROM APRIL 1 THROUGH SEPTEMBER 30. ALL NECESSARY TREE REMOVAL SHALL OCCUR FROM OCTOBER 1 THROUGH MARCH 31. THIS REQUIREMENT IS NECESSARY TO AVOID AND MINIMIZE IMPACTS TO THESE SPECIES AS REQUIRED BY THE ENDANGERED SPECIES ACT (ESA). FOR THE PURPOSES OF THIS NOTE, A TREE IS DEFINED AS: A LIVE, DYING, OR DEAD WOODY PLANT, WITH A TRUNK 3 INCHES OR GREATER IN DIAMETER AT A HEIGHT OF 4.5 FEET ABOVE THE GROUND SURFACE, AND WITH A MINIMUM HEIGHT OF 13 FEET.

**ITEM SPECIAL - MISC: HEAVY DUTY BRICK PAVERS INCLUDING CONCRETE BASE**

HEAVY DUTY BRICK PAVERS INCLUDING CONCRETE BASE, BITUMINOUS SETTING BED, ASPHALT ADHESIVE, BRICK PAVERS, AND POLYMERIC SAND FILL, SHALL BE CONSTRUCTED IN ACCORDANCE TO THE DETAIL ON SHEET 34.

THE SUBGRADE COMPACTION AND 304 AGGREGATE BASE ARE QUANTIFIED AND PAID UNDER SEPARATE ITEMS.

PAYMENT FOR THIS WORK, INCLUDING ALL LABOR, TOOLS, EQUIPMENT AND NECESSARY MATERIALS, SHALL BE MADE AT THE UNIT PRICE BID PER SQ. FT., COMPLETE IN PLACE, AND ACCEPTED.

P:\PR41806\Fra\80748\roadway\sheet\80748GN001.dgn

CALCULATED  
KOD  
CHECKED  
MAH

GENERAL NOTES

UNI - 33 - 24.87

SHEET NO.	MOT PHASE	254	411	442	614	614	614	614	614	614	614	614	614	615	622	622	622	614	614	614	614								
		SY	CY	CY	FT	EACH	EACH	EACH	EACH	MILE	MILE	FT	FT	EACH	SY	FT	FT	FT	MILE	MILE	FT	FT							
60	- 61							4		19	19		0.21	529															
63	- 64						113	8		26	26		0.37	82		874	2	2401		250	1080								
65	- 67																												
							163	12		111	111		0.51	1.29	210	1301	4	117		4035	1455								
68	- 71																												
							556	16		110	110		0.013	1.61			981	1		5475									
72	- 73																												
													0.03	618	71					282	209								
74	- 75						383	3		37	37		0.13	394	484	5				1870									
76	- 80						8511	2840	1047	1028	16	375	353	353						4261	2	16920	470	6.23	2.71	4827	1595		
81	- 84									673	13		82	82						168	2	3120	500	2.22	0.19	4209	420		
85	- 88									705	6		86	86							4250		3.17	1.15	1010	1897			
89	- 90									582	5		30	30						692		1510		1.82	0.04	4205	914		
<table border="1" style="width: 100%; border-collapse: collapse;"> <tr> <td style="width: 10%;">NO.</td> <td style="width: 70%;">DESCRIPTION</td> <td style="width: 10%;">REV. BY</td> <td style="width: 10%;">DATE</td> </tr> <tr> <td>B</td> <td>ITEM UPDATES</td> <td>EMW</td> <td>2-28-2022</td> </tr> </table>																						NO.	DESCRIPTION	REV. BY	DATE	B	ITEM UPDATES	EMW	2-28-2022
NO.	DESCRIPTION	REV. BY	DATE																										
B	ITEM UPDATES	EMW	2-28-2022																										
<b>MAINTENANCE OF TRAFFIC SUMMARY</b> <b>TOTALS CARRIED TO GENERAL SUMMARY</b>		8511	2841	1047	4203	83	375	854	854	0.53	3.64	1833	3711	22	10288	4	37430	4395	13.44	4.09	14251	4826							

**MAINTENANCE OF TRAFFIC SUBSUMMARY**

**UNI -33-24.87**



P:\PR418060aa\fra\80748\roadway\sheet\GC003.dgn

SHEET NUM.										PART.		ITEM	ITEM EXT	GRAND TOTAL	UNIT	DESCRIPTION	SEE SHEET NO.	
48	109	110	111	108	122	585	601	37		01/NHS/PV	02/S>2/PV							
					1						1	611	99851	1	EACH	WATER QUALITY BASIN, RETENTION, AS PER PLAN	582	
																PAVEMENT		
	4,635										4,635	254	01000	4,635	SY	PAVEMENT PLANING, ASPHALT CONCRETE, 1.5"		
	47,759										46,451	1,308	254	01000	47,759	SY	PAVEMENT PLANING, ASPHALT CONCRETE, VARIABLE DEPTH	
	697										697	301	46000	697	CY	ASPHALT CONCRETE BASE, PG64-22		
	19,404										12,226	7,178	302	46000	19,404	CY	ASPHALT CONCRETE BASE, PG64-22	
	12,869	3,539	1,584	692							12,626	6,058	304	20000	18,684	CY	AGGREGATE BASE	
			238								238		305	16010	238	SY	12" CONCRETE BASE, CLASS QC 1P	
	16,436										12,693	3,743	407	20000	16,436	GAL	NON-TRACKING TACK COAT	
	155											155	441	50101	155	CY	ASPHALT CONCRETE SURFACE COURSE, TYPE 1, (448), AS PER PLAN	9
	9,333										6,606	2,727	442	00100	9,333	CY	ANTI-SEGREGATION EQUIPMENT	
	5,056										3,550	1,506	442	10001	5,056	CY	ASPHALT CONCRETE SURFACE COURSE, 12.5 MM, TYPE A (446), AS PER PLAN, PG 70-22M	37
	3,224										1,756	1,468	442	10100	3,224	CY	ASPHALT CONCRETE INTERMEDIATE COURSE, 19 MM, TYPE A (446)	
	2,258										2,258		442	10100	2,258	CY	ASPHALT CONCRETE INTERMEDIATE COURSE, 19 MM, TYPE A (446), 1.75	
		19,498	7,785								27,283		452	14020	27,283	SY	10" NON-REINFORCED CONCRETE PAVEMENT, CLASS QC 1P WITH QC/QA	
				6,216							6,216	609	12001	6,216	FT	COMBINATION CURB AND GUTTER, TYPE 2, AS PER PLAN	33	
				169							169	609	18001	169	FT	COMBINATION CURB AND GUTTER, TYPE 3, AS PER PLAN	33	
				926							392	534	609	24510	926	FT	CURB, TYPE 4-C	
				209							209	609	26000	209	FT	CURB, TYPE 6		
				5,310							5,310	609	26001	5,310	FT	CURB, TYPE 6, AS PER PLAN	33	
				1,506							1,506	609	71000	1,506	SF	CONCRETE MEDIAN		
				342							342	609	98000	342	FT	CURB, MISC.: 18" HEIGHT	33	
								35,000			35,000		872	10000	35,000	FT	VOID REDUCING ASPHALT MEMBRANE (VRAM)	37
																WATER WORK		
											9	202	75610	9	EACH	VALVE BOX REMOVED		
											32	613	41201	32	CY	LOW STRENGTH MORTAR BACKFILL, AS PER PLAN	586	
											769	638	02401	769	FT	12" WATERMAIN DUCTILE IRON PIPE ANSI CLASS 52, PUSH-ON JOINTS AND FITTINGS, AS PER PLAN, (COC 801)*	586	
											160	638	03001	160	FT	16" WATER MAIN DUCTILE IRON PIPE ANSI CLASS 52, PUSH-ON JOINTS AND FITTINGS, AS PER PLAN, (COC 801)	593	
											60	638	06705	60	FT	20" STEEL PIPE ENCASEMENT, OPEN CUT, AS PER PLAN*	586	
											320	638	07305	320	FT	20" STEEL PIPE ENCASEMENT, BORED OR JACKED, AS PER PLAN*	586	
											4	638	07501	4	EACH	12" GATE VALVE, AS PER PLAN, (COC 802)*	586	
											2	638	09801	2	EACH	12" X 12" TAPPING SLEEVE, VALVE AND VALVE BOX, AS PER PLAN, (COC 803)*	586	
											1	638	10201	1	EACH	6" FIRE HYDRANT, AS PER PLAN, (COC 809)*	595	
											1	638	10600	1	EACH	FIRE HYDRANT AND GATE VALVE REMOVED AND RESET, (COC 809)		
											9	638	10800	9	EACH	VALVE BOX ADJUSTED TO GRADE, (COC 807)		
											1	638	11300	1	EACH	1" AIR RELEASE VALVE, (COC 812)		
											2,350	SPECIAL	63820414	2,350	FT	2" WATER MAIN POLYVINYL CHORIDE PIPE AND FITTINGS (WSP 6768)	601	
											1	SPECIAL	63820752	1	EACH	FIRE HYDRANT REMOVED FOR STORAGE, (COC 809)*	586	
											114	638	20774	114	FT	1-1/2" WATER TUBING, TYPE K SOFT COPPER (COLS. CMS ITEM 805.03), A.P.P. (WSP 6768)	601	
											1	SPECIAL	63898000	1	EACH	1-1/2" WATER SERVICE TAP, COMPLETE (COLS. CMS ITEM 805) (WSP 6768)	601	
											8	SPECIAL	63898000	8	EACH	QUICK COUPLER VALVE, 1" BRASS, 2 PIECE, WITH BOX (10" ROUND) (WSP 6768)	601	
											1	SPECIAL	63898100	1	LUMP	1 1/2" METER SETTING WITH BACK FLOW PREVENTER IN HEATED ENCLOSURE (WSP 6768)	601	
																*INDICATES CITY OF MARYSVILLE SYSTEM ONLY		

CALCULATED  
NJL  
CHECKED  
KOD

GENERAL SUMMARY

UNI-33-24.87

NO.	DESCRIPTION	REV. BY	DATE
A	QUANTITY REVISIONS	ENR	2-3-2022
B	ADDED ITEM	ENR	2-28-2022











P:\PR55741\FRA\80748\Design\Roadway\Sheets\80748GS10.dgn Sheet 2/28/2022 4:05:41PM riley

	202	202	202	202	202	202	202	202	202	202	202	202	202	202	202	202	202	202	202	202	202
	HEADWALL REMOVED	PAVEMENT REMOVED, AS PER PLAN	WALK REMOVED	CONCRETE MEDIAN REMOVED	CONCRETE BARRIER REMOVED	CURB REMOVED	CURB AND GUTTER REMOVED	PIPE REMOVED, 24" AND UNDER	GUARDRAIL REMOVED	MAILBOX REMOVED	MANHOLE REMOVED	CATCH BASIN REMOVED	FENCE REMOVED	MONUMENT ASSEMBLY REMOVED	GUARDRAIL REMOVED, BARRIER DESIGN	ANCHOR ASSEMBLY REMOVED	IMPACT ATTENUATOR REMOVED	BRIDGE TERMINAL ASSEMBLY REMOVED	REMOVAL MISC.: CONCRETE PAD	CABLE BARRIER REMOVED	
	EACH	SY	SF	SY	FT	FT	FT	FT	FT	EACH	EACH	EACH	FT	EACH	FT	EACH	EACH	EACH	SF	FT	
QUANTITIES FOR PLAN SPLIT 01/NHS/PV																					
	11	25097		69		212		797	2054			3		1	232	8	5	3	16	35	
			7496																		
	11	32593		69		212		797	2054			3		1	232	8	5	3	16	35	
QUANTITIES FOR PLAN SPLIT 02/S>2/PV																					
	4	14220	681	1022	163	1929	645	2153	93		1	7									
	3	11223	5370			258	2070	1423		1	1	8	40								
	7	25443	6051	1022	163	2187	2715	3576	93	1	2	15	40								
<b>TOTALS CARRIED TO GENERAL SUMMARY</b>																					
	18	58036	6051	1091	163	2399	2715	4373	2147	1	2	18	40	1	232	8	5	3	16	35	

NO.	DESCRIPTION	REV. BY	DATE
A	ITEM UPDATE	ENR	2-4-2022
B	QUANTITY UPDATES	ENR	2-28-2022

CALCULATED	NJL
	CHECKED
KOD	


**ROADWAY SUBSUMMARY**

**UNI - 33 - 24.87**

104
923



NO.	DESCRIPTION	REV. BY	DATE
B	ADDED BALLOON	ENR	2-28-2022

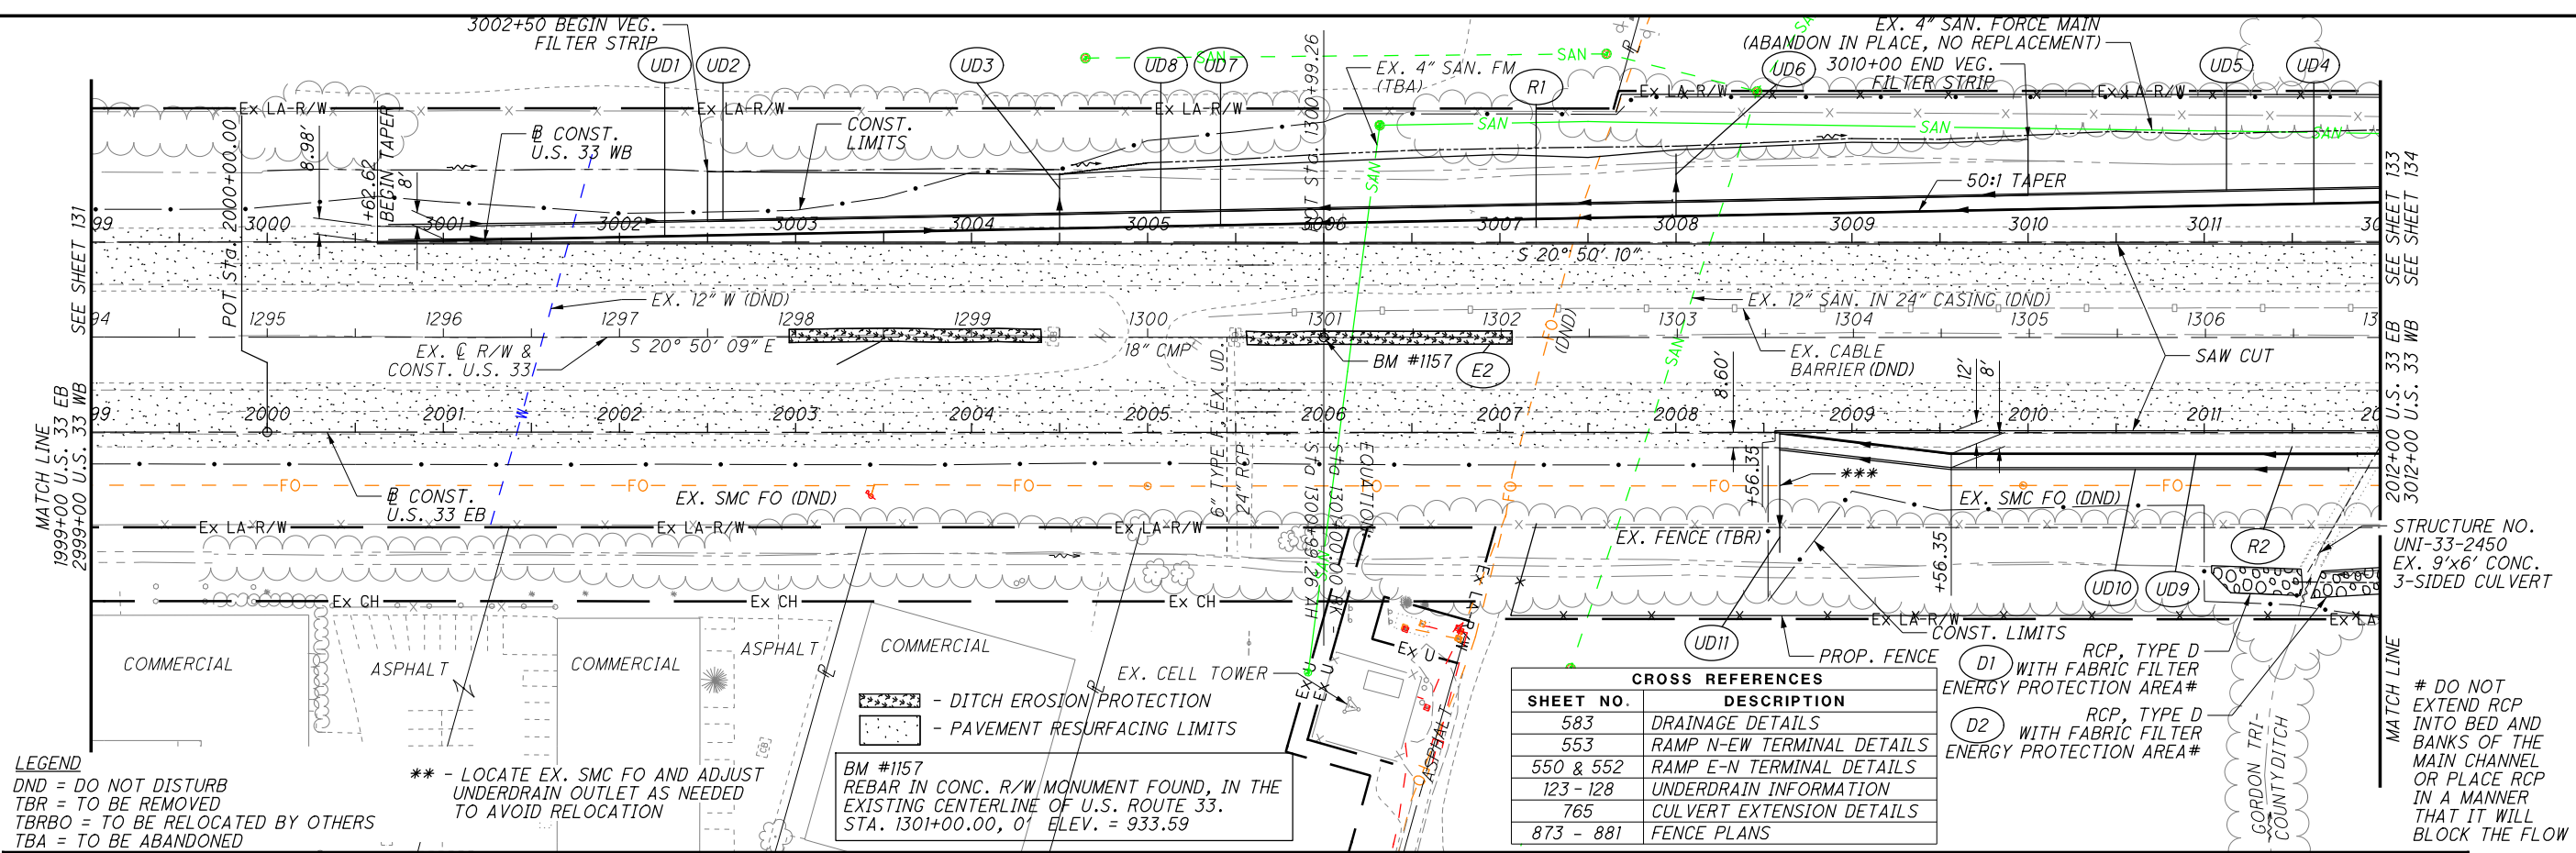

**LEGEND**  
 DND = DO NOT DISTURB  
 TBR = TO BE REMOVED  
 TBRBO = TO BE RELOCATED BY OTHERS  
 TBA = TO BE ABANDONED

\*\* - LOCATE EX. SMC FO AND ADJUST UNDERDRAIN OUTLET AS NEEDED TO AVOID RELOCATION


BM #1157  
 REBAR IN CONC. R/W MONUMENT FOUND, IN THE EXISTING CENTERLINE OF U.S. ROUTE 33.  
 STA. 1301+00.00, 0' ELEV. = 933.59

CROSS REFERENCES	
SHEET NO.	DESCRIPTION
583	DRAINAGE DETAILS
553	RAMP N-EW TERMINAL DETAILS
550 & 552	RAMP E-N TERMINAL DETAILS
123 - 128	UNDERDRAIN INFORMATION
765	CULVERT EXTENSION DETAILS
873 - 881	FENCE PLANS


STRUCTURE NO. UNI-33-2450  
 EX. 9'x6' CONC. 3-SIDED CULVERT

# DO NOT EXTEND RCP INTO BED AND BANKS OF THE MAIN CHANNEL OR PLACE RCP IN A MANNER THAT IT WILL BLOCK THE FLOW

WEST BOUND PROFILE

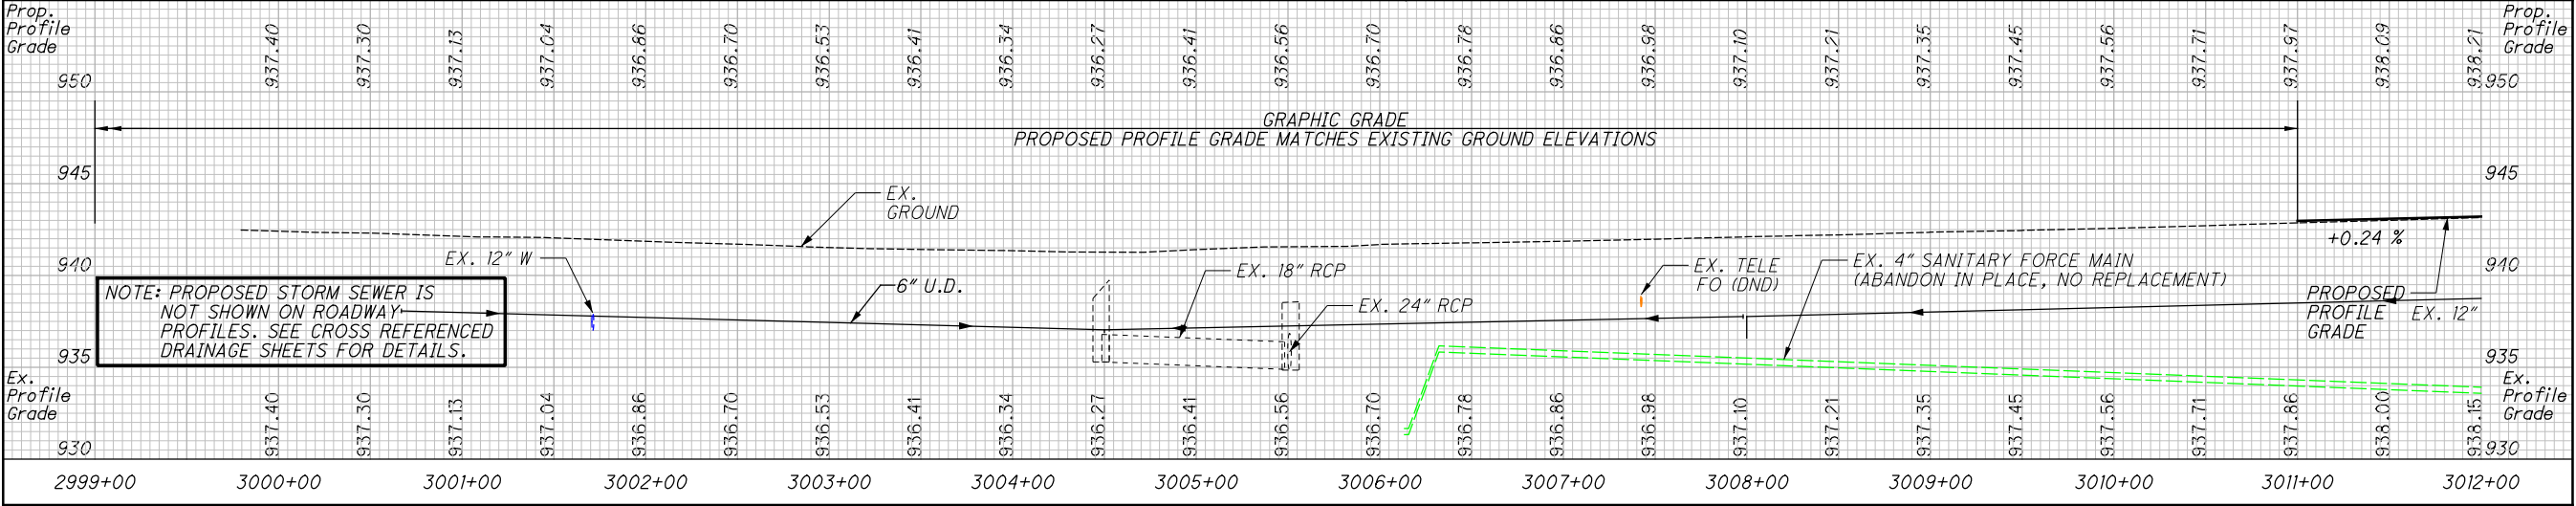


EAST BOUND PROFILE

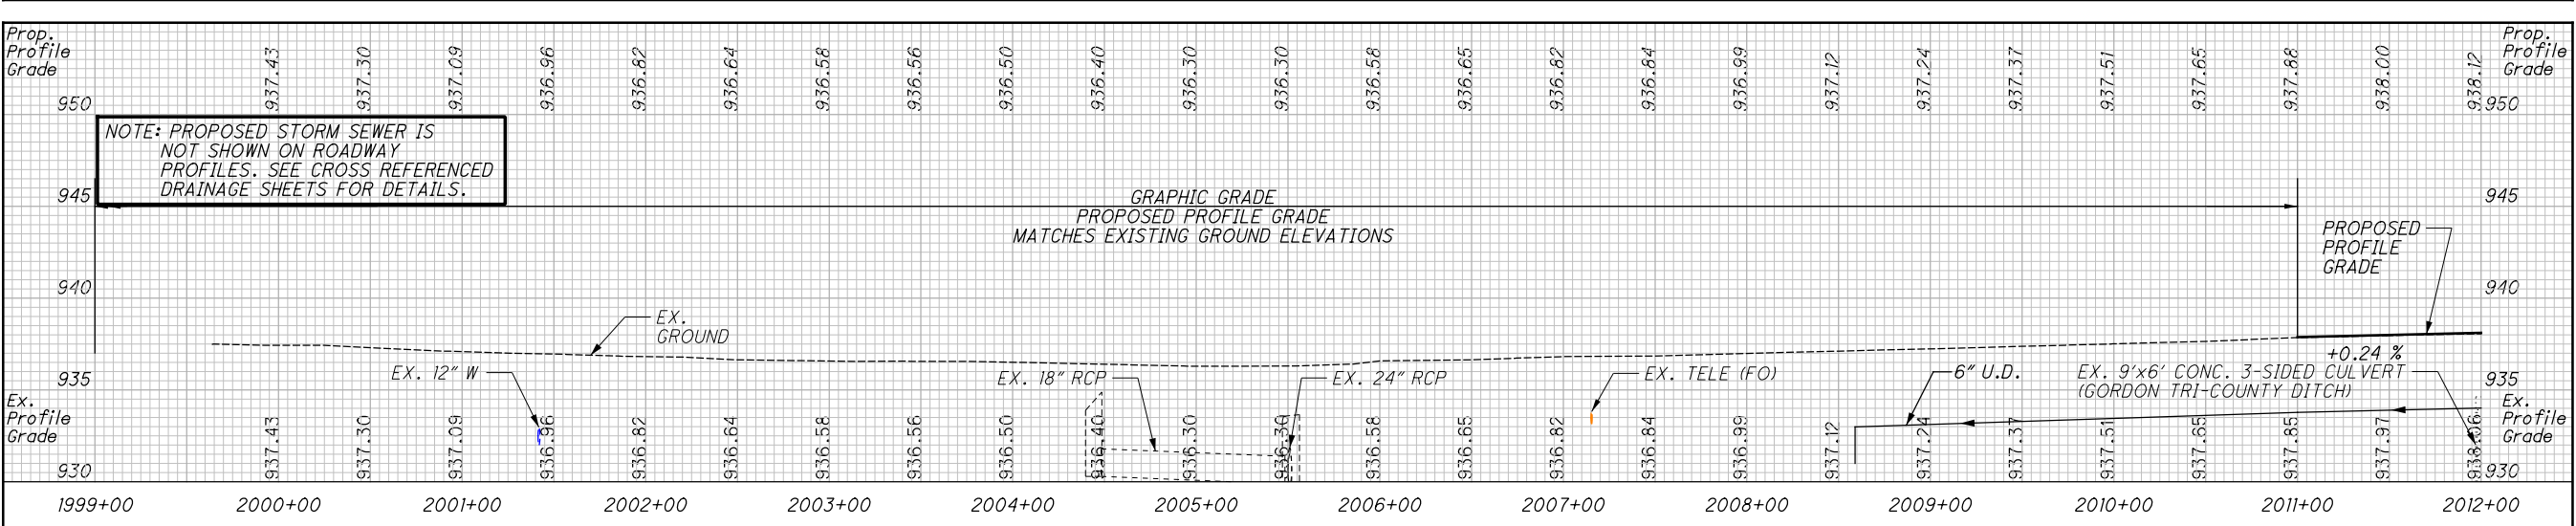

PLAN AND PROFILE - U.S. 33 EB & WB  
 STA. 1999+00.00 EB & STA. 2999+00.00 WB  
 TO STA 2012+00.00 EB & 3012+00.00 WB

UNI-33-24.87

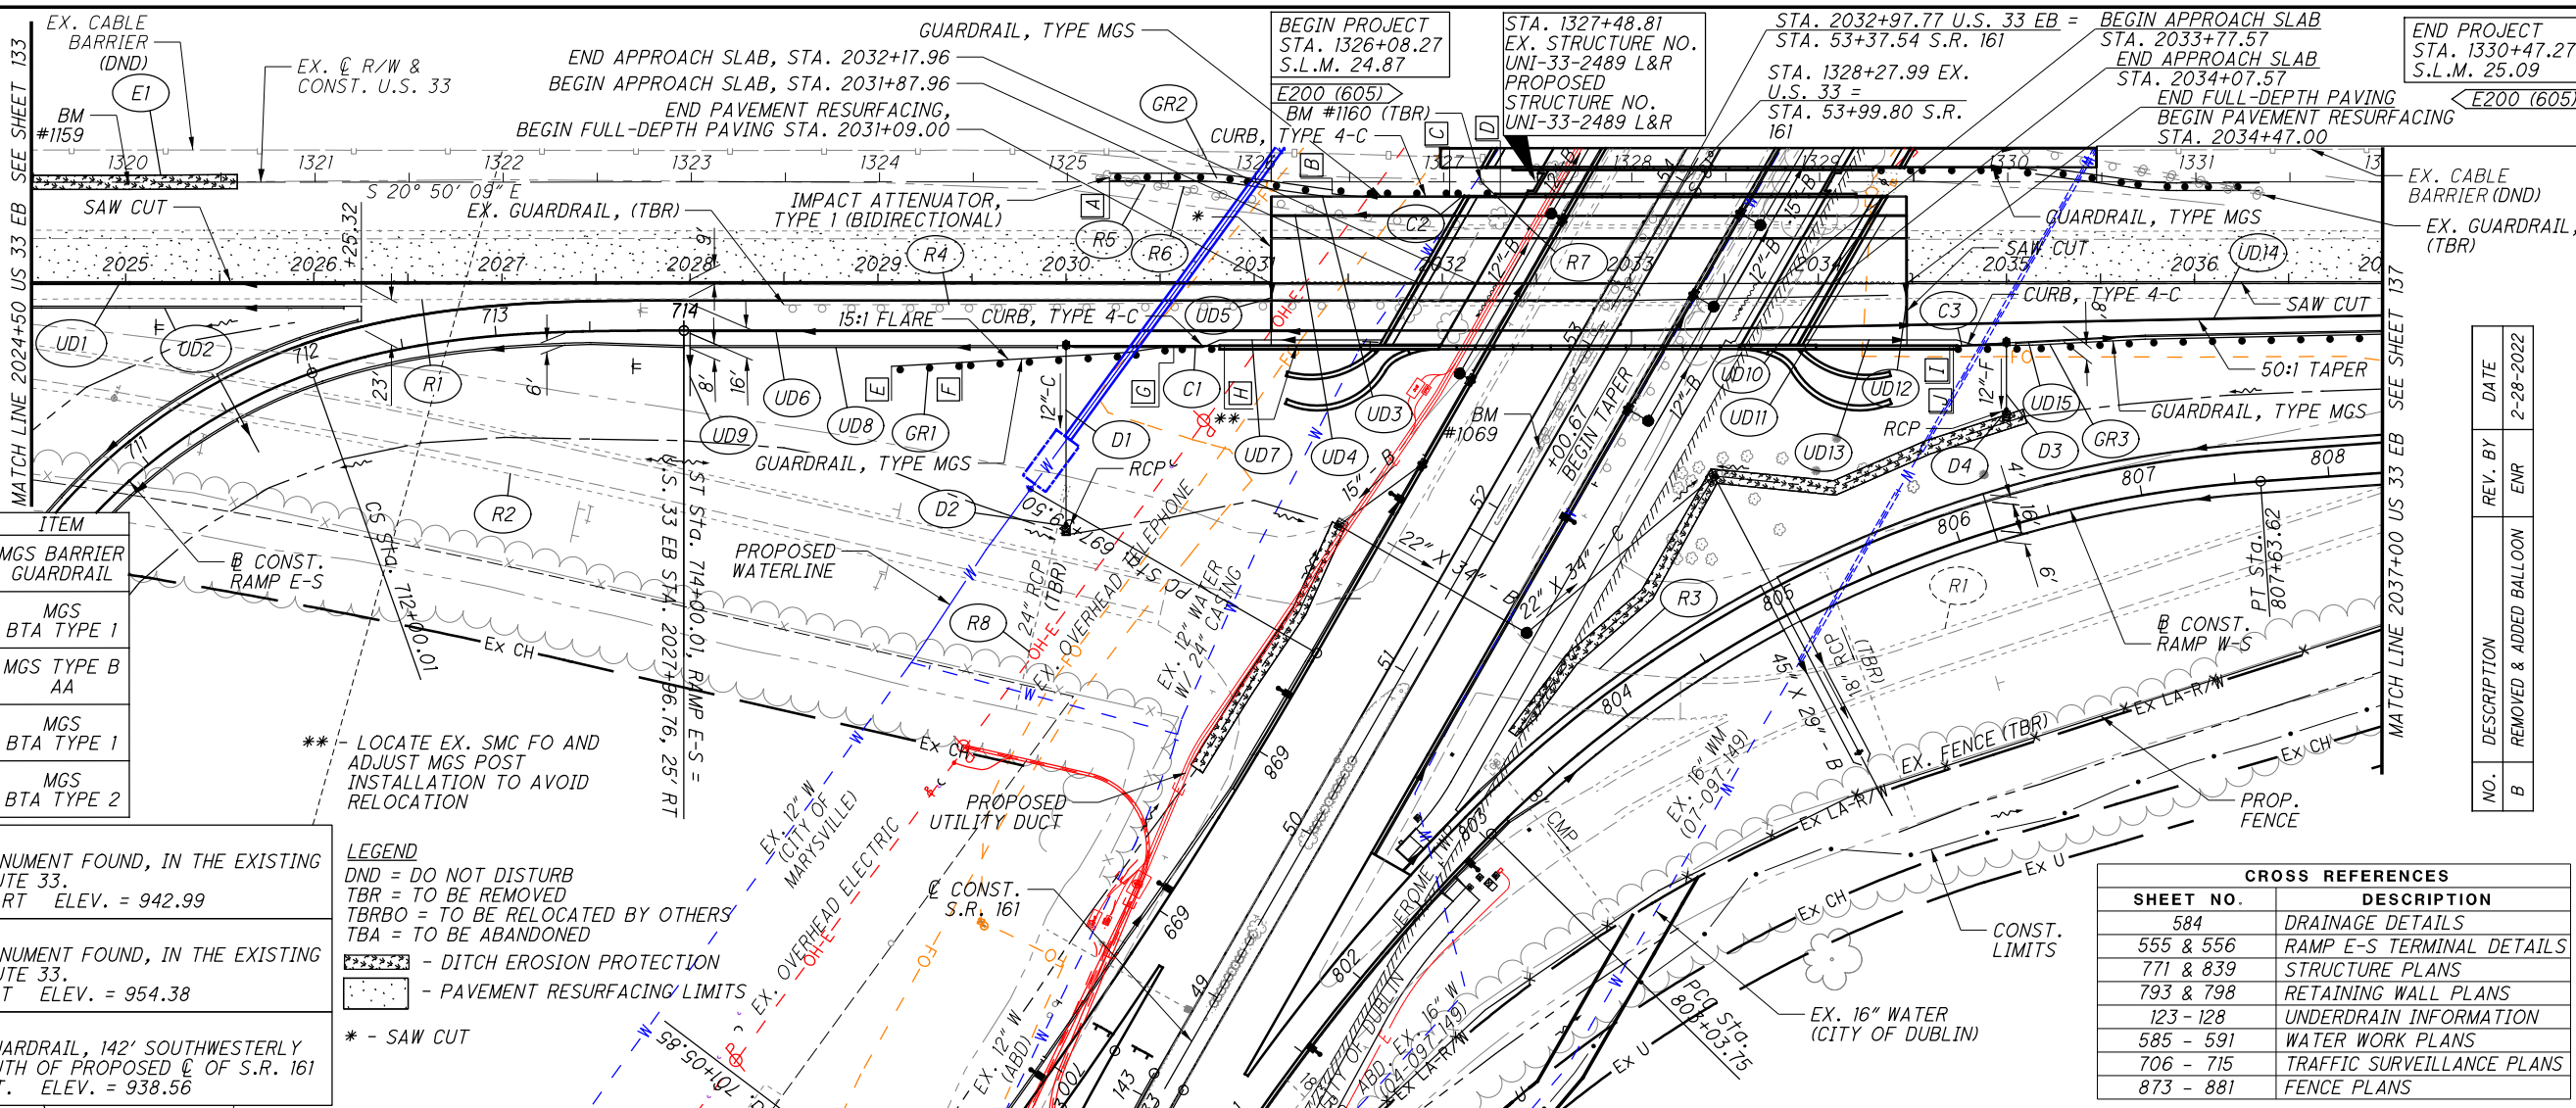

GUARDRAIL STATIONING	ITEM
A STA. 2030+23.05 LT	MGS BARRIER GUARDRAIL
B STA. 2031+41.42 LT	MGS
C STA. 2032+03.92 LT	BTA TYPE 1
D STA. 2032+30.82 LT	MGS TYPE B
E STA. 2029+07.20 RT	AA
F STA. 2029+44.70 RT	MGS
G STA. 2030+57.29 RT	BTA TYPE 1
H STA. 2030+84.19 RT	MGS
I STA. 2034+69.85 RT	BTA TYPE 2
J STA. 2034+71.85 RT	MGS


BM #1159  
REBAR IN CONC. R/W MONUMENT FOUND, IN THE EXISTING CENTERLINE OF U.S. ROUTE 33.  
STA. 1320+00.08, 0.23' RT ELEV. = 942.99

BM #1160  
REBAR IN CONC. R/W MONUMENT FOUND, IN THE EXISTING CENTERLINE OF U.S. ROUTE 33.  
STA. 1327+20.15, 0.16' RT ELEV. = 954.38



BM #1069  
BOLT ON "W" SIDE OF GUARDRAIL, 142' SOUTHWESTERLY OF THE U.S. 33., 4' SOUTH OF PROPOSED C OF S.R. 161  
STA. 52+38.33, 3.90' RT. ELEV. = 938.56

**LEGEND**  
 DND = DO NOT DISTURB  
 TBR = TO BE REMOVED  
 TBRBO = TO BE RELOCATED BY OTHERS  
 TBA = TO BE ABANDONED  
 - - - - - DITCH EROSION PROTECTION  
 . . . . . PAVEMENT RESURFACING LIMITS  
 \* - SAW CUT


CROSS REFERENCES	
SHEET NO.	DESCRIPTION
584	DRAINAGE DETAILS
555 & 556	RAMP E-S TERMINAL DETAILS
771 & 839	STRUCTURE PLANS
793 & 798	RETAINING WALL PLANS
123 - 128	UNDERDRAIN INFORMATION
585 - 591	WATER WORK PLANS
706 - 715	TRAFFIC SURVEILLANCE PLANS
873 - 881	FENCE PLANS

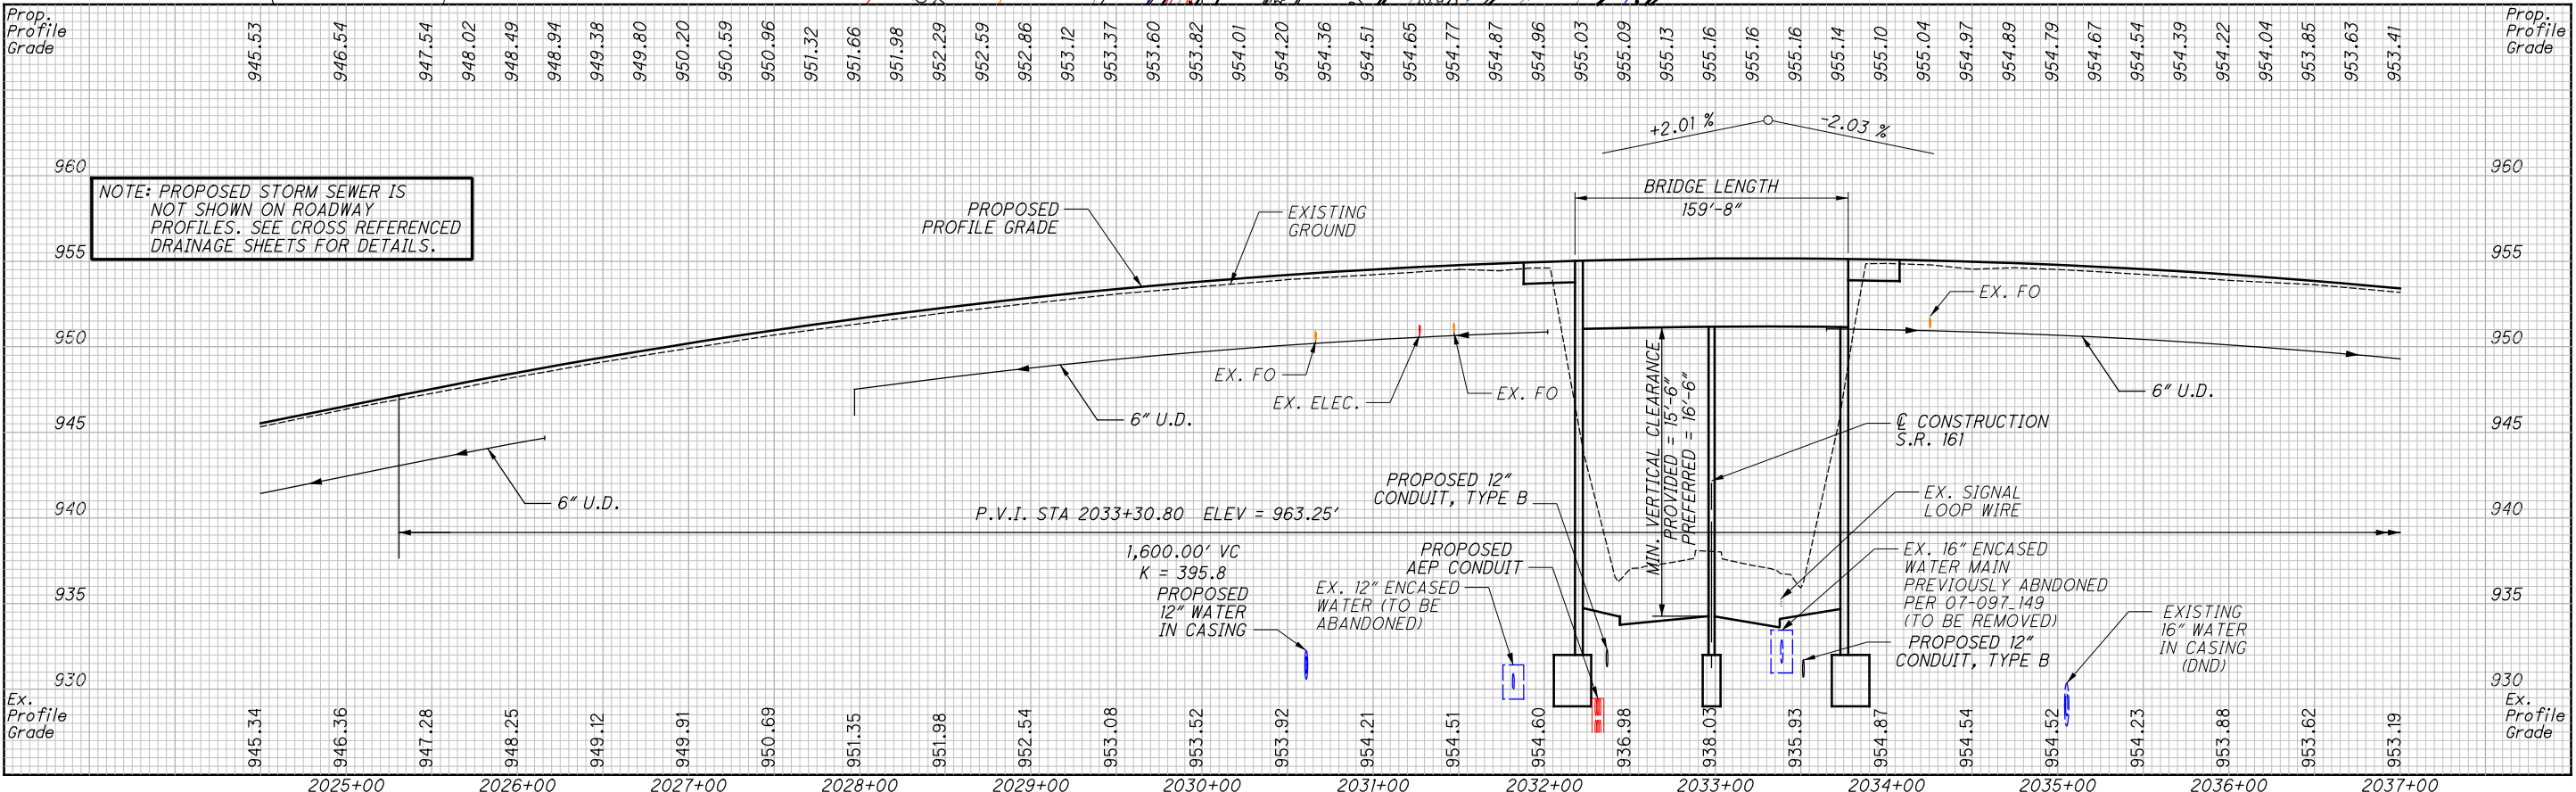

NOTE: PROPOSED STORM SEWER IS NOT SHOWN ON ROADWAY PROFILES. SEE CROSS REFERENCED DRAINAGE SHEETS FOR DETAILS.

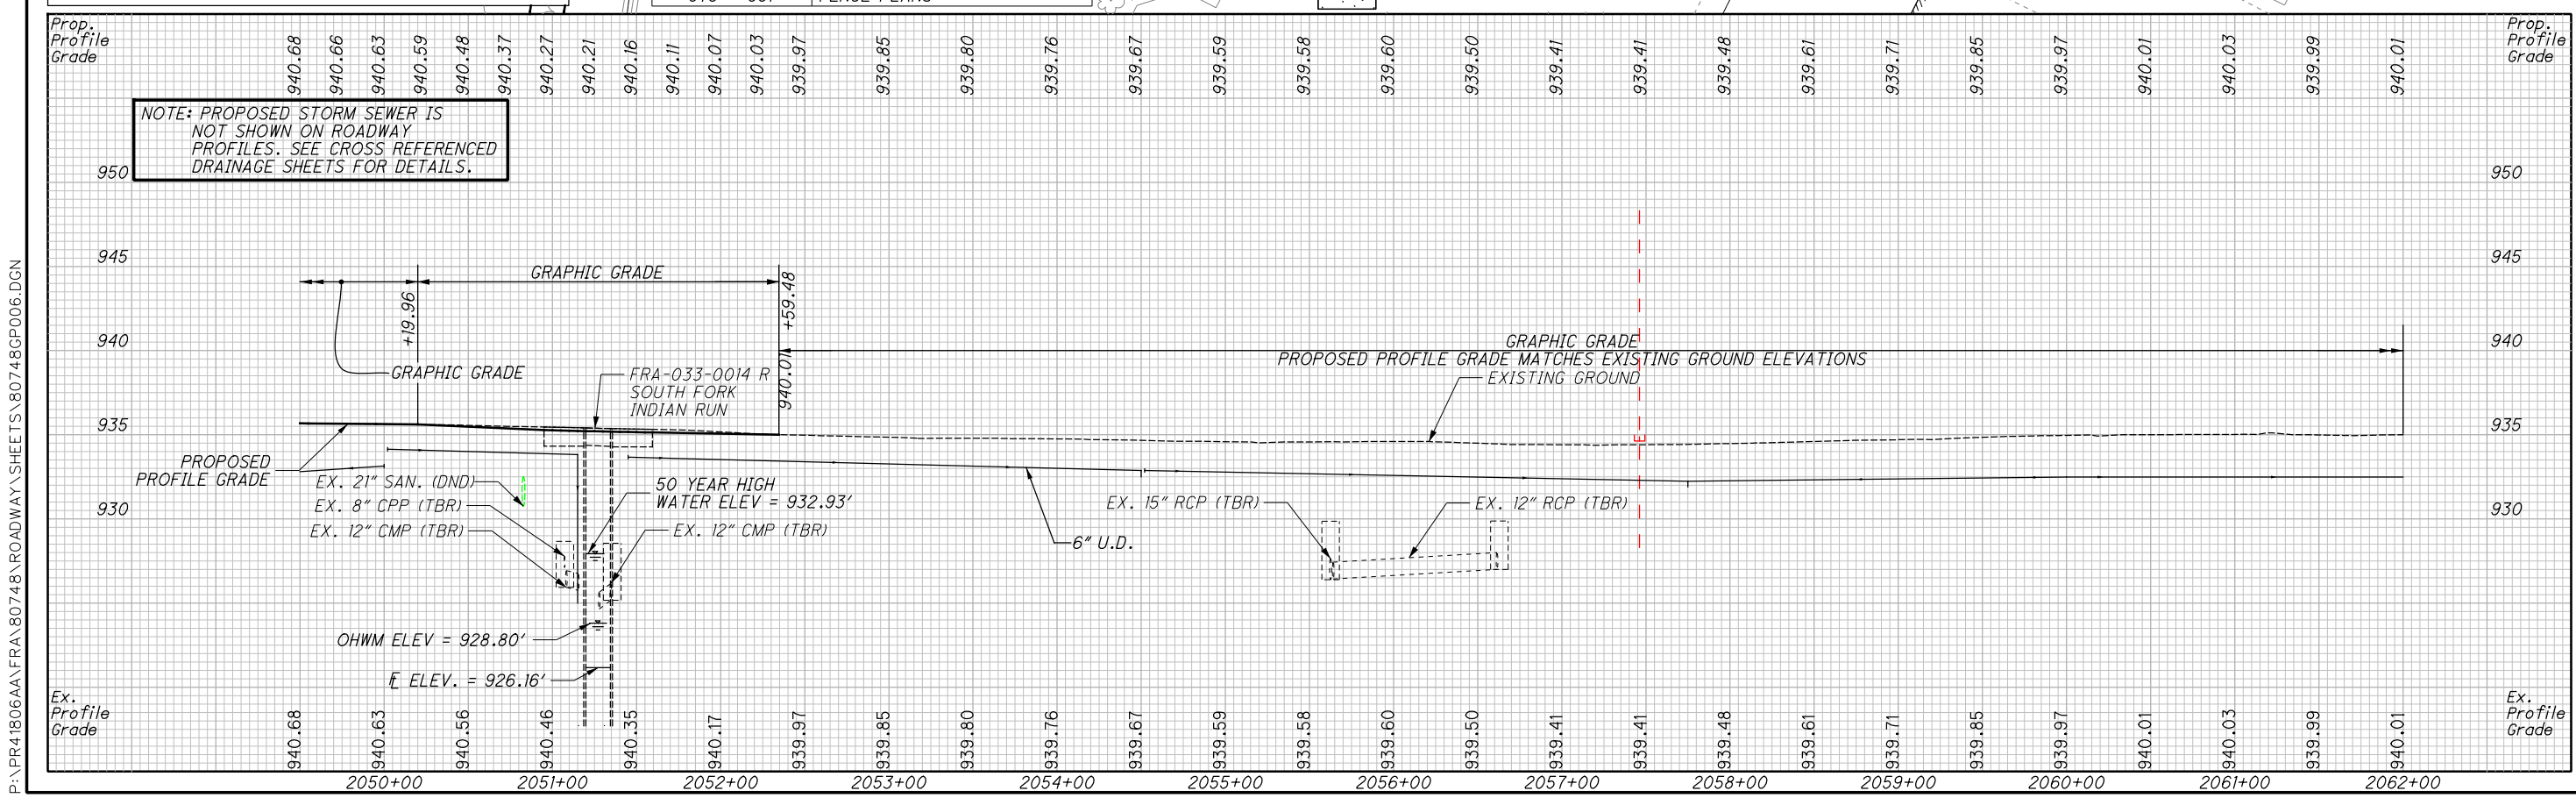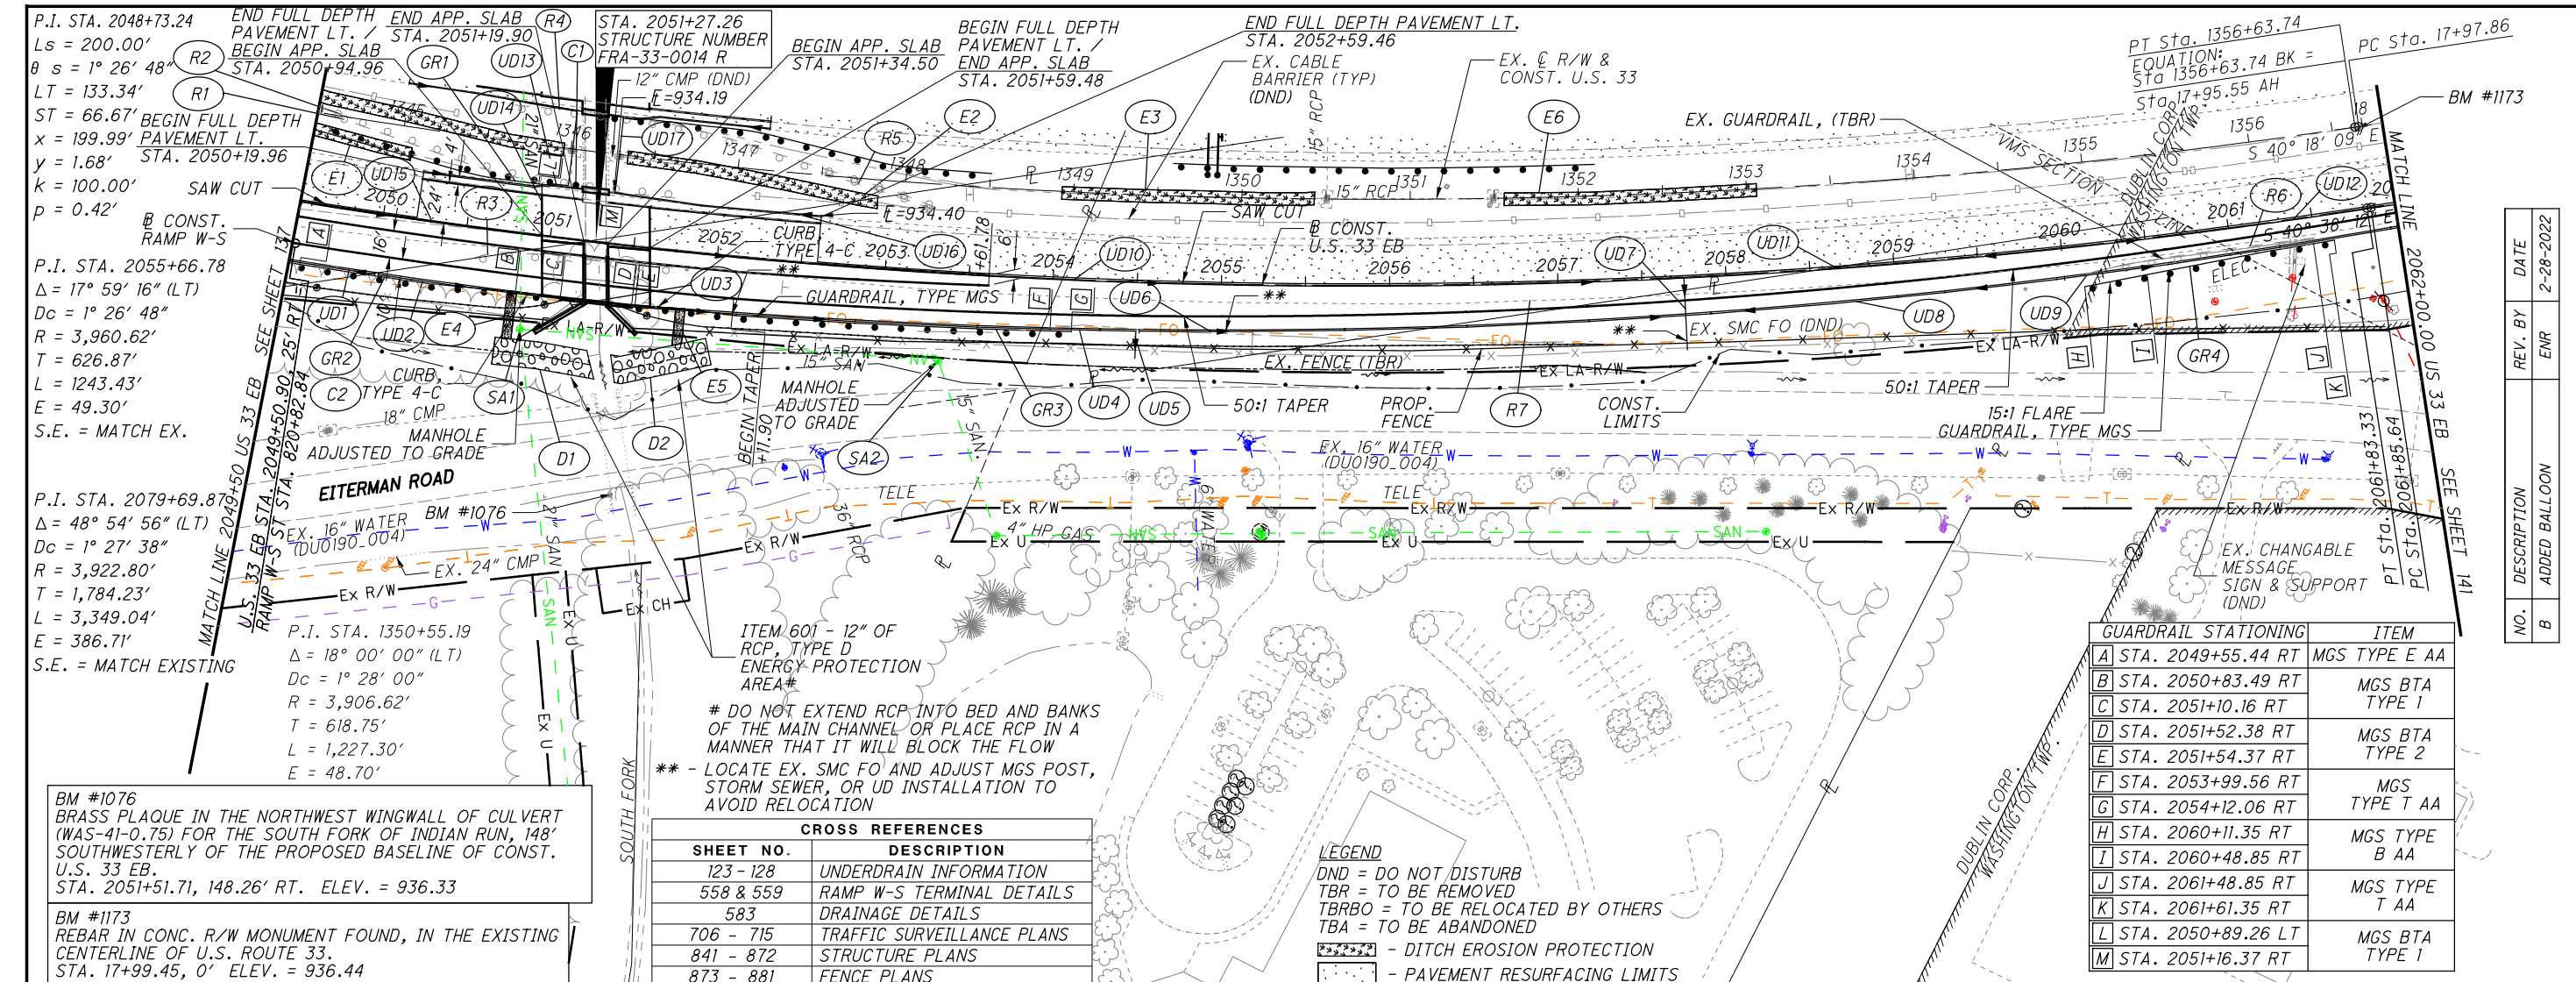

P:\PR41806AA\FRA\80748\ROADWAY\SHEETS\80748GP006.DGN

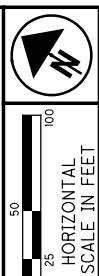

CALCULATED  
KOD  
CHECKED  
MAH

NO.	DESCRIPTION	REV. BY	DATE
B	ADDED BALLOON	ENR	2-28-2022

**PLAN AND PROFILE - US 33 EB**  
**STA. 2049+50.00 EB TO STA. 2062+00.00 EB**

**UNI-33-24.87**  
 139  
 923

P.I. STA. 2048+73.24  
 Ls = 200.00'  
 $\theta = 1^\circ 26' 48''$   
 LT = 133.34'  
 ST = 66.67'  
 x = 199.99'  
 y = 1.68'  
 k = 100.00'  
 p = 0.42'

P.I. STA. 2055+66.78  
 $\Delta = 17^\circ 59' 16''$  (LT)  
 $Dc = 1^\circ 26' 48''$   
 R = 3,960.62'  
 T = 626.87'  
 L = 1243.43'  
 E = 49.30'

P.I. STA. 2079+69.87  
 $\Delta = 48^\circ 54' 56''$  (LT)  
 $Dc = 1^\circ 27' 38''$   
 R = 3,922.80'  
 T = 1,784.23'  
 L = 3,349.04'  
 E = 386.71'

P.I. STA. 1350+55.19  
 $\Delta = 18^\circ 00' 00''$  (LT)  
 $Dc = 1^\circ 28' 00''$   
 R = 3,906.62'  
 T = 618.75'  
 L = 1,227.30'  
 E = 48.70'

BM #1076  
 BRASS PLAQUE IN THE NORTHWEST WINGWALL OF CULVERT (WAS-41-0.75) FOR THE SOUTH FORK OF INDIAN RUN, 148' SOUTHWESTERLY OF THE PROPOSED BASELINE OF CONST. U.S. 33 EB.  
 STA. 2051+51.71, 148.26' RT. ELEV. = 936.33

BM #1173  
 REBAR IN CONC. R/W MONUMENT FOUND, IN THE EXISTING CENTERLINE OF U.S. ROUTE 33.  
 STA. 17+99.45, 0' ELEV. = 936.44

SHEET NO.	DESCRIPTION
123 - 128	UNDERDRAIN INFORMATION
558 & 559	RAMP W-S TERMINAL DETAILS
583	DRAINAGE DETAILS
706 - 715	TRAFFIC SURVEILLANCE PLANS
841 - 872	STRUCTURE PLANS
873 - 881	FENCE PLANS

**LEGEND**  
 DND = DO NOT DISTURB  
 TBR = TO BE REMOVED  
 TBRBO = TO BE RELOCATED BY OTHERS  
 TBA = TO BE ABANDONED  
 - - - - - DITCH EROSION PROTECTION  
 - - - - - PAVEMENT RESURFACING LIMITS

GUARDRAIL STATIONING	ITEM
A STA. 2049+55.44 RT	MGS TYPE E AA
B STA. 2050+83.49 RT	MGS BTA TYPE 1
J STA. 2061+48.85 RT	MGS TYPE T AA
K STA. 2061+61.35 RT	MGS TYPE T AA
L STA. 2050+89.26 LT	MGS BTA TYPE 1
M STA. 2051+16.37 RT	MGS BTA TYPE 1

\*\* - LOCATE EX. SMC FO AND ADJUST MGS POST, STORM SEWER, OR UD INSTALLATION TO AVOID RELOCATION

**LEGEND**  
 DND = DO NOT DISTURB  
 TBR = TO BE REMOVED  
 TBRBO = TO BE RELOCATED BY OTHERS  
 TBA = TO BE ABANDONED



--- - PAVEMENT RESURFACING LIMITS  
 - - - - - DITCH EROSION PROTECTION

P.I. STA. 35+60.19  
 $\Delta = 48^\circ 58' 50''$  (LT)  
 $Dc = 1^\circ 28' 51''$   
 $R = 3,868.80'$   
 $T = 1,762.32'$   
 $L = 3,307.34'$   
 $E = 382.48'$

CROSS REFERENCES	
SHEET NO.	DESCRIPTION
123 - 128	UNDERDRAIN INFORMATION
559	RAMP W-S TERMINAL DETAILS
583	DRAINAGE DETAILS

BM #1170  
 REBAR IN CONC. R/W MONUMENT FOUND, IN THE EXISTING CENTERLINE OF U.S. ROUTE 33.  
 STA. 30+00.75, 0' ELEV. = 934.64



P.I. STA. 3078+90.59  
 $\Delta = 49^\circ 02' 25''$  (LT)  
 $Dc = 1^\circ 30' 07''$   
 $R = 3,814.80'$   
 $T = 1,740.13'$   
 $L = 3,265.15'$   
 $E = 378.15'$   
 S.E. = MATCH EXISTING

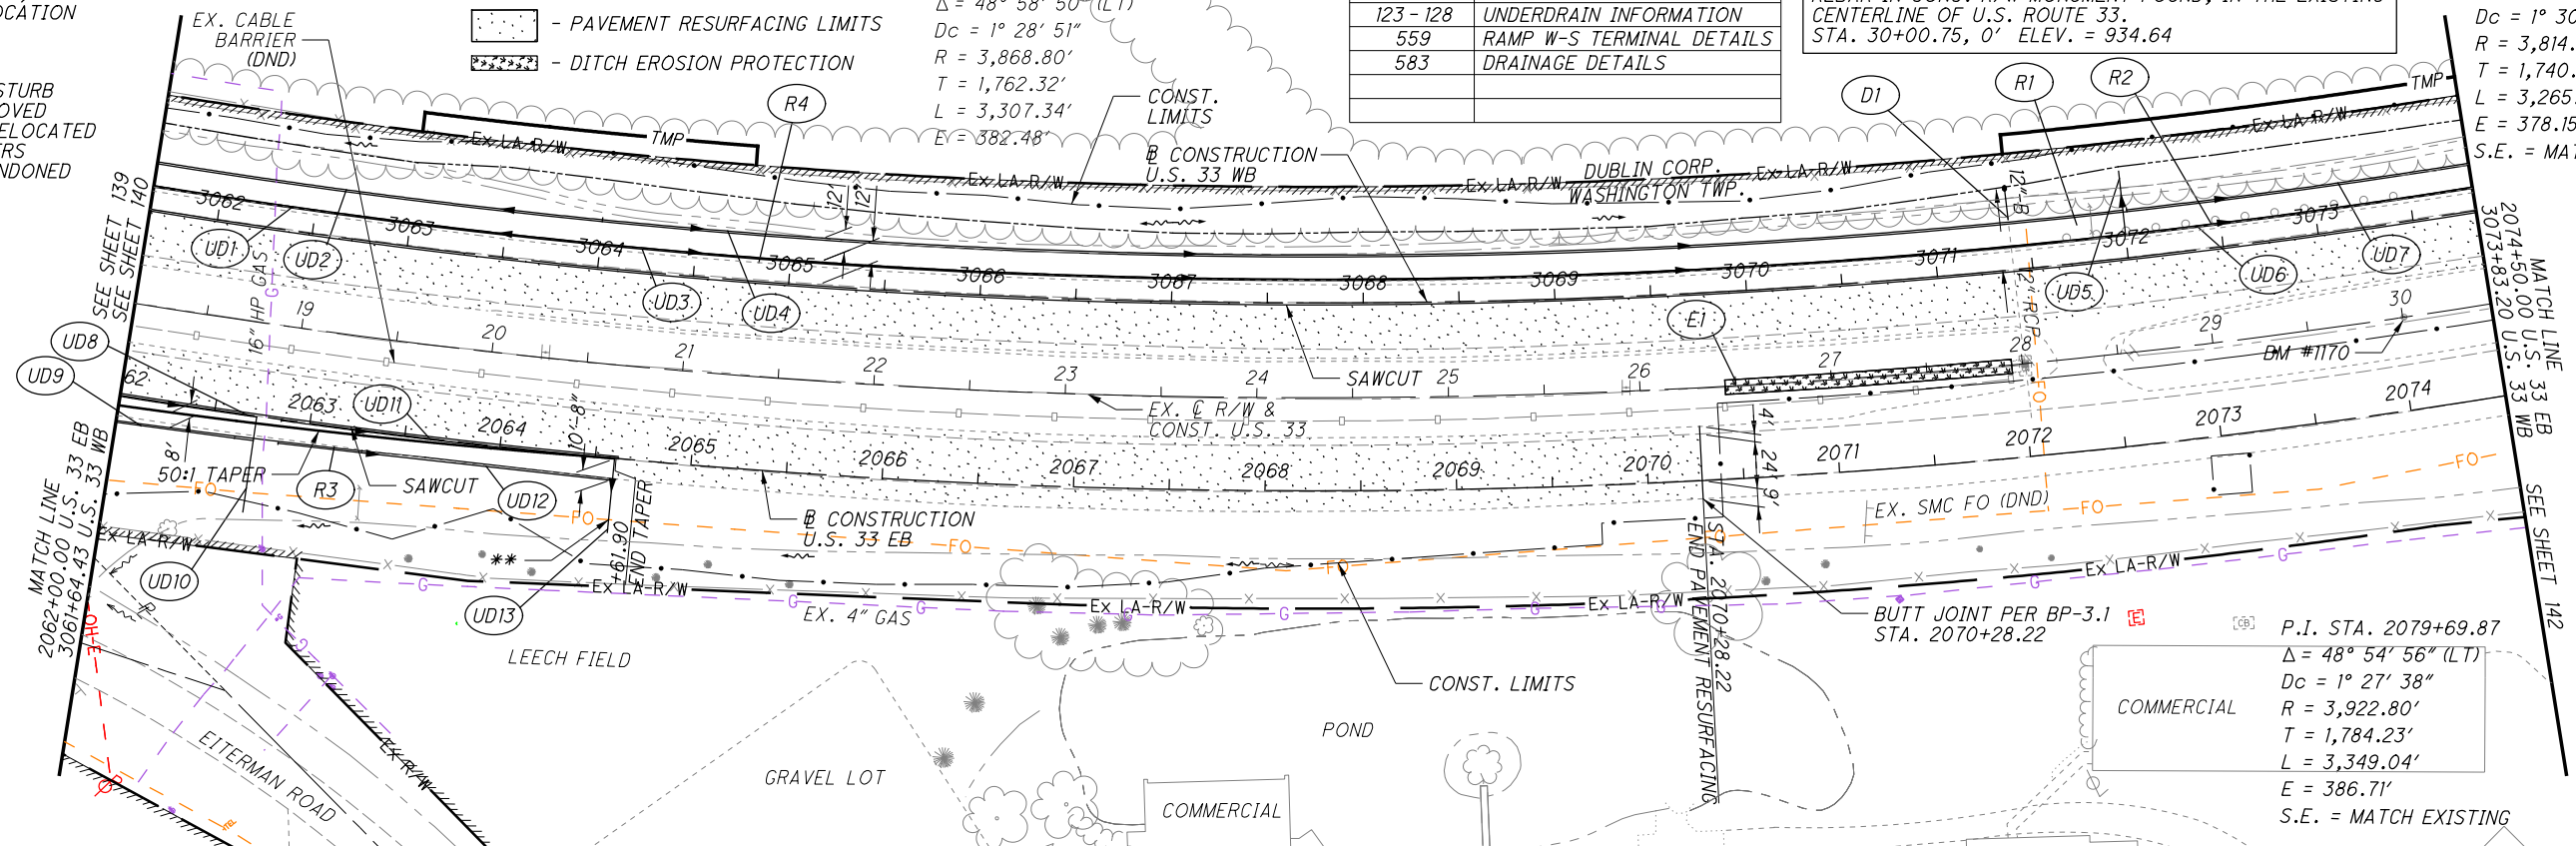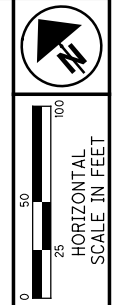

NO.	DESCRIPTION	REV. BY	DATE
B	ADDED BALLOON	ENR	2-28-2022

**PLAN AND PROFILE - U.S. 33 EB & WB**  
 STA. 2062+00.00 EB & 3061+64.43 WB TO STA. 2074+50.00 EB & 3073+83.20 WB

**UNI - 33 - 24.87**

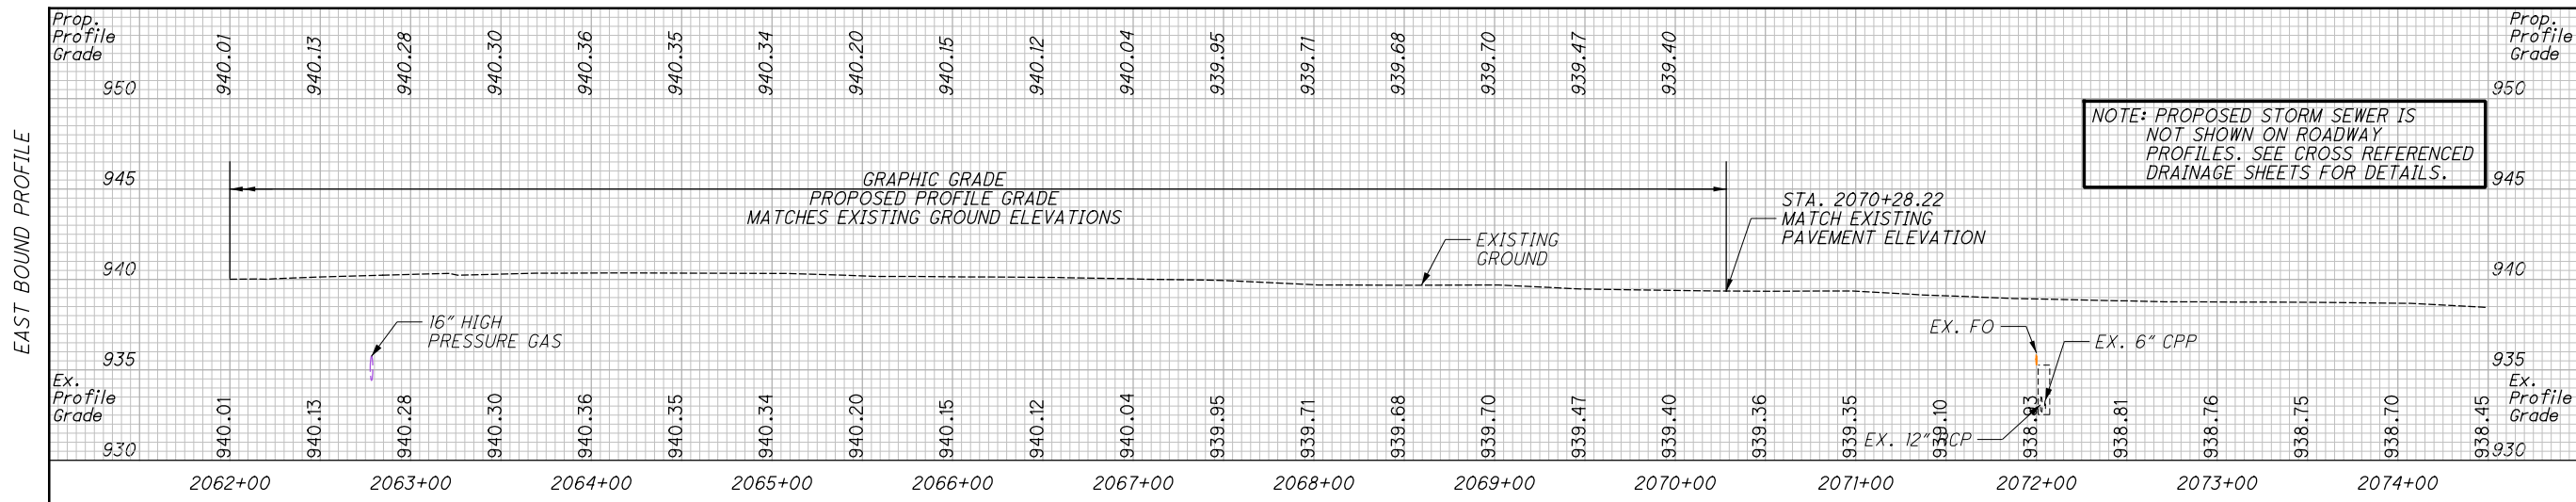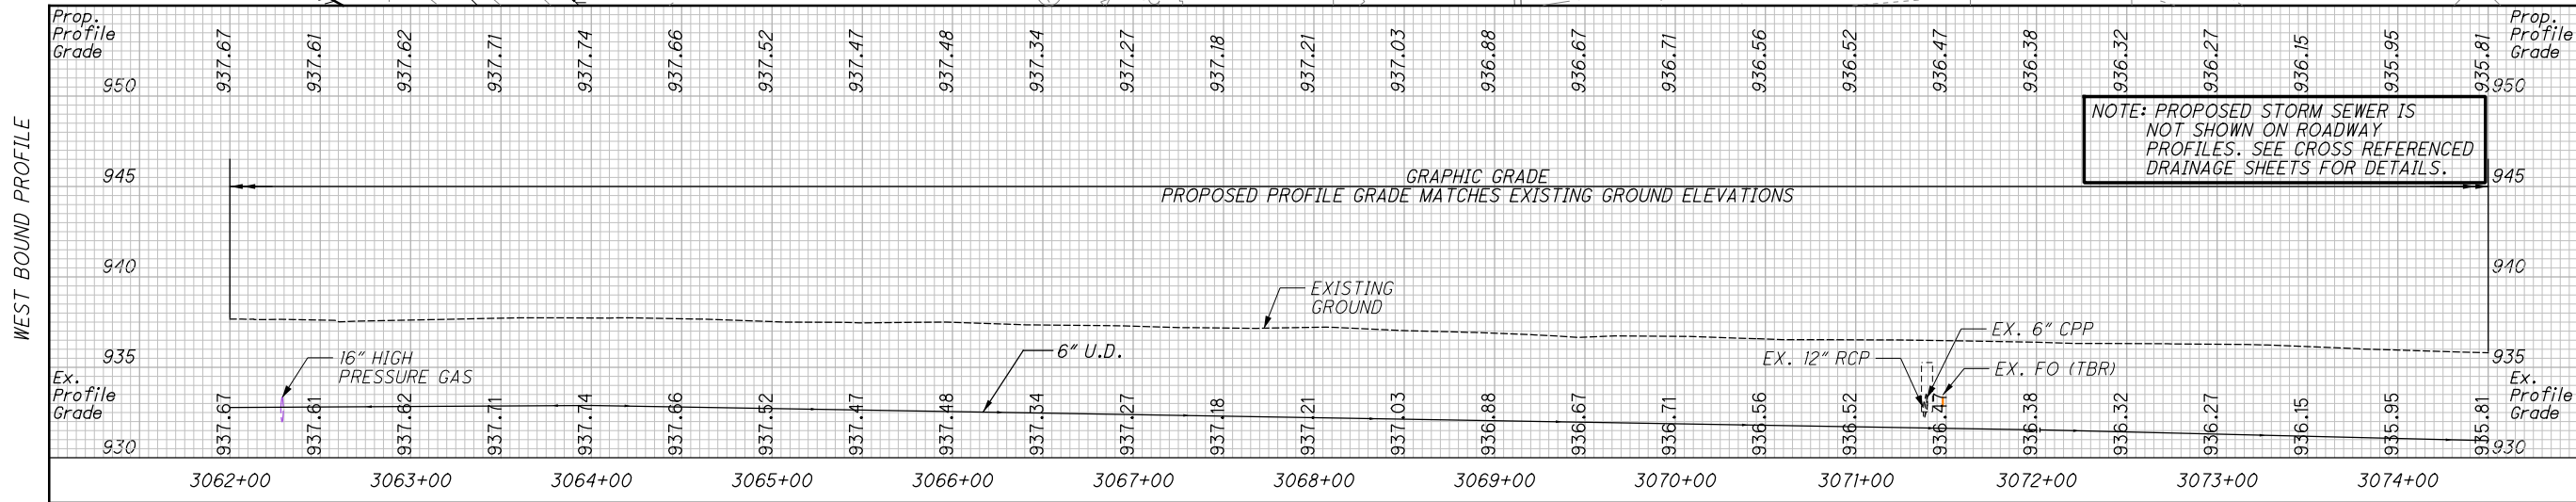

P:\PR41806AA\FRA\80748\ROADWAY\SHEETS\80748GPO07.DGN

P.I. STA. 35+60.19  
 $\Delta = 48^\circ 58' 50''$  (LT)  
 $D_c = 1^\circ 28' 51''$   
 $R = 3,868.80'$   
 $T = 1,762.32'$   
 $L = 3,307.34'$   
 $E = 382.48'$

P.I. STA. 3078+90.59  
 $\Delta = 49^\circ 02' 25''$  (LT)  
 $D_c = 1^\circ 30' 07''$   
 $R = 3,814.80'$   
 $T = 1,740.13'$   
 $L = 3,265.15'$   
 $E = 378.15'$   
 S.E. = MATCH EXISTING

P.I. STA. 2079+69.87  
 $\Delta = 48^\circ 54' 56''$  (LT)  
 $D_c = 1^\circ 27' 38''$   
 $R = 3,922.80'$   
 $T = 1,784.23'$   
 $L = 3,349.04'$   
 $E = 386.71'$   
 S.E. = MATCH EXISTING


BM #1169  
 REBAR IN CONC. R/W MONUMENT FOUND, IN THE EXISTING  
 CENTERLINE OF U.S. ROUTE 33.  
 STA. 35+00.70, 0.14' RT ELEV. = 934.00

BM #1168  
 REBAR IN CONC. R/W MONUMENT FOUND, IN THE EXISTING  
 CENTERLINE OF U.S. ROUTE 33.  
 STA. 40+00.00, 0' ELEV. = 932.33

LEGEND  
 DND = DO NOT DISTURB  
 TBR = TO BE REMOVED  
 TBRBO = TO BE RELOCATED BY OTHERS  
 TBA = TO BE ABANDONED  
 [Pattern] - PAVEMENT RESURFACING LIMITS  
 [Pattern] - DITCH EROSION PROTECTION

CROSS REFERENCES	
SHEET NO.	DESCRIPTION
123 - 128	UNDERDRAIN INFORMATION
583	DRAINAGE DETAILS



NO.	DESCRIPTION	REV. BY	DATE
B	ADDED BALLOON	ENR	2-28-2022

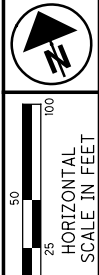

PLAN AND PROFILE - U.S. 33 EB & WB  
 STA. 2074+50.00 EB & 3073+83.20 WB TO  
 STA. 2087+00.00 EB & 3086+02.00 WB


UNI-33-24.87

142  
923

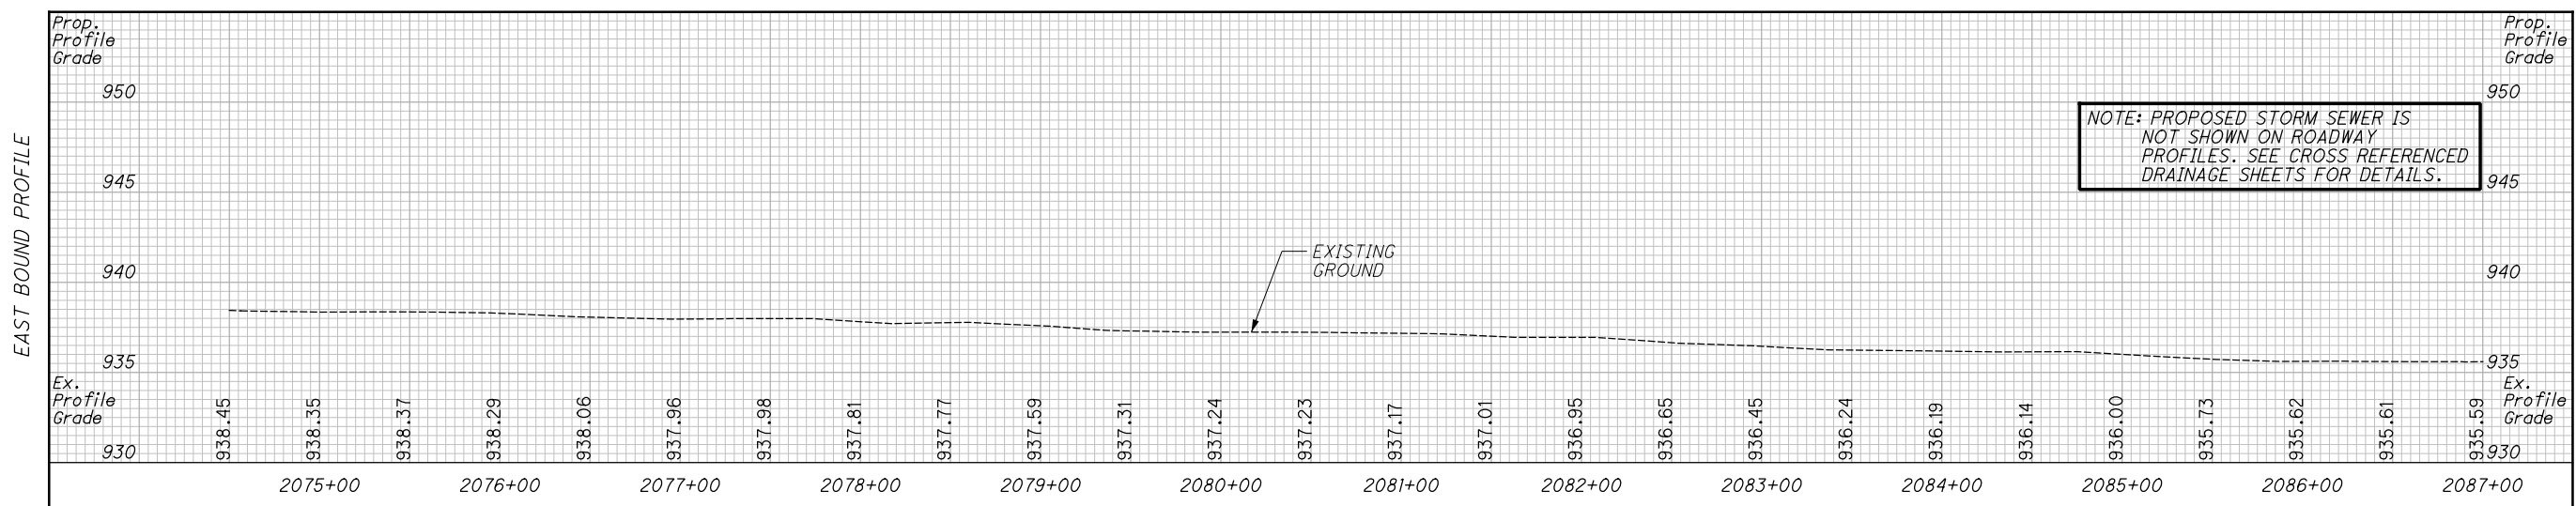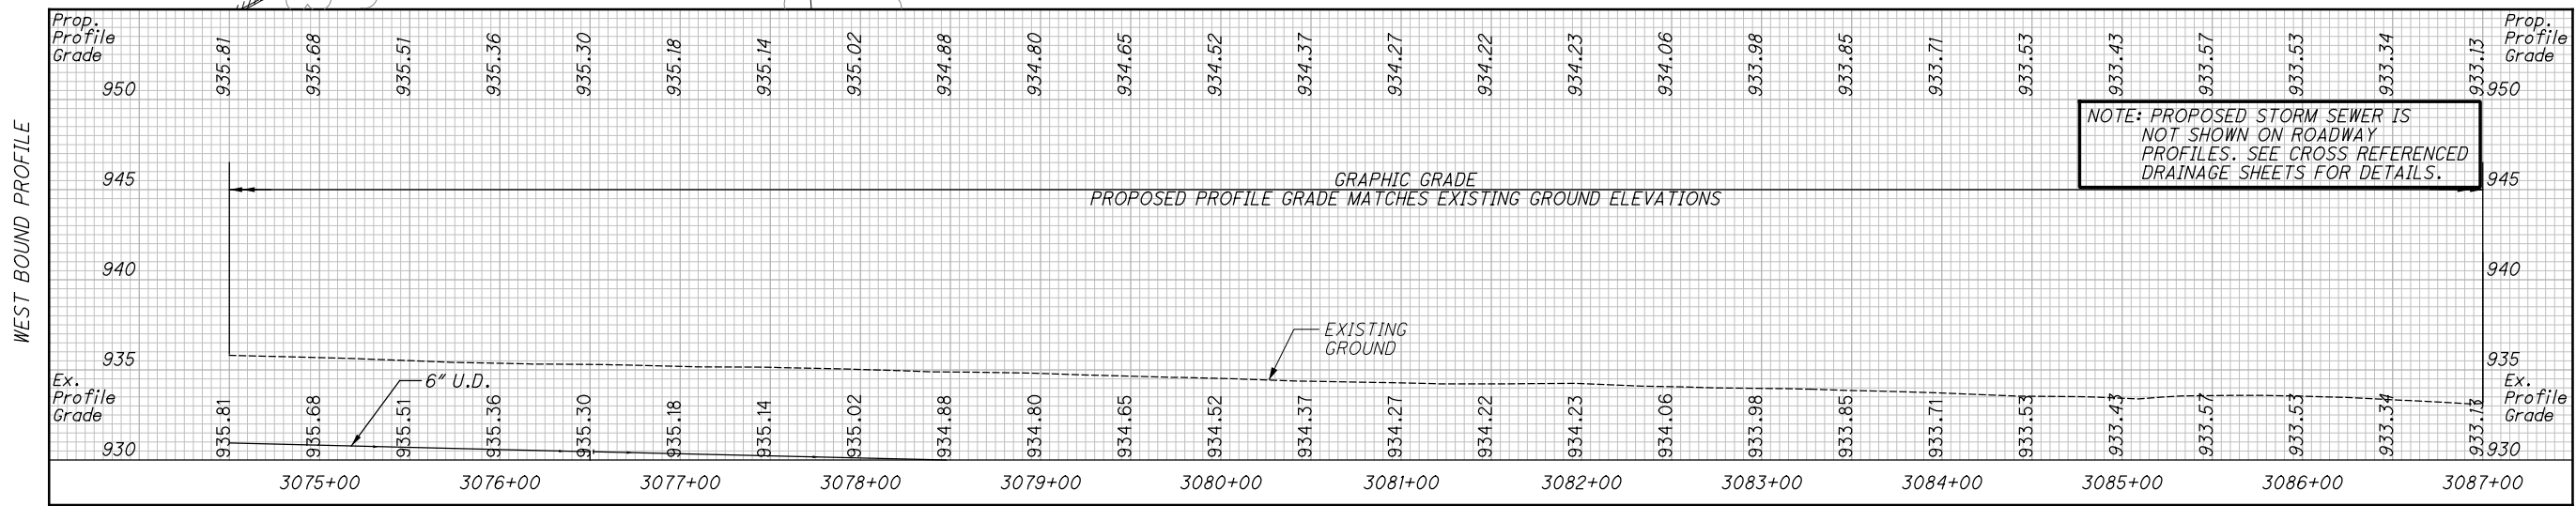

P:\PR41806AA\FRA\80748\ROADWAY\SHEETS\80748GPO08.DGN



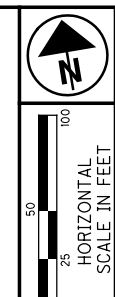


CALCULATED  
KOD  
CHECKED  
MAH

PLAN AND PROFILE - U.S. 33 EB & WB  
STA. 2087+00.00 EB & 3086+02.00 WB TO  
STA. 2099+00.00 EB & 3097+81.02 WB

UNI - 33 - 24.87

143  
923

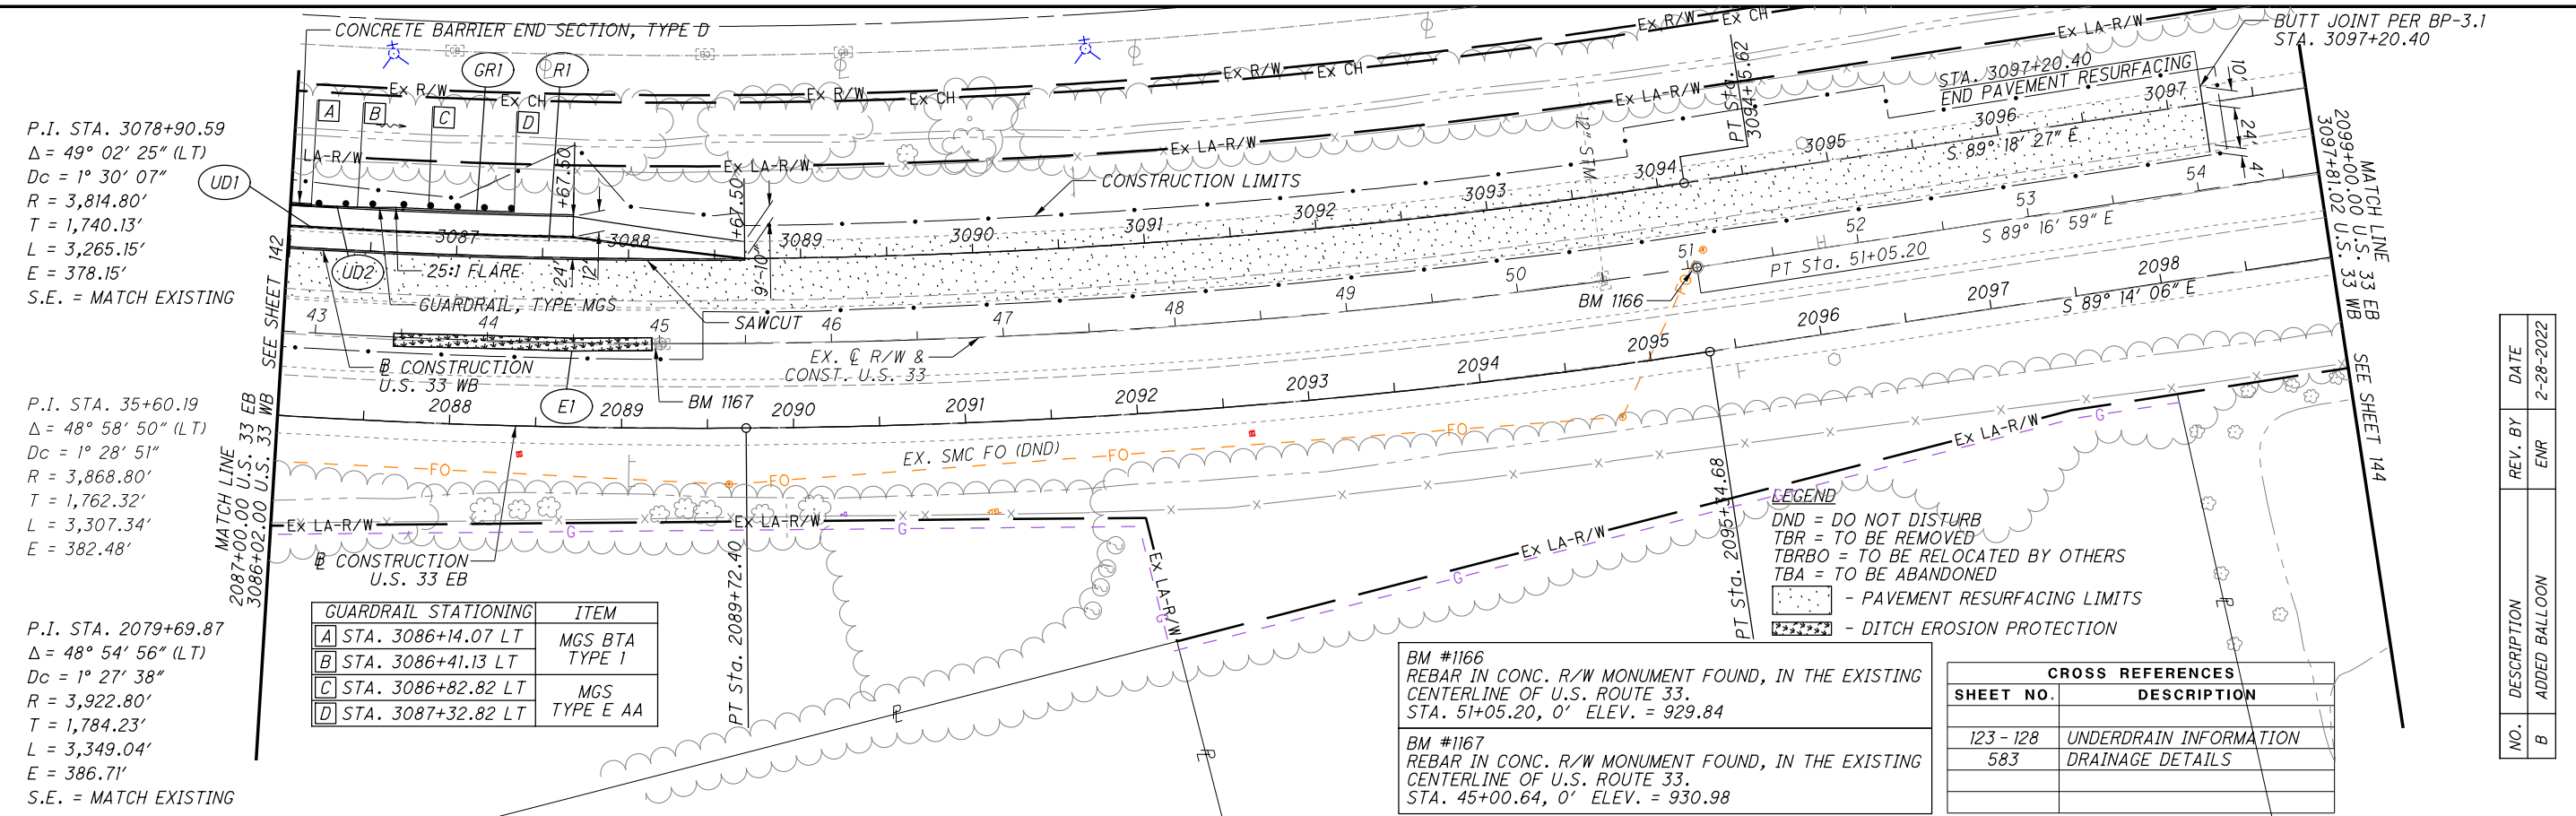


GUARDRAIL STATIONING	ITEM
A STA. 3086+14.07 LT	MGS BTA
B STA. 3086+41.13 LT	TYPE 1
C STA. 3086+82.82 LT	MGS
D STA. 3087+32.82 LT	TYPE E AA

BM #1166  
REBAR IN CONC. R/W MONUMENT FOUND, IN THE EXISTING CENTERLINE OF U.S. ROUTE 33.  
STA. 51+05.20, 0' ELEV. = 929.84

BM #1167  
REBAR IN CONC. R/W MONUMENT FOUND, IN THE EXISTING CENTERLINE OF U.S. ROUTE 33.  
STA. 45+00.64, 0' ELEV. = 930.98

CROSS REFERENCES	
SHEET NO.	DESCRIPTION
123 - 128	UNDERDRAIN INFORMATION
583	DRAINAGE DETAILS

NO.	DESCRIPTION	REV. BY	DATE
B	ADDED BALLOON	EMR	2-28-2022

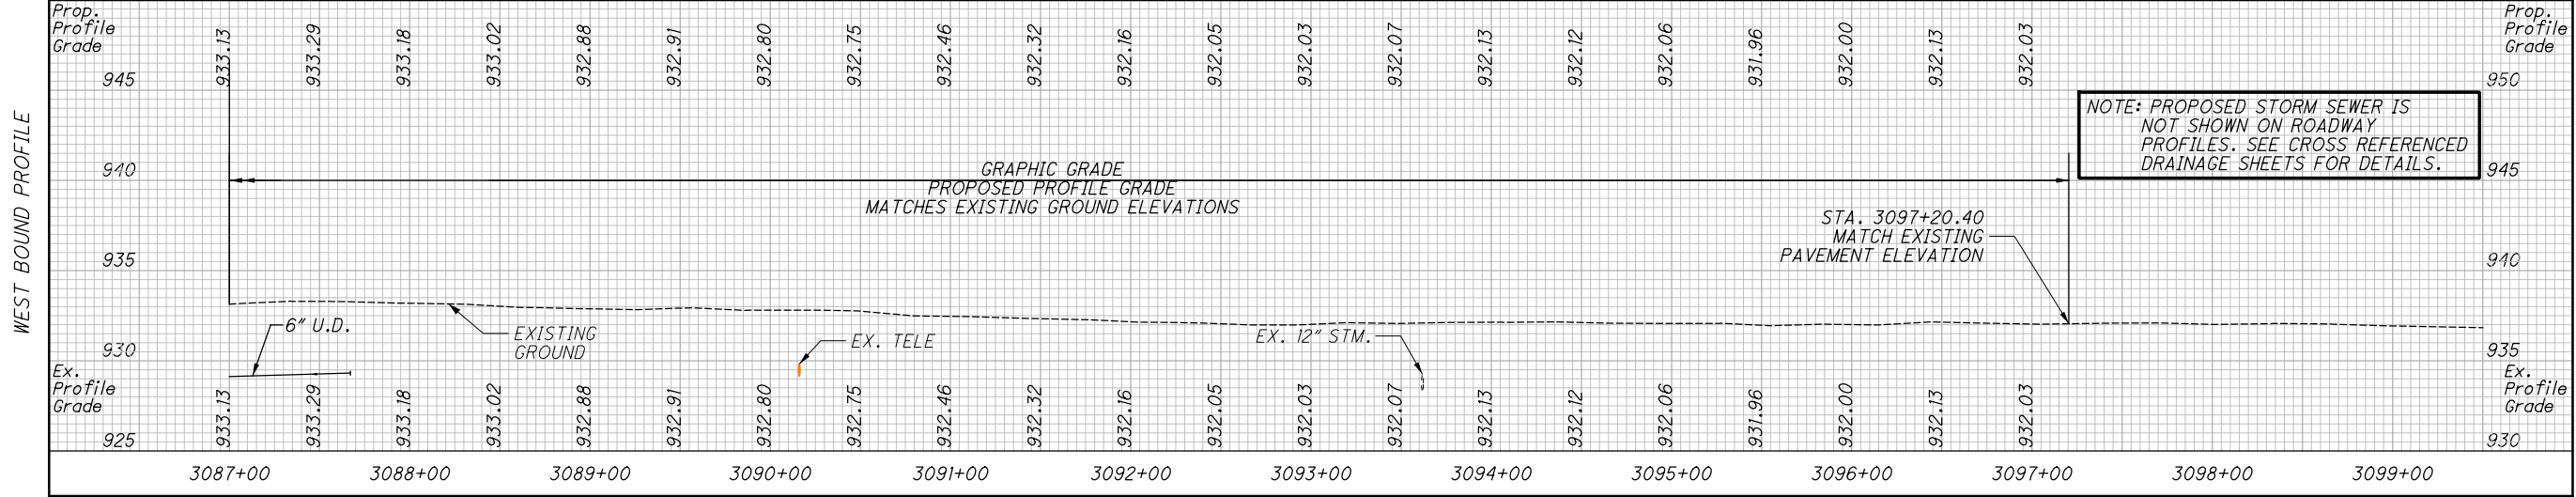

P:\PR41806AA\FRA\80748\ROADWAY\SHEETS\80748GP009.DGN




CALCULATED  
MRT  
CHECKED  
MAH

PLAN - S.R. 161  
BEGIN TO STA. 42+00.00

UNI-33-24.87

145  
923

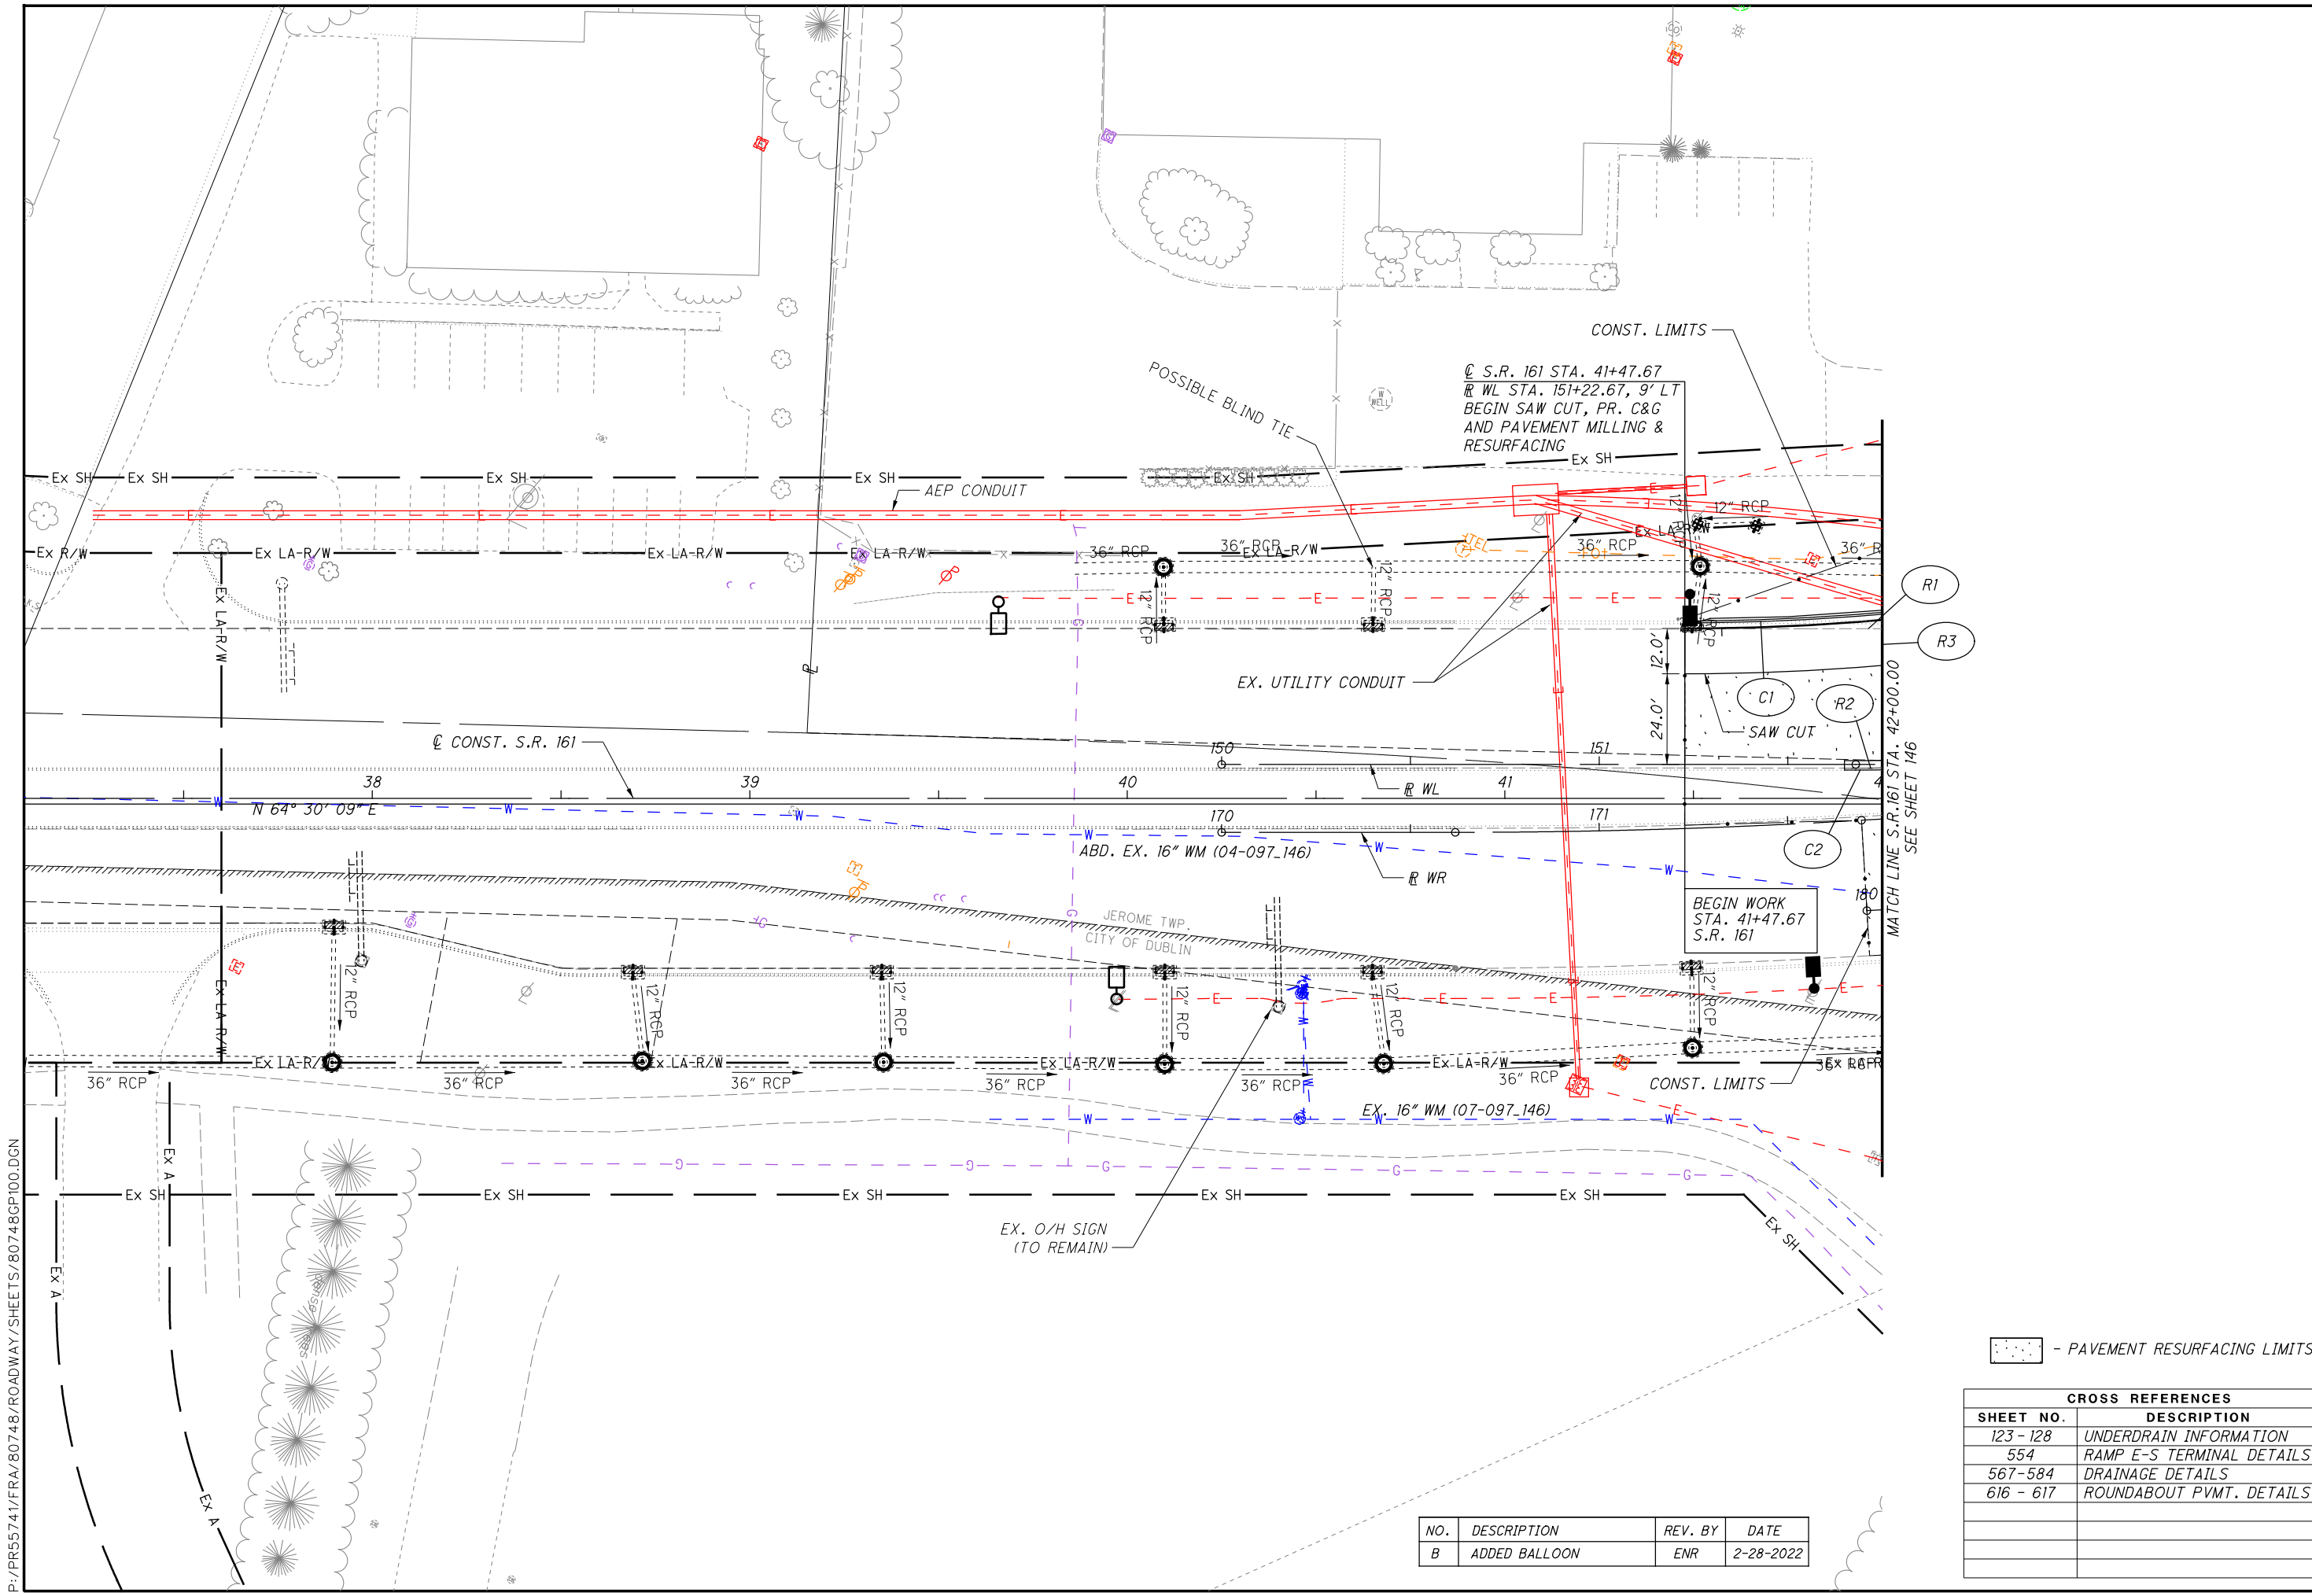

- PAVEMENT RESURFACING LIMITS

CROSS REFERENCES	
SHEET NO.	DESCRIPTION
123 - 128	UNDERDRAIN INFORMATION
554	RAMP E-S TERMINAL DETAILS
567-584	DRAINAGE DETAILS
616 - 617	ROUNDBOUT PVMT. DETAILS

NO.	DESCRIPTION	REV. BY	DATE
B	ADDED BALLOON	ENR	2-28-2022

P:\PR55741\FRA\80748\ROADWAY\SHEETS\80748GP100.DGN

NO.	DESCRIPTION	REV. BY	DATE
B	ADDED BALLOON	ENR	2-28-2022




0 20 40  
HORIZONTAL SCALE IN FEET

CALCULATED  
MRT  
CHECKED  
MAH

PLAN - S.R. 161  
STA. 42+00.00 TO STA. 47+50.00

UNI-33-24.87

146  
923

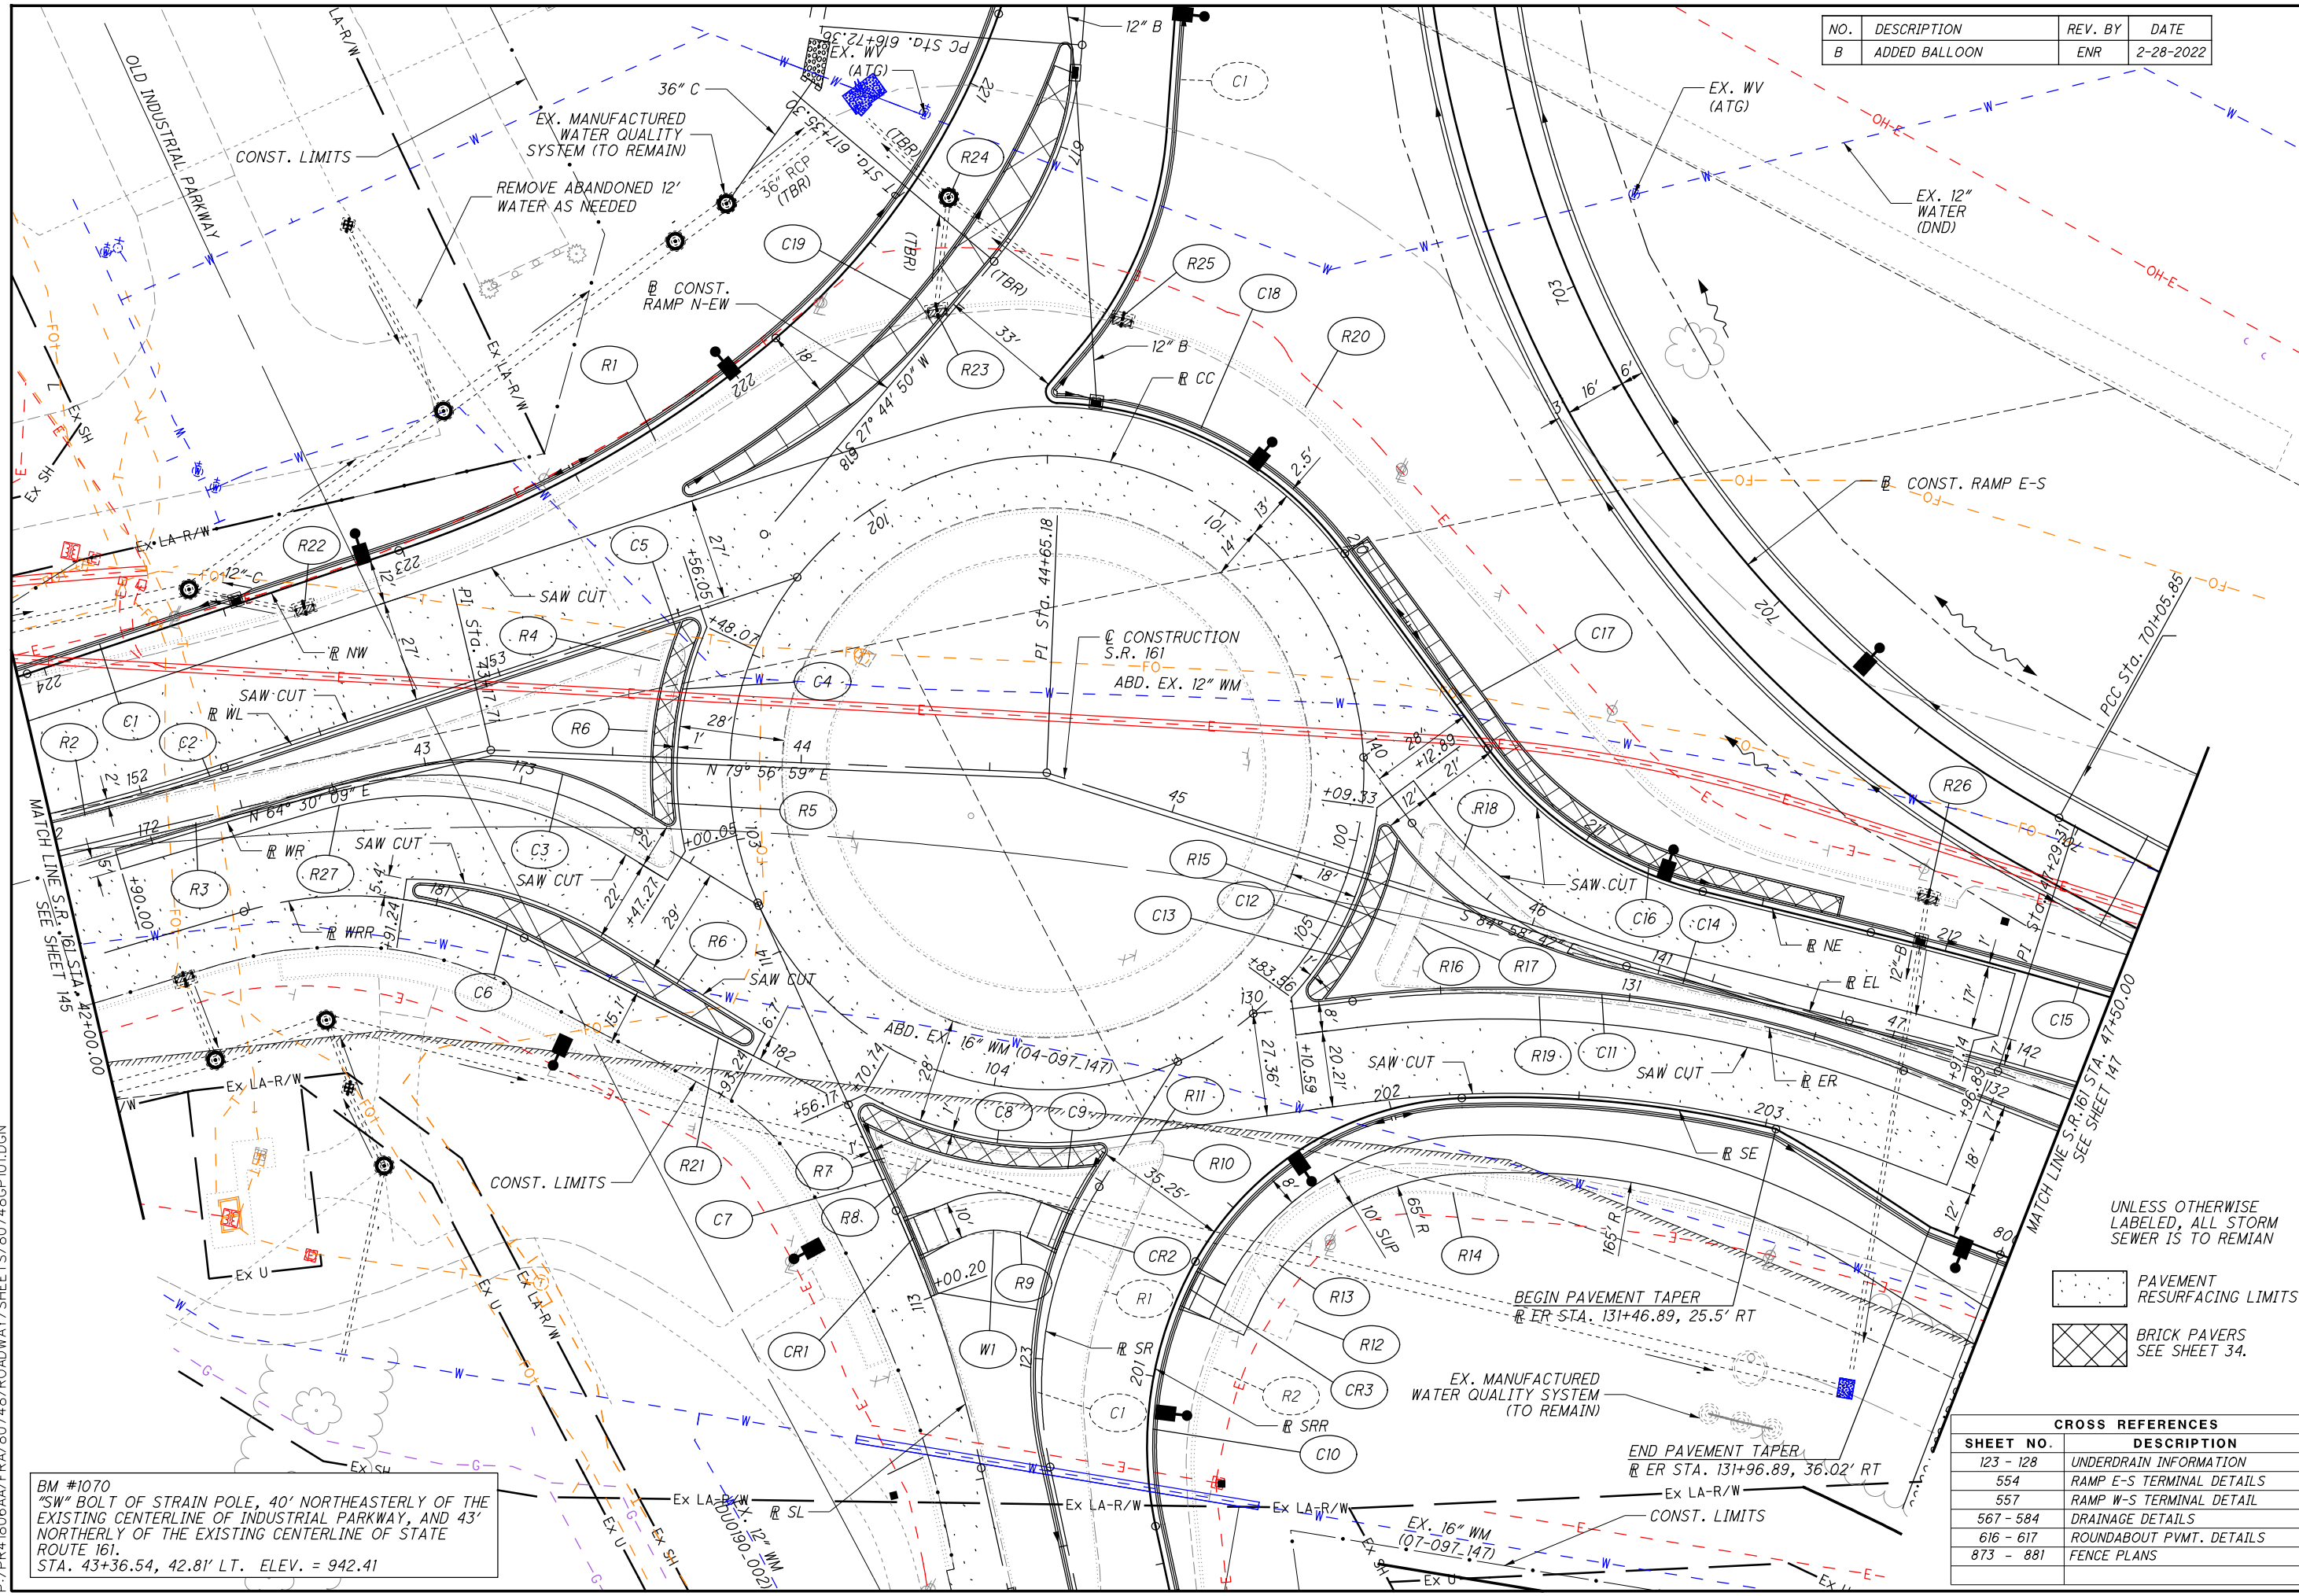

BM #1070  
"SW" BOLT OF STRAIN POLE, 40' NORTHEASTERLY OF THE  
EXISTING CENTERLINE OF INDUSTRIAL PARKWAY, AND 43'  
NORTHERLY OF THE EXISTING CENTERLINE OF STATE  
ROUTE 161.  
STA. 43+36.54, 42.81' LT. ELEV. = 942.41

UNLESS OTHERWISE  
LABELED, ALL STORM  
SEWER IS TO REMAIN

- PAVEMENT  
RESURFACING LIMITS
- BRICK PAVERS  
SEE SHEET 34.

CROSS REFERENCES	
SHEET NO.	DESCRIPTION
123 - 128	UNDERDRAIN INFORMATION
554	RAMP E-S TERMINAL DETAILS
557	RAMP W-S TERMINAL DETAIL
567 - 584	DRAINAGE DETAILS
616 - 617	ROUNDBOUT PVMT. DETAILS
873 - 881	FENCE PLANS

P:\PR41806AA\FRA\80748\ROADWAY\SHETS\80748GP101.DGN



CALCULATED  
MRT  
CHECKED  
MAH

PLAN AND PROFILE - S.R. 161  
STA. 47+50.00 TO STA. 52+00.00

UNI-33-24.87


147  
923

**LEGEND**  
 DND = DO NOT DISTURB  
 TBR = TO BE REMOVED  
 TBRBO = TO BE RELOCATED BY OTHERS


- PAVEMENT RESURFACING LIMITS  
 - DITCH EROSION PROTECTION

**NOTE**  
 \* SEE SHEET 135 FOR QUANTITY  
 \*\* SEE SHEET 159 FOR QUANTITY

CROSS REFERENCES	
SHEET NO.	DESCRIPTION
123 - 128	UNDERDRAIN INFORMATION
568 - 570, 583 - 584	DRAINAGE DETAILS
616 - 621	ROUNDABOUT PVMT. DETAILS
554	RAMP E-S TERMINAL DETAILS
557	RAMP W-S TERMINAL DETAILS
609 - 615	UTILITY DUCT PLANS
791 - 805	RETAINING WALL PLANS

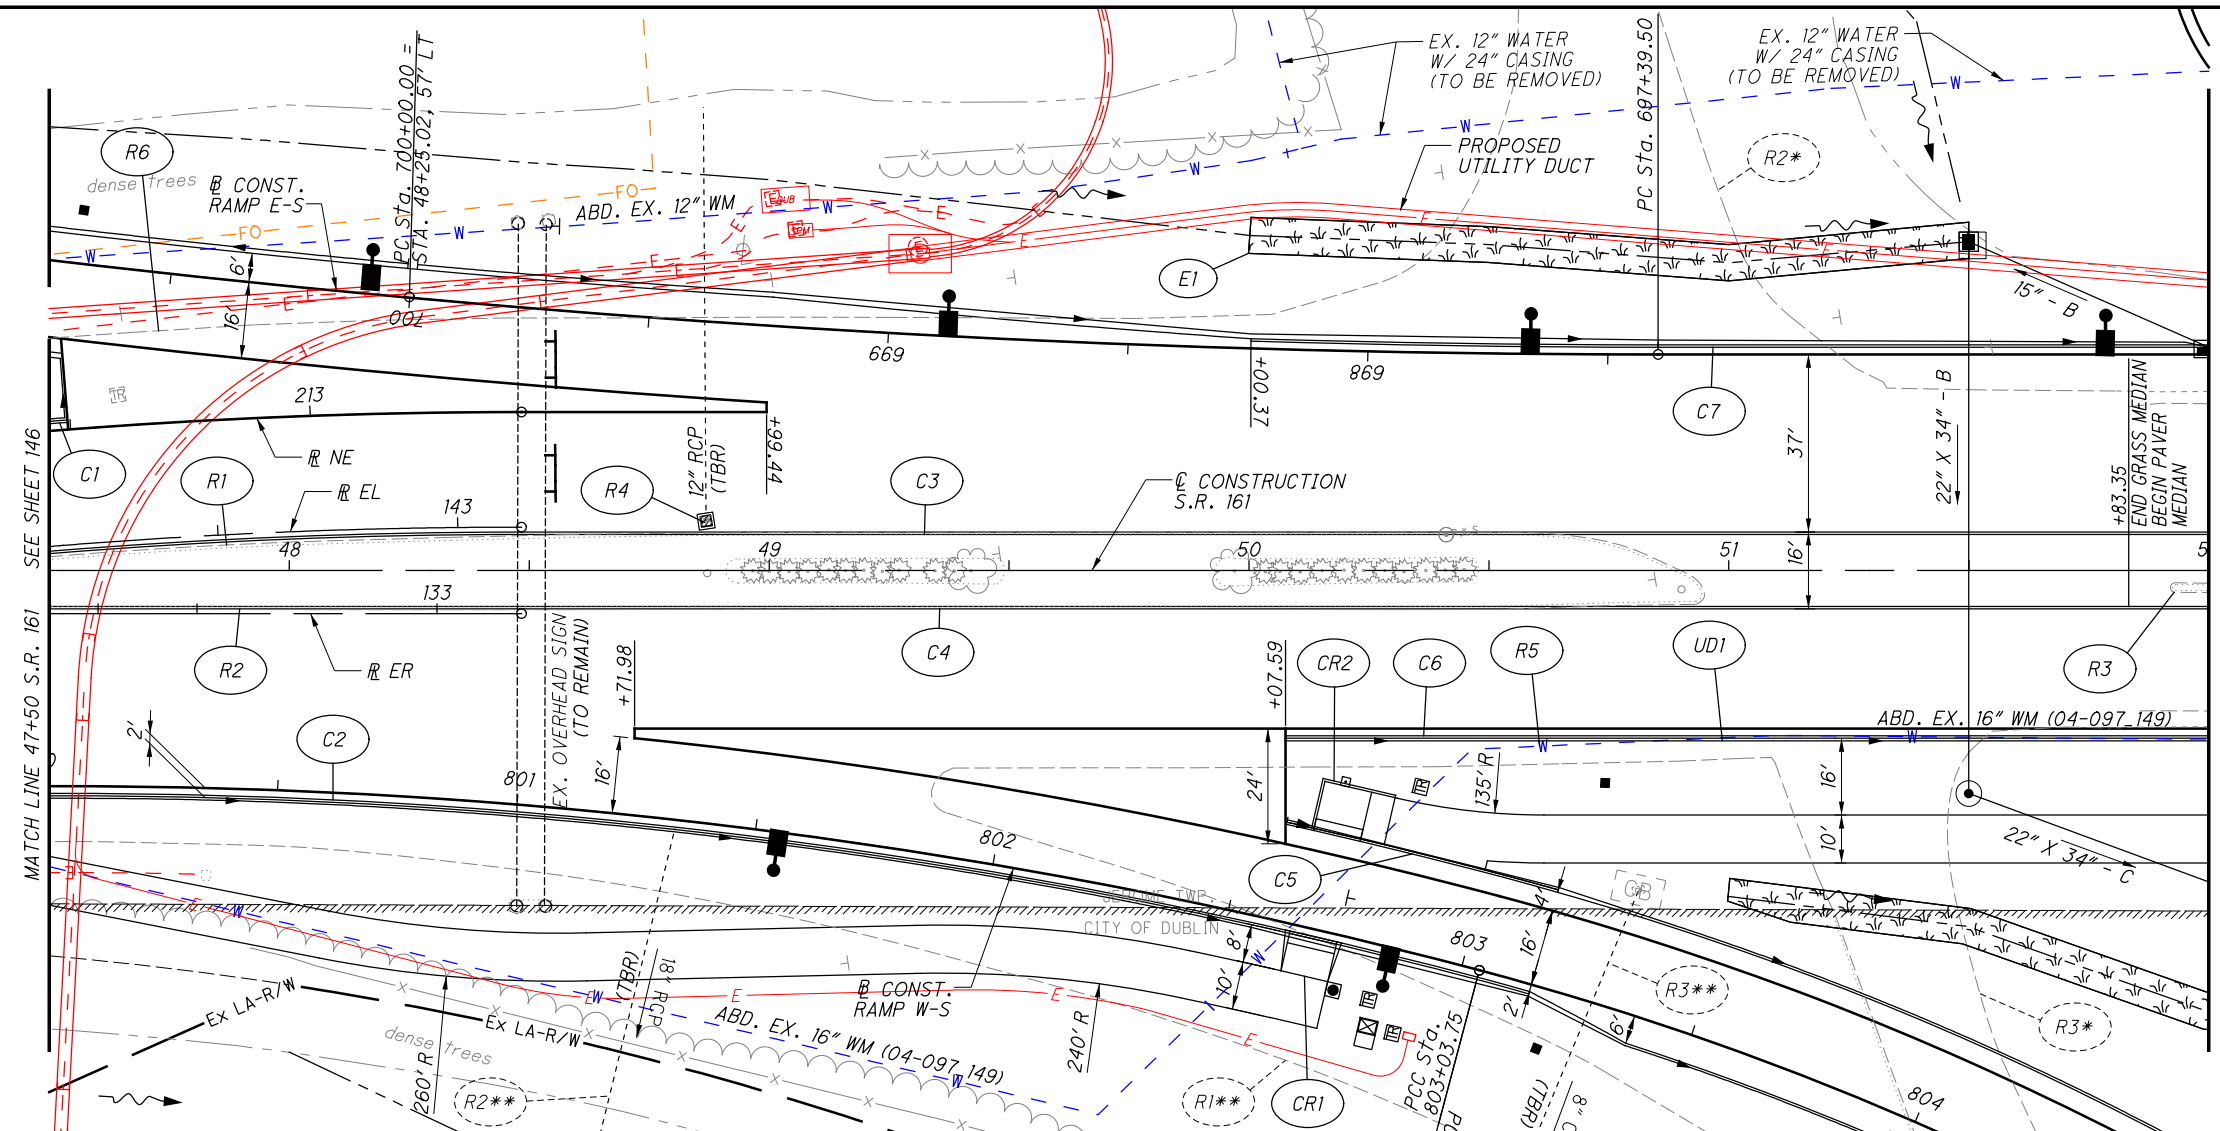

NO.	DESCRIPTION	REV. BY	DATE
B	ADDED BALLOON	ENR	2-28-2022

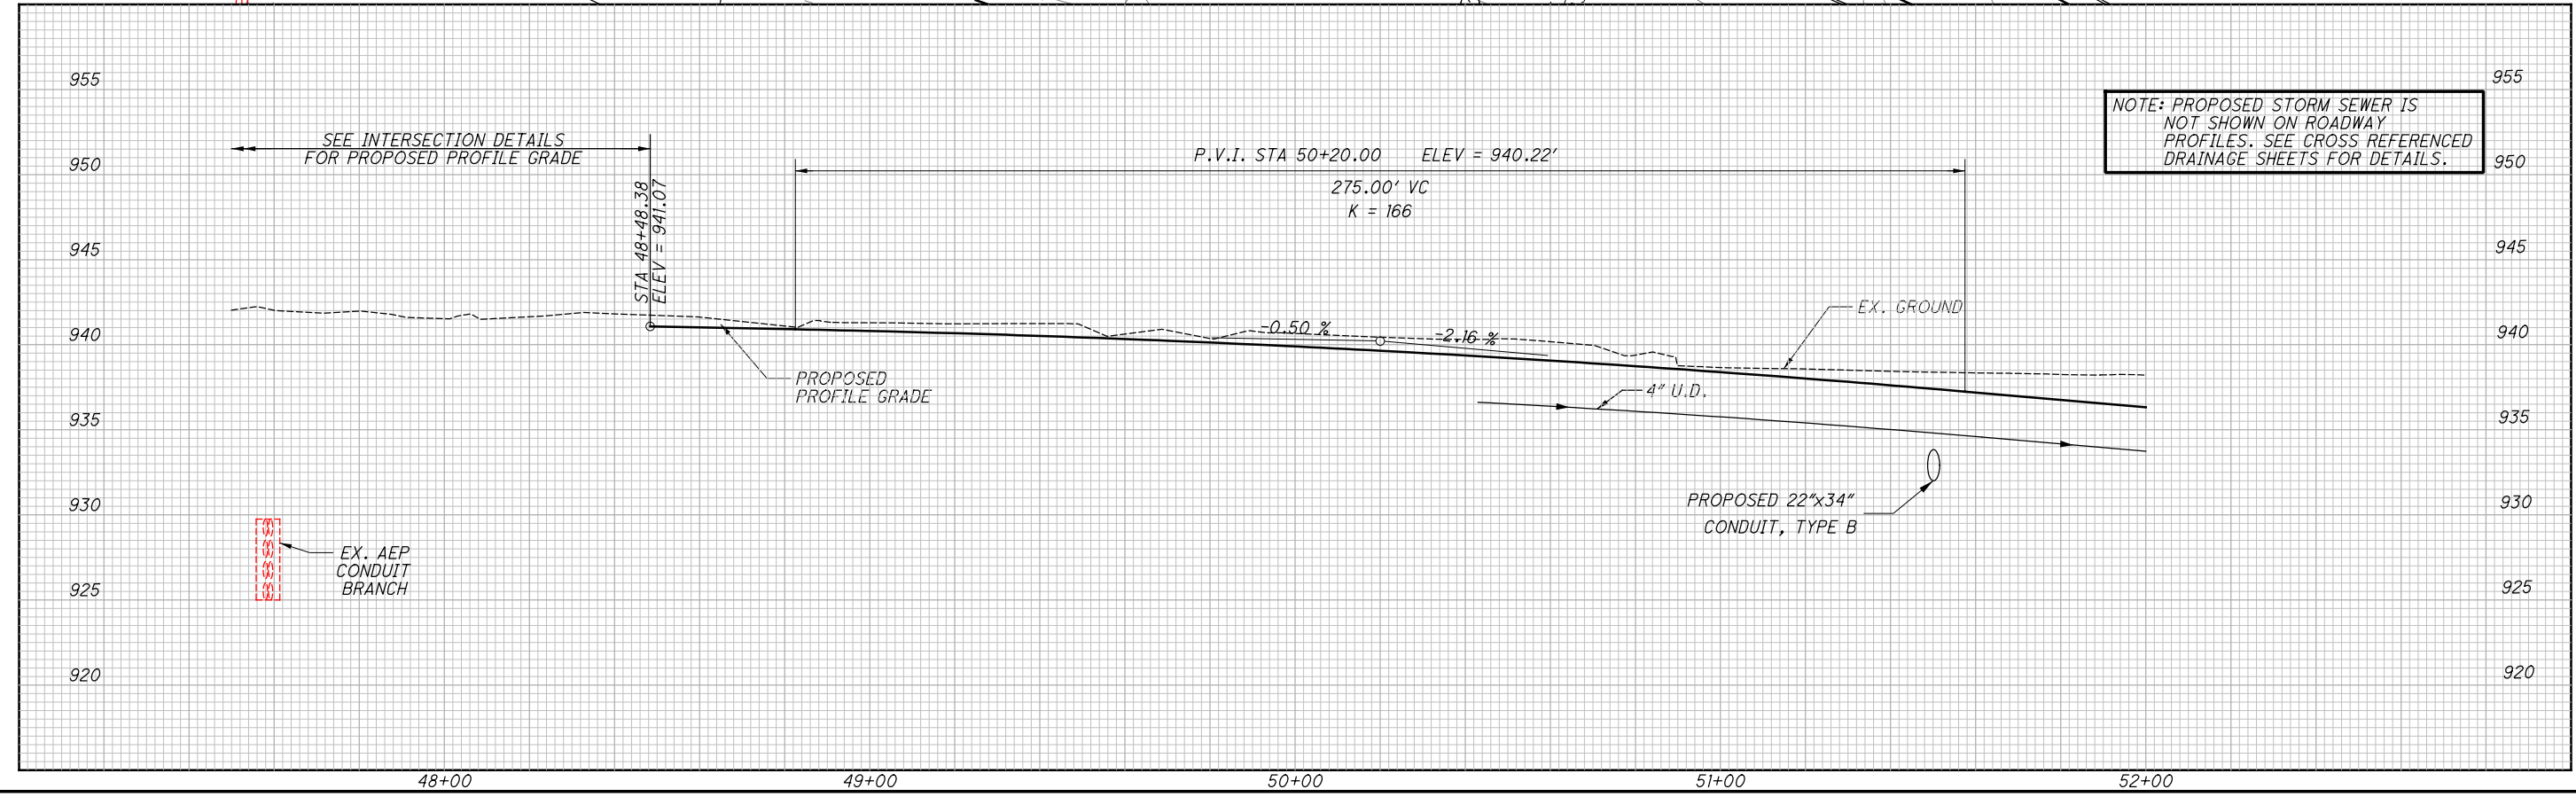

NOTE: PROPOSED STORM SEWER IS NOT SHOWN ON ROADWAY PROFILES. SEE CROSS REFERENCED DRAINAGE SHEETS FOR DETAILS.

P:\PR41806AA\FRA\80748\ROADWAY\SHEETS\80748GP105.DGN

**LEGEND**  
 DND = DO NOT DISTURB  
 TBR = TO BE REMOVED  
 TBRBO = TO BE RELOCATED BY OTHERS


- PAVEMENT RESURFACING LIMITS  
 - DITCH EROSION PROTECTION

\*\* - LOCATE EX. SMC FO AND ADJUST STORM SEWER OR UD INSTALLATION TO AVOID RELOCATION


CROSS REFERENCES	DESCRIPTION
SHEET NO.	
568-570,	DRAINAGE DETAILS
583-584	RAMP E-S TERMINAL DETAILS
554	RAMP W-N TERMINAL DETAILS
560	LANDSCAPE PLANS
	PAVEMENT DETAILS
	UTILITY DUCT PLANS
	STRUCTURE UNI-33-2489 L/R

BM #1160  
 REBAR IN CONC. R/W MONUMENT FOUND, IN THE EXISTING CENTERLINE OF U.S. ROUTE 33.  
 STA. 1327+20.00, 0' ELEV. = 954.38

BM #1069  
 BOLT ON "W" SIDE OF GUARDRAIL, 142' SOUTHWESTERLY OF THE EXISTING CENTERLINE OF U.S. ROUTE 33, AND 6' SOUTHERLY OF THE EXISTING CENTERLINE OF STATE ROUTE 161  
 STA. 52+30.59, 3.90' RT. ELEV. = 938.36

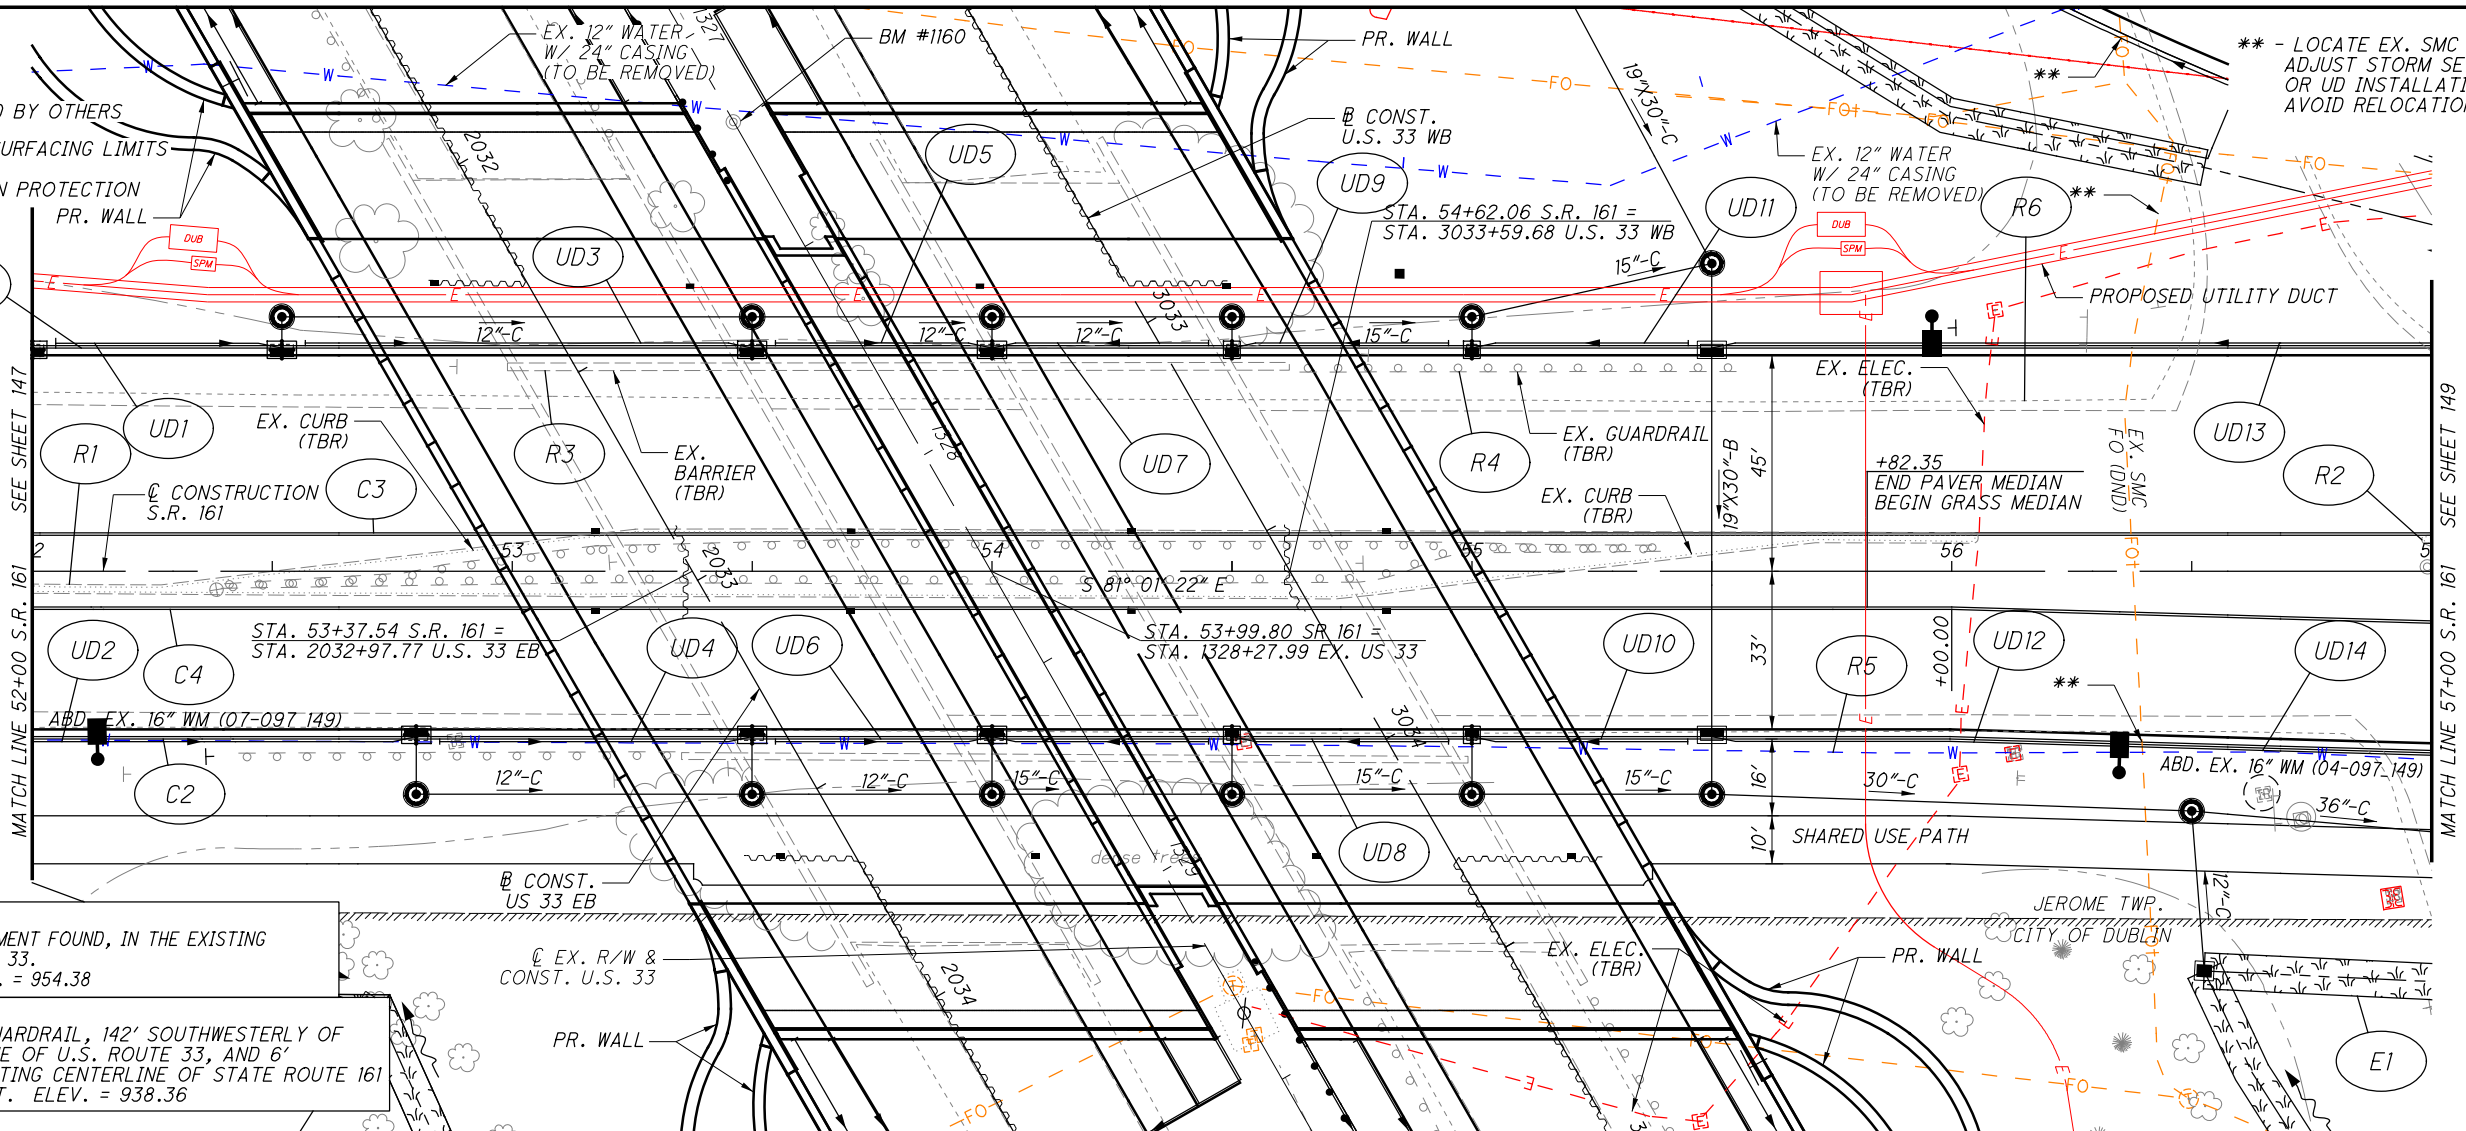

NO.	DESCRIPTION	REV. BY	DATE
B	ADDED BALLOON	ENR	2-28-2022

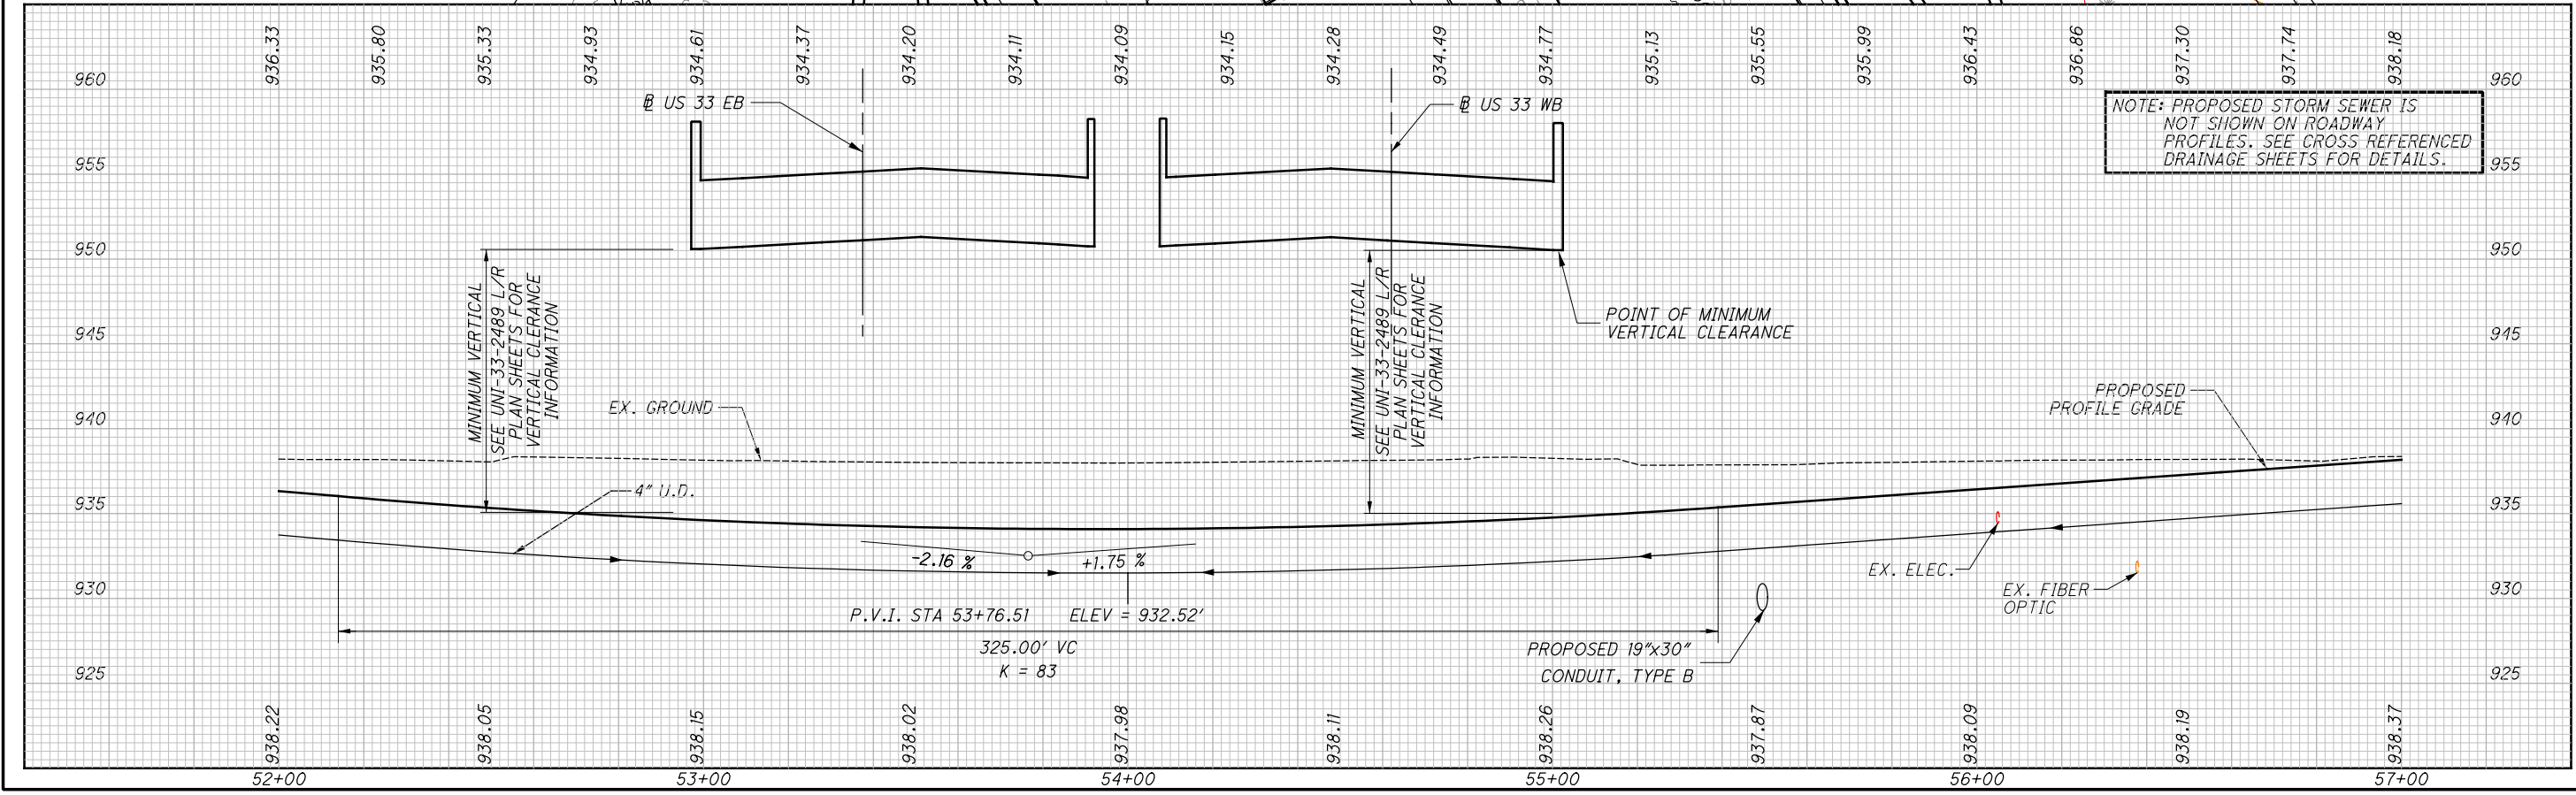

NOTE: PROPOSED STORM SEWER IS NOT SHOWN ON ROADWAY PROFILES. SEE CROSS REFERENCED DRAINAGE SHEETS FOR DETAILS.


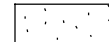
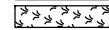
**PLAN AND PROFILE - S.R. 161  
 STA. 52+00.00 TO STA. 57+00.00**


**UNI-33-24.87**

P:\PR41806AA\FRA\80748\ROADWAY\SHEETS\80748GP106.DGN

NO.	DESCRIPTION	REV. BY	DATE
B	ADDED BALLOON	ENR	2-28-2022


LEGEND  
 DND = DO NOT DISTURB  
 TBR = TO BE REMOVED  
 TBRBO = TO BE RELOCATED BY OTHERS

-  BRICK PAVERS SEE SHEET 34.
-  - PAVEMENT RESURFACING LIMITS
-  - DITCH EROSION PROTECTION

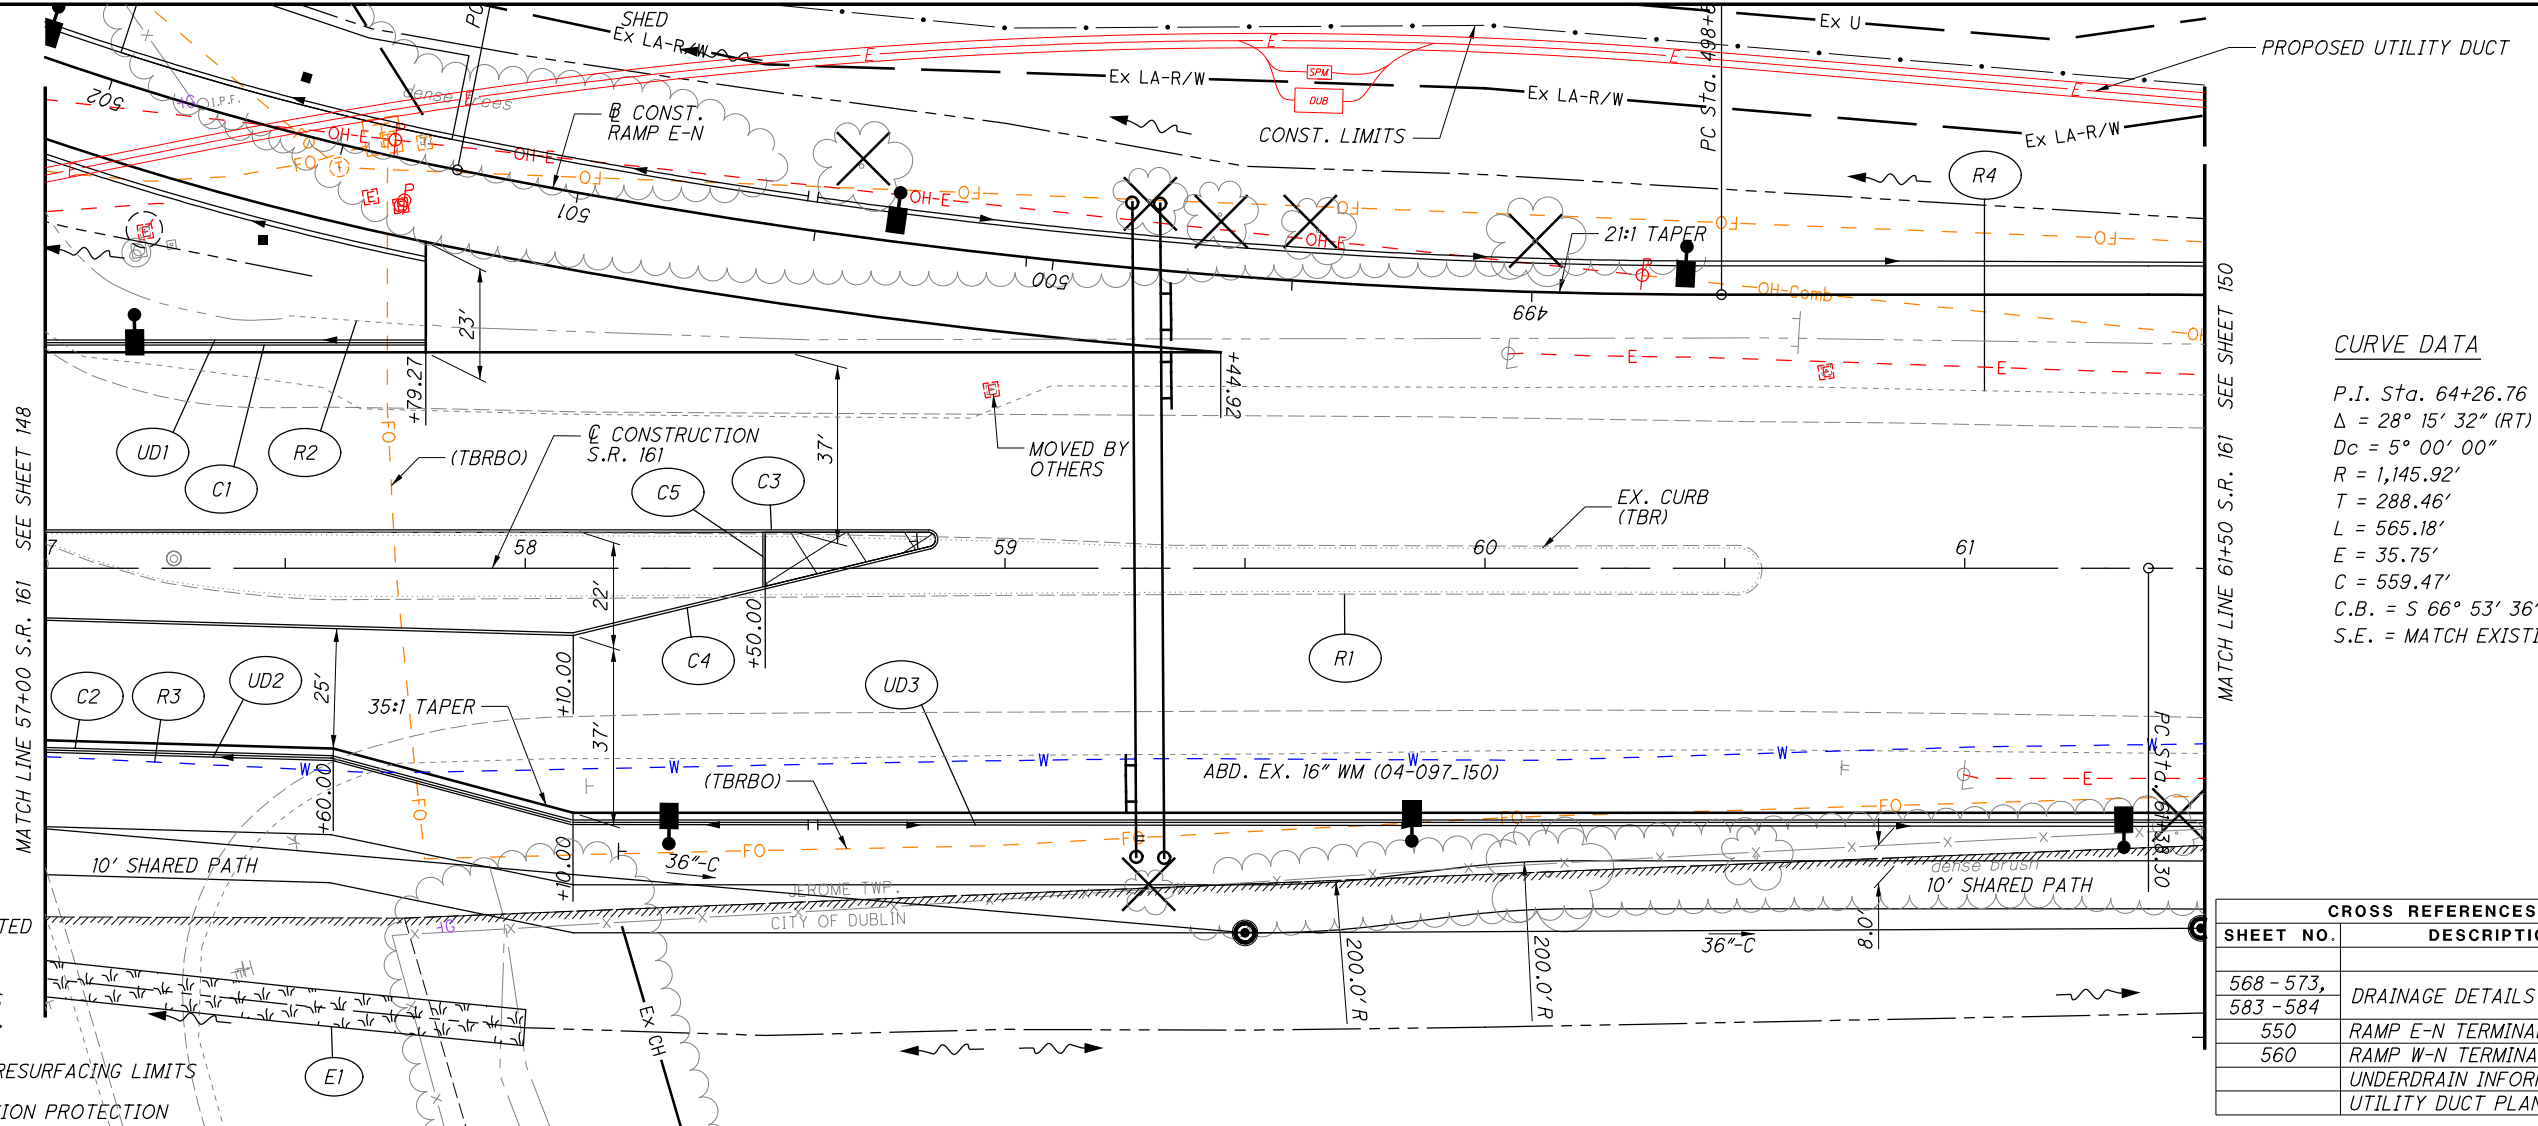

**CURVE DATA**  
 P.I. Sta. 64+26.76  
 $\Delta = 28^\circ 15' 32''$  (RT)  
 $D_c = 5^\circ 00' 00''$   
 $R = 1,145.92'$   
 $T = 288.46'$   
 $L = 565.18'$   
 $E = 35.75'$   
 $C = 559.47'$   
 C.B. = S  $66^\circ 53' 36''$  E  
 S.E. = MATCH EXISTING

CROSS REFERENCES	
SHEET NO.	DESCRIPTION
568 - 573, 583 - 584	DRAINAGE DETAILS
550	RAMP E-N TERMINAL DETAILS
560	RAMP W-N TERMINAL DETAILS
	UNDERDRAIN INFORMATION
	UTILITY DUCT PLANS

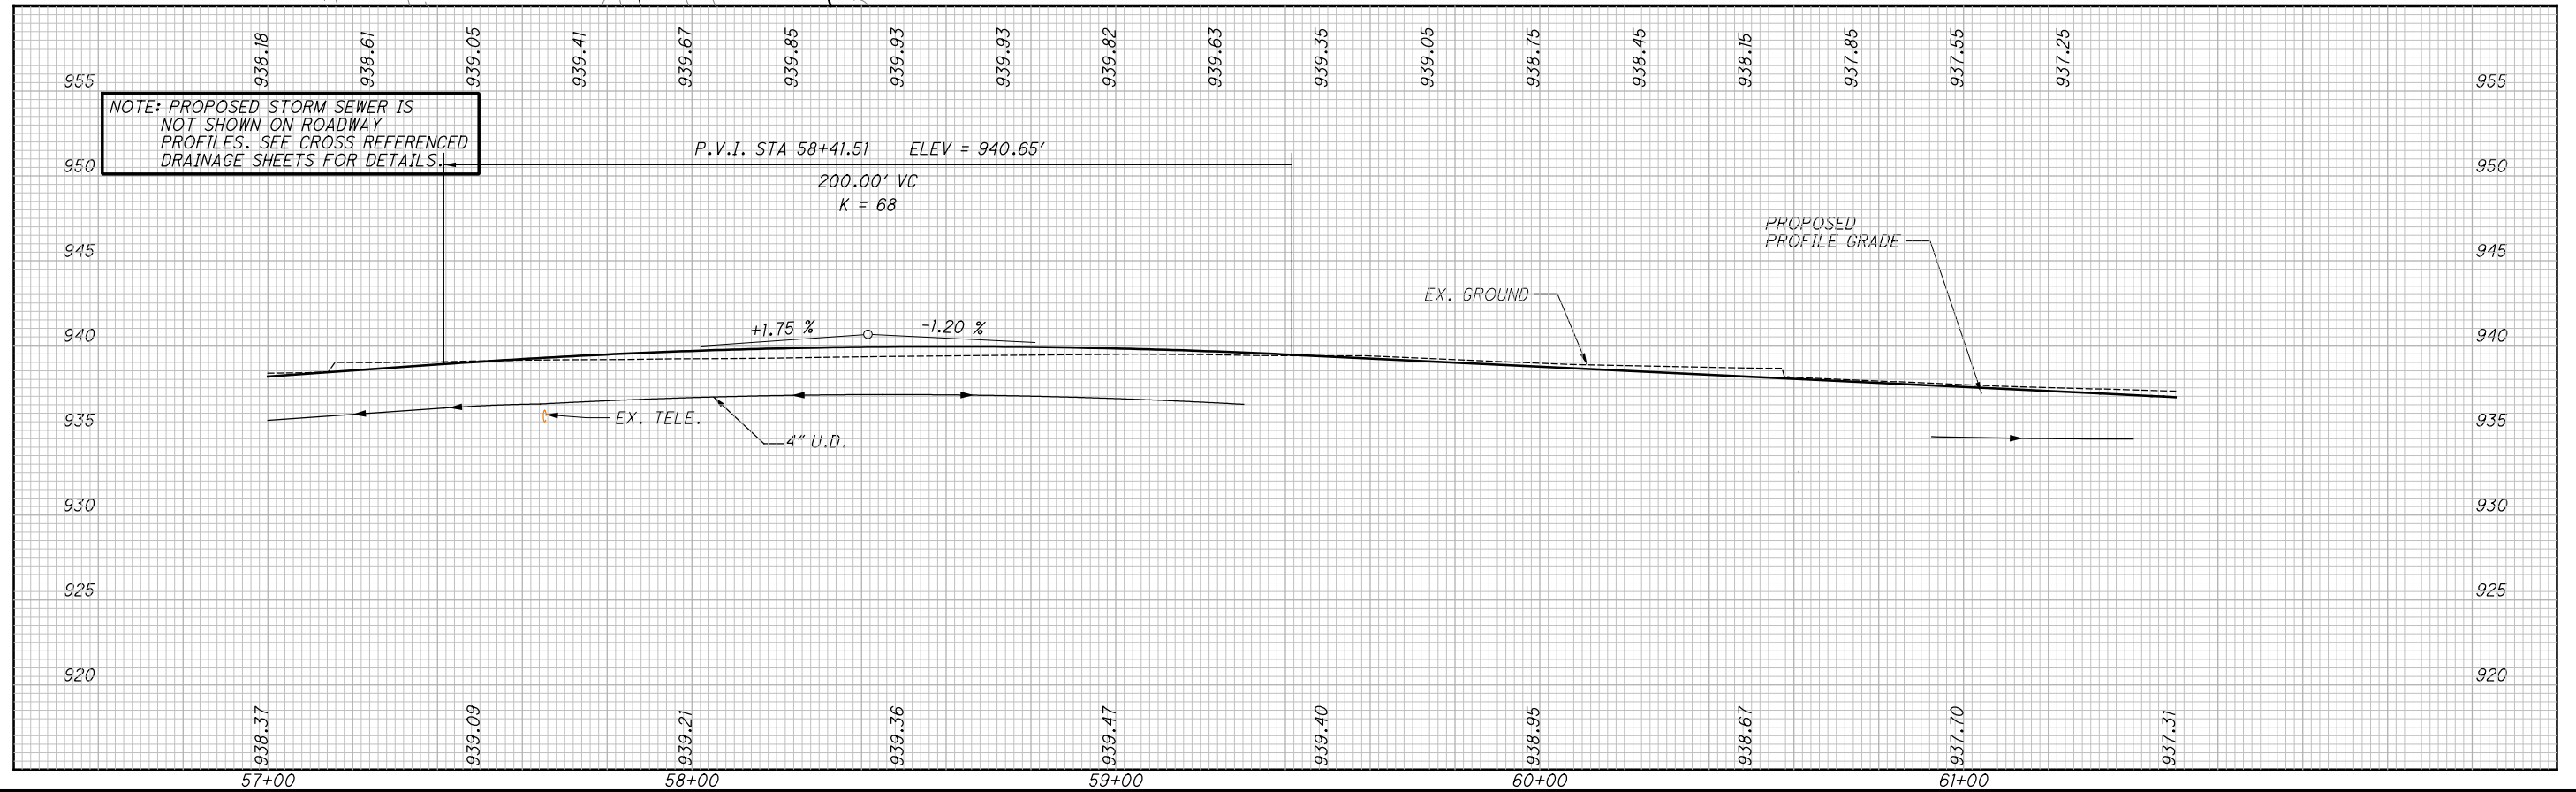

PLAN AND PROFILE - S.R. 161  
 STA. 57+00.00 TO STA. 61+50.00

UNI-33-24.87

149  
 923

BM #1162  
REBAR IN CONC. R/W MONUMENT FOUND, IN THE EXISTING  
CENTERLINE OF U.S. ROUTE 33.  
STA. 1344+36.44, 0' ELEV. = 939.13

BM #1001  
BRASS PLAQUE, FRANKLIN COUNTY ENGINEER'S BENCHMARK  
N32, WEST OF THE EXISTING CENTERLINE OF POST ROAD.  
STATION 13+61.72, 12.97' WEST, ELEV. = 934.12

RP# 1068  
SOUTHEAST BOLT OF LIGHT POLE BASE (#CC-2/C-9),  
NORTH OF THE EXISTING CENTERLINE OF POST ROAD.  
STA. 243+27.68, 38.89' NORTH, ELEV. 937.29

IPS# 100  
IRON PIN SET, EAST OF THE EXISTING CENTERLINE  
OF LIGGETT ROAD.  
STA. 1+78.79, 35.84' EAST, ELEV. = 936.46


NO.	DESCRIPTION	REV. BY	DATE
B	ADDED BALLOON	ENR	2-28-2022

**LEGEND**

DND = DO NOT DISTURB  
TBR = TO BE REMOVED  
TBRBO = TO BE RELOCATED BY OTHERS  
TBA = TO BE ABANDONED

- PAVEMENT RESURFACING LIMITS  
 - DITCH EROSION PROTECTION


CROSS REFERENCES	
SHEET NO.	DESCRIPTION
571-573, 583-584	DRAINAGE DETAILS
	UNDERDRAIN INFORMATION
	INTERSECTION DETAILS
587-590	WATER WORK
609-615	UTILITY DUCT PLAN

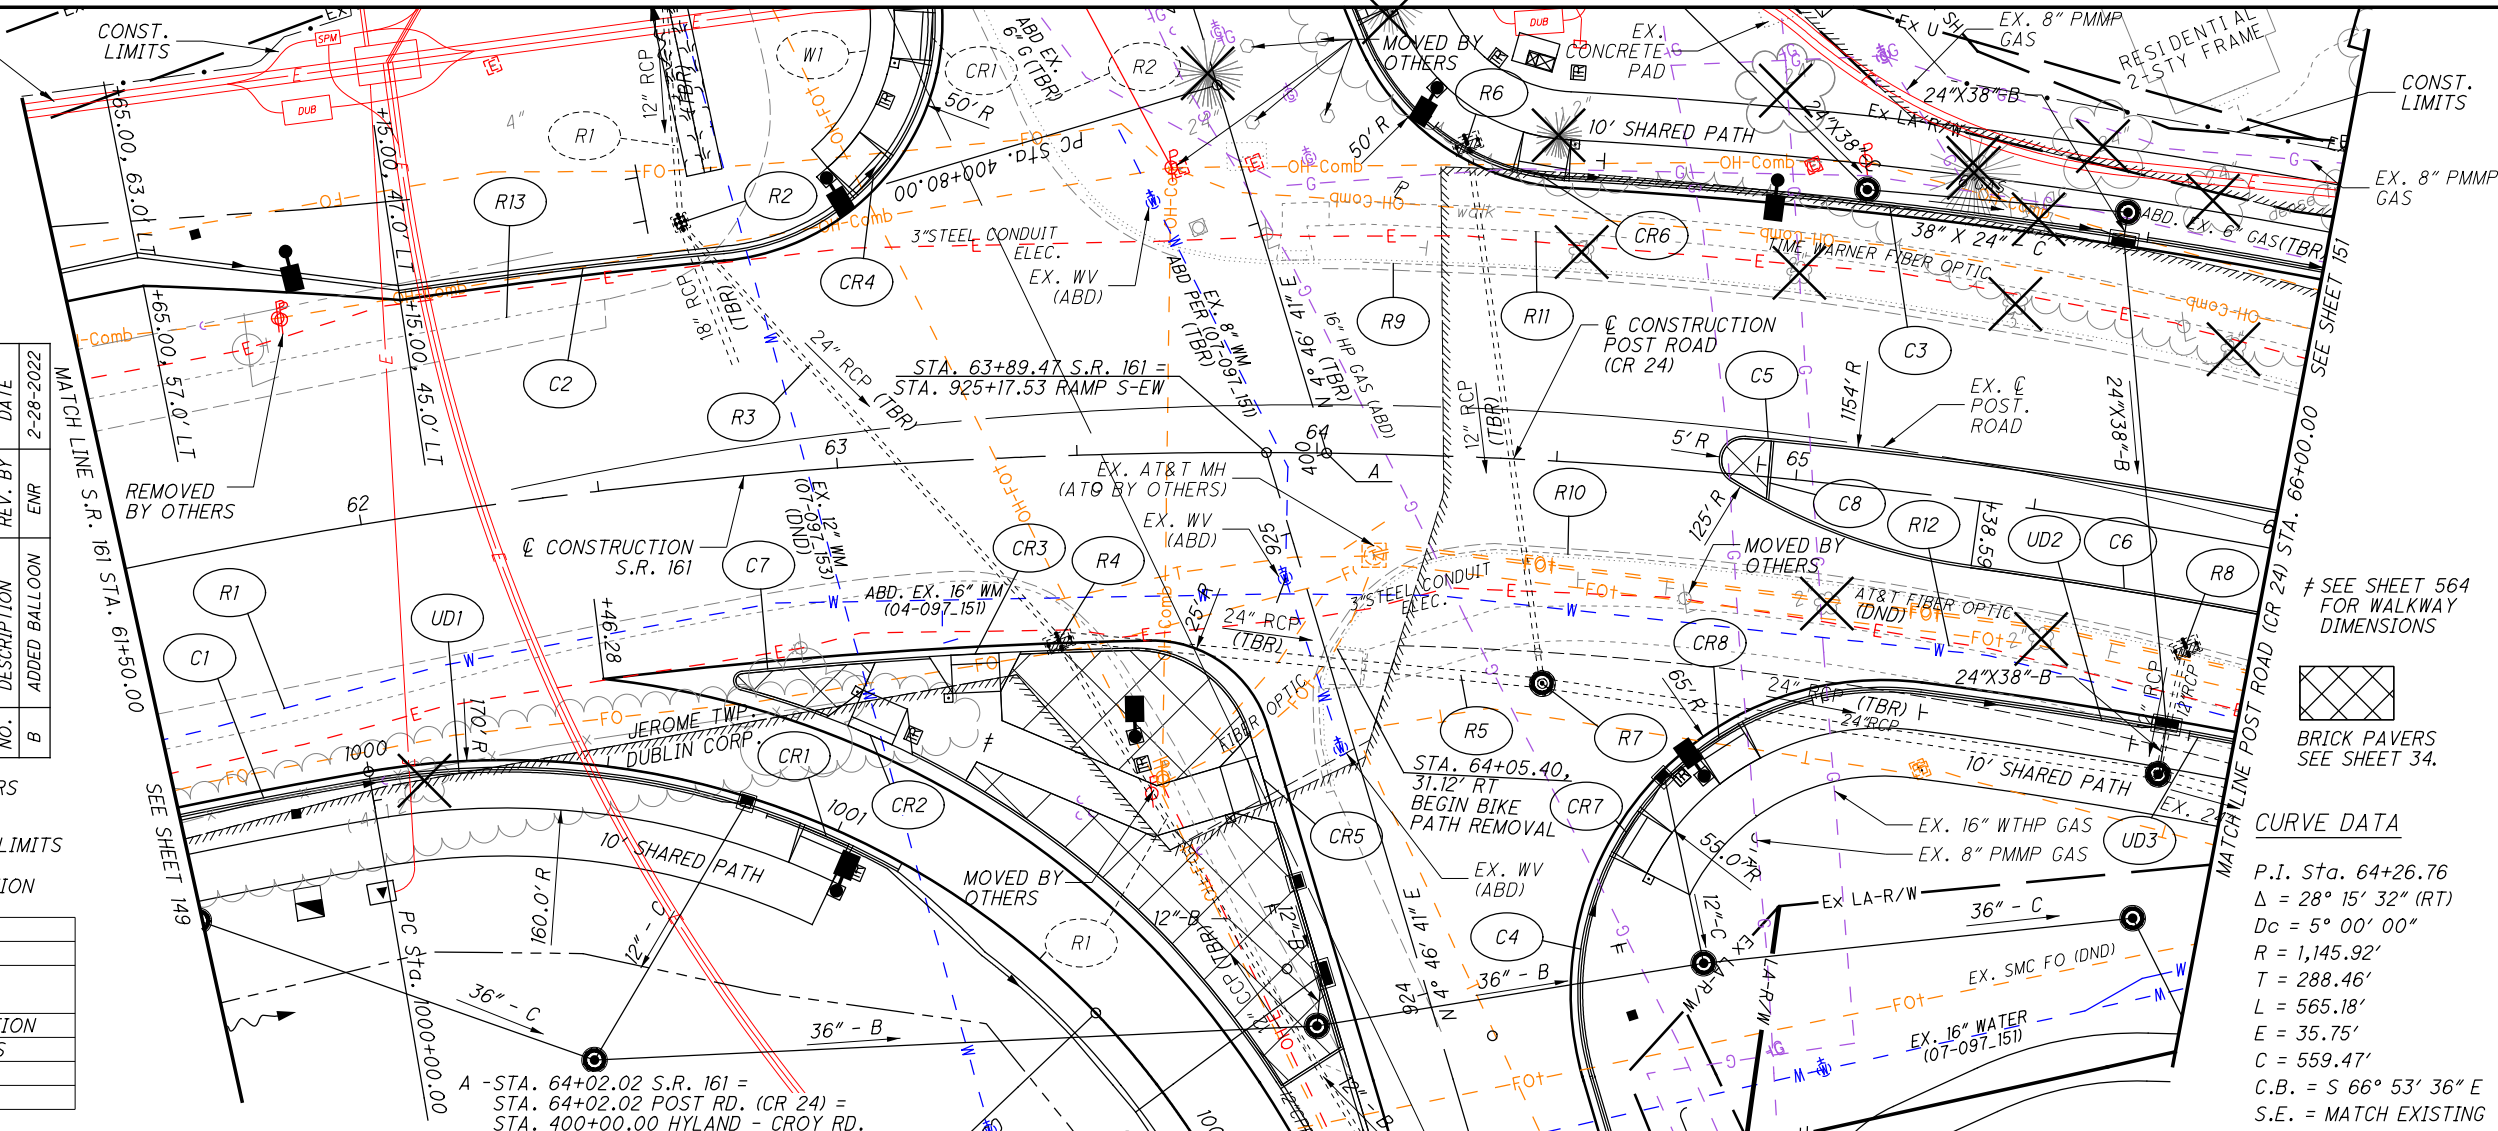

**CURVE DATA**

P.I. Sta. 64+26.76  
 $\Delta = 28^\circ 15' 32''$  (RT)  
 $D_c = 5^\circ 00' 00''$   
 $R = 1,145.92'$   
 $T = 288.46'$   
 $L = 565.18'$   
 $E = 35.75'$   
 $C = 559.47'$   
 $C.B. = S 66^\circ 53' 36'' E$   
 $S.E. = MATCH EXISTING$

NOTE: PROPOSED STORM SEWER IS NOT SHOWN ON ROADWAY PROFILES. SEE CROSS REFERENCED DRAINAGE SHEETS FOR DETAILS.

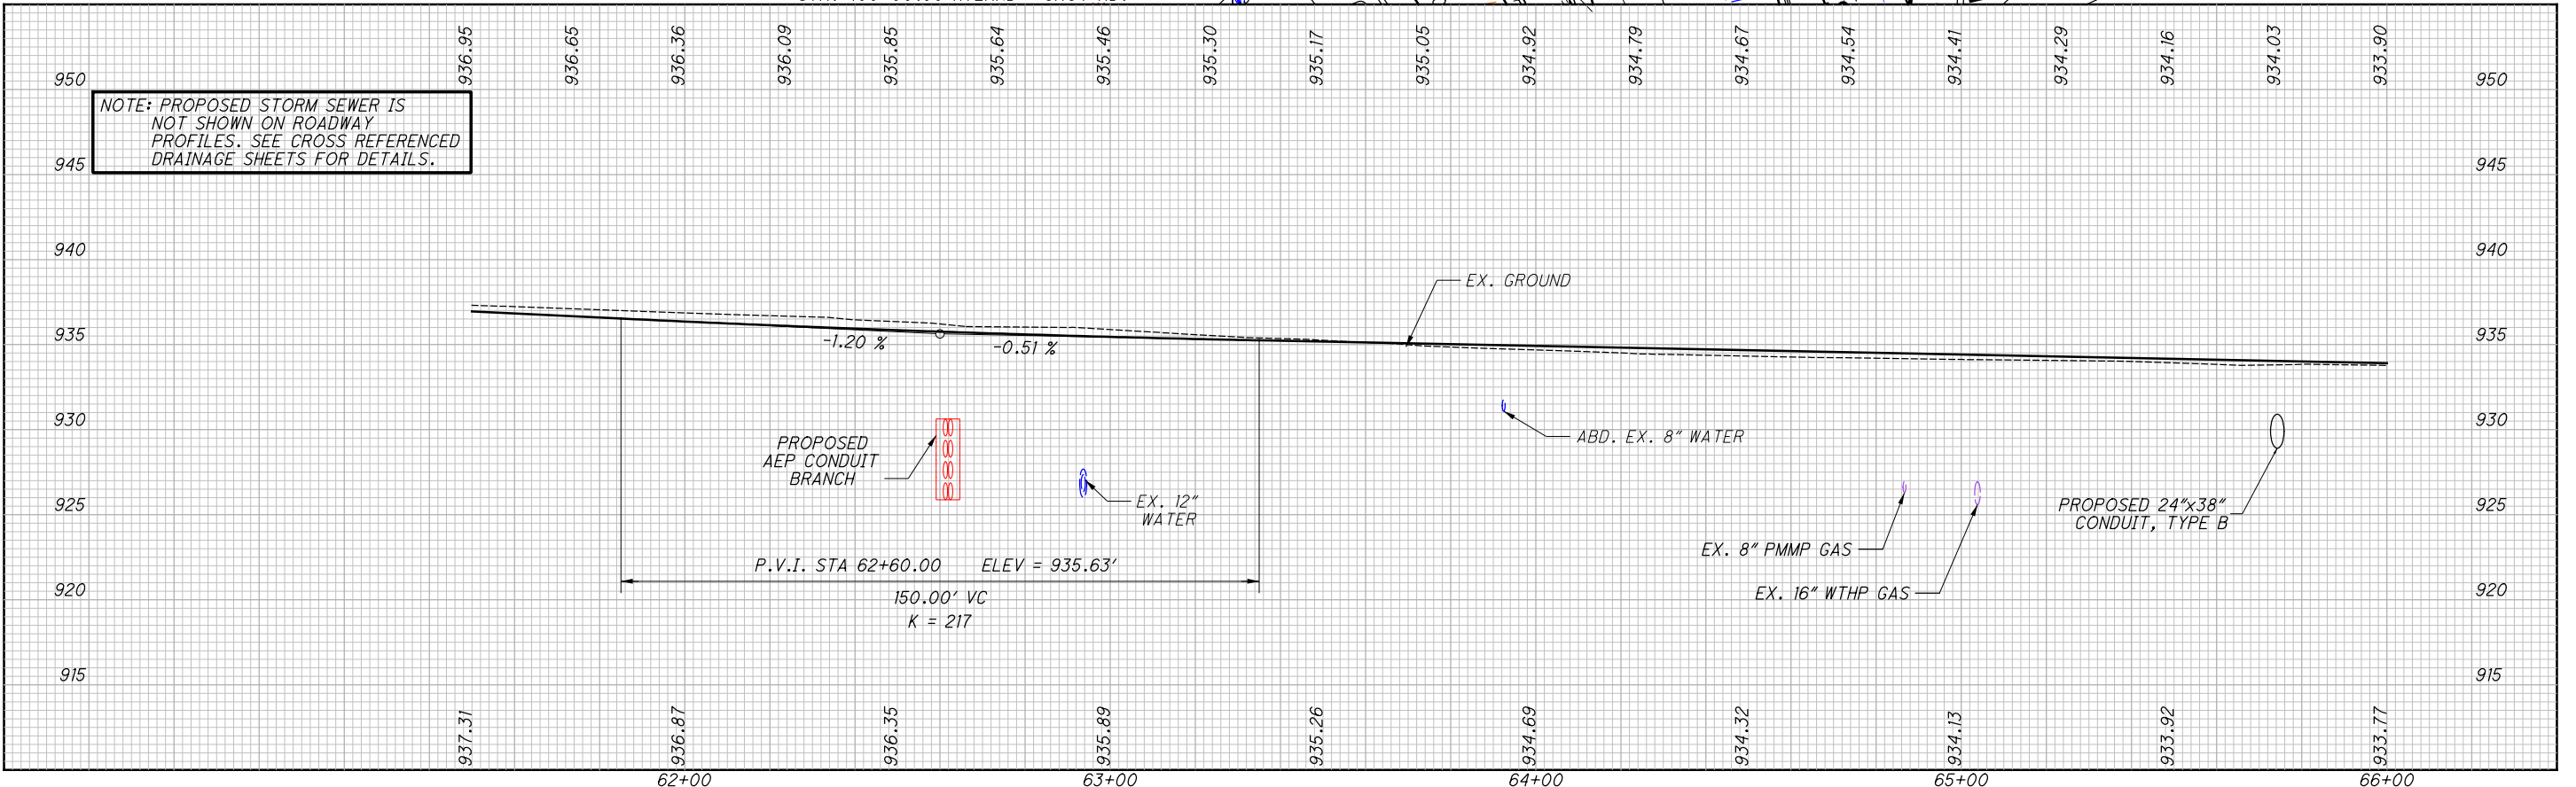

**PLAN AND PROFILE - S.R. 161/ POST RD.**  
**STA. 61+50.00 TO STA. 66+00.00**


**UNI-33-24.87**



CALCULATED MRT  
CHECKED MAH

**PLAN AND PROFILE - POST ROAD (CR 24)  
STA. 66+00.00 TO STA. 71+00.00**

**UNI-33-24.87**

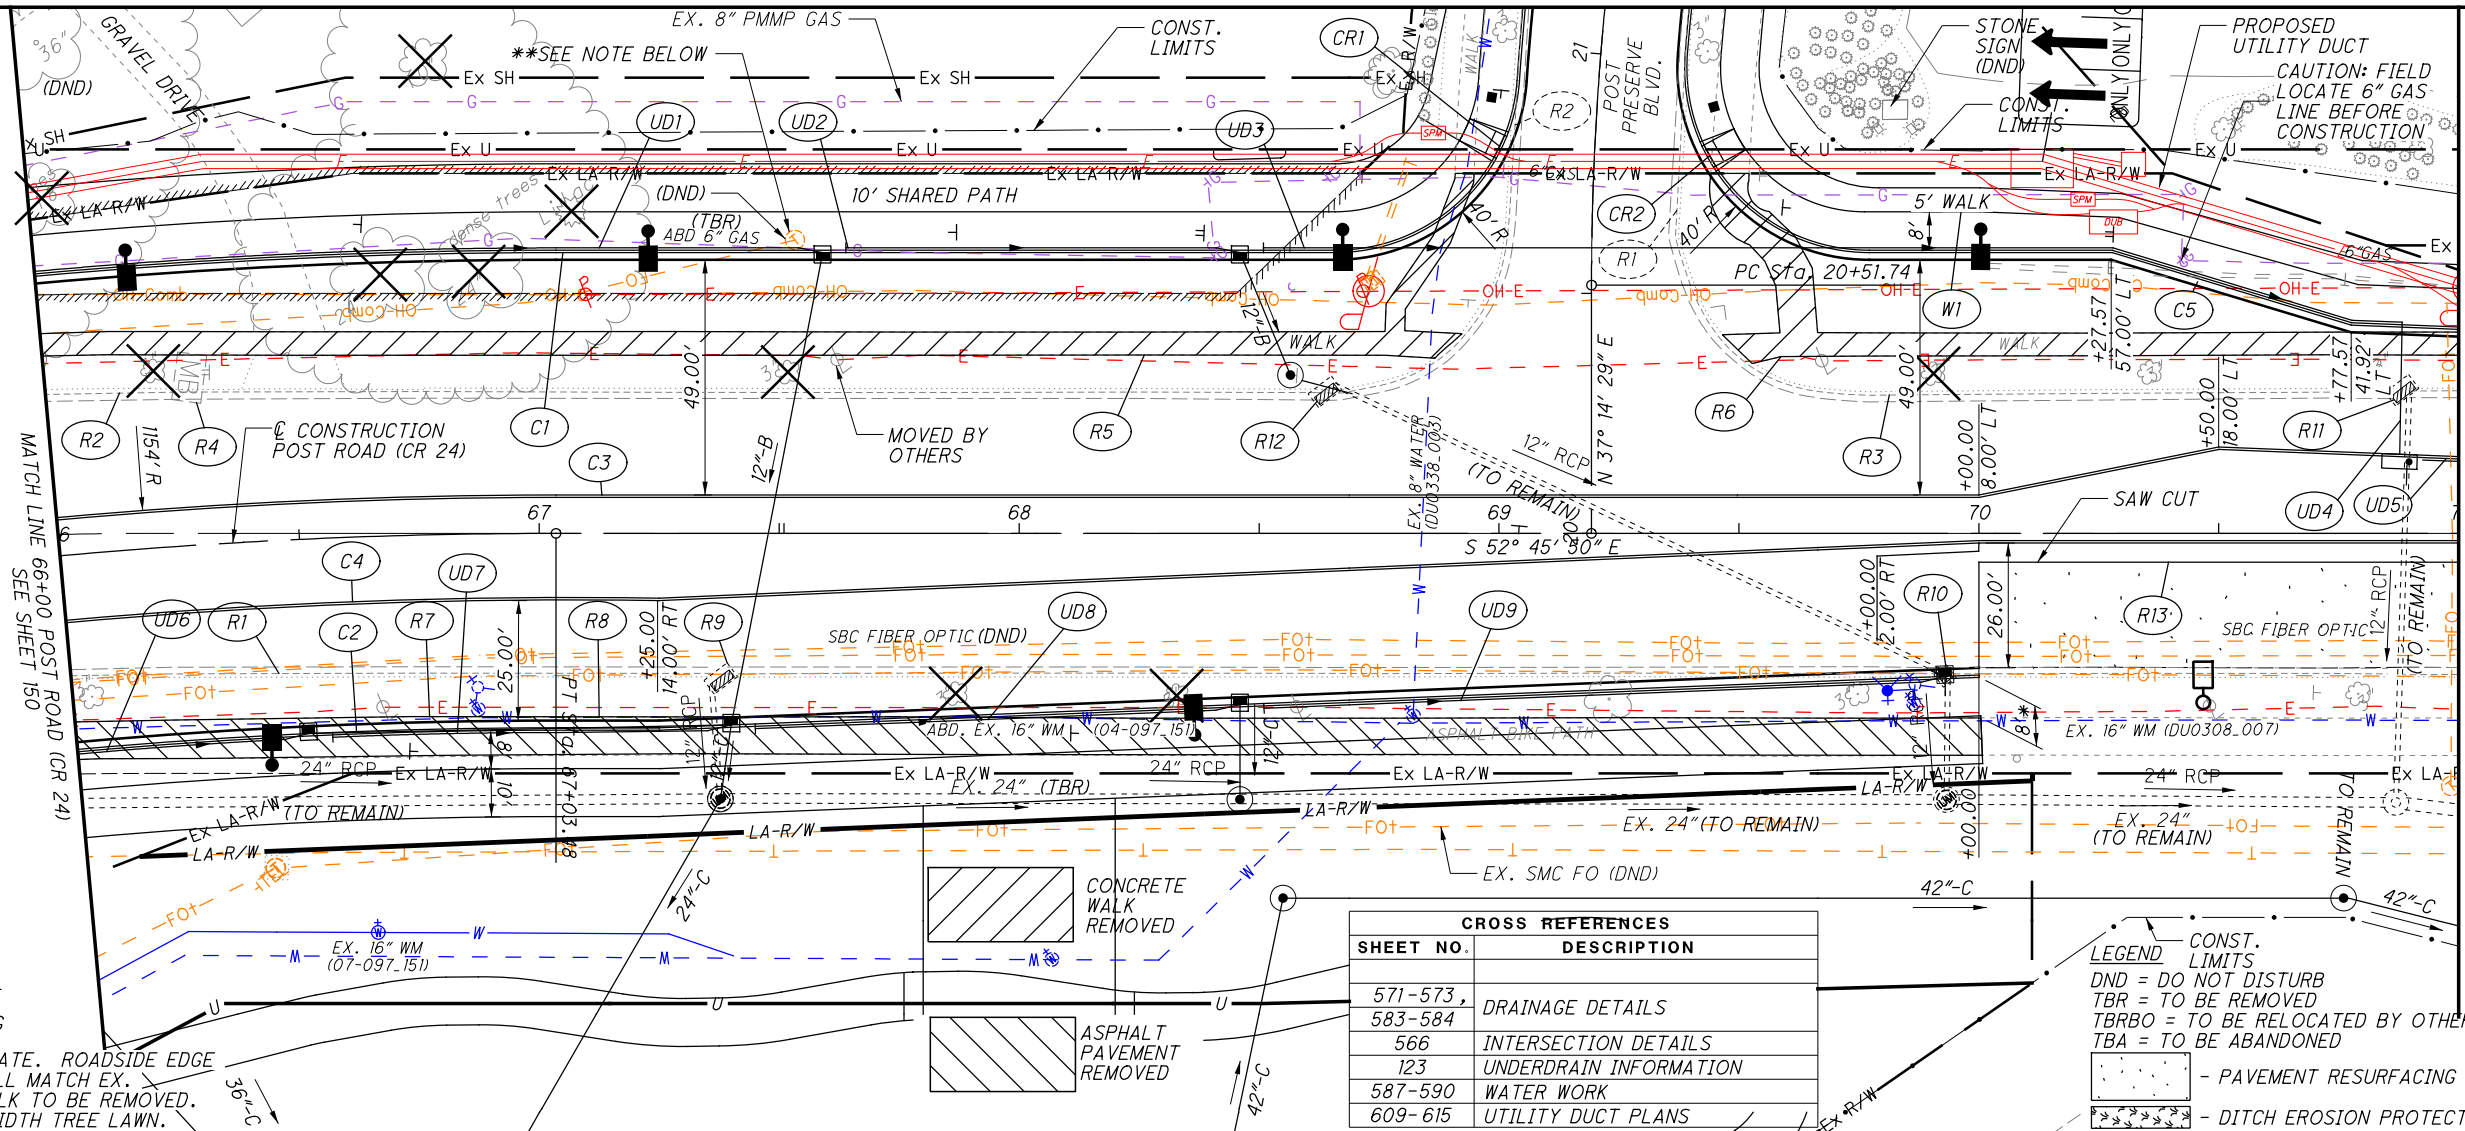

**CURVE DATA**

P.I. Sta. 64+26.76  
 $\Delta = 28^\circ 15' 32''$  (RT)  
 $D_c = 5^\circ 00' 00''$   
 $R = 1,145.92'$   
 $T = 288.46'$   
 $L = 565.18'$   
 $E = 35.75'$   
 $C = 559.47'$   
 $C.B. = S 66^\circ 53' 36'' E$   
 $S.E. = MATCH EXISTING$


\*OFFSET IS APPROXIMATE. ROADSIDE EDGE OF WALKING PATH SHALL MATCH EX. ROADSIDE EDGE OF WALK TO BE REMOVED. MAINTAIN CONSTANT WIDTH TREE LAWN.

CROSS REFERENCES	
SHEET NO.	DESCRIPTION
571-573, 583-584	DRAINAGE DETAILS
566	INTERSECTION DETAILS
123	UNDERDRAIN INFORMATION
587-590	WATER WORK
609-615	UTILITY DUCT PLANS

**LEGEND**

CONST. LIMITS  
 DND = DO NOT DISTURB  
 TBR = TO BE REMOVED  
 TBRBO = TO BE RELOCATED BY OTHERS  
 TBA = TO BE ABANDONED


- PAVEMENT RESURFACING LIMITS  
 - DITCH EROSION PROTECTION

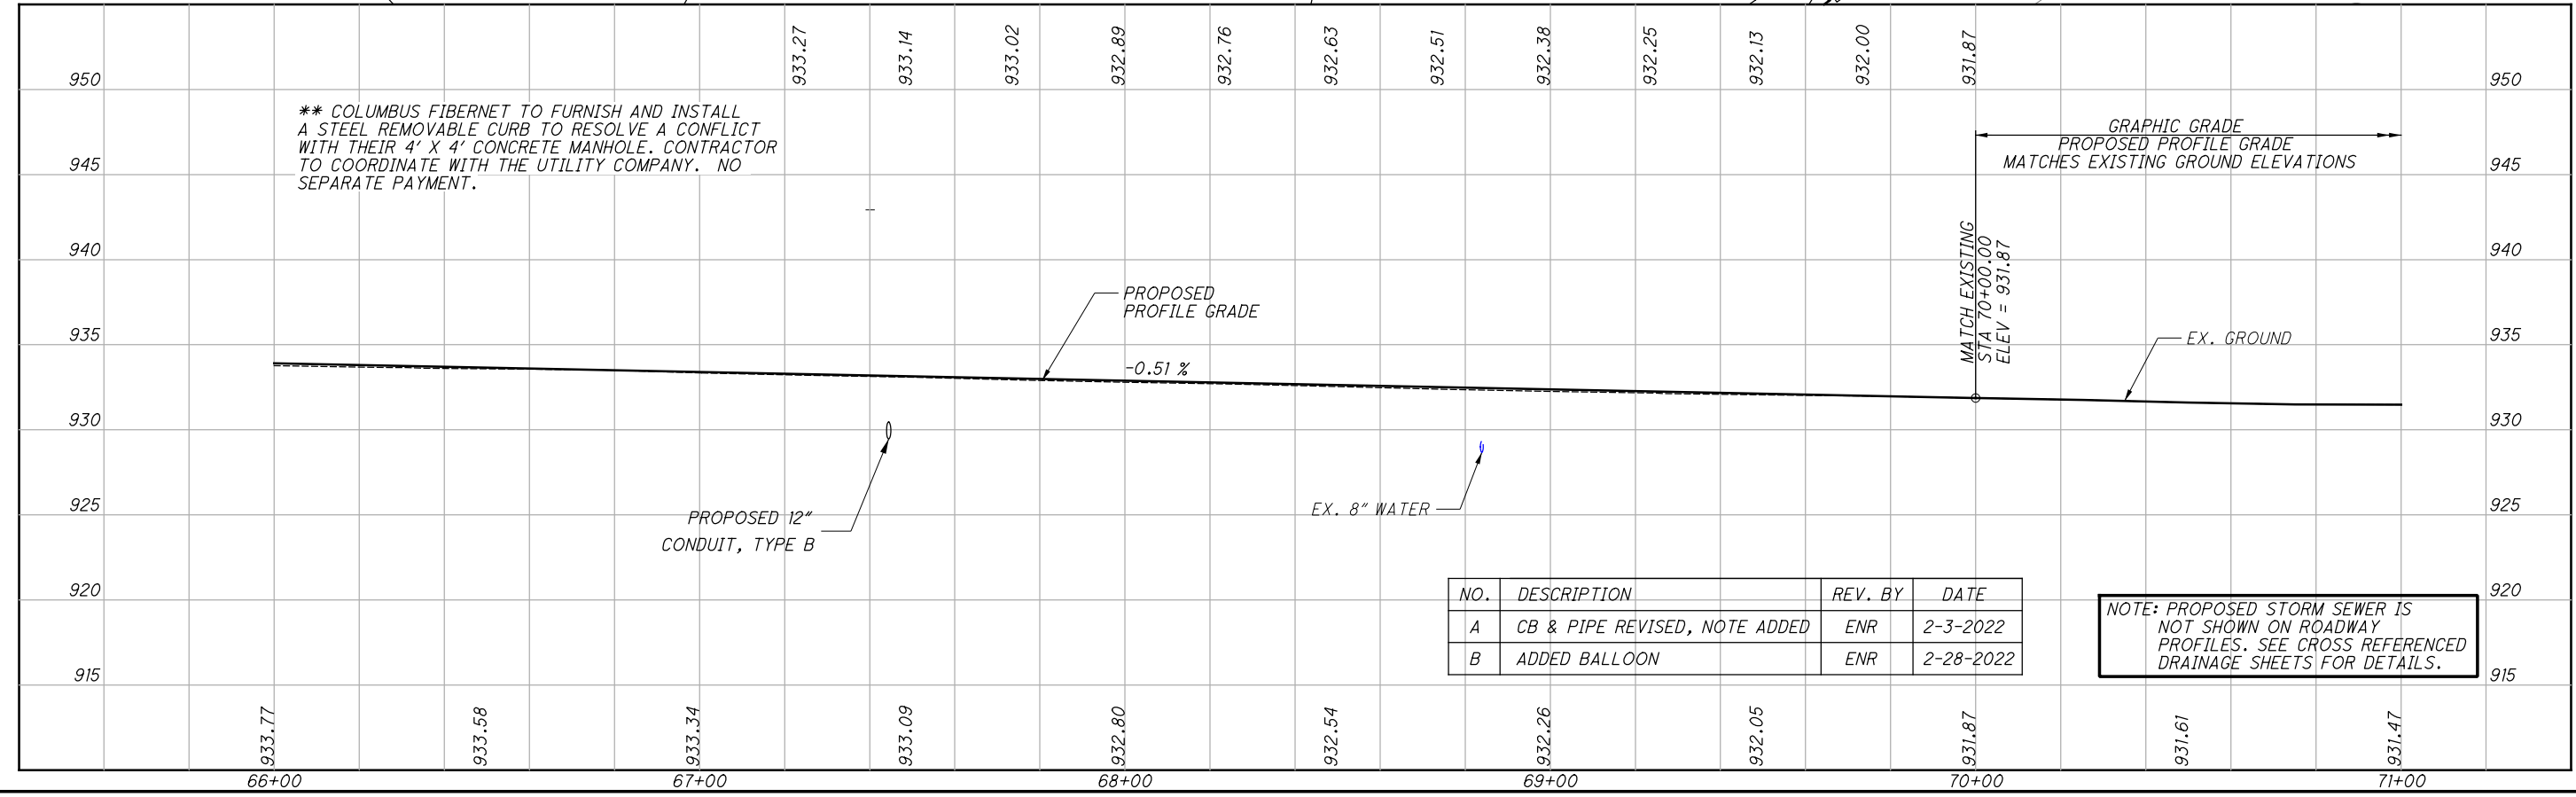

NO.	DESCRIPTION	REV. BY	DATE
A	CB & PIPE REVISED, NOTE ADDED	ENR	2-3-2022
B	ADDED BALLOON	ENR	2-28-2022

NOTE: PROPOSED STORM SEWER IS NOT SHOWN ON ROADWAY PROFILES. SEE CROSS REFERENCED DRAINAGE SHEETS FOR DETAILS.



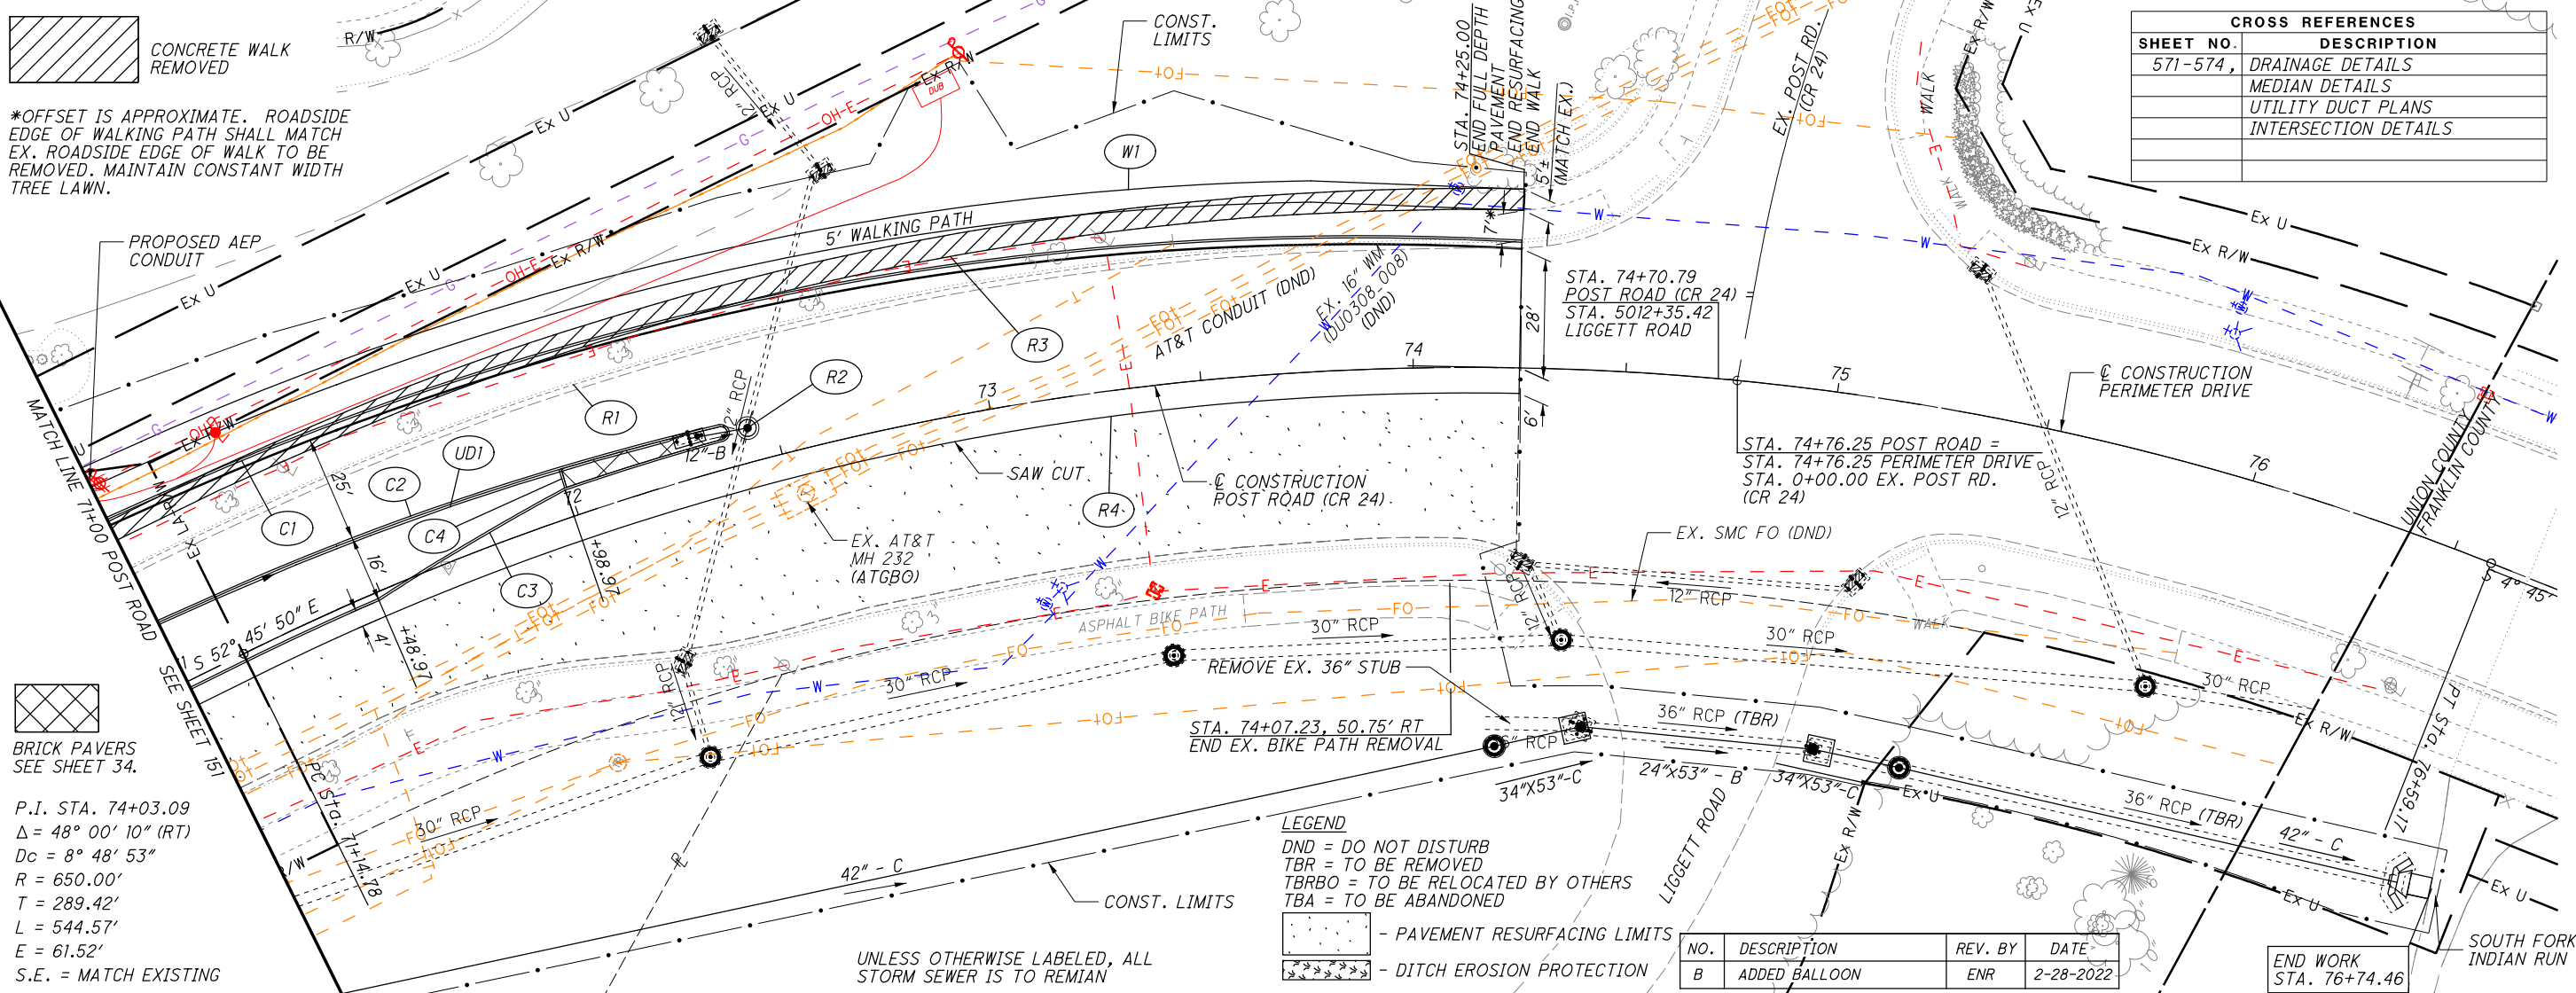

\*OFFSET IS APPROXIMATE. ROADSIDE EDGE OF WALKING PATH SHALL MATCH EX. ROADSIDE EDGE OF WALK TO BE REMOVED. MAINTAIN CONSTANT WIDTH TREE LAWN.

BRICK PAVERS  
SEE SHEET 34.

P.I. STA. 74+03.09  
 $\Delta = 48^\circ 00' 10''$  (RT)  
 $D_c = 8^\circ 48' 53''$   
 $R = 650.00'$   
 $T = 289.42'$   
 $L = 544.57'$   
 $E = 61.52'$   
 S.E. = MATCH EXISTING

LEGEND  
 DND = DO NOT DISTURB  
 TBR = TO BE REMOVED  
 TBRBO = TO BE RELOCATED BY OTHERS  
 TBA = TO BE ABANDONED

UNLESS OTHERWISE LABELED, ALL STORM SEWER IS TO REMIAN

NO.	DESCRIPTION	REV. BY	DATE
B	ADDED BALLOON	ENR	2-28-2022


CROSS REFERENCES	
SHEET NO.	DESCRIPTION
571-574,	DRAINAGE DETAILS
	MEDIAN DETAILS
	UTILITY DUCT PLANS
	INTERSECTION DETAILS



PLAN - POST ROAD (CR 24) / PERIMETER DRIVE  
 STA 71+00.00 TO END WORK


UNI-33-24.87

152  
 923

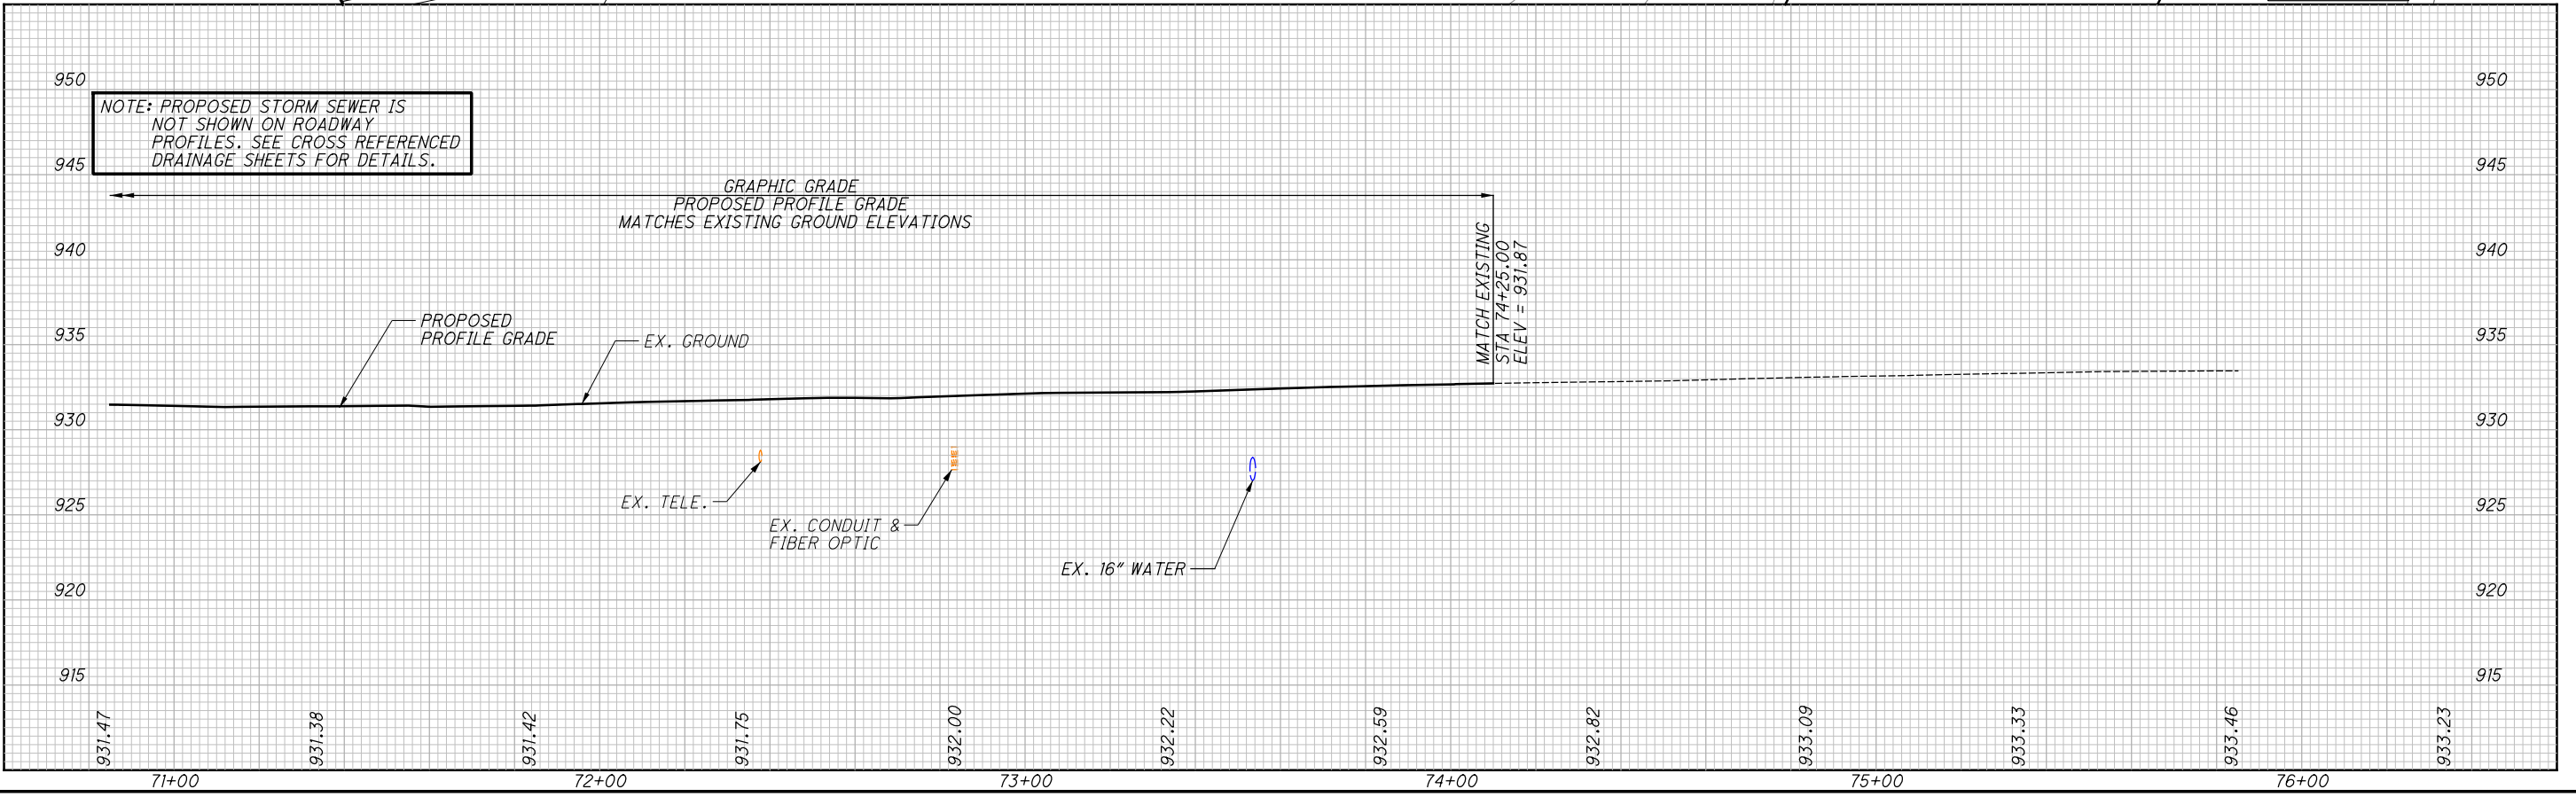

P:\PR41806AA\FRA\80748\ROADWAY\SHEETS\80748GF113.DGN

P:\PR41806AA\FRA\80748\ROADWAY\SHEETS\80748GP901.DGN

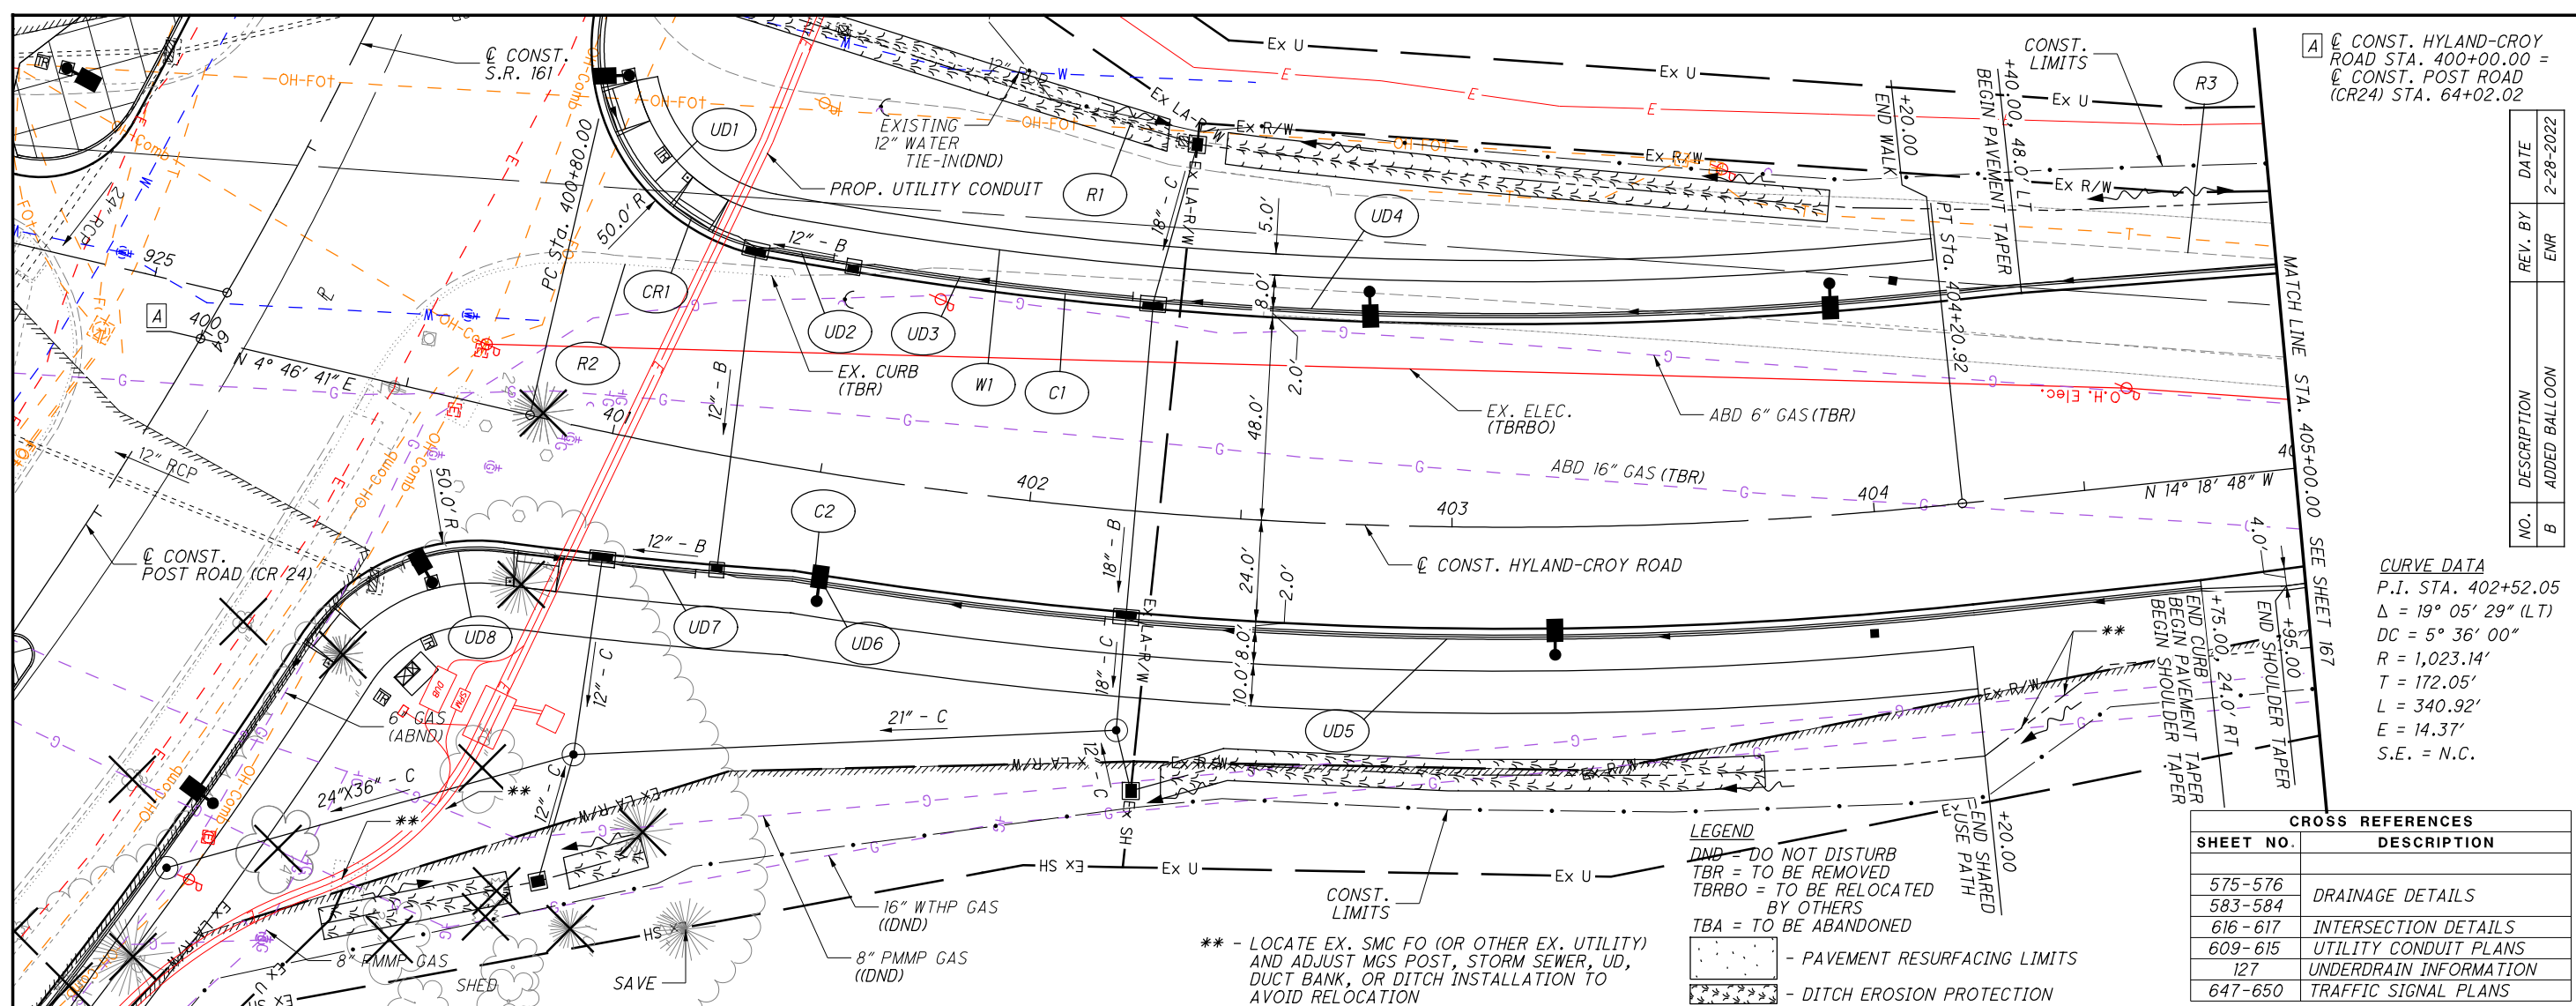


CONST. HYLAND-CROY ROAD STA. 400+00.00 =  
 CONST. POST ROAD (CR24) STA. 64+02.02

**CURVE DATA**  
 P.I. STA. 402+52.05  
 $\Delta = 19^\circ 05' 29''$  (LT)  
 $DC = 5^\circ 36' 00''$   
 $R = 1,023.14'$   
 $T = 172.05'$   
 $L = 340.92'$   
 $E = 14.37'$   
 $S.E. = N.C.$

**LEGEND**  
 DND = DO NOT DISTURB  
 TBR = TO BE REMOVED  
 TBRBO = TO BE RELOCATED BY OTHERS  
 TBA = TO BE ABANDONED  
 [Symbol] - PAVEMENT RESURFACING LIMITS  
 [Symbol] - DITCH EROSION PROTECTION


CROSS REFERENCES	
SHEET NO.	DESCRIPTION
575-576	
583-584	DRAINAGE DETAILS
616-617	INTERSECTION DETAILS
609-615	UTILITY CONDUIT PLANS
127	UNDERDRAIN INFORMATION
647-650	TRAFFIC SIGNAL PLANS

NO.	DESCRIPTION	REV. BY	DATE
B	ADDED BALLOON	ENR	2-28-2022

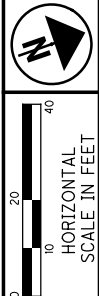


**PLAN AND PROFILE - HYLAND-CROY ROAD**  
 STA. 400+00.00 TO STA. 405+00.00

UNI-33-24.87

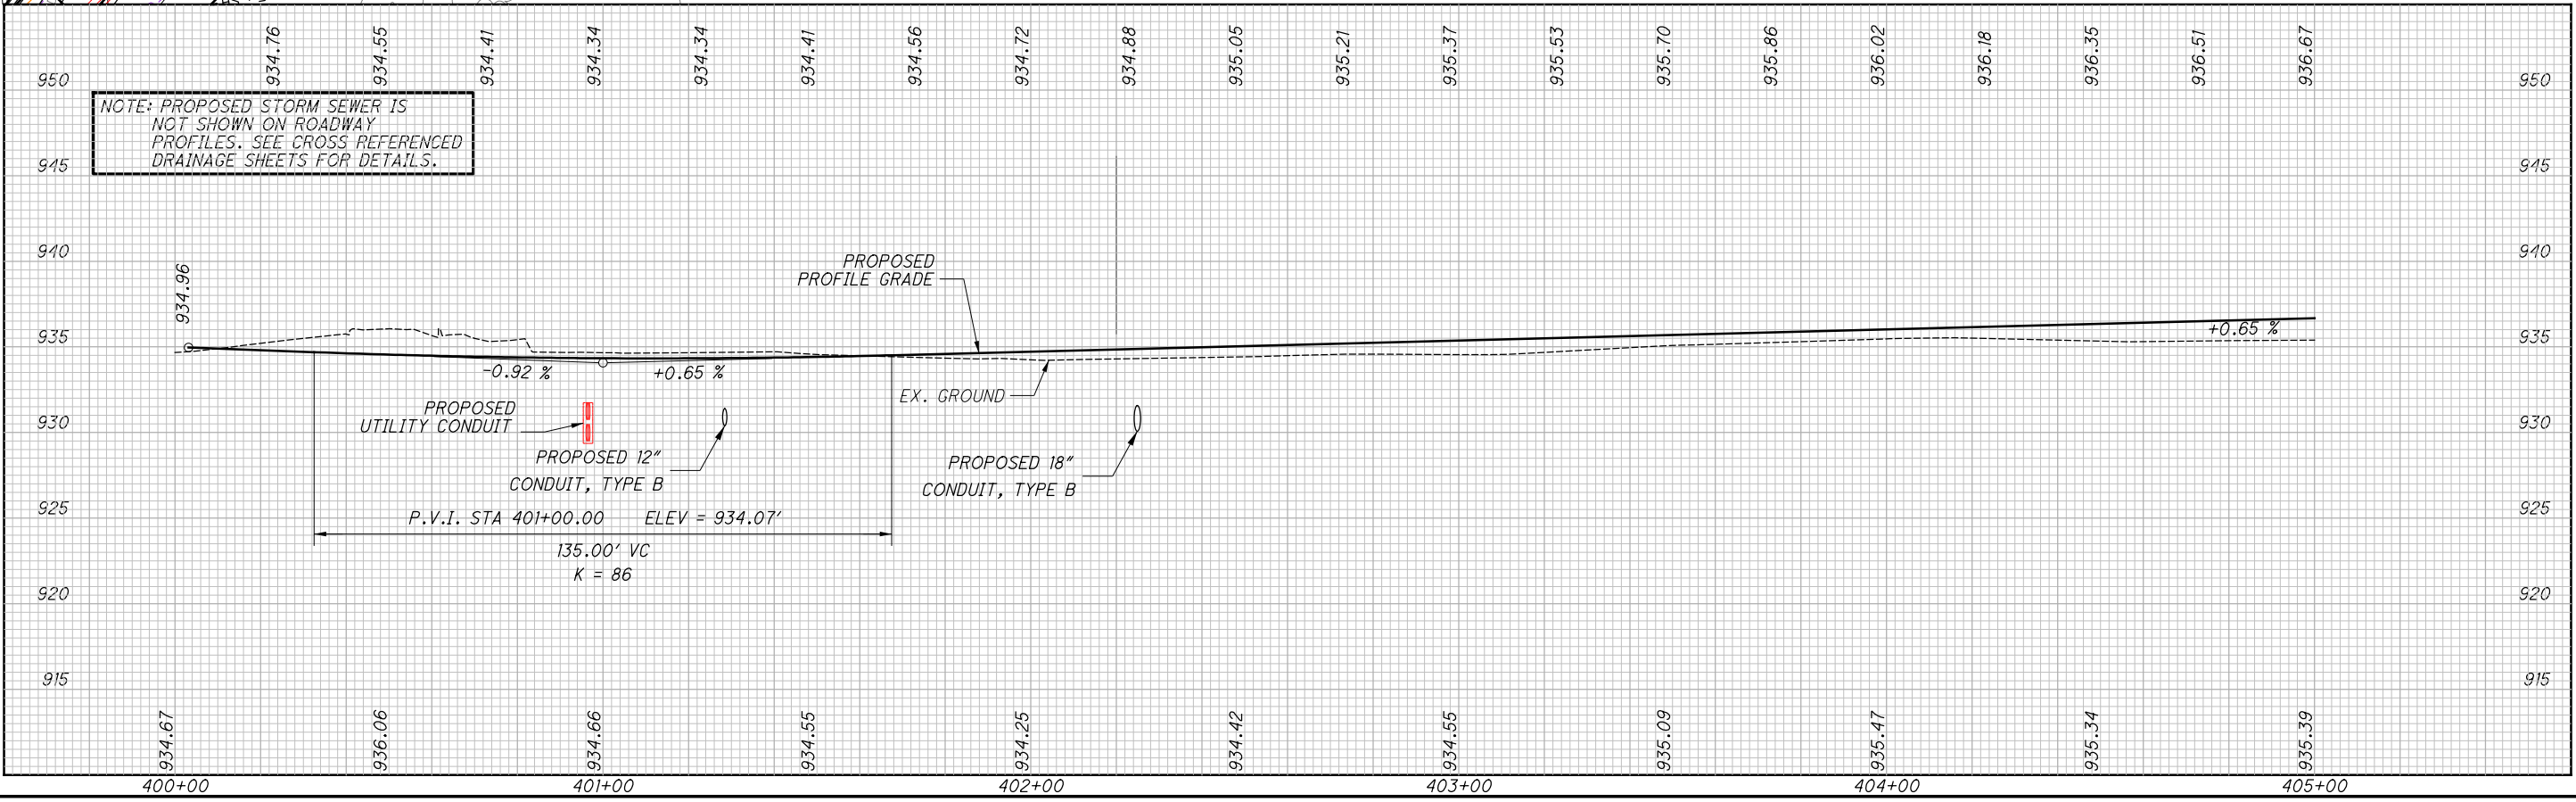


NOTE: PROPOSED STORM SEWER IS NOT SHOWN ON ROADWAY PROFILES. SEE CROSS REFERENCED DRAINAGE SHEETS FOR DETAILS.

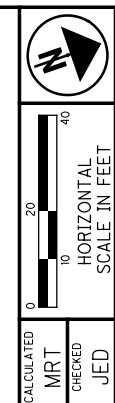

**PLAN AND PROFILE - HYLAND-CROY ROAD  
STA. 405+00.00 TO 410+00.00**

**UNI-33-24.87**

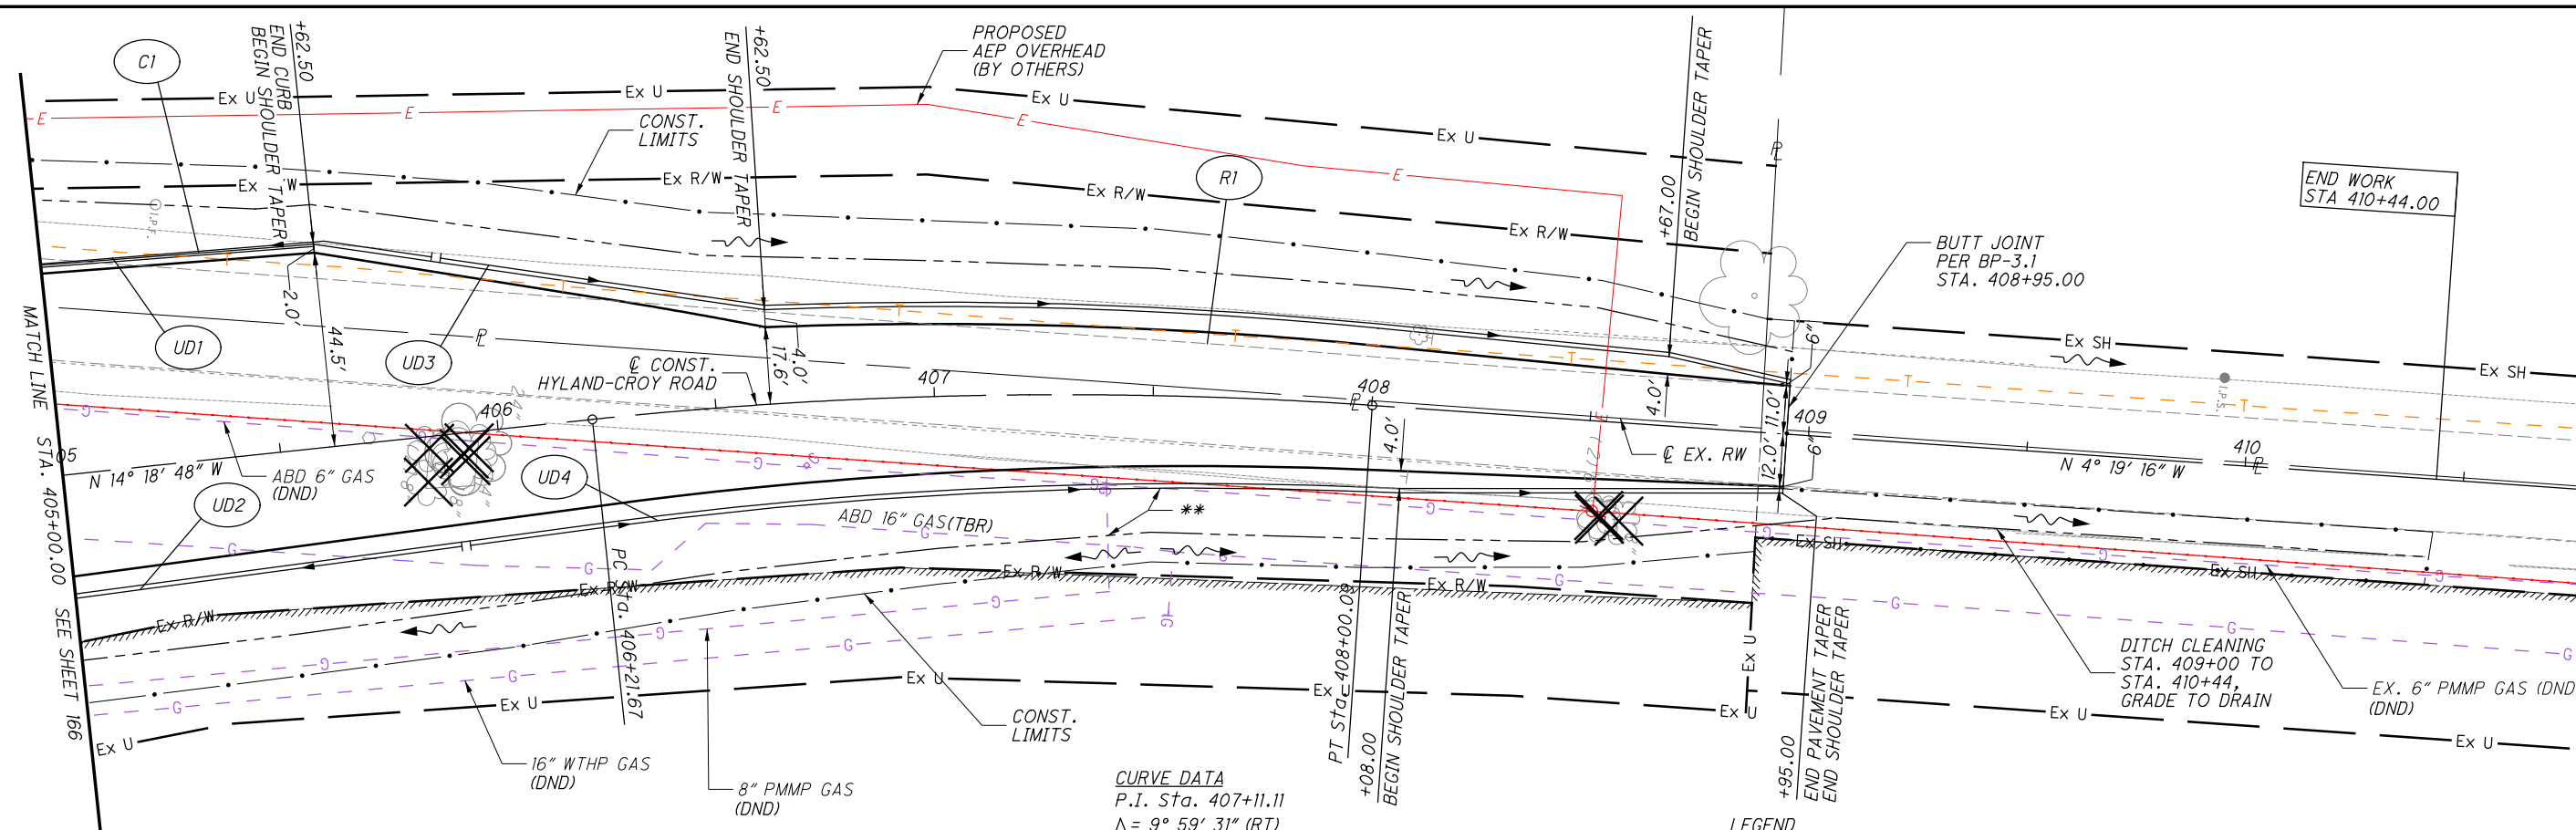


\*\* - LOCATE EX. SMC FO (OR OTHER EX. UTILITY) AND ADJUST MGS POST, STORM SEWER, UD, DUCT BANK, OR DITCH INSTALLATION TO AVOID RELOCATION

**CURVE DATA**  
 P.I. Sta. 407+11.11  
 $\Delta = 9^\circ 59' 31''$  (RT)  
 $D_c = 5^\circ 36' 00''$   
 $R = 1,023.14'$   
 $T = 89.44'$   
 $L = 178.43'$   
 $E = 3.90'$   
 S.E. = N.C.

**LEGEND**  
 DND = DO NOT DISTURB  
 TBR = TO BE REMOVED  
 TBRBO = TO BE RELOCATED BY OTHERS  
 TBA = TO BE ABANDONED  
 [Symbol] - PAVEMENT RESURFACING LIMITS  
 [Symbol] - DITCH EROSION PROTECTION

CROSS REFERENCES	
SHEET NO.	DESCRIPTION
583	DRAINAGE DETAILS
127	UNDERDRAIN INFORMATION


NO.	DESCRIPTION	REV. BY	DATE
B	ADDED BALLOON	ENR	2-28-2022

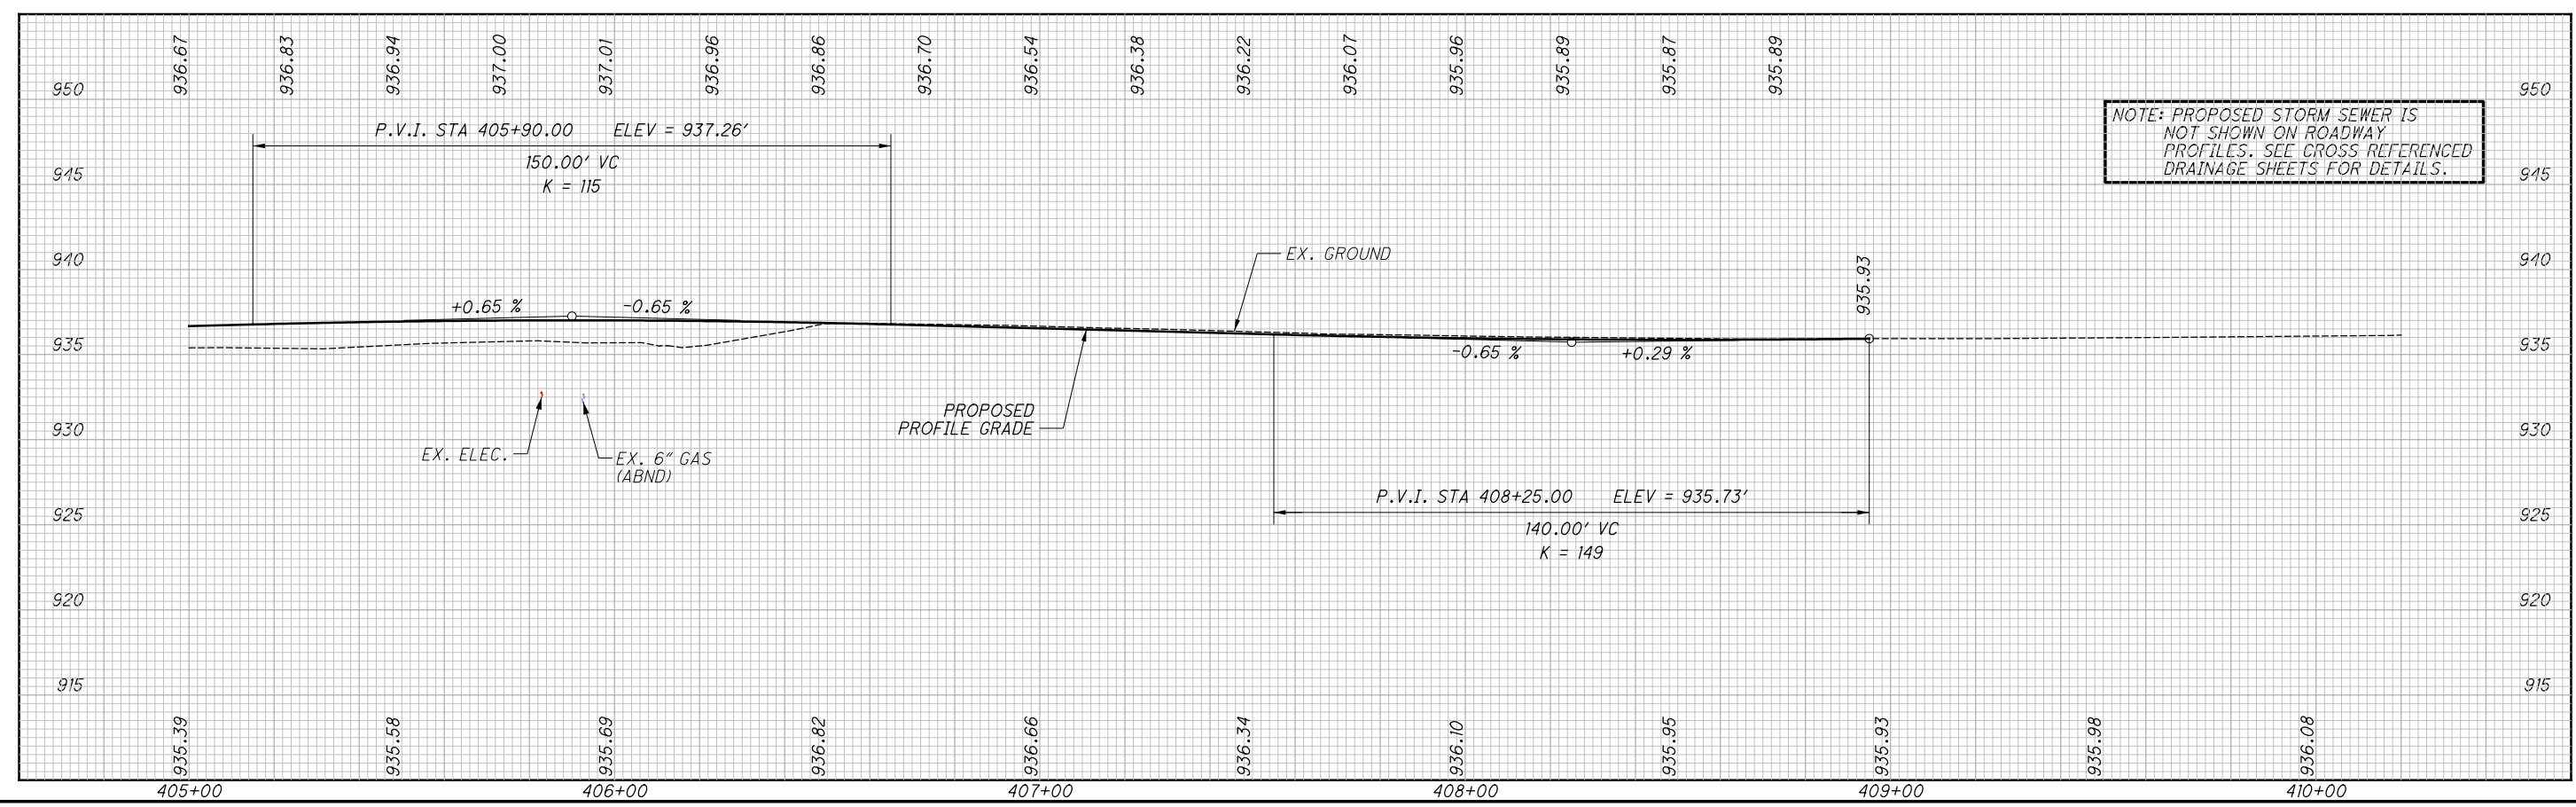

NOTE: PROPOSED STORM SEWER IS NOT SHOWN ON ROADWAY PROFILES. SEE CROSS REFERENCED DRAINAGE SHEETS FOR DETAILS.

P:\PR55741\FRA\80748\ROADWAY\SHEETS\80748GP1001.DGN


NO.	DESCRIPTION	REV. BY	DATE
B	ADDED BALLOON	ENR	2-28-2022

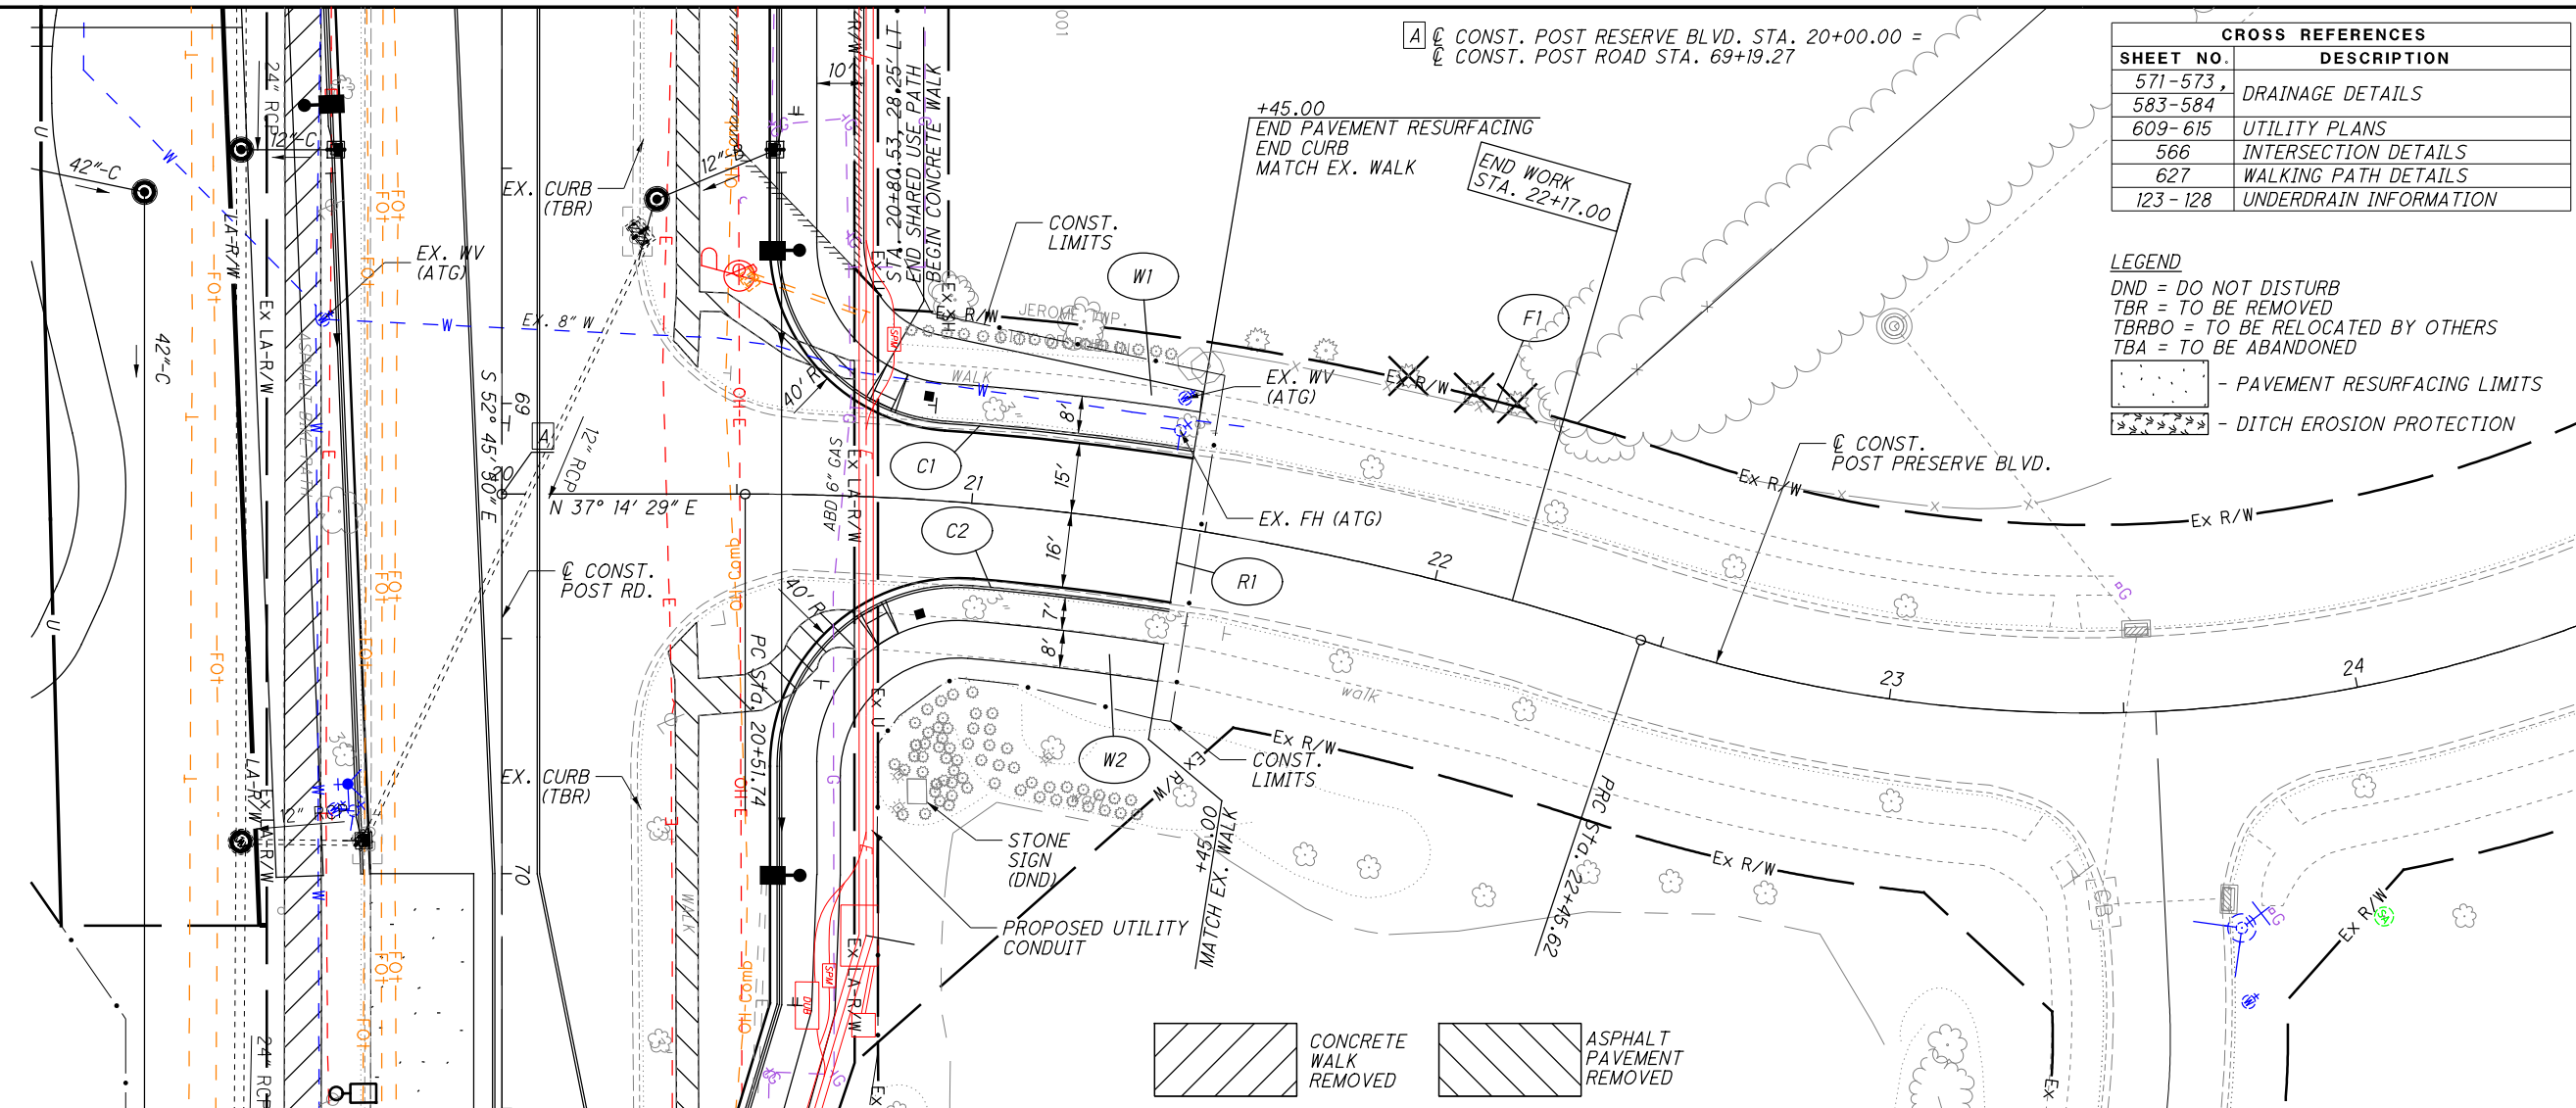

CROSS REFERENCES	
SHEET NO.	DESCRIPTION
571-573, 583-584	DRAINAGE DETAILS
609-615	UTILITY PLANS
566	INTERSECTION DETAILS
627	WALKING PATH DETAILS
123-128	UNDERDRAIN INFORMATION

**LEGEND**  
 DND = DO NOT DISTURB  
 TBR = TO BE REMOVED  
 TBRBO = TO BE RELOCATED BY OTHERS  
 TBA = TO BE ABANDONED

- PAVEMENT RESURFACING LIMITS  
 - DITCH EROSION PROTECTION

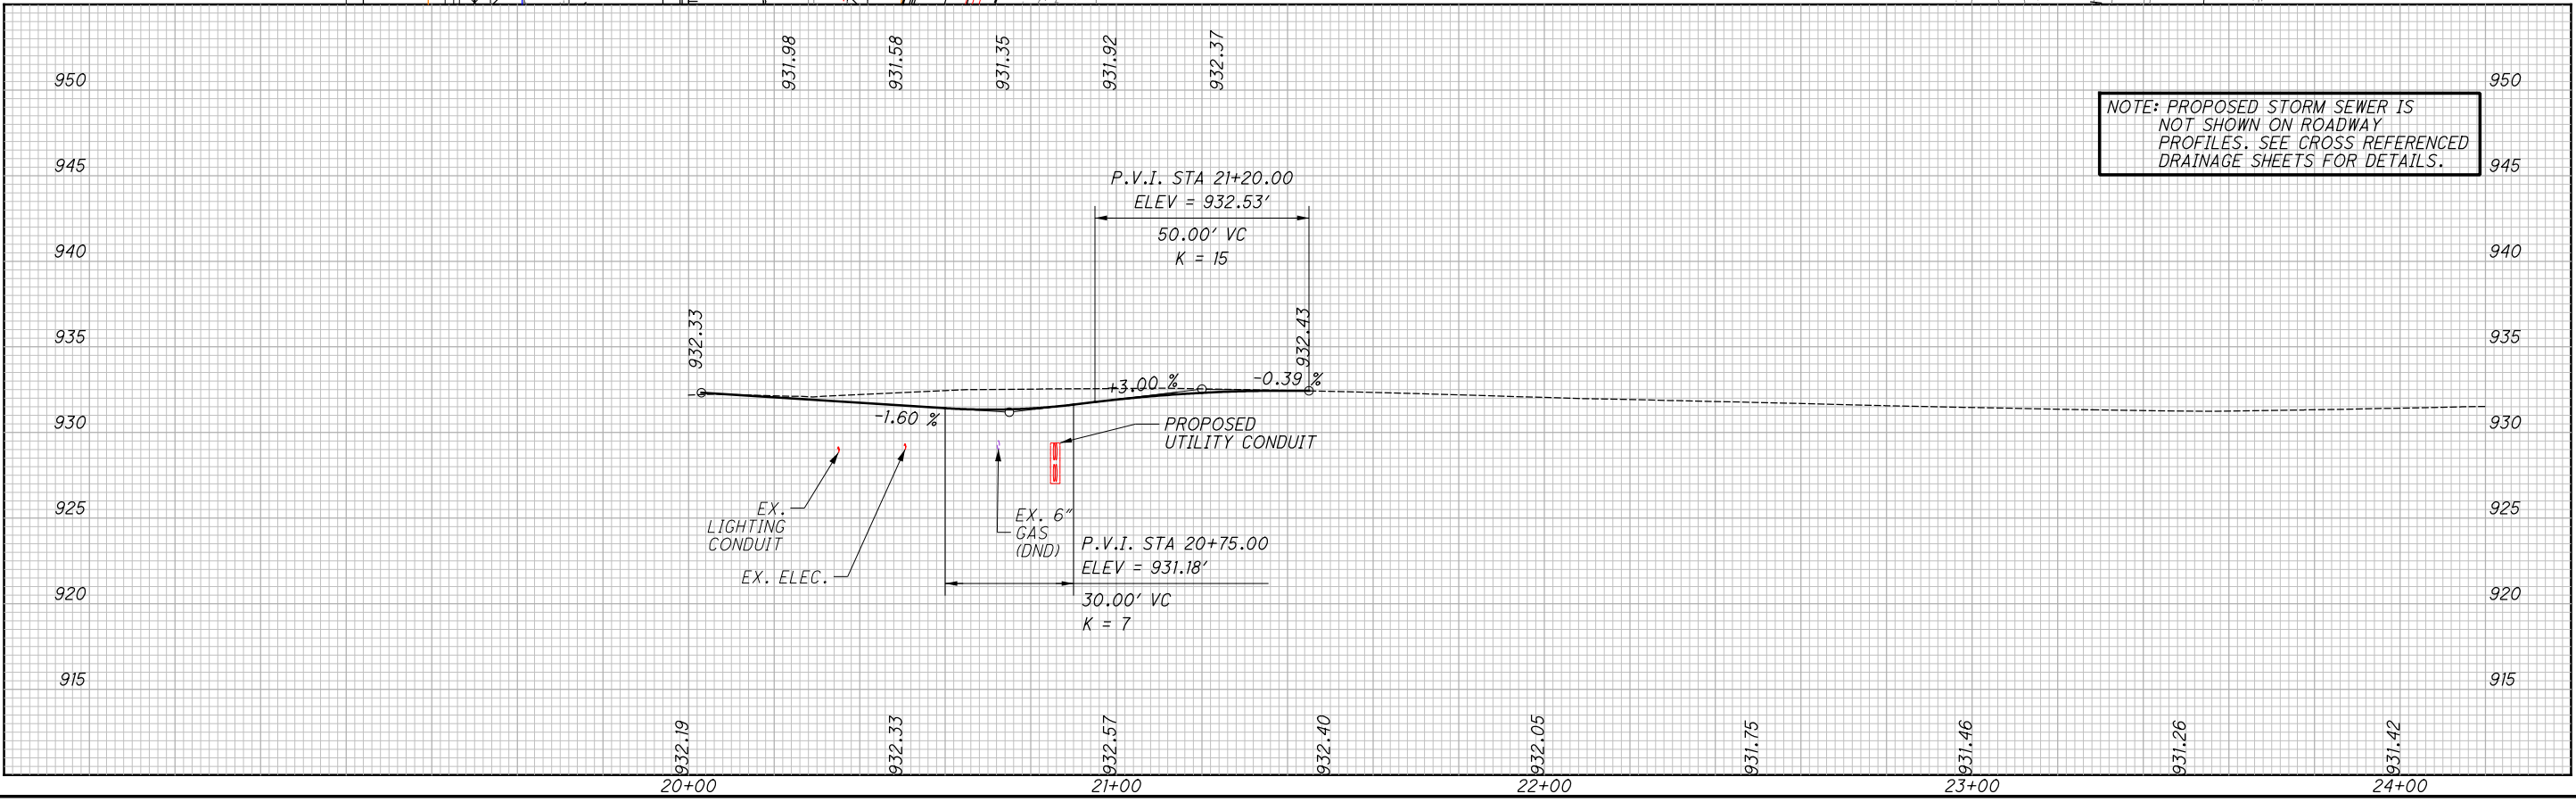


NOTE: PROPOSED STORM SEWER IS NOT SHOWN ON ROADWAY PROFILES. SEE CROSS REFERENCED DRAINAGE SHEETS FOR DETAILS.

PLAN AND PROFILE - POST PRESERVE BLVD.  
 STA. 20+00.00 TO END WORK

UNI-33-24.87

**QUICK COUPLER LOCATIONS:**

- 1 - N 769764.60, E 1777617.21
- 2 - N 769470.17, E 1777778.45
- 3 - N 769325.93, E 1778240.92
- 4 - N 769298.85, E 1778452.39
- 5 - N 769101.95, E 1778325.14
- 6 - N 769075.20, E 1778539.38
- 7 - N 768964.62, E 1778970.35
- 8 - N 768683.76, E 1779131.67

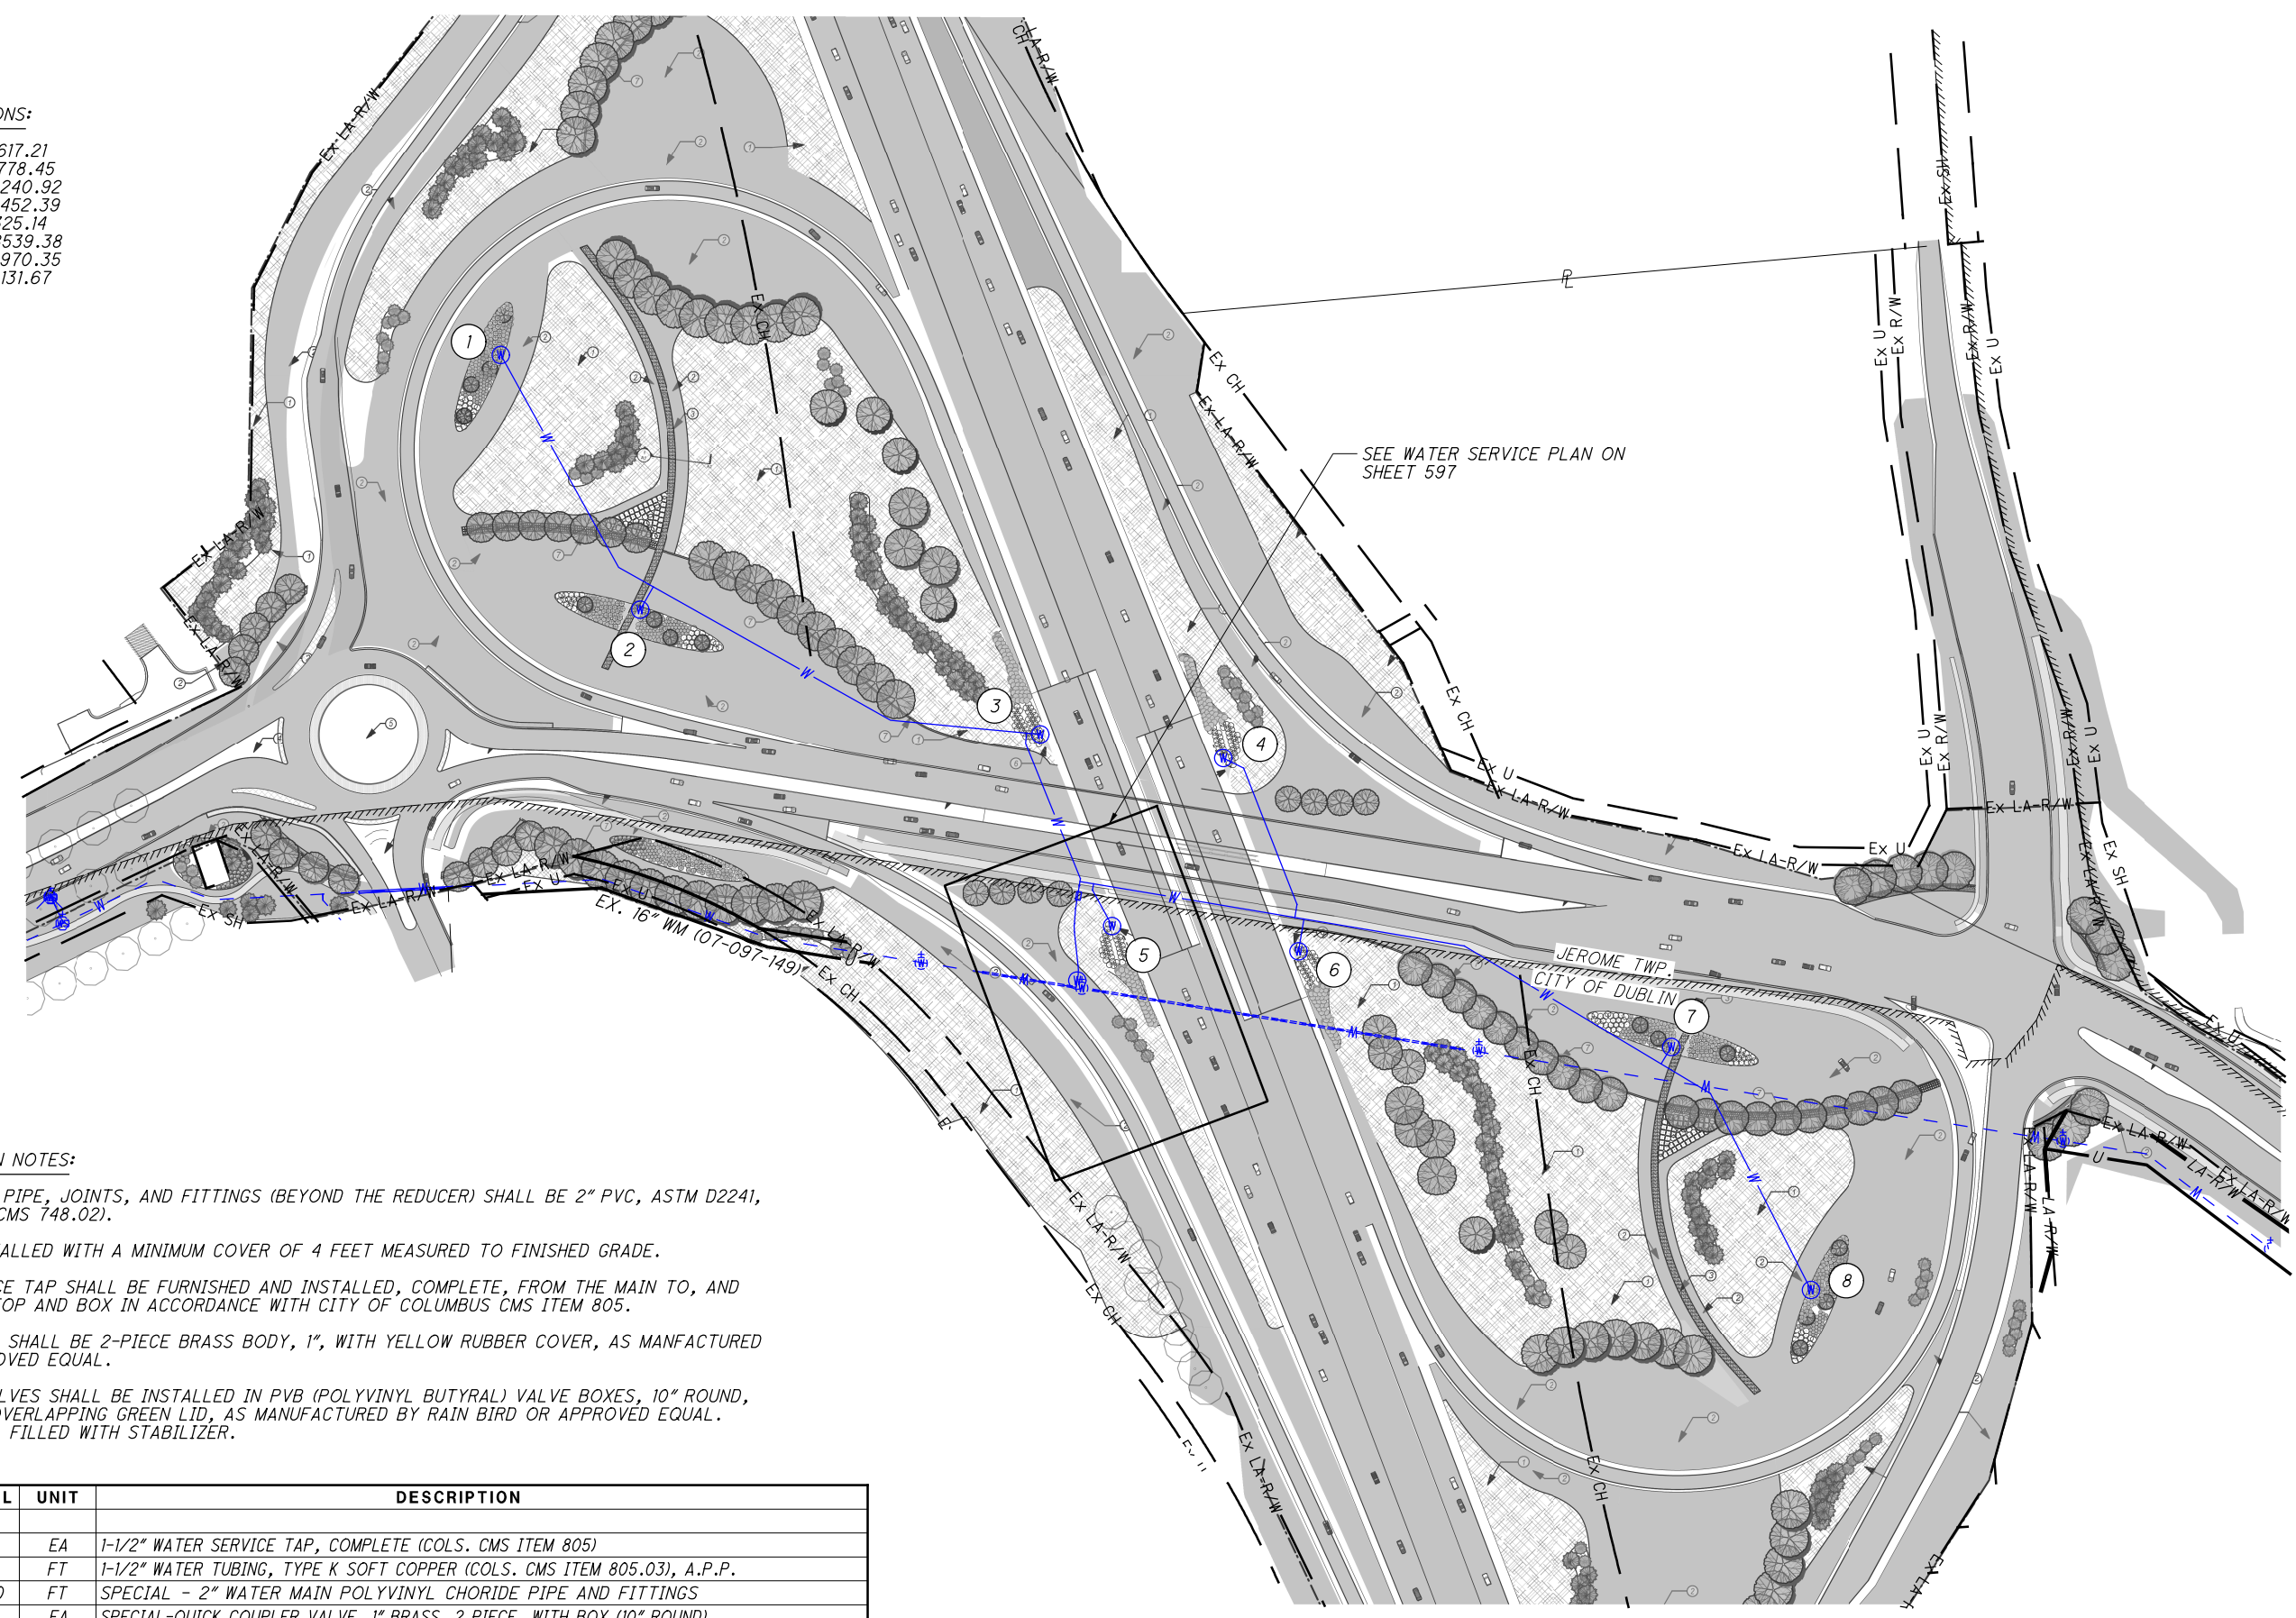

**IRRIGATION AS PER PLAN NOTES:**

- ALL IRRIGATION SYSTEM PIPE, JOINTS, AND FITTINGS (BEYOND THE REDUCER) SHALL BE 2" PVC, ASTM D2241, SDR 21, 200 PSI (ODOT CMS 748.02).
- ALL PIPE SHALL BE INSTALLED WITH A MINIMUM COVER OF 4 FEET MEASURED TO FINISHED GRADE.
- THE 1-1/2" WATER SERVICE TAP SHALL BE FURNISHED AND INSTALLED, COMPLETE, FROM THE MAIN TO, AND INCLUDING, THE CURB STOP AND BOX IN ACCORDANCE WITH CITY OF COLUMBUS CMS ITEM 805.
- QUICK COUPLING VALVES SHALL BE 2-PIECE BRASS BODY, 1", WITH YELLOW RUBBER COVER, AS MANUFACTURED BY RAIN BIRD, OR APPROVED EQUAL.
- ALL QUICK COUPLING VALVES SHALL BE INSTALLED IN PVB (POLYVINYL BUTYRAL) VALVE BOXES, 10" ROUND, WITH BLACK BODY AND OVERLAPPING GREEN LID, AS MANUFACTURED BY RAIN BIRD OR APPROVED EQUAL. BOXES SHALL BE GRAVEL FILLED WITH STABILIZER.

ITEM	EXT.	TOTAL	UNIT	DESCRIPTION
638	98000	1	EA	1-1/2" WATER SERVICE TAP, COMPLETE (COLS. CMS ITEM 805)
638	20774	114	FT	1-1/2" WATER TUBING, TYPE K SOFT COPPER (COLS. CMS ITEM 805.03), A.P.P.
638	20414	2,350	FT	SPECIAL - 2" WATER MAIN POLYVINYL CHORIDE PIPE AND FITTINGS
638	98000	8	EA	SPECIAL-QUICK COUPLER VALVE, 1" BRASS, 2 PIECE, WITH BOX (10" ROUND)
638	98100	1	LUMP	SPECIAL-1 1/2" METER SETTING WITH BACK FLOW PREVENTER IN HEATED ENCLOSURE

NO.	DESCRIPTION	REV. BY	DATE
B	ITEM UPDATES	ENR	2-28-2022

P:\PR5574\FRA\80748\Design\Utilities\Sheets\80748UP20.dgn Sheet 2/28/2022 7:44:05 PM Riley

