


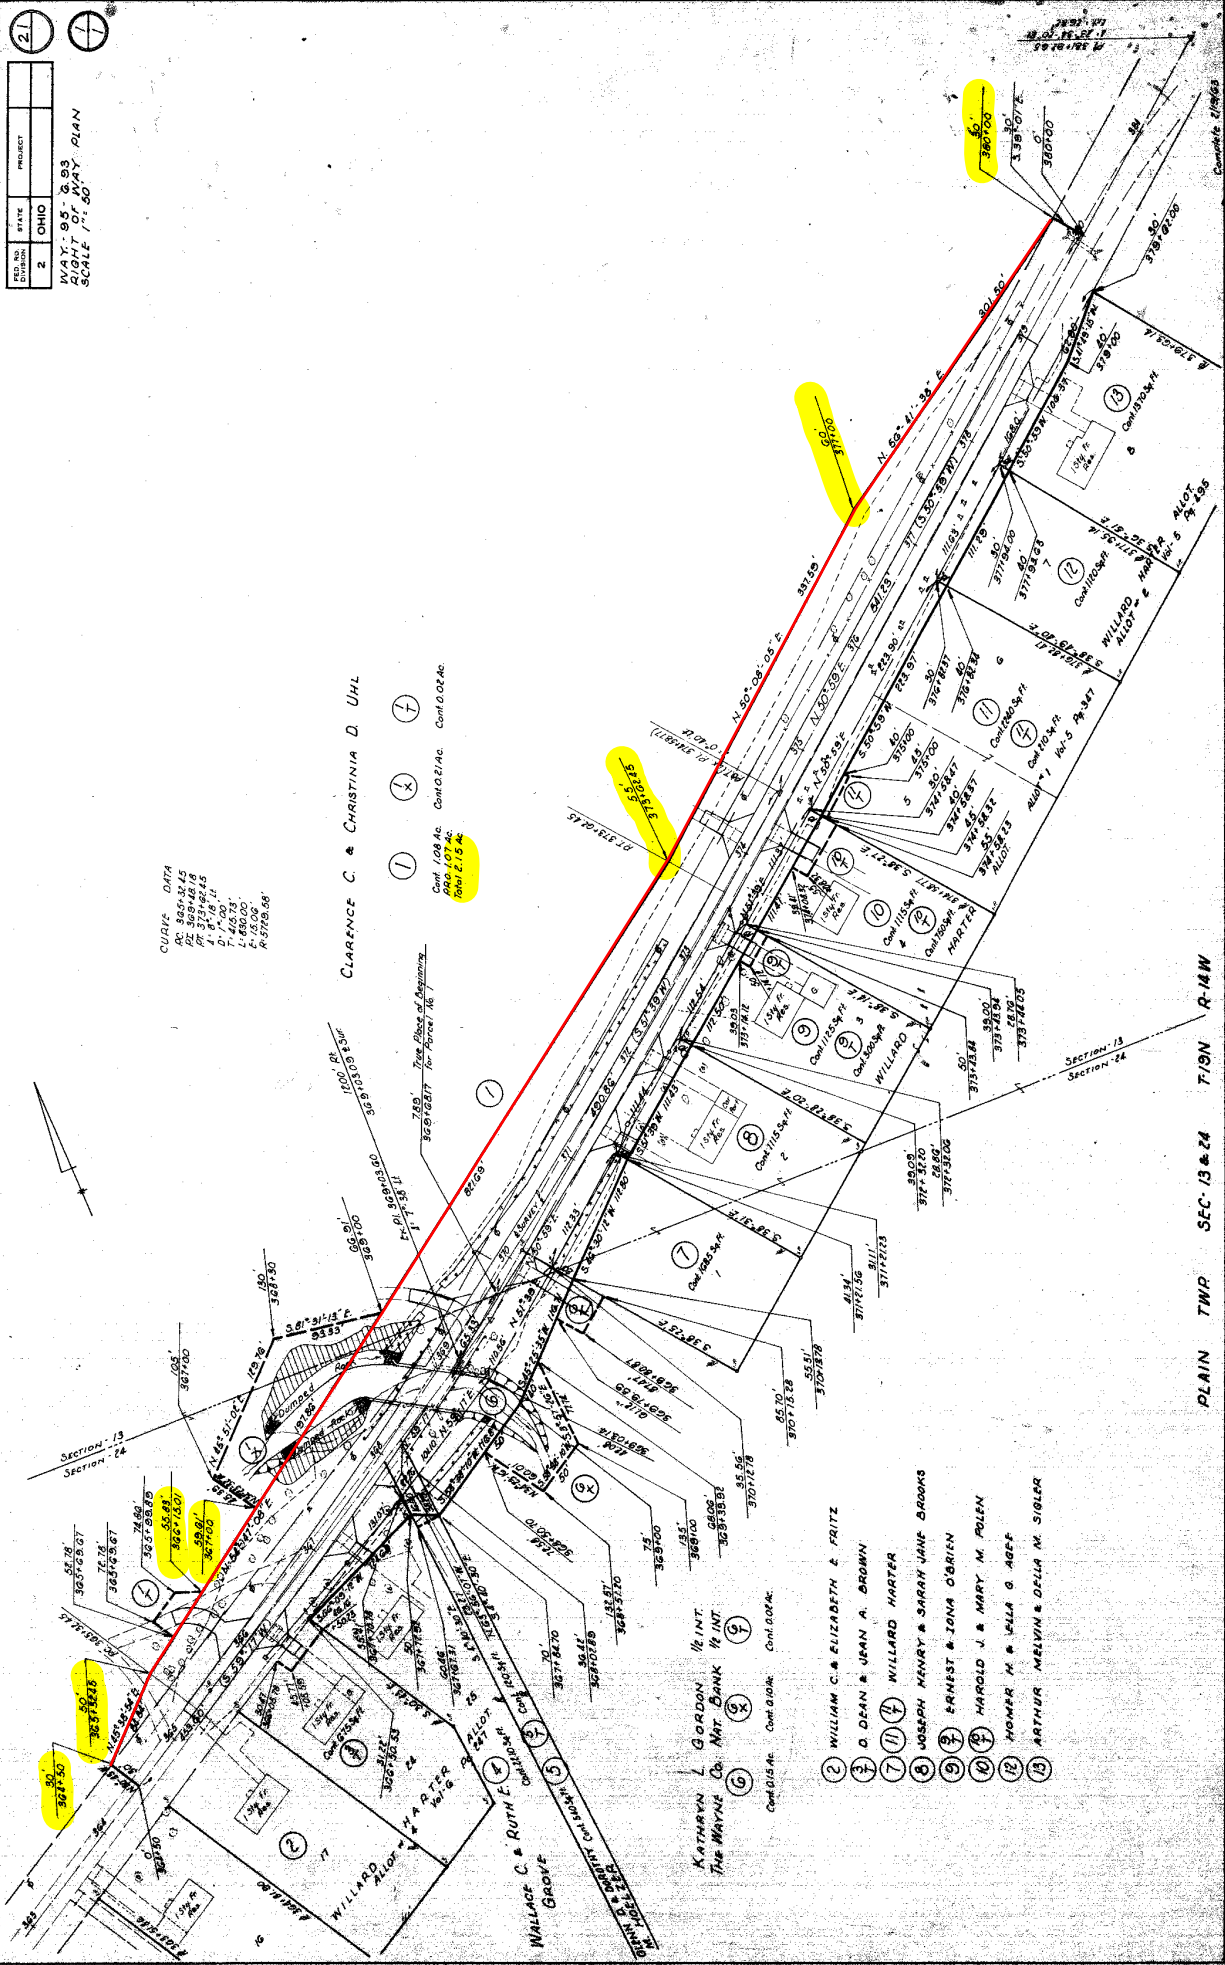

CURVE DATA

CLARENCE C & CHRISTINA D. UHL


KATHRYN L. GORDON, 1/2 INT.
 The Wayne Co. Mkt. Bank 1/2 INT.

- 2 WILLIAM C. & ELIZABETH E. FRITZ
- 3 O. DEAN & JEAN A. BROWN
- 4 WILLARD HARTER
- 5 JOSEPH MENARY & SARAH JANE BROOKS
- 6 ERNEST & IONA O'BRIEN
- 7 HAROLD J. & MARY M. POLEN
- 8 HOMER H. & LELLA G. ABFF
- 9 ARTHUR MELVIN & DELLA M. SIELER

PLAIN TWP SEC. 13 & 24 T. 19N R. 14W