



CUY-90-14.90

PID 77332/85531

APPENDIX UT-16

**Potential Utility Conflicts – CCG2
(Reference Document)**

State of Ohio
Department of Transportation
Jolene M. Molitoris, Director


**Innerbelt Bridge
Construction Contract Group 1 (CCG1)**

PUBLIC UTILITY CONFLICTS - CONTRACT GROUP 2


* CONFLICTS WITH BRIDGE PIERS WILL BE DETERMINED DURING BRIDGE DESIGN

CONFLICTS WITH U.G. ELECTRIC FOR ROADWAY LIGHTING IS NOT SHOWN


CONFLICT I.D.	ALIGNMENT	ROADWAY	STATIONING		AFFECTED UTILITY					PROPOSED CONSTRUCTION				
			Begin	End	GAS	WATER	TELE	STEAM	ELECTRIC	COVER REDUCTION/ DEEP FILL	RETAINING WALL	PAVEMENT WIDENING	BRIDGE REPLACEMENT	BRIDGE PIERS*
2-1	NEVW14E90	W. 14TH ST. TO I-90 EB (RAMP B2)	1205+86			16"						X		
2-2	NEV90ONT	I-90 EB TO ONTARIO ST. (RAMP B3)	1315+50	1316+30			(15) SP 4" (6) SP 4"				14' CUT			
2-3	NEV90ONT	I-90 EB TO ONTARIO ST. (RAMP B3)	1317+93				(24) MTD (4) STD T-DUCT FO				10' CUT	X X X		
2-4	NEV90ONT	I-90 EB TO ONTARIO ST. (RAMP B3)	1318+76				(12) SP 4" (6) SP 4"				9' CUT	X X		
2-5	NEV90ONT	I-90 EB TO ONTARIO ST. (RAMP B3)	1322+12	1322+62			(24) MTD (4) STD T-DUCT FO				4' CUT			

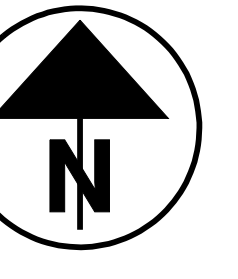


CONTRACT GROUP 2 POTENTIAL UTILITY CONFLICTS SHEET 1

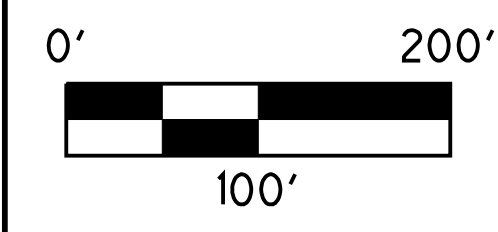


DECEMBER 23, 2009
DRAFT

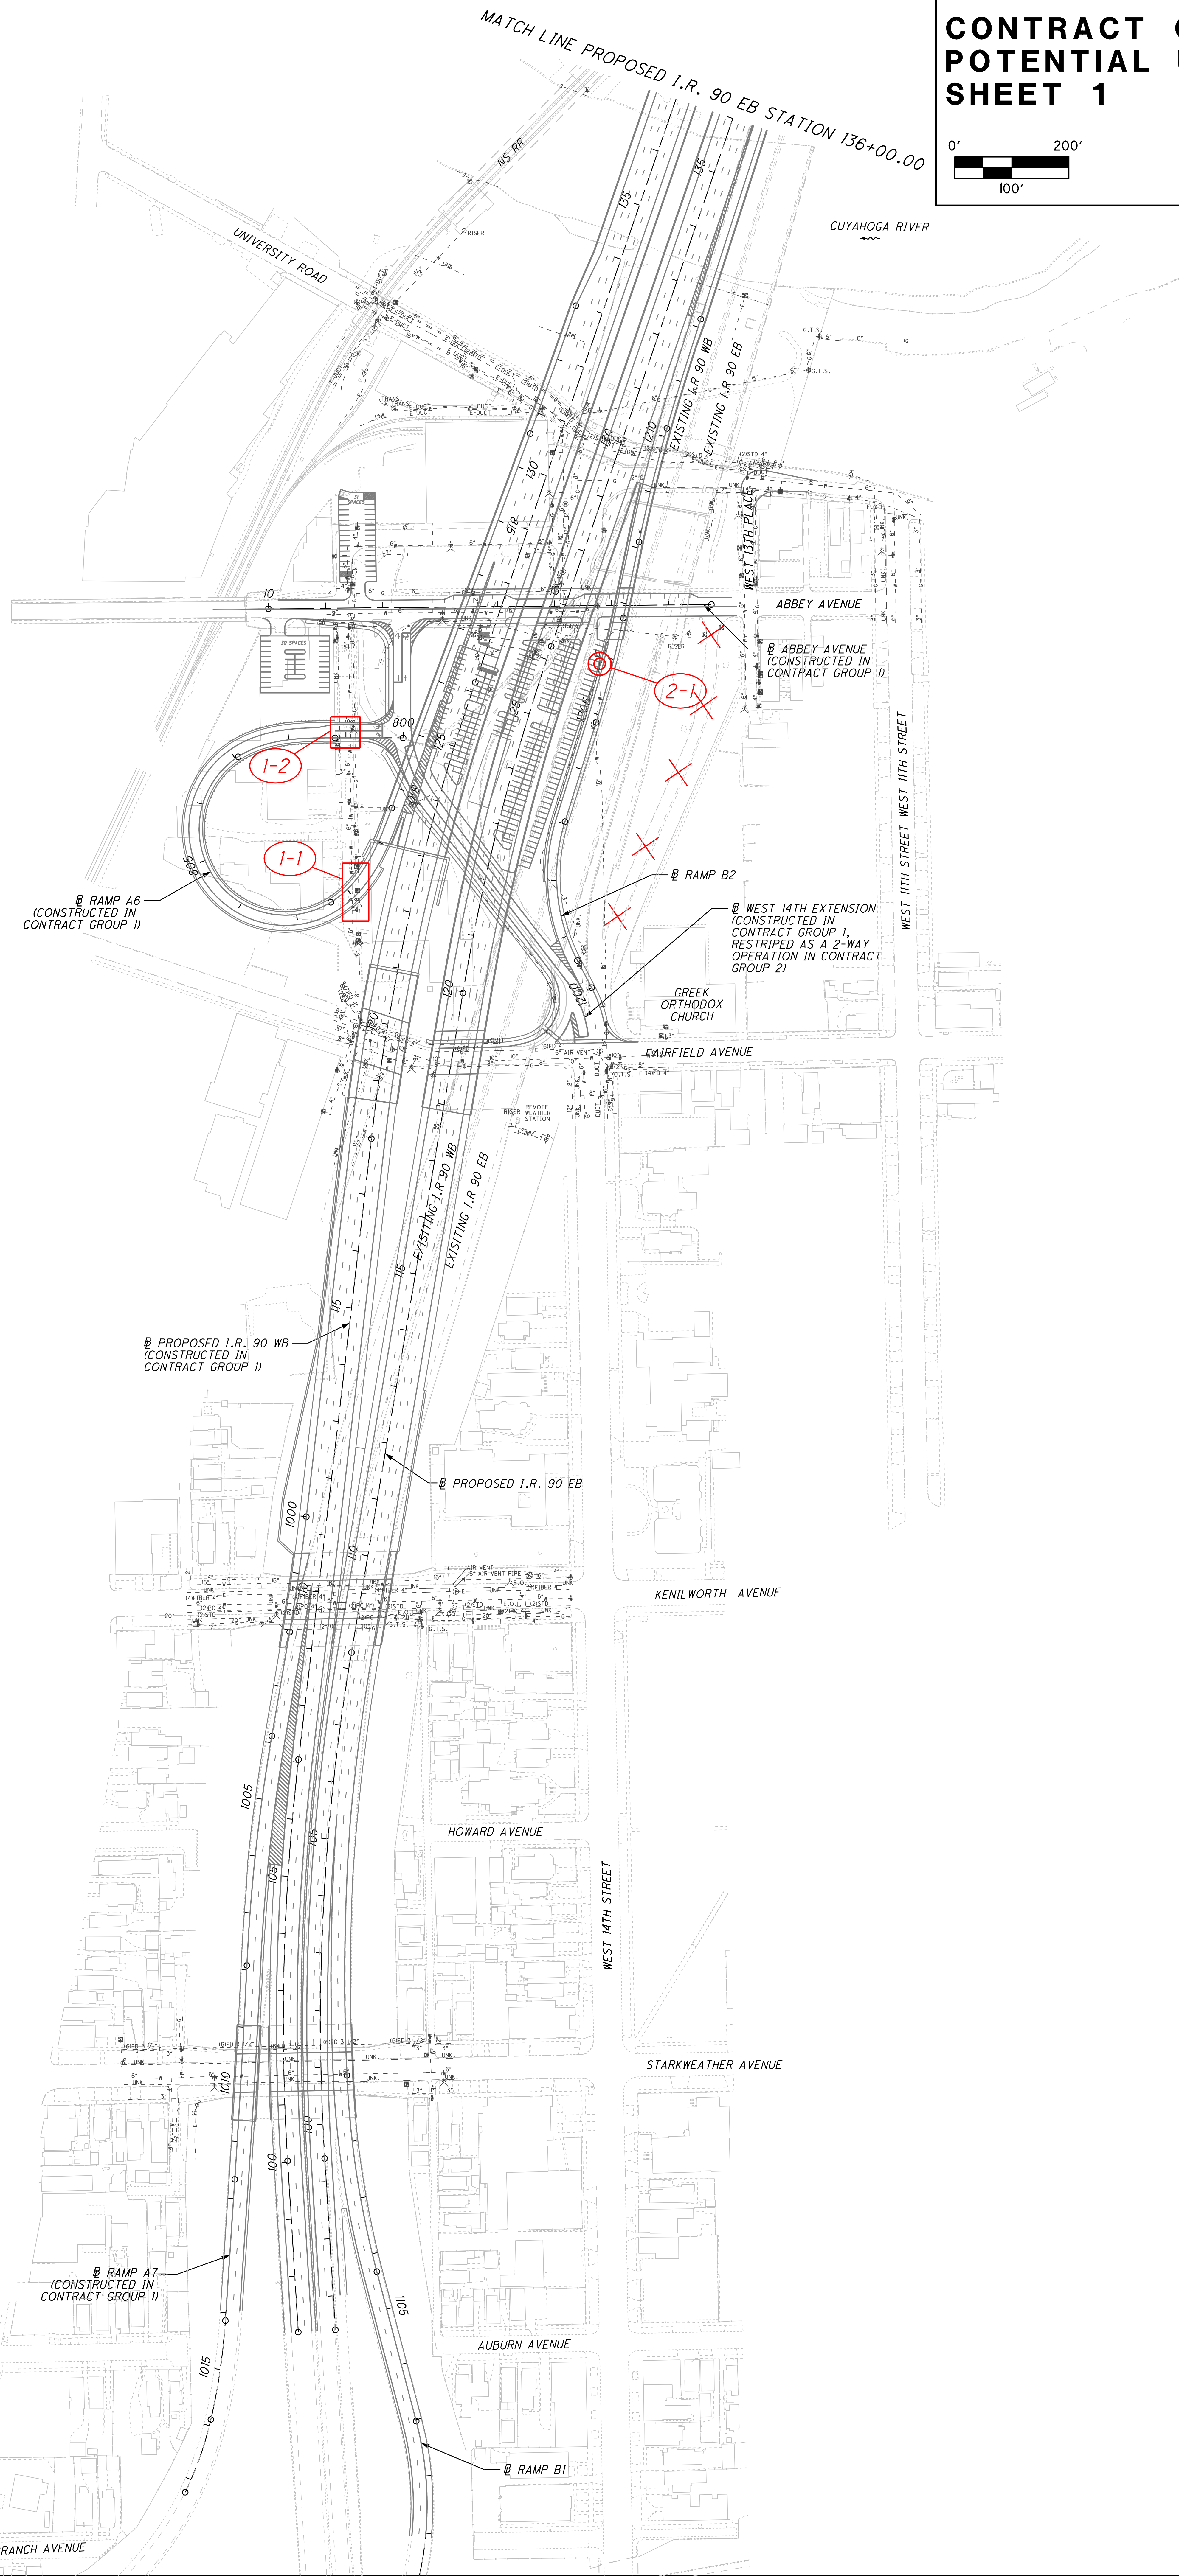

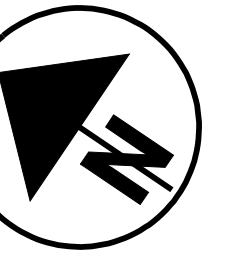

CONTRACT GROUP 2
POTENTIAL UTILITY CONFLICTS
SHEET 2

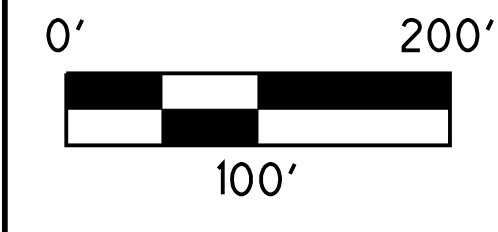

DECEMBER 23, 2009
DRAFT

MATCH LINE PROPOSED I.R. 90 EB STA 168+00.00

PROGRESSIVE FIELD

RAMP A4
 (CONSTRUCTED IN CONTRACT GROUP 1)
 ONTARIO STREET
 (CONSTRUCTED IN CONTRACT GROUP 1)

1-4

TEMPORARY I.R. 90 WB
 (CONSTRUCTED IN CONTRACT GROUP 1)

1-3

RAMP B3

CARNEGIE AVENUE
 (CONSTRUCTED IN CONTRACT GROUP 1)

COMMERCIAL ROAD
 (CONSTRUCTED IN CONTRACT GROUP 1)

EAST 9TH STREET
 (CONSTRUCTED IN CONTRACT GROUP 1)

CENTRAL VIADUCT WAY
 (CONSTRUCTED IN CONTRACT GROUP 1)

RAMP A5

(CONSTRUCTED IN CONTRACT GROUP 1)


WEST 3RD STREET
 EXISTING I.R. 90 WB
 EXISTING I.R. 90 EB

CUYAHOGA RIVER


PROPOSED I.R. 90 EB

PROPOSED I.R. 90 WB
 (CONSTRUCTED IN CONTRACT GROUP 1)

MATCH LINE PROPOSED I.R. 90 EB
 STA 136+00.00

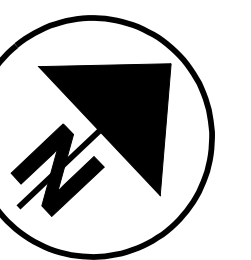

CONTRACT GROUP 2 POTENTIAL UTILITY CONFLICTS SHEET 3

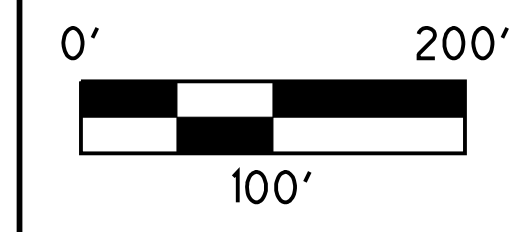

DECEMBER 23, 2009
DRAFT

