



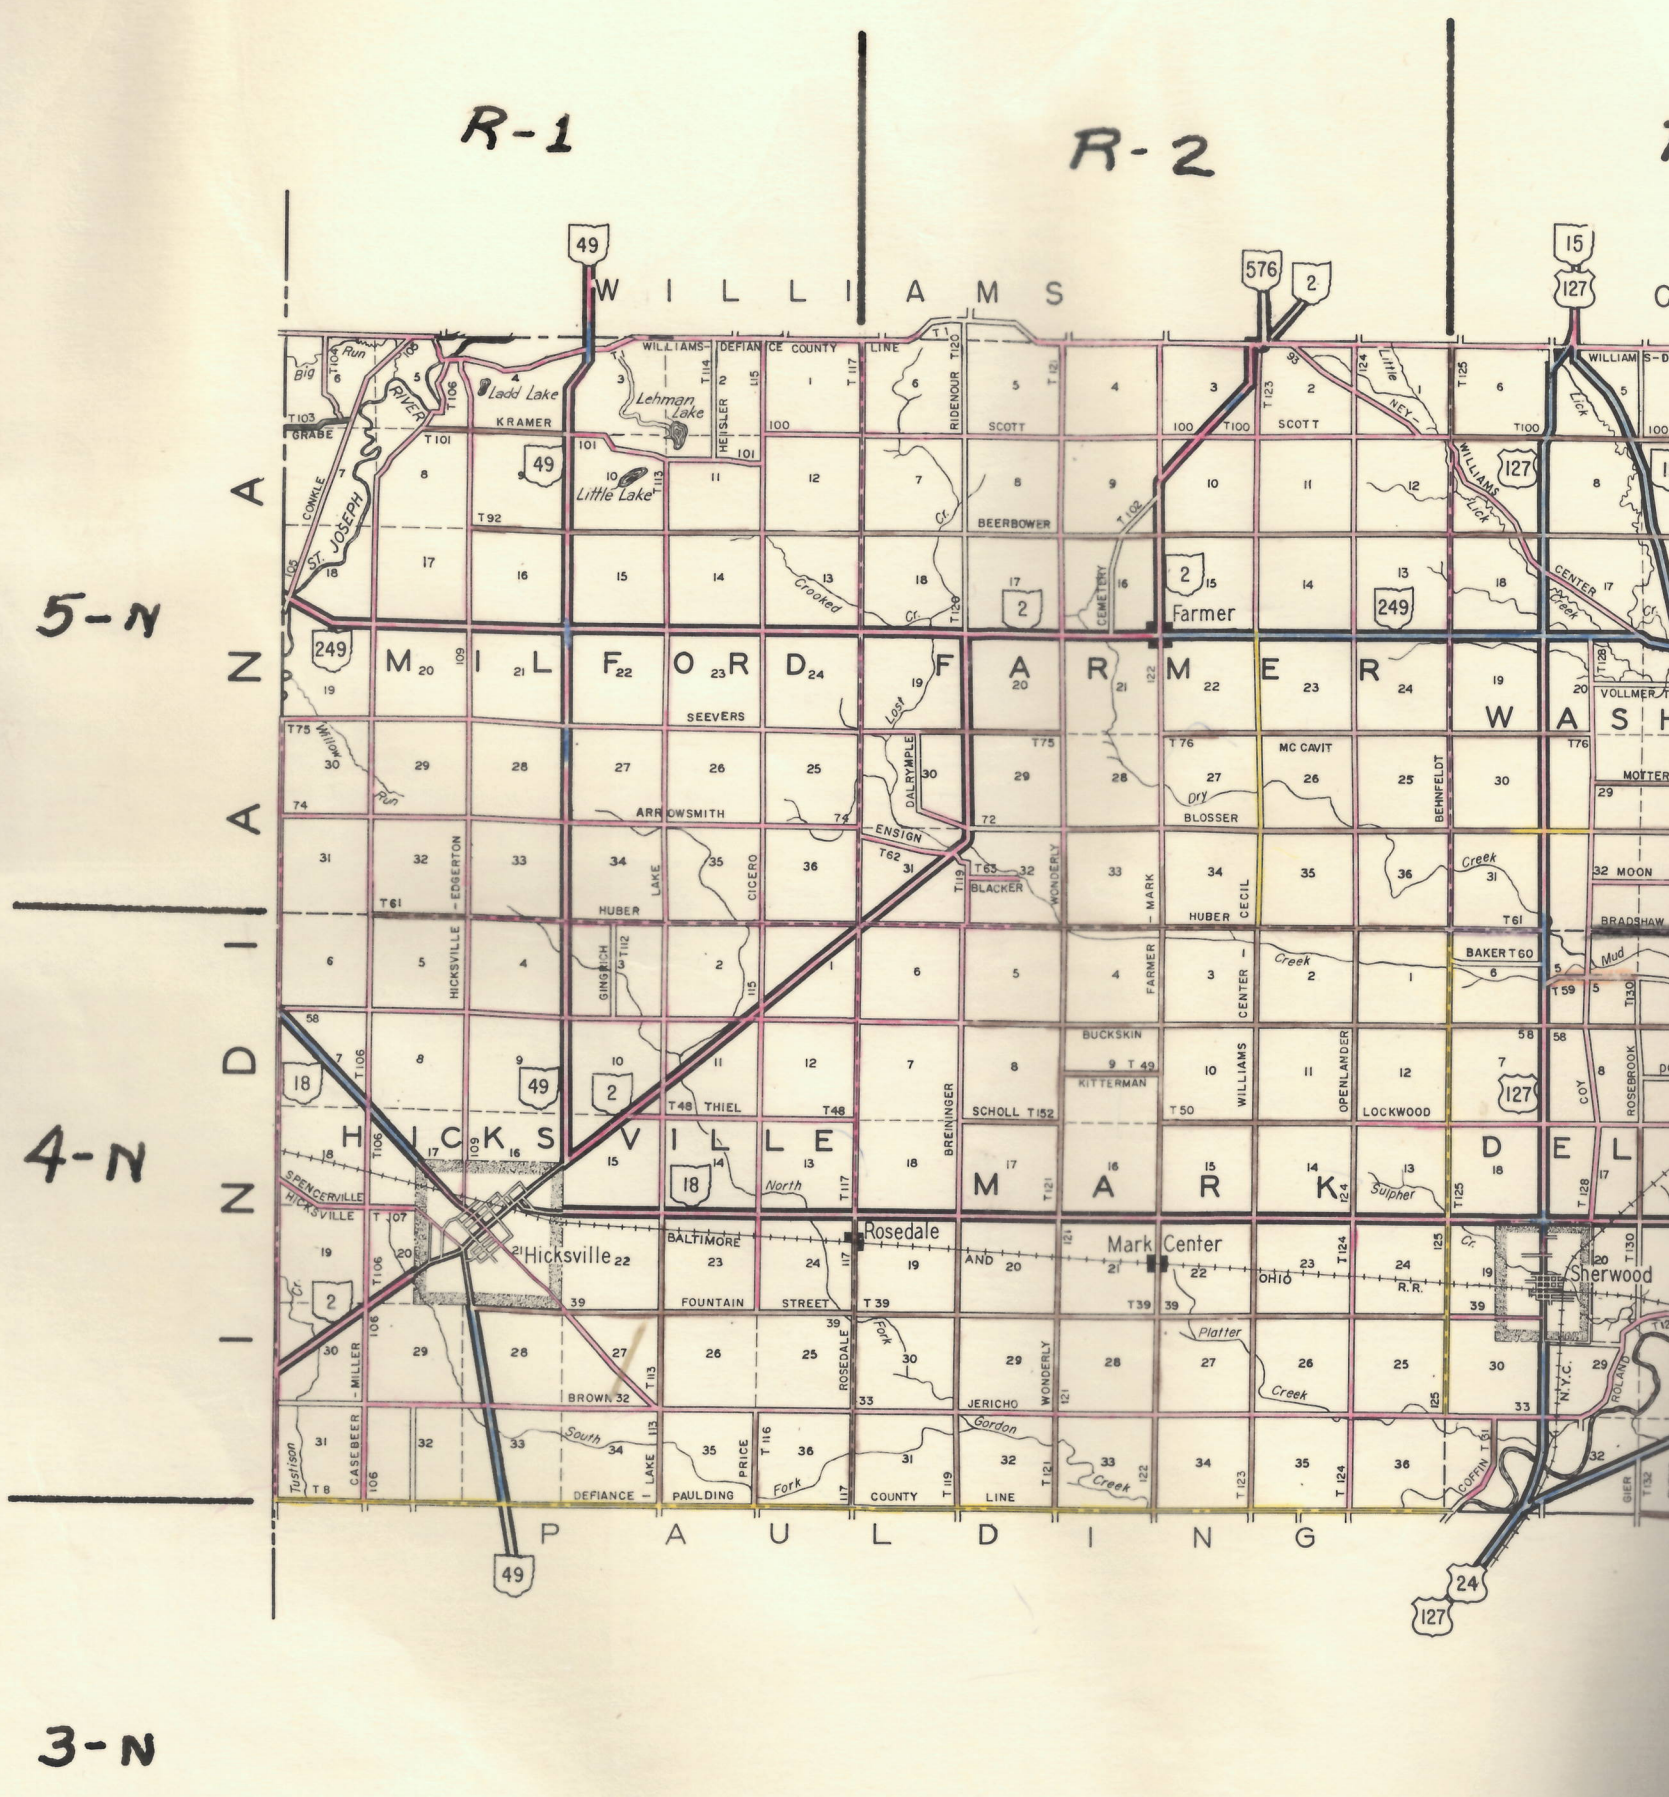


White	= 100' R/W EOVER
Blue	= 80' R/W
Green	= 70' R/W
Red	= 60' R/W
Yellow	= 50' R/W
Orange	= 45' R/W
Brown	= 40' R/W
Black	= 30' R/W
Purple	= Irregular

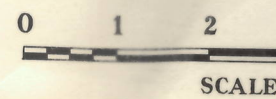

R-3

R-4

R-5

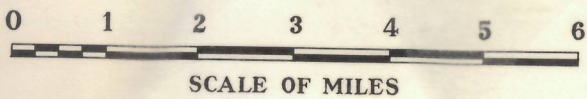

SCALE OF MILES

OHIO DEPARTMENT OF HIGHWAYS
BUREAU OF TRAFFIC

OHIO HIGHWAY MAP
DEFIANCE COUNTY