LD-5—(25M—2-59)

SHEET NO.

PERSONNEL	TITLE	PERSONNEL	TITLE
Red Beach			
Newcomb			
Knape			

COUNTY Fulton DATE Nov - Dec 1971

S. R. US 20-A WEATHER

SEC. 9 YORK TWP T-7-N TEMP.

DESCRIPTION ALIGNMENT & CONTROLS JOB NO.
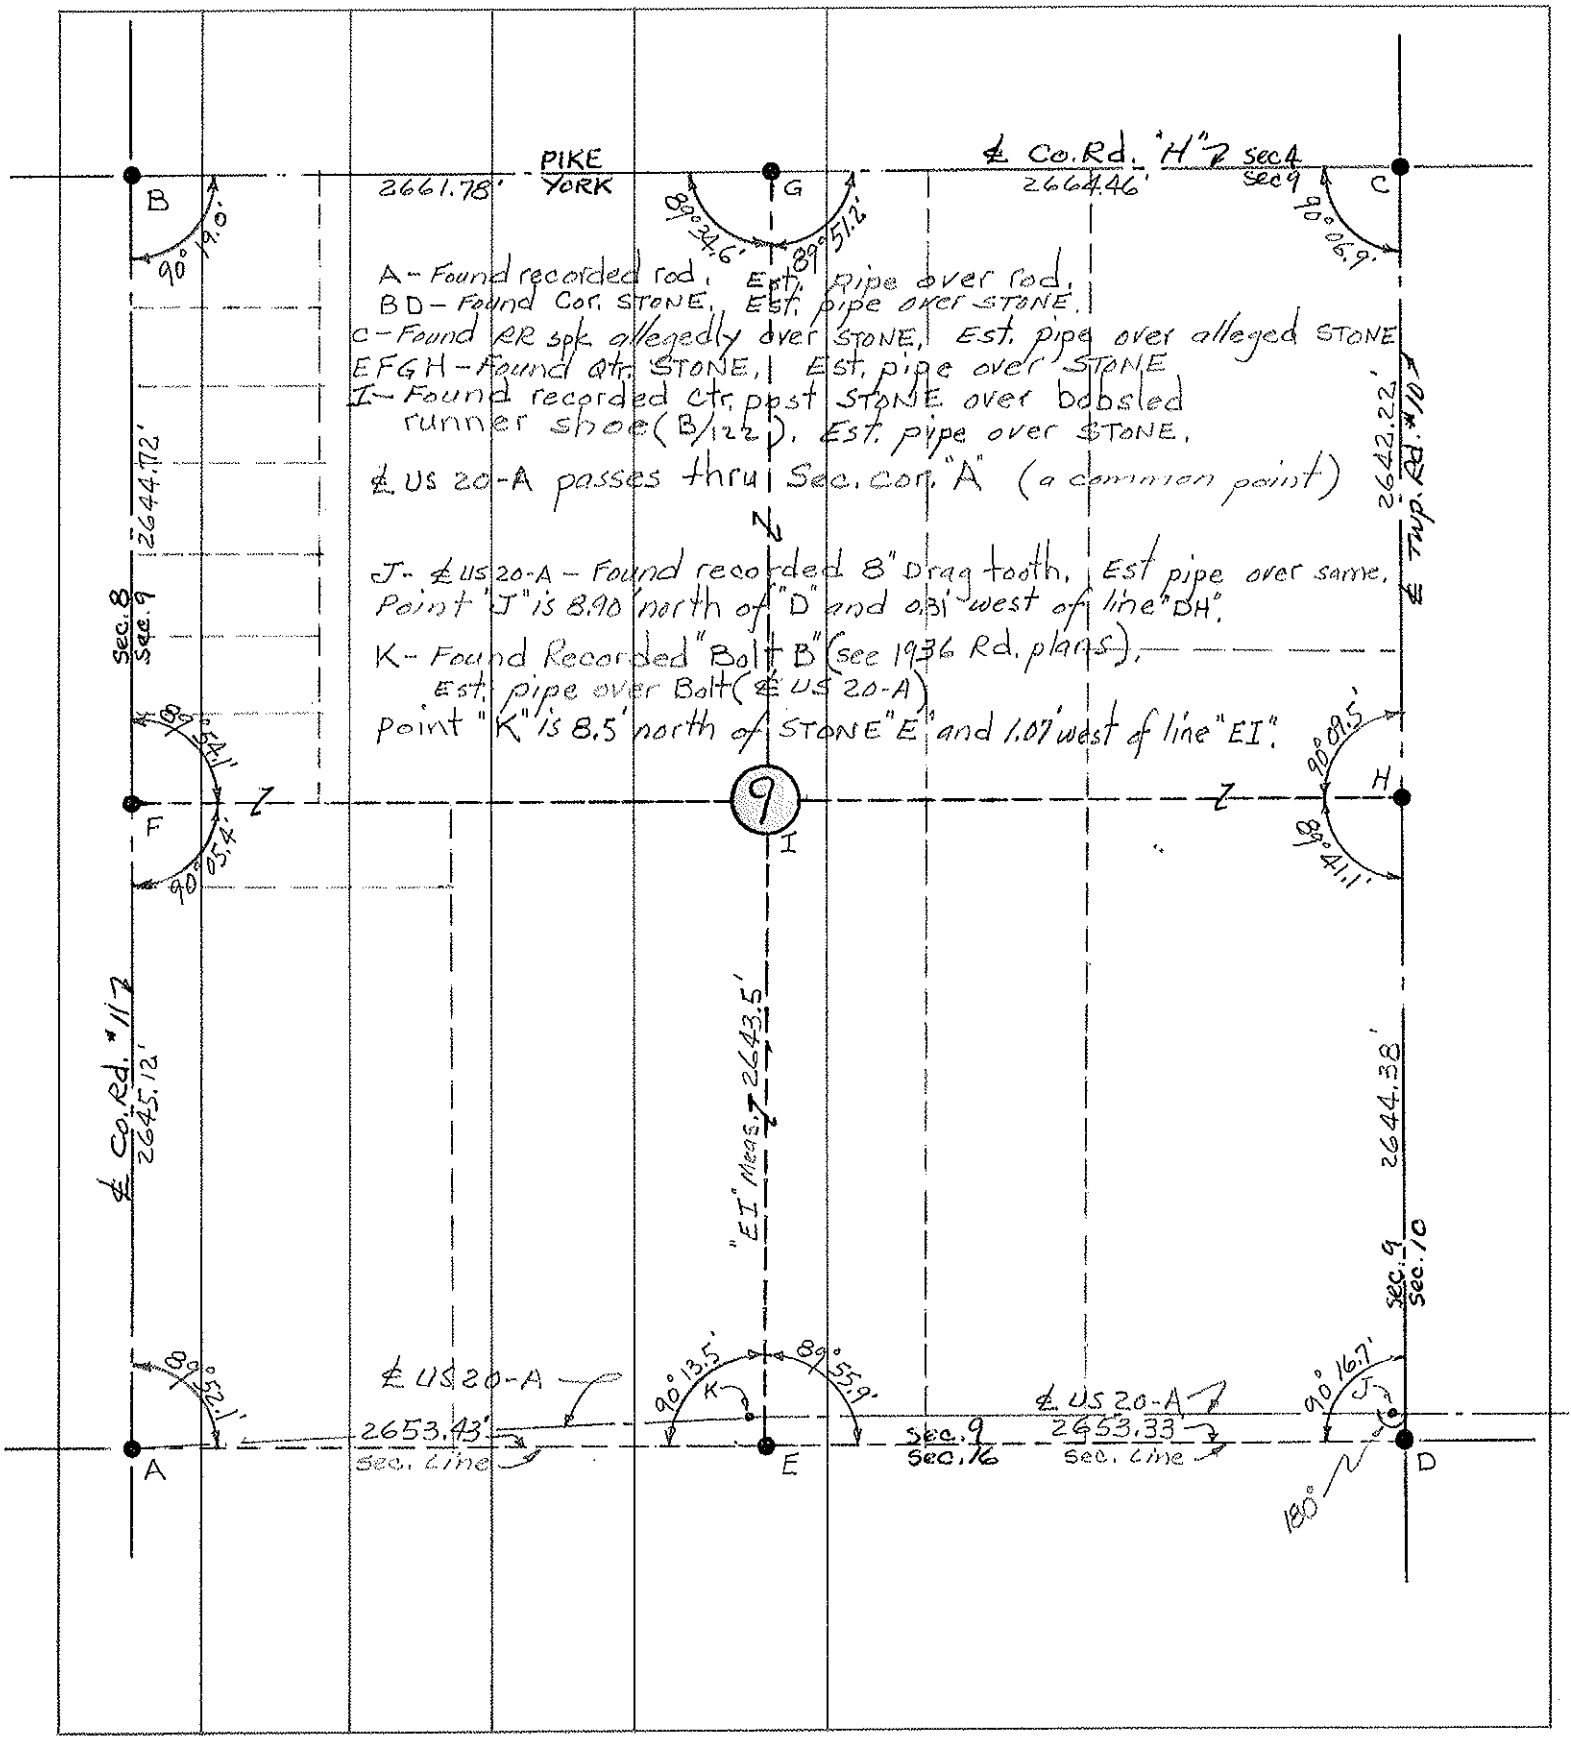
LEFT CENTER LINE RIGHT