

NOTED TO:
J. HUSZ
6-29-97
8 ALSO
UTILITIES

HENRY

[illegible]

COUNTY HENRY ROUTE 6 SECTION 32.508 SUK

[illegible]

PERSONNEL

PERSONNEL

TITLE

COUNTY HENRYDATE 8-26-97BARANISEL IIICANTERBURY TAPEROUSOS TAPEWEATHER SUNNYTEMP. +27°C

DESCRIPTION

INFORMATION FOR RESURFACING

LEFT

CENTER LINE

RIGHT

BAD CURBING LT SIDE

32+384.4 to 32+490

32+553 to 32+674.25

BAD CURBING RT SIDE

32+420 to 32+460


32+601 to 32+674.25

NOTE:

CURB & GUTTER IS IN POOR COND., the area's listed ABOVE ARE the WORST area's, but the ENTIRE CURB and GUTTER should be replaced.

LIFE LINES LOCATED ON E

BRIDGE CLEARANCES

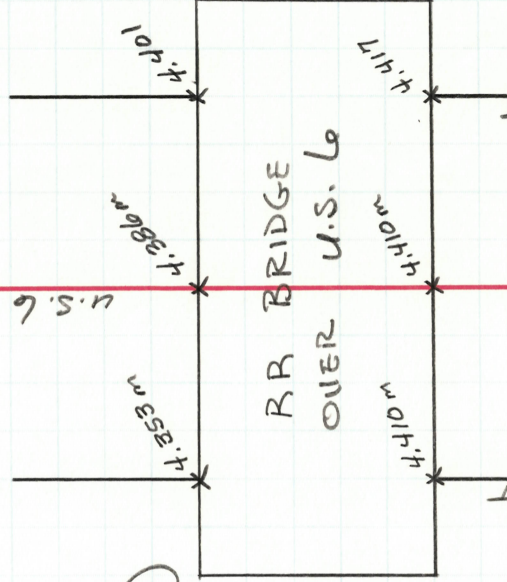

PERSONNEL TITLE PERSONNEL TITLE
 BARNHISEL π
 CANTERBURY ϕ
 Rousos π

COUNTY HENRY DATE 8-26-97
 S.A. U.S. 6 WEATHER Fog "Am"
 SEC. 32.508 SLK TEMP. +24° C

DESCRIPTION X-Section of Pav't
 LEFT CENTER LINE RIGHT
 JOB NO. 024320

STA;	B.S.	π	F.S.	ELEV.	
B.M.	1.889	201.889		100.00	"11" CUT ON TOP OF CONC. WALL, UNDER BRIDGE / 32+508.75 / 4.58 CT E Pav't
32+350		E.B.	E.P.	E.B.	
		0.788	0.740	0.696	0.761 0.822
32+380		1.008	1.003	0.954	1.012 1.037
32+384.6		Top CURB	GUTTER	Pav't	Gutter Top CURB
		0.992	1.054	1.005	1.053 0.991
+410		1.195	1.284	1.220	1.296 1.203
+440		1.582	1.709	1.626	1.679 1.581
+470		2.115	2.228	2.165	2.220 2.121
+499.63		2.588	2.684	2.656	2.690 2.613
+519.15		2.492	2.580	2.576	2.593 2.493
+530		2.186	2.312	2.296	2.323 2.208

PERSONNEL BARNHISEL TITLE DI K PERSONNEL HENRY DATE 8-26-97
CANTERBURY Φ U.S. G WEATHER FOG "Am"
ROUSOS 7 SEC. 32.508 SLK +24° C

DESCRIPTION C.B. INFORMATION CENTER LINE LEFT RIGHT
 JOB NO. 024320

STA:	BS.	K	F.S.	ELEV.	
C.B.	32+465.7 / CT CURB	101.889	2.113		1" GRATE
			3.343		1" 30.48 cm SOUTH "CONC."
			3.405		1" 15.24 cm N.W. "cmp"
			3.225		1" 15.24 cm N.E. "cmp"
			3.413		BOTTOM
C.B.	32+465.7 / RT CURB		2.112		1" GRATE
			3.183		1" 30.48 cm NORTH "CONC."
			3.202		1" 15.24 cm S.E. "cmp"
			3.162		1" 15.24 cm S.W. "cmp"
			3.252		BOTTOM
C.B.	32+502.66 / LT CURB		2.755		1" GRATE
			3.525		1" 30.48 cm CONC. South
			3.520		1" 15.24 cm cmp N.W.
			3.585		BOTTOM
C.B.	32+502.77 / RT CURB		2.733		1" GRATE
			3.468		1" 30.48 cm NORTH "CONC"
			3.471		BOTTOM
C.B.	32+516.25 / CT CURB		2.662		1" GRATE
			3.416		1" 30.48 cm CONC. South

OHIO DEPARTMENT OF TRANSPORTATION

SHEET NO. 728

PERSONNEL BARNHISEL TITLE PI PERSONNEL HENRY TITLE _____
CANTERBURY P U.S. 6 COUNTY U.S. 6 DATE 8-26-97
ROUSOS P 32.508 SEC. 32.508 SK SUNNY WEATHER SUNNY
 TEMP. +27°C

DESCRIPTION C.B. INFORMATION CENTER LINE RIGHT
 JOB NO. 024320

STA;	BS.	FS.	ELEV.
T.P.	2.833	1.660	100.229
C.B.	32+570.65 / CUT CURB	2.578	AT GRATE
		3.583	AT 30.48 cm CONC. SOUTH
		3.629	AT 15.24 cm CMP N.W.
		3.572	AT 15.24 cm CMP N.E.
		3.638	BOTTOM
C.B.	32+570.65 / RT CURB	2.567	AT GRATE
		3.764	AT 30.48 cm CONC. NORTH
		3.735	AT 15.24 cm CMP S.W.
		3.672	AT 15.24 cm CMP S.E.
		3.821	BOTTOM
M.H.	32+647.45	1.495	Top of Rim w/s

PERSONNEL BARNHISEL TITLE IN PERSONNEL HENRY DATE 8-26-97
CANTERBURY P U.S. 6 WEATHER Fog "Am"
Rousas SEC. 32.508 SLK +24° C

DESCRIPTION X-Section of PAUT CENTER LINE
 LEFT RIGHT JOB NO. 024320


STA.	B.S.	Σ	F.S.	ELEV.			
		103.062					
32+650		TOP CURB	GUTTER		E PAUT	GUTTER	Top CURB
		1.377	1.520		1.459	1.498	1.383
+674.25		1.262	1.339		1.311	1.339	1.255
		E.B.	E.P.			E.P.	E.B.
+680		1.237	1.234		1.228	1.270	1.278
+710		1.136	1.083		1.040	1.087	1.126
T.P.	1.356	102.134	2.284	100.778			
B.M.			2.134	100.000			(100.000)

DATE 4-8-98

WEATHER cloudy

TEMP. + 57.0

JOB NO. 024320

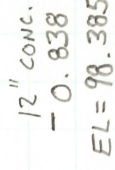RIGHT

NOTE: ON RIM OF BOTH M.H.'S
ALL SHOT'S MEASURED DOWN TO
FE OF PIPE.

