LD-5—(25M—4-63)

SHEET NO. 1-W4

PERSONNEL	TITLE	PERSONNEL	TITLE
Bruster			
Beacher			
Moehler			
Knapper			

COUNTY Henry DATE Dec 1964

S. R. US #6/24 Bypass WEATHER

SEC. Zahrends Intchg TEMP.
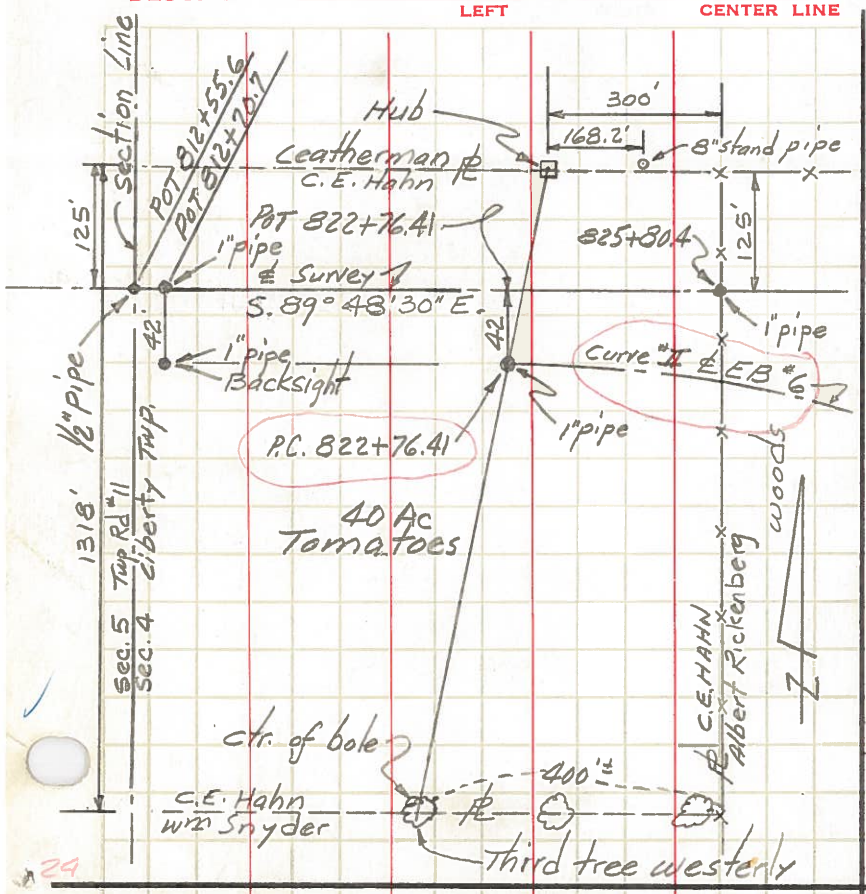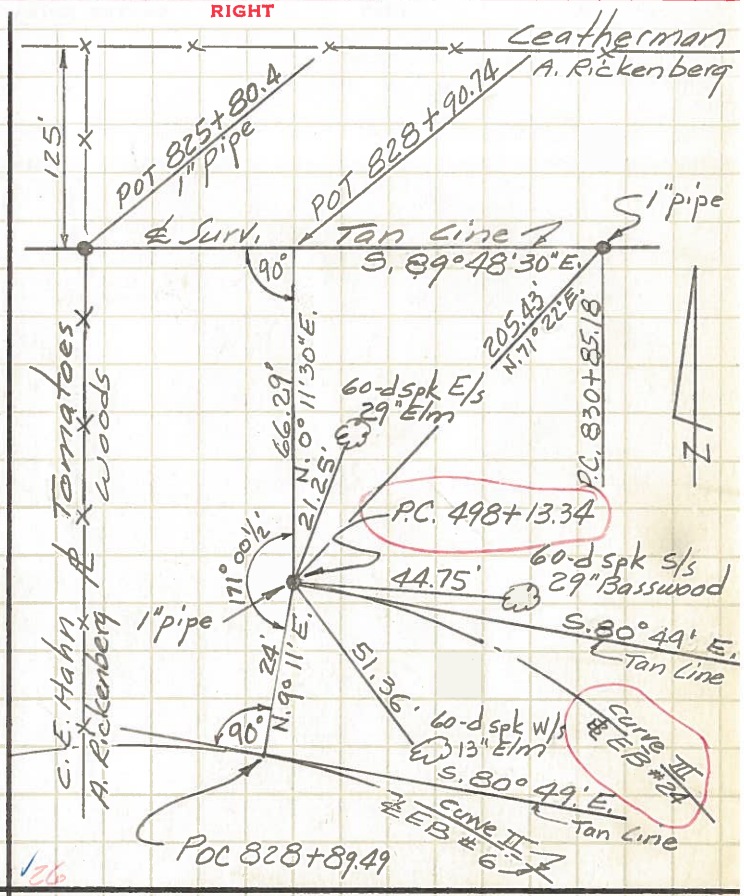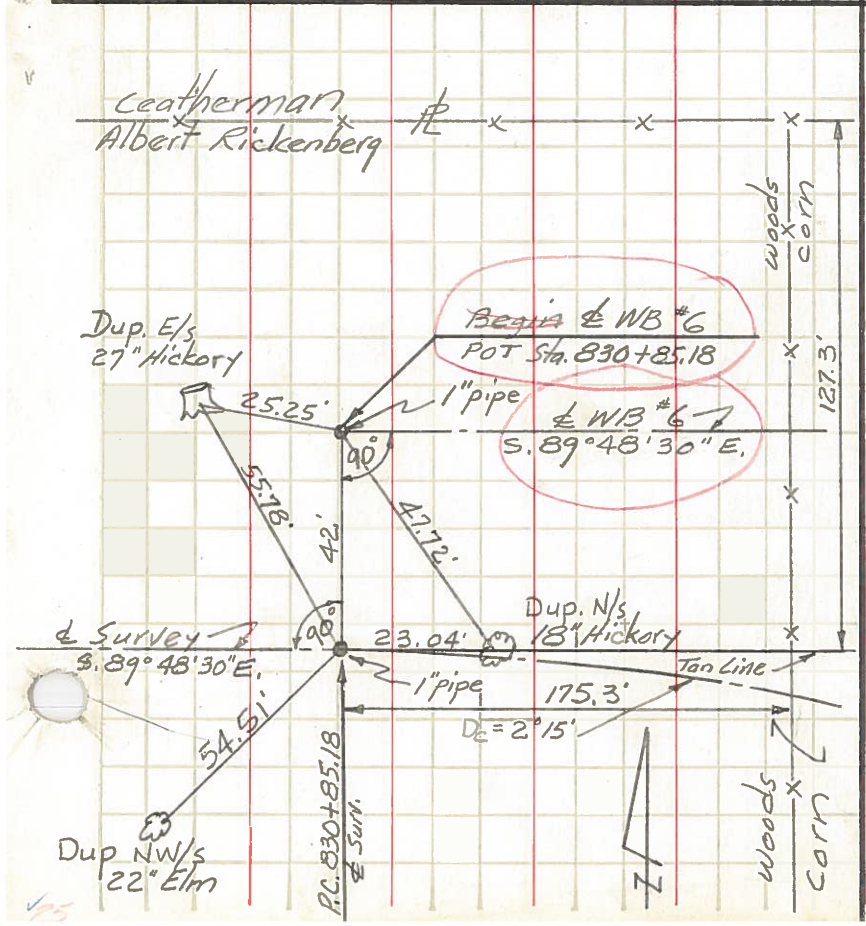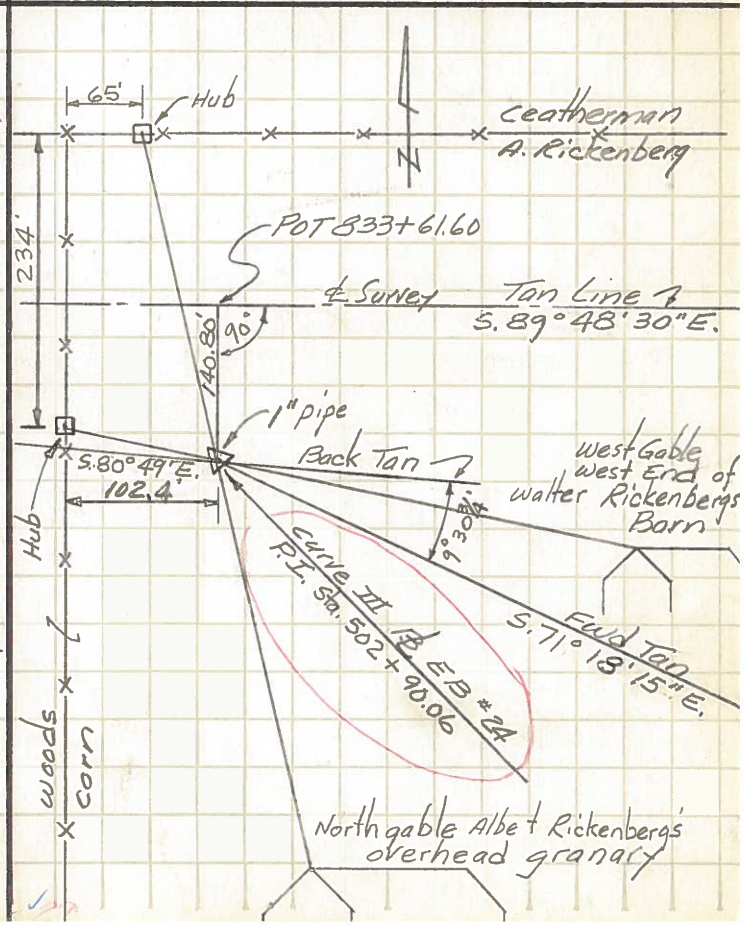
DESCRIPTION CONTROL POINTS JOB NO.