

ODOT (D-2)
Notes to:
J. Huss
7-30-97

1998 TWO-LANE RESURFACING PROGRAM

DATE 6-4-97

PERSONNEL Barshisel

Canterbury

Rouser

PRIORITY NO. 4 PART 3 OF 3 SHEET 1 OF 12

COUNTY Henry ROUTE 281 SECTION 9.189

BEGIN LOG (SLM) 9.189 TERMINI SE 108

END LOG (SLM) 29.987 TERMINI WOOD COUNTRY LINE

TOTAL LENGTH 19.698 K.M. MILES

MUNICIPALITY _____ BEGIN LOG (SLM) _____ END LOG (SLM) _____

MUNICIPALITY _____ BEGIN LOG (SLM) _____ END LOG (SLM) _____

PROPOSED WORK: Repair existing pavement & Resurface
0.038 m 446 SE 108 to SE 109 & use 65 to wood co.
PAVEMENT 0.019 m / 0.032 m 446 SE 109 to SE 108 SHOULDER JAMES - 617

OTHER LOCATE BAD PAVEMENT & SHOULDER NEARS

STATION ESTABLISHED FROM: Rel. pt. at intersection SE 281 & 108
ENDING CONSTRUCTION JOINTS ST 28+845.4 Berm 24 6.74
Wood/Henry Co Line stg. 28+863.5 Right 6.25 Berm 6+0.85

HEW 281 1776	28+551.2	12.23	16.25	Approach L 7.68 7.68
HEW 281 1753	28+181.6	10.6	18.4	Approach W 10.16 10.16
STRUCTURES:				Approach Length 7.64 7.64
NUMBER	STATION	WIDTH	LENGTH	Approach Width 10.6 10.6
HEW 281 0574	9+226.9	9.11	20.90	Front Back
HEW 281 0811	13+056.25	9.10	8.20	Width approach sl.
HEW 281 0969	15+582.8	8.33	11.4	
	16+512.8	11.65	23.54	Length approach slabs
				Width approach slabs
				Front Back 7.65 7.65
				11.65 11.65

RAILROAD CROSSING:

(NO WORK)

NAME _____ STATION 16+350.8 NO. TRACKS 1 LENGTH ALONG C L 2.60 M

DATE 6-4-971994 TWO-LANE RESURFACING PROGRAM
PAVEMENT DATA

NOTE: LOCATE ALL
CHANGES IN PVMT WIDTH

COUNTY Henry ROUTE 281 SECTION 9.189

[illegible]

DATE 6-4-97

TWO-LANE RESURFACING PROGRAM
DEFECTIVE PAVEMENT AREAS

SHEET 3 OF 12

COUNTY Henry ROUTE SR 281 SECTION 9.189

STATION		LT BERM	LT LANE	RT LANE	RT BERM	SIZE (WIDTH)	EXISTING PAVEMENT CONDITIONS	
FROM	TO						RUTTED	CRACKED BASE FAILURE
13+590	13+700	✓				1.00m	✓	✓
15+260	15+295	✓	✓			1.00m	✓	✓
15+965	16+000			✓	✓	2.00m	✓	✓
16+088	16+180	✓	✓			2.50m	✓	✓
16+200	16+485	✓	✓			2.00m	✓	✓
16+335	16+400			✓	✓	1.50m	✓	✓
16+670	16+880			✓	✓	2.00m	✓	✓
17+000	17+345			✓	✓	2.00m	✓	✓
17+450	17+520			✓	✓	2.00m	✓	✓
17+600	17+705			✓	✓	1.50m	✓	✓
17+985	18+050	✓	✓			2.0m	✓	✓
17+985	18+265			✓	✓	2.00m	✓	✓
18+770	19+040			✓	✓	2.00m	✓	✓
19+250	19+290			✓	✓	2.50m	✓	✓
19+330	19+620			✓	✓	2.00m	✓	✓
20+680	20+740			✓	✓	1.50m	✓	✓
20+920	21+025			✓	✓	2.00m	✓	✓
21+260	21+475				✓	1.00m	✓	✓
21+510	21+600			✓	✓	1.50m	✓	✓
21+850	21+885				✓	1.00m	✓	✓

DATE 6-4-97

SHEET 4 OF 12

COUNTY Henry ROUTE SR 281 SECTION 9.189

SECTION 9, 189

[illegible]

DATE 6-4-971994 TWO-LANE RESURFACING PROGRAM
INTERSECTIONSSHEET 5 OF 12COUNTY Henry ROUTE SR 281 SECTION 9.189

L - PROP PAVT DEPTH (IN) X IO; W - WIDTH @ MOUTH; W-I - WIDTH @ THROAT

STATION	SIDE	NAME OR NO.	L	W	W-I	ASPH	CONC	REMARKS
9 + 474		SR 108	4.572					
	R	Co. Rd. 10A	4.572	20.3	9.20	✓		
11 + 106.85	R	Co Rd 12	4.572	29.4	13.4	✓		
	L	Co. Rd 12	4.572	20.5	8.2	✓		
12 + 726.75	R	Co Rd 11	4.572	20.5	8.7	✓		
12 + 726.75	L	Co. Rd. 11	4.572	18.9	8.0	✓		
14 + 341.8	R	Co. Rd 10	4.572	20.0	8.4	✓		
	L	Co. Rd 10	4.572	18.4	7.2	✓		
15 + 955.55	R	SR 109	4.572	27.6	12.4	✓		
15 + 955.55	L	SR 109	4.572	24.3	11.4	✓		
17 + 559	R	Co Rd 8	4.572	23.4	9.4	✓		
17 + 559	L	Co Rd 8	4.572	21.8	8.8	✓		
19 + 169.6	R	Co Rd 7	4.572	20.3	8.5	✓		
19 + 169.6	L	Co Rd 7	4.572	20.9	9.0	✓		
20 + 761.8	R	Co Rd 6	4.572	18.4	6.6	✓		
20 + 761.8	L	Co Rd 6	4.572	17.8	8.0	✓		
22 + 384	R	Co. Rd 5	4.572	19.8	7.5	✓		
22 + 384	L	Co. Rd 5	4.572	19.6	7.7	✓		
24 + 003.3	R	SR 65	7.26	21.9	7.3	✓		Back to joint
24 + 003.3	L	SR 65	4.572	23.9	11.6	✓		
25 + 621.95	R	Co Rd 3	4.572	22.6	8.3	✓		

1994 TWO-LANE RESURFACING PROGRAM SHEET 12 OF 12
UTILITIES (CATCH BASIN, MANHOLE, INLET, WATER VALVE, BOX AND MONUMENT BOX)

COUNTY Henry ROUTE 281 SECTION 9.189

R - RAISE F - FEATHER

[illegible]

1994 TWO-LANE RESURFACING PROGRAM
CROSSWALKS AND STOP BARS

SHEET 8 OF 12

COUNTY Henry ROUTE SR 281 SECTION 9.189

[illegible]

X-SECTIONS
HENRY
SR 281

pg 9 of 12
SR 281
9.189

Sta	Left Edge	Right Edge
9+300	4.25	4.04
10+100	5.39	5.16
10+950	5.22	5.24
11+650	5.03 on wedge	4.86
12+450	5.07	4.85
13+300	5.08	4.85
14+100	5.02	4.83
14+900	5.24	5.00
15+700	5.30	5.07
16+600	5.15	4.98

Right Edge

Left Edge

on wedge

on wedge

on wedge

on wedge

pg 10 of 12
of SR 281
9.189

X-SECTIONS

HENRY
SR 281

Sta	Left Edge	Δ	Right Edge
20+00	4.92	4.86	<u>on wedge</u> 5.04
20+800	<u>on wedge</u> 5.11	4.93	5.10
21+700	4.86	4.73	<u>on wedge</u> 5.11
22+500	4.86	4.68	<u>on wedge</u> 4.96
23+300	5.06	4.90	5.12
24+100	5.06	4.94	5.07
24+900	5.17	5.02	5.15
25+700	5.06	4.93	5.06
26+500	5.00	4.88	5.08
27+300	5.15	5.02	5.17

PERSONNEL	TITLE	PERSONNEL	TITLE	COUNTY	DATE	WEATHER	TEMP.
BARNHISEL	M			HENRY	6-4-97	SUNNY	
CANTERBURY	Tape			S. R.	281		
ROUSOS	Tape			SEC.	9,189 SLK		+21° C


DESCRIPTION Wide Pav't Area by Newer Bridges JOB NO. 025763

LEFT

CENTER LINE

RIGHT

6112

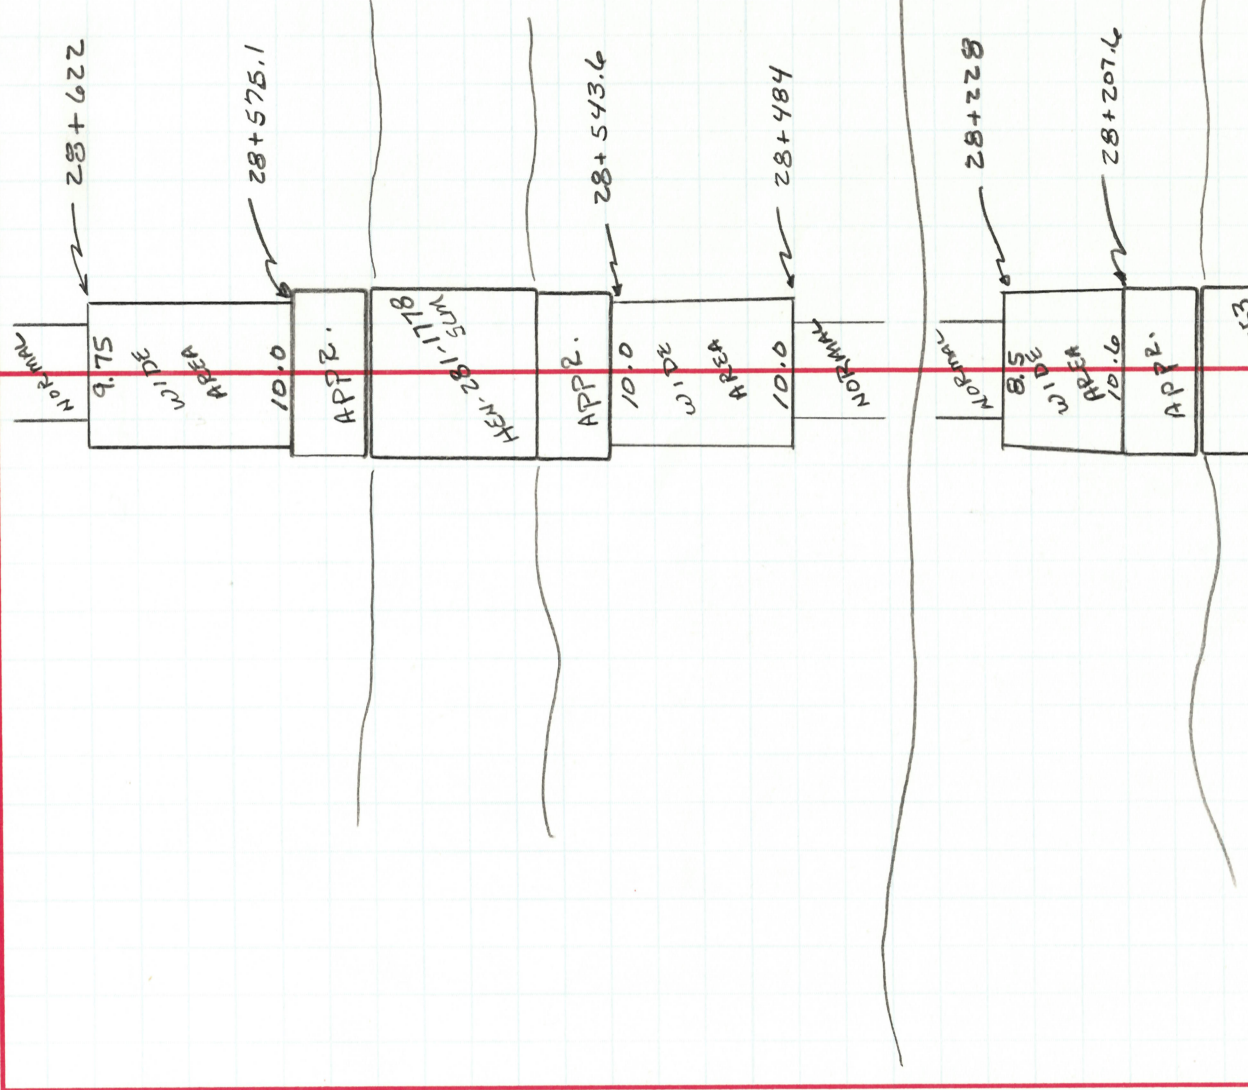

194SWH

OHIO DEPARTMENT OF TRANSPORTATION

SHEET NO. 12 of 12

PERSONNEL

TITLE

PERSONNEL

TITLE

Brandtzel
Cantabury
Kausas

COUNTY Henry

S. R. 281

SEC. 9.189

DATE 6-4-97

WEATHER

TEMP.

DESCRIPTION

LEFT

CENTER LINE

JOB NO.

RIGHT

